


**ABUTMENT 2 PLAN VIEW**  
SCALE 1/2" = 1'-0"

**NOTE:**  
 NF = NEAR FACE  
 FF = FAR FACE  
 EF = EACH FACE  
 ▲ = CUT TO FIT IN FIELD  
 3" CLEAR, UNLESS OTHERWISE SPECIFIED ON THE PLANS.  
 2'-2" BAR LAP UNLESS OTHERWISE SPECIFIED ON THE PLANS.

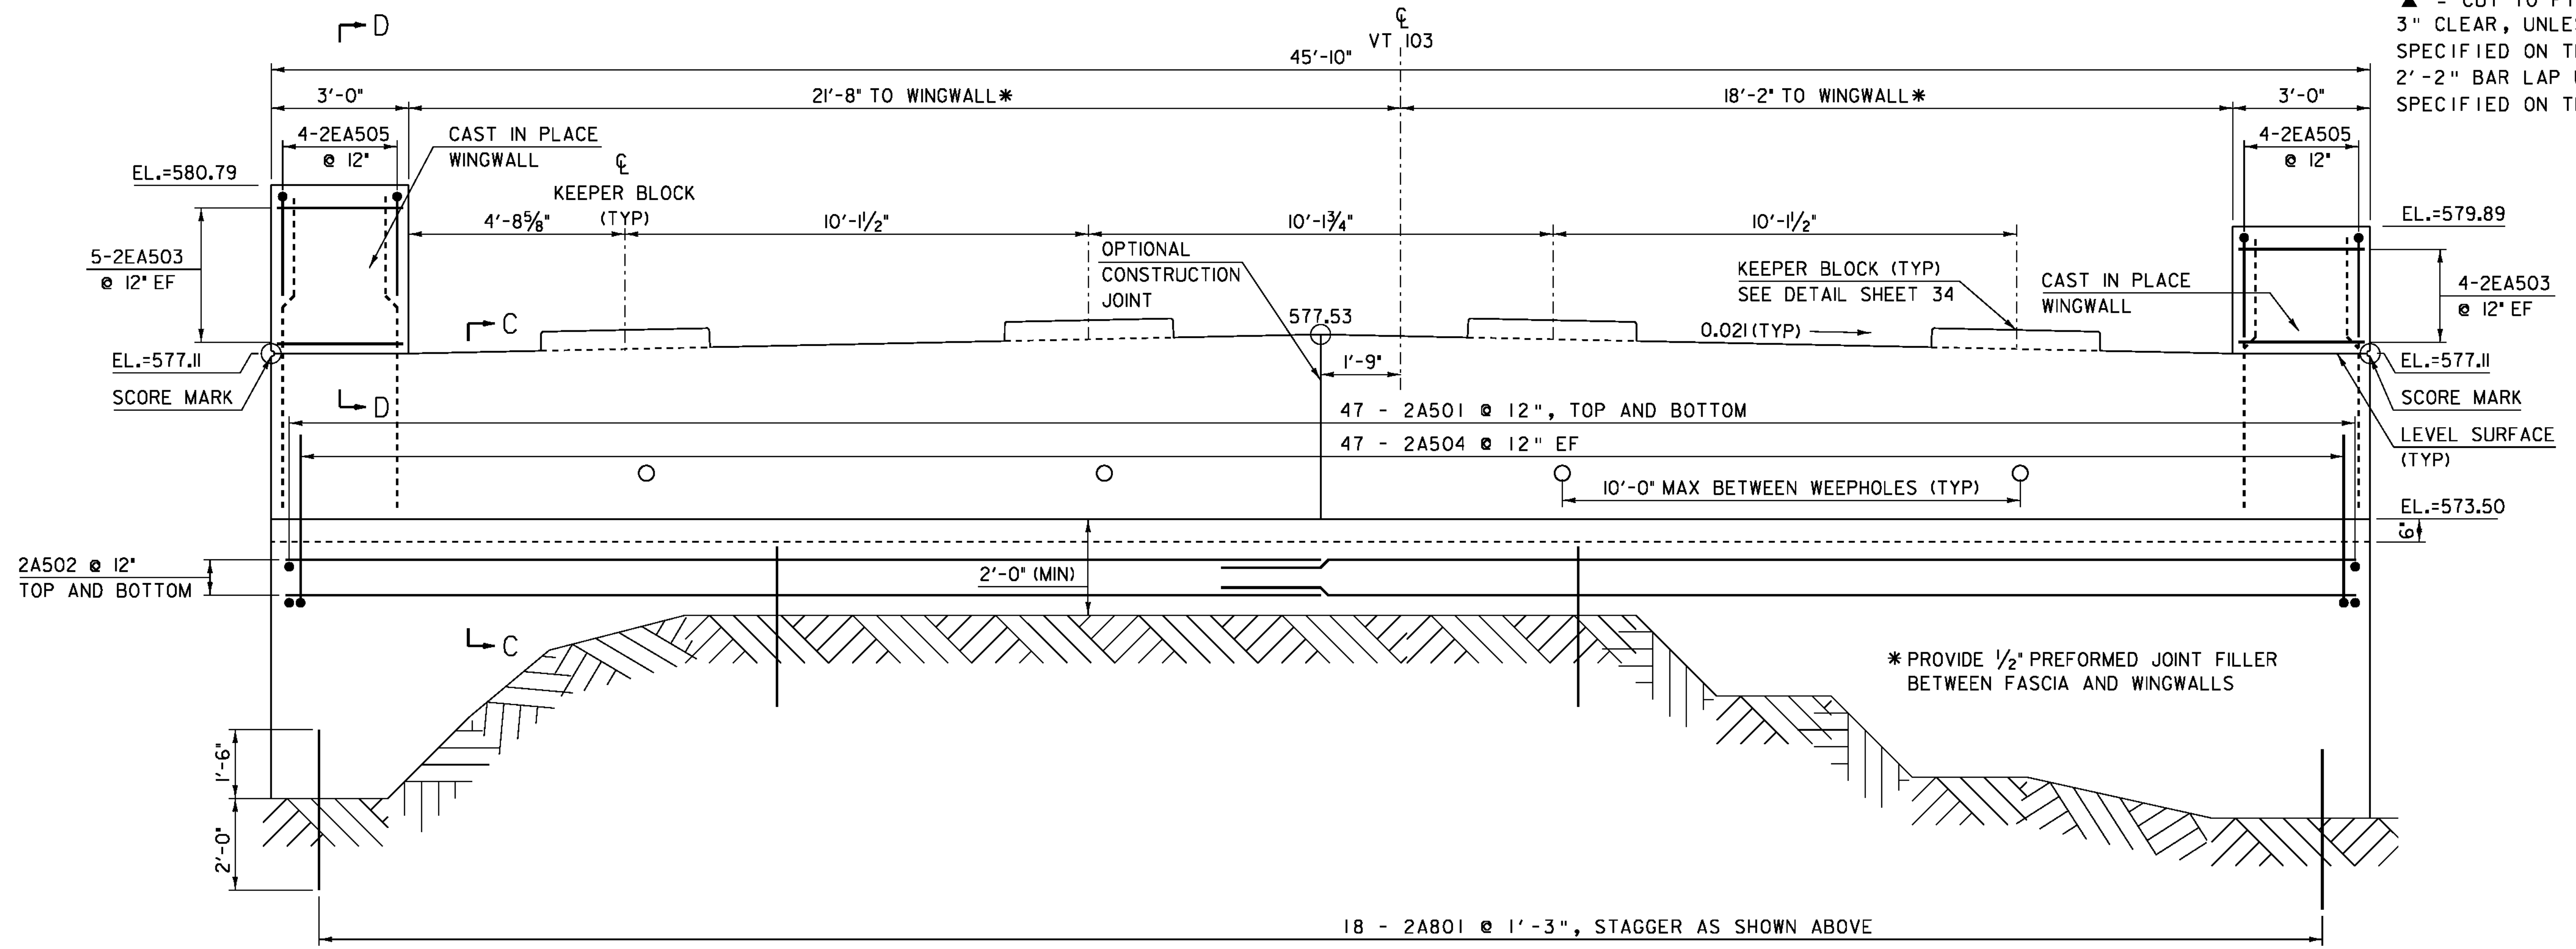

**ABUTMENT 2 ELEVATION VIEW**  
SCALE 1/2" = 1'-0"

SEE SHEET 36  
FOR SECTIONS 'C-C' & 'D-D'

SCALE 1/2" = 1'-0"

PROJECT NAME: CHESTER	PLOT DATE: 20-SEP-2010
PROJECT NUMBER: BRF 025-1(28)	DRAWN BY: M.FESSEL
FILE NAME: 84e061/Str/sub.dgn	CHECKED BY: R.S.YOUNG
PROJECT LEADER: C.P.WILLIAMS	SHEET 35 OF 124
DESIGNED BY: R.S.YOUNG	
BRIDGE 8 ABUTMENT 2 DETAILS	