
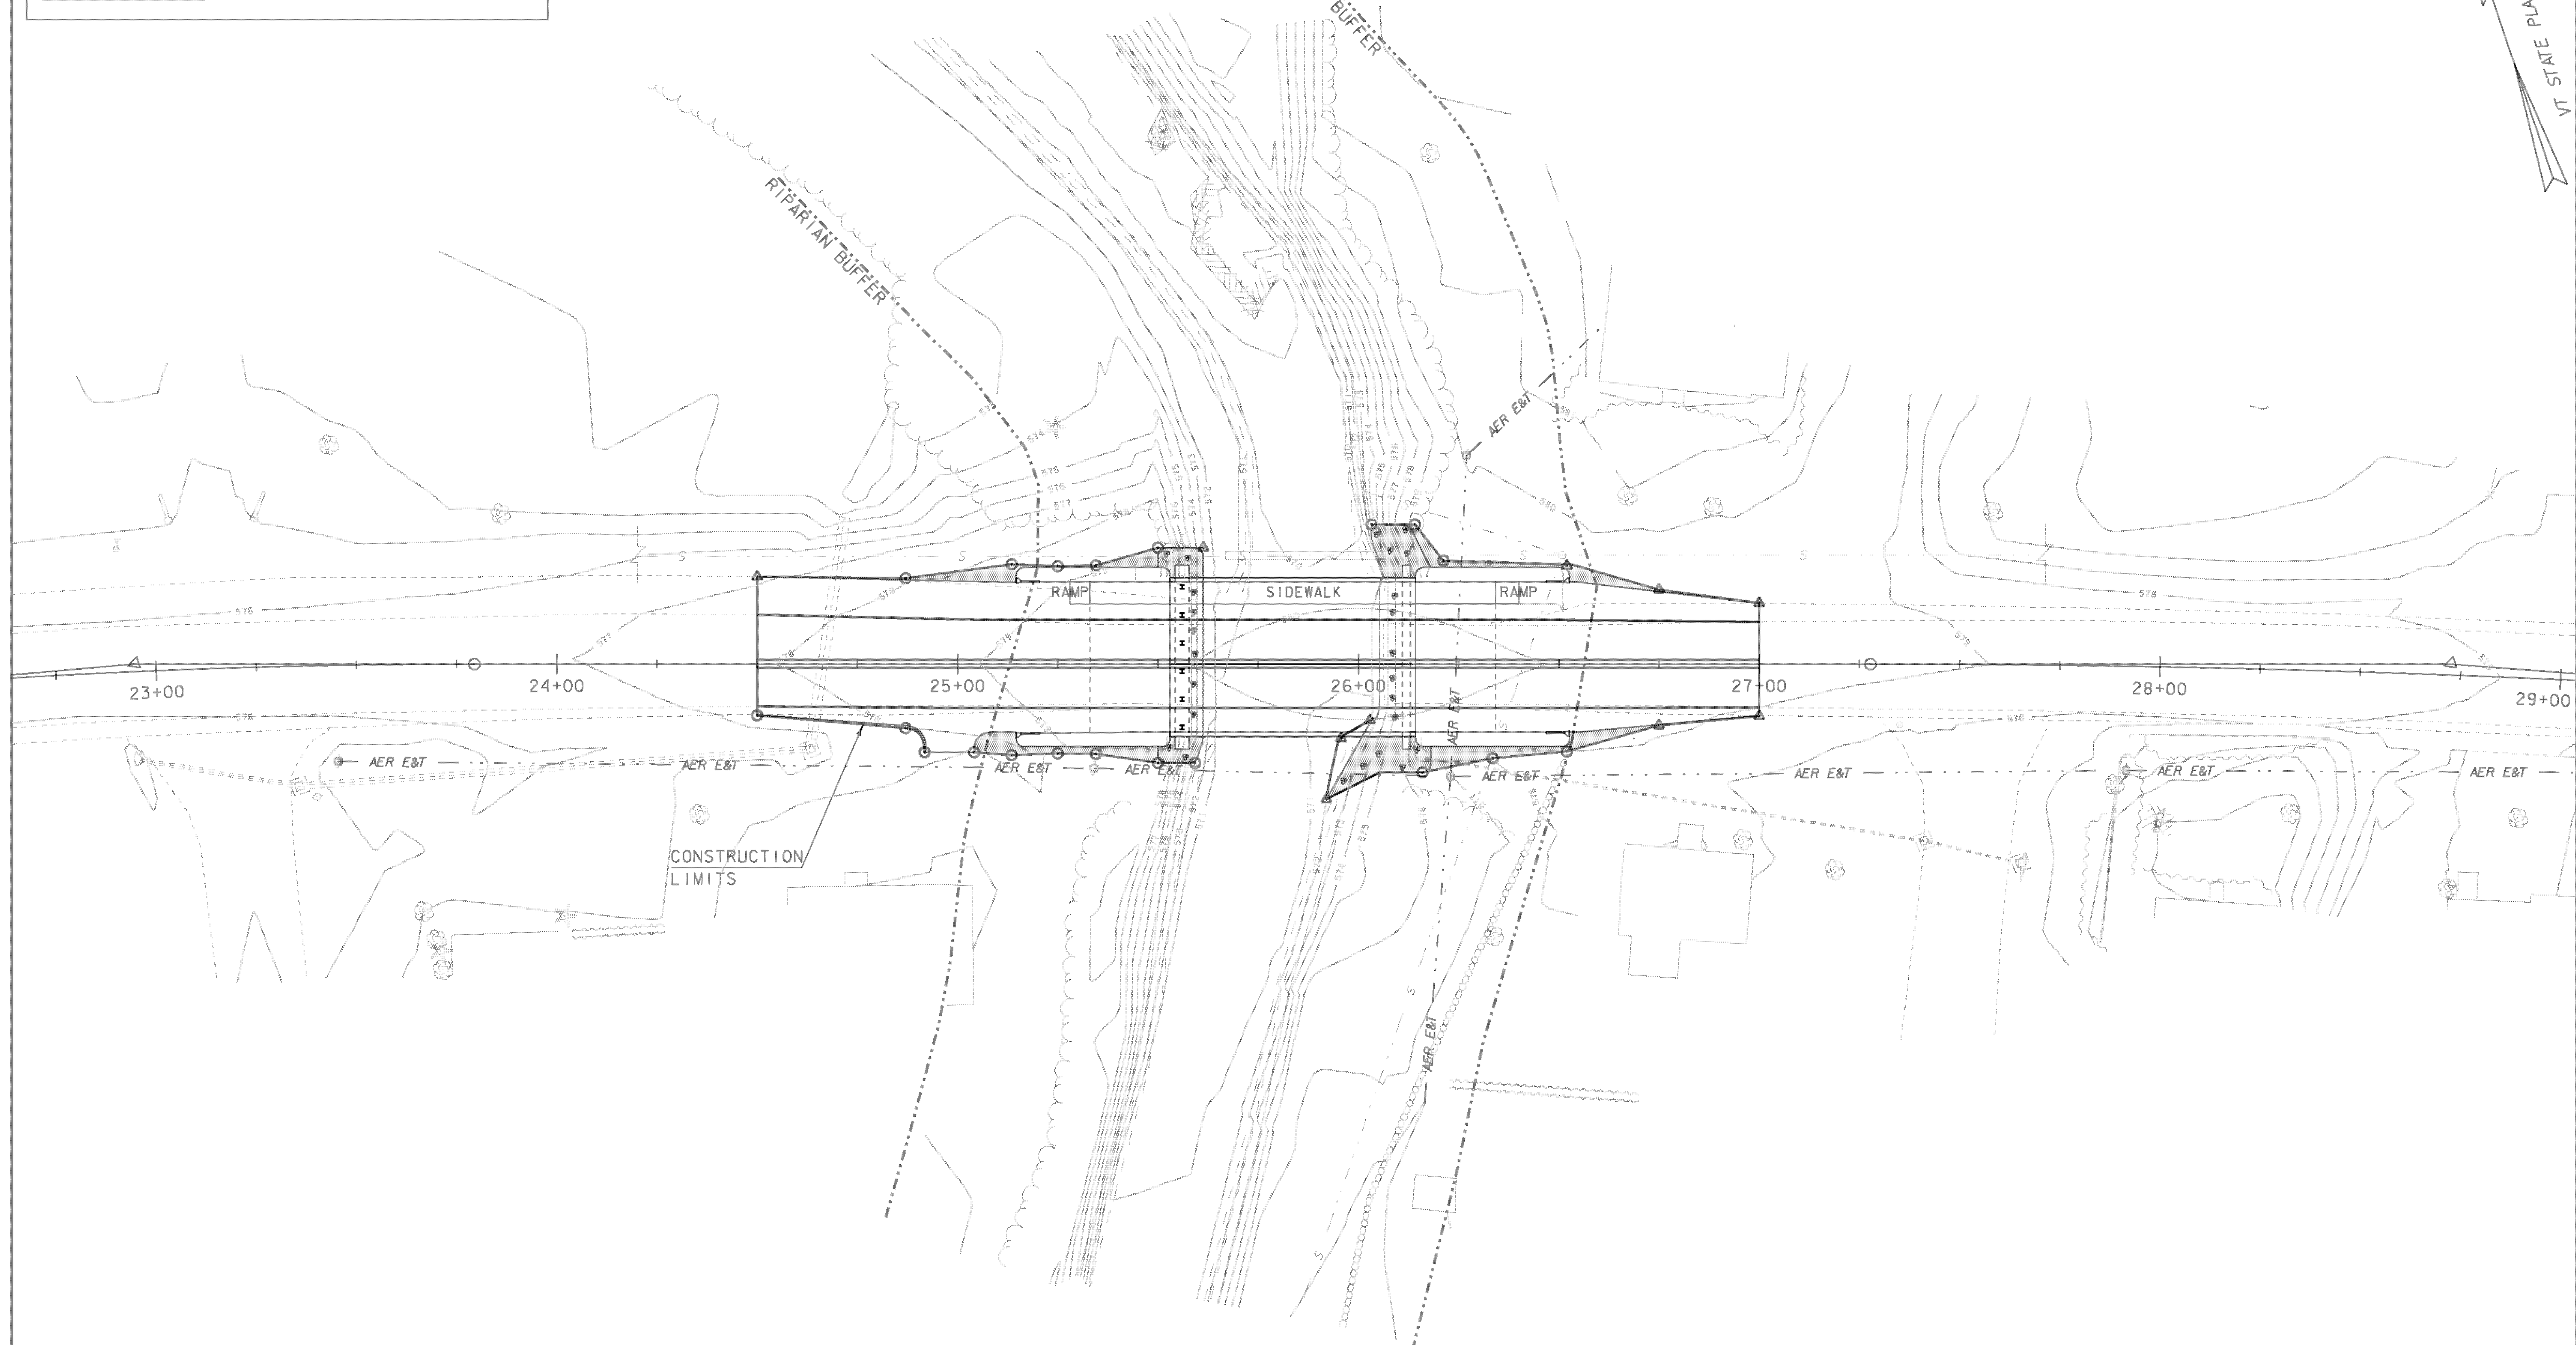


LEGEND

-  RIPARIAN BUFFER ZONE
-  EROSION MATTING
-  SEED AND MULCH

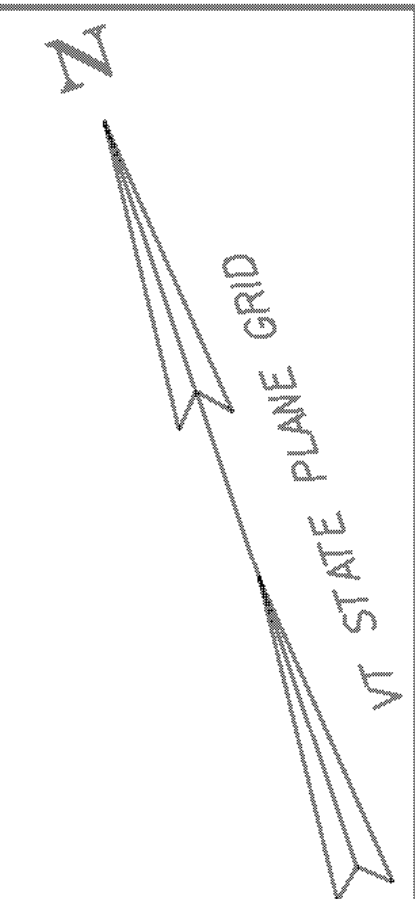

|                                     |                   |             |             |
|-------------------------------------|-------------------|-------------|-------------|
| PROJECT NAME:                       | CHESTER           | PLOT DATE:  | 20-SEP-2010 |
| PROJECT NUMBER:                     | BRF 025-1(28)     | DRAWN BY:   | M.FESSEL    |
| FILE NAME:                          | s84e06lbr_ero.dgn | CHECKED BY: | R.S.YOUNG   |
| PROJECT LEADER:                     | C.P.WILLIAMS      |             |             |
| DESIGNED BY:                        | R.S.YOUNG         |             |             |
| BRIDGE 8 FINAL CONDITIONS SITE PLAN |                   | SHEET       | 49 OF 124   |

SCALE 1" = 20'-0"  
