



24+50

BEGIN APPROACH
STA 24+50.00

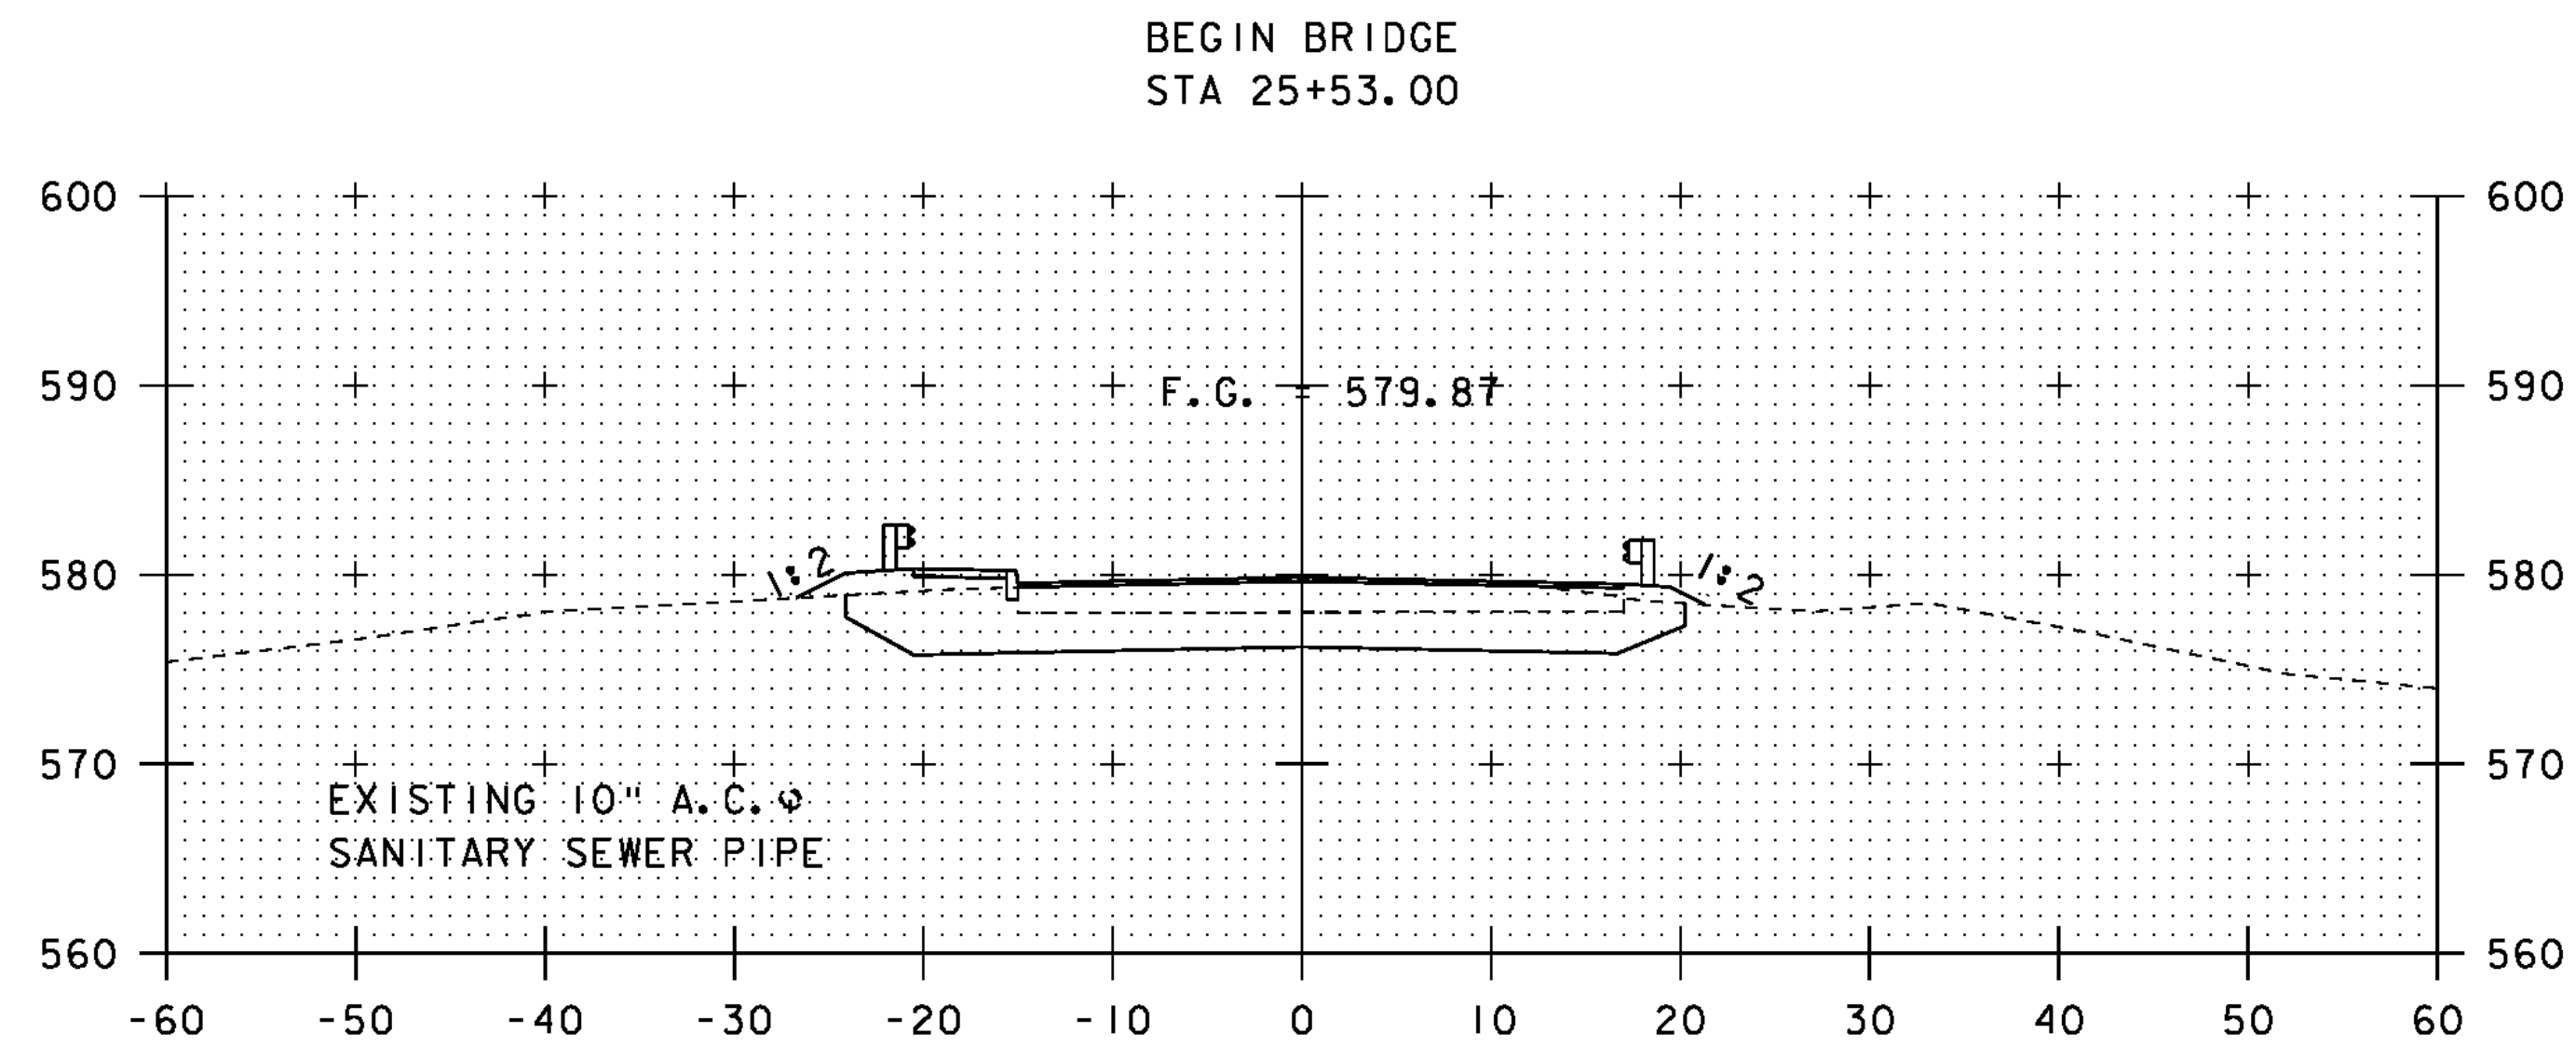


25+50

BEGIN BRIDGE
STA 25+53.00

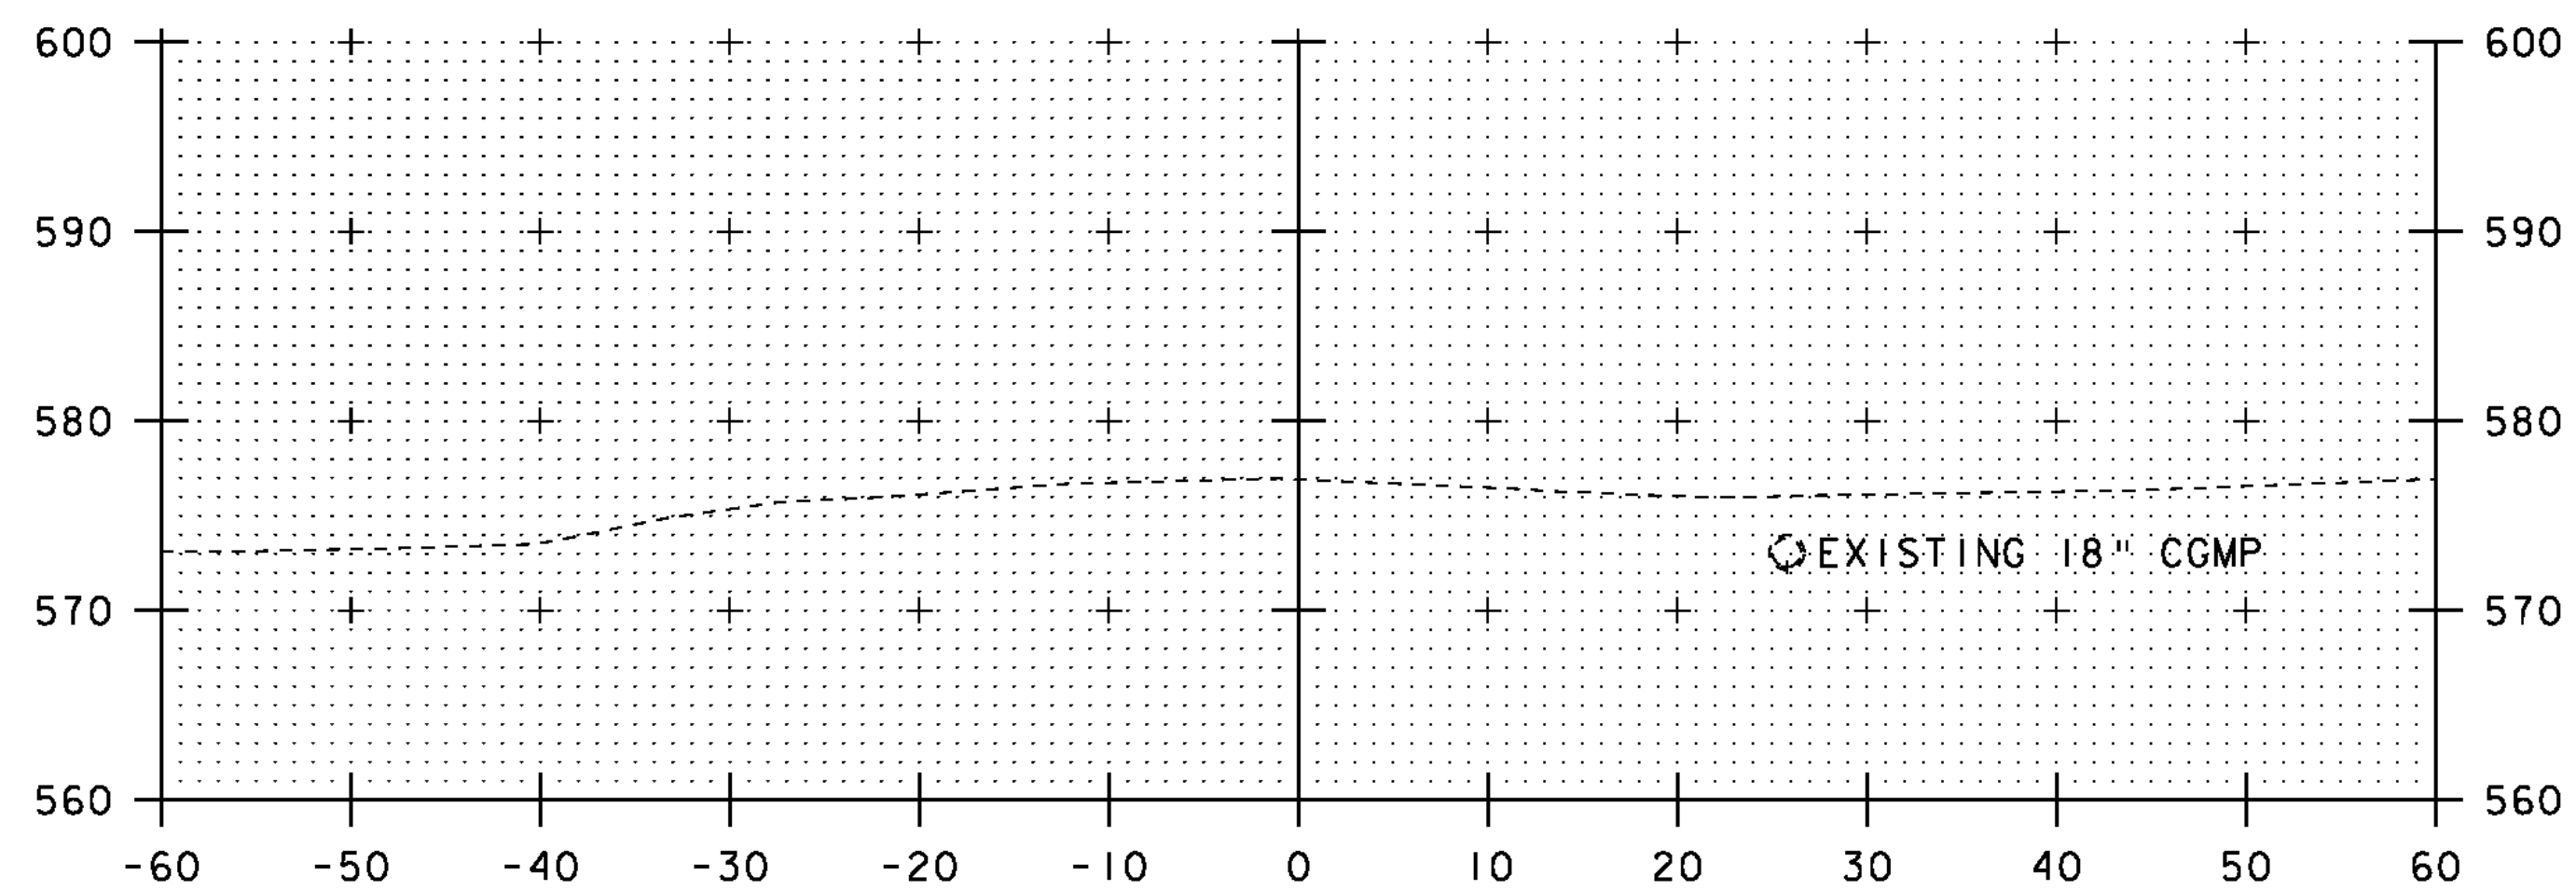

24+00

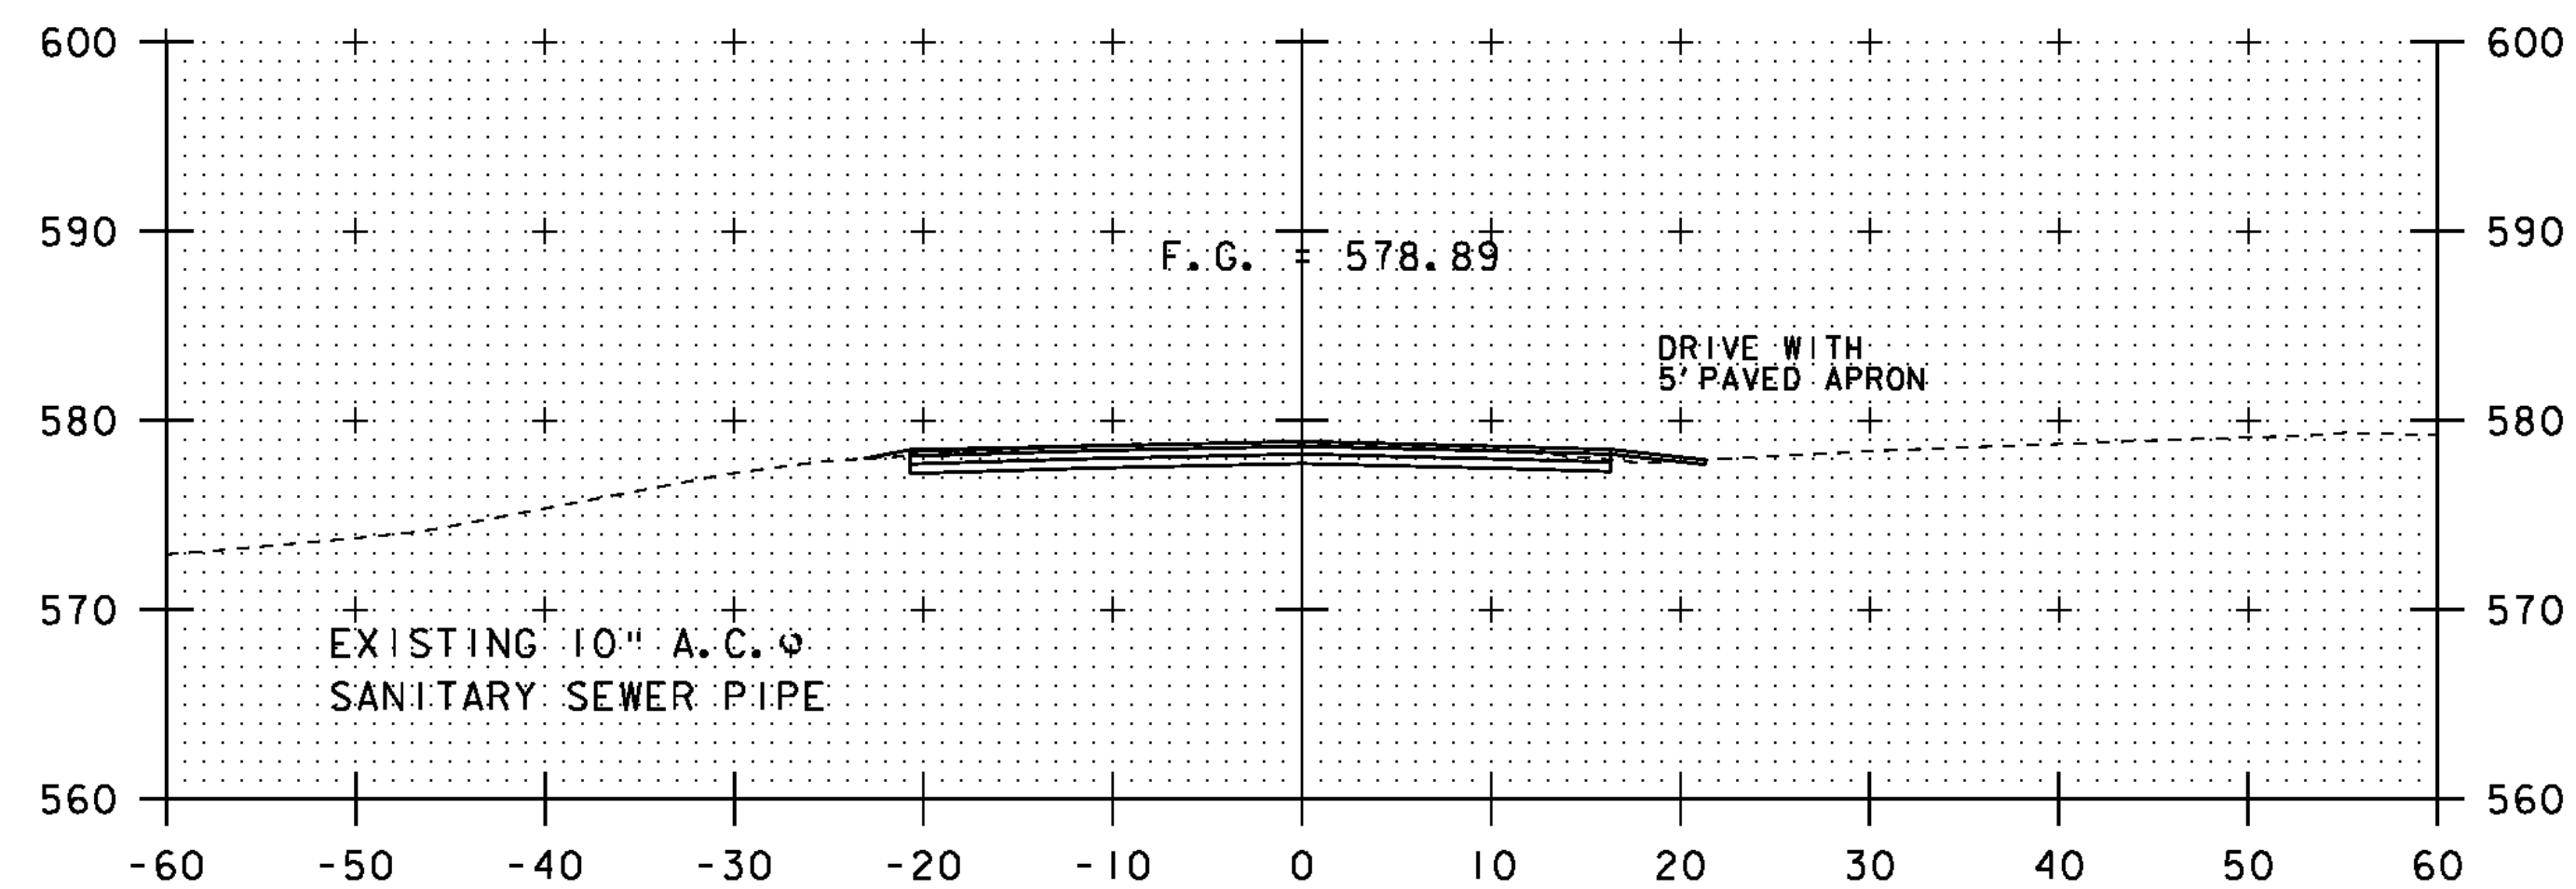

25+00

BEGIN PROJECT

STA. 24+00 TO STA. 25+50

SCALE 1" = 10'-0"
10 0 10

PROJECT NAME: CHESTER
PROJECT NUMBER: BRF 025-1(28)

FILE NAME: s84e061/Str/xsl.dgn
PROJECT LEADER: C.P.WILLIAMS
DESIGNED BY: R.S.YOUNG
BRIDGE 8 MAINLINE CROSS SECTIONS 1

PLOT DATE: 20-SEP-2010
DRAWN BY: M.FESSEL
CHECKED BY: R.S.YOUNG
SHEET 52 OF 124