



26+50  
 END PROJECT  
 STA 26+50.00

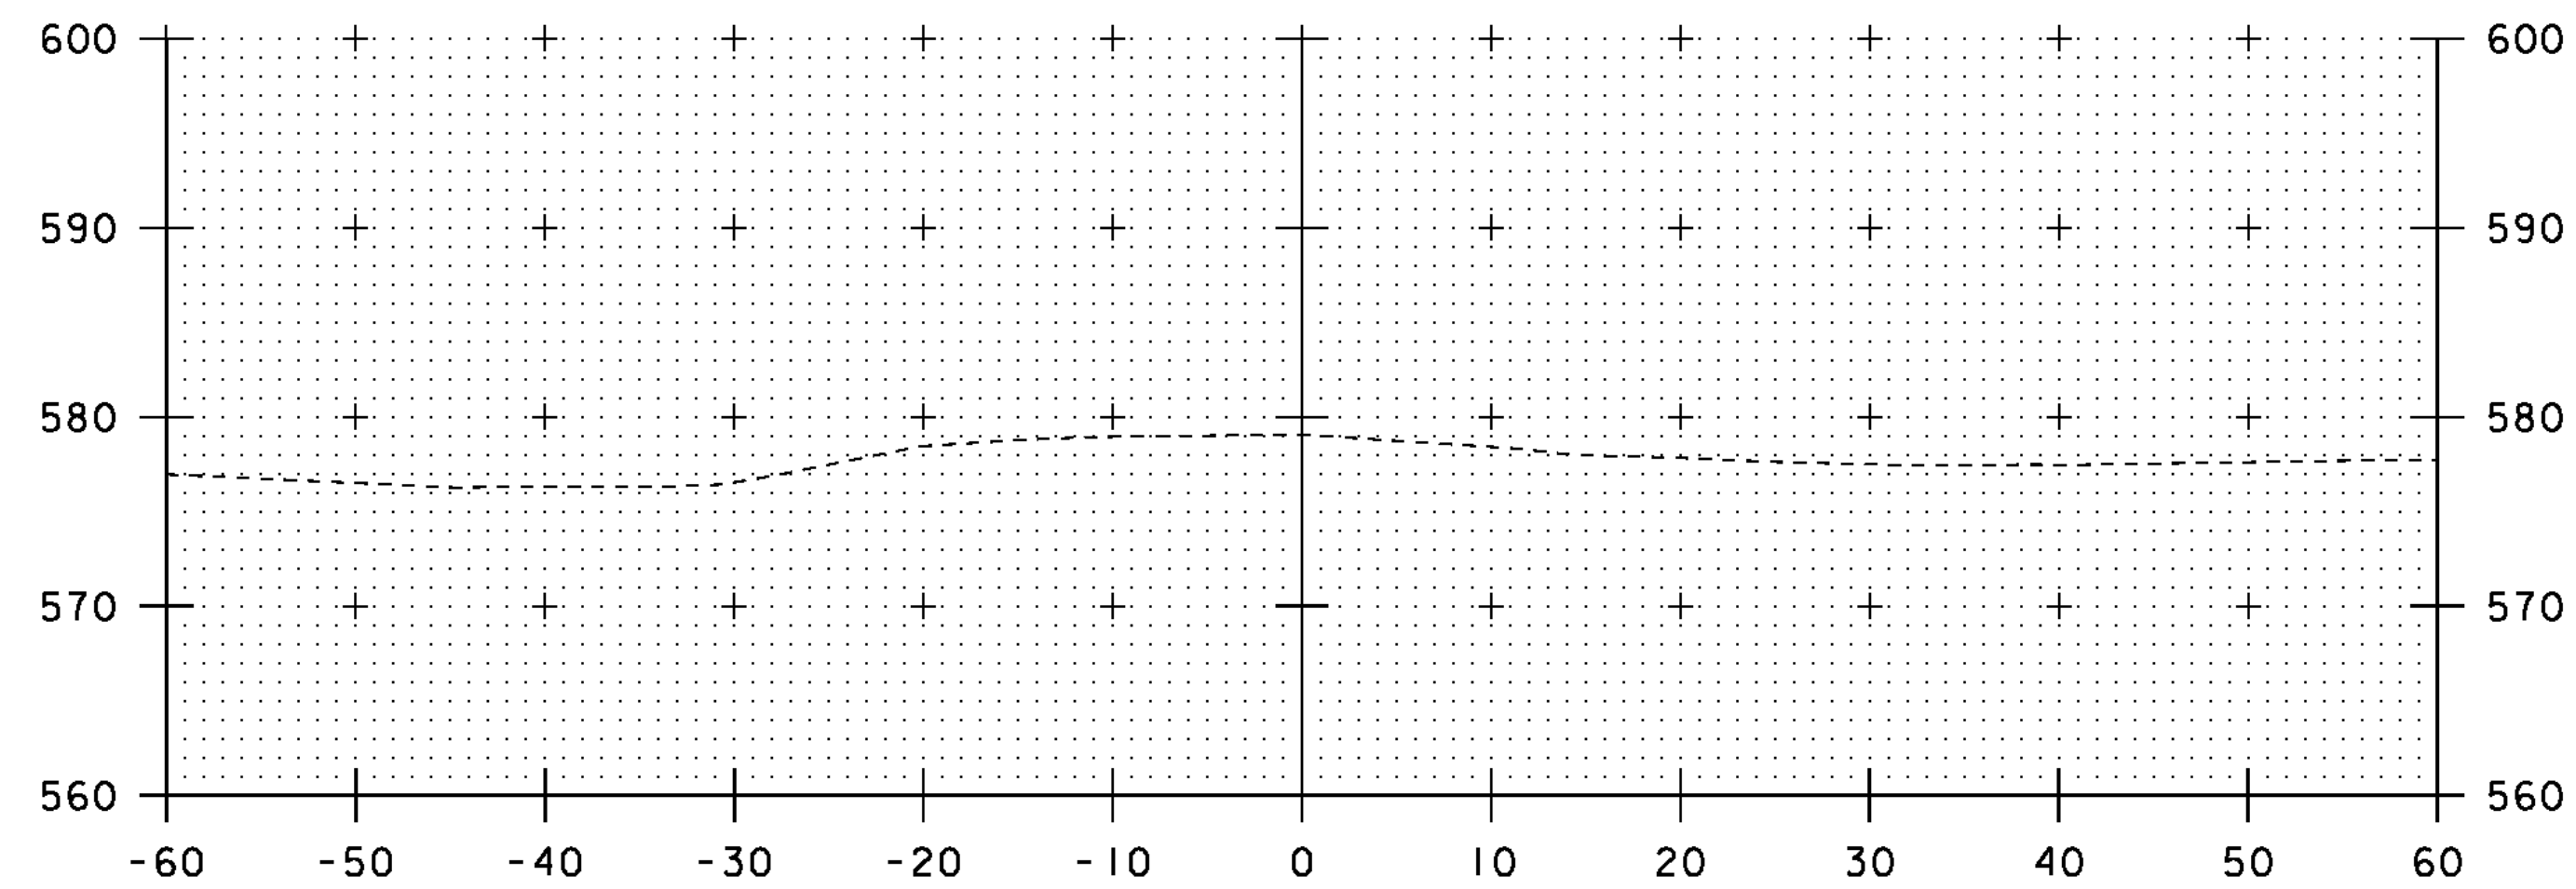


27+50

END BRIDGE  
 STA 26+14.25

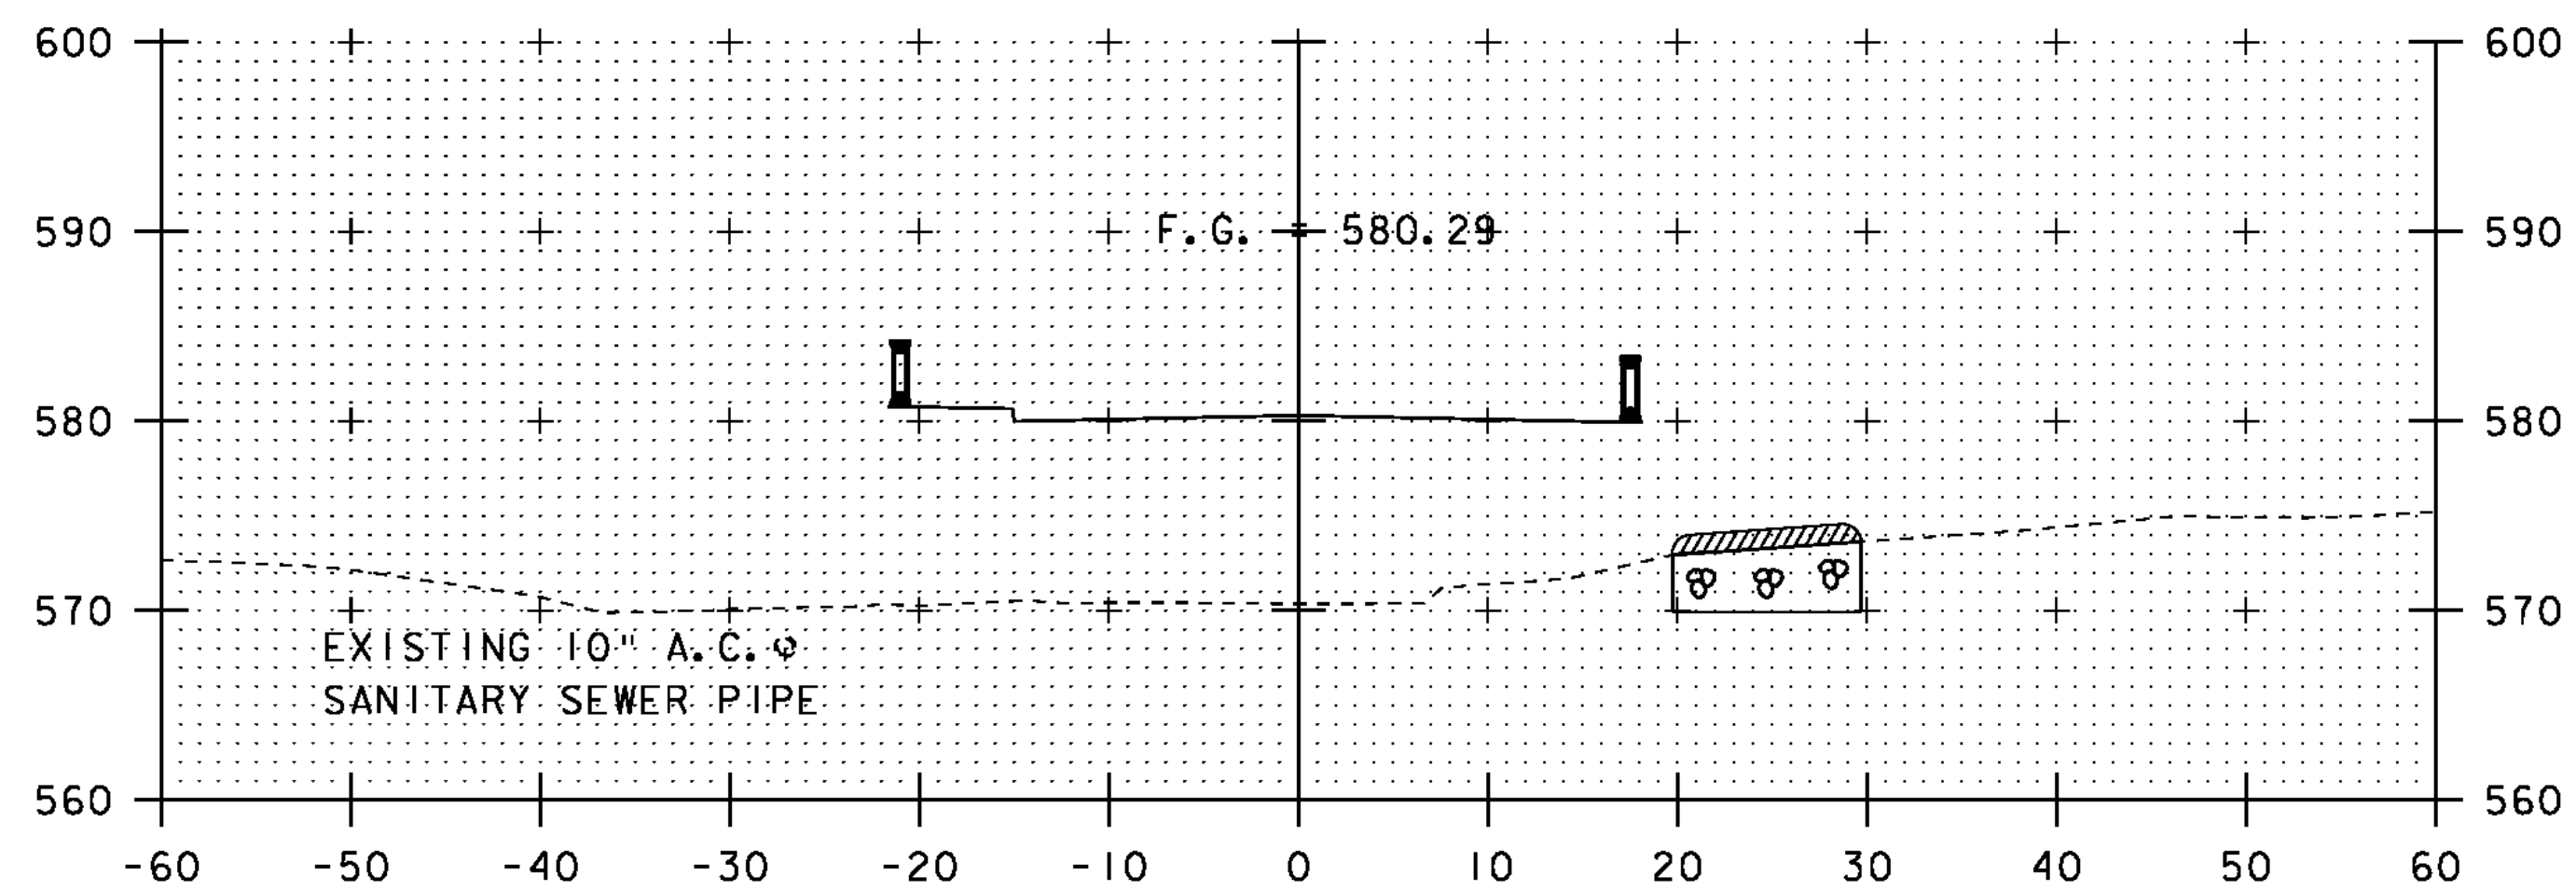

26+00

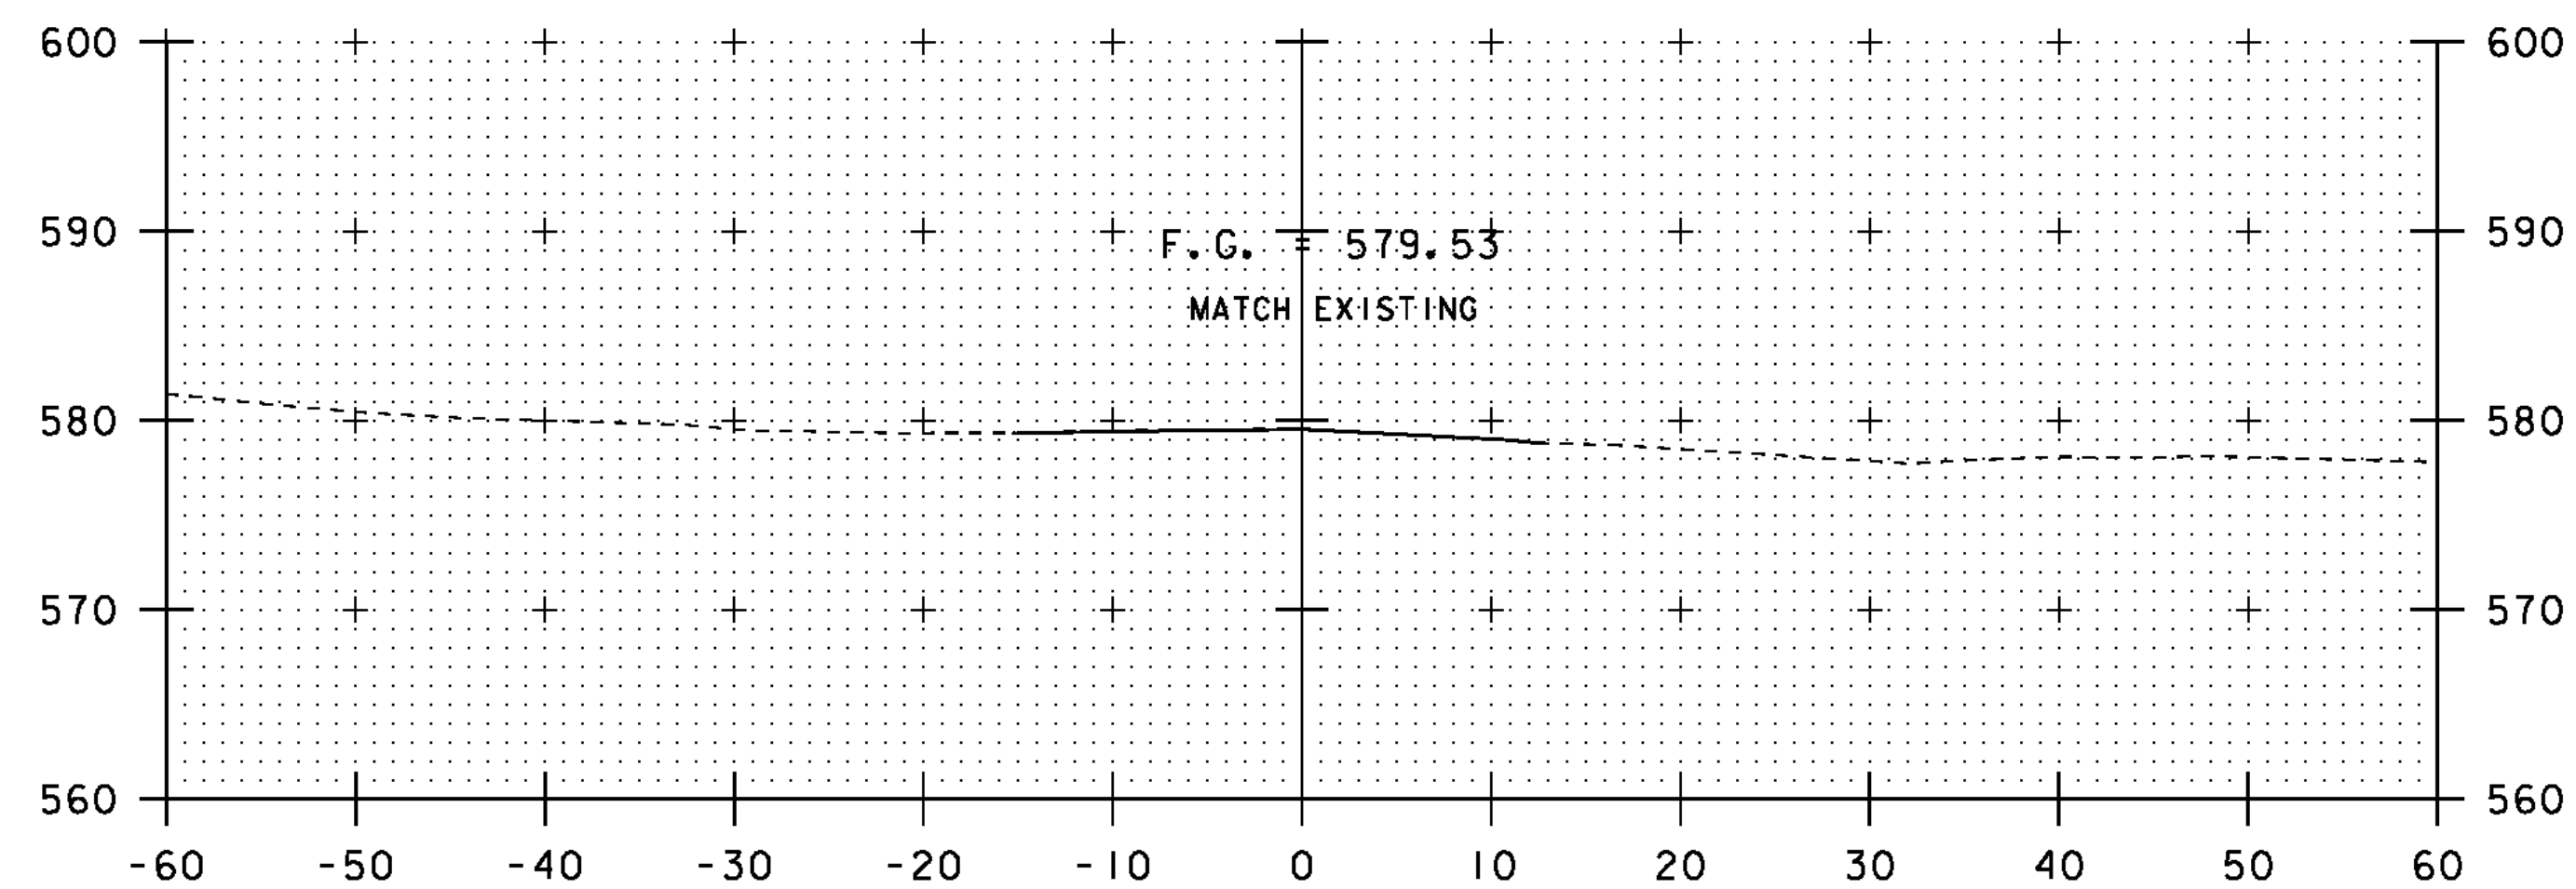

27+00

END APPROACH  
 STA 27+00.00

STA. 26+00 TO STA. 27+50

SCALE 1" = 10' - 0  
 10 0 10

PROJECT NAME: CHESTER  
 PROJECT NUMBER: BRF 025-1(28)

FILE NAME: s84e061/Str/xsl.dgn PLOT DATE: 20-SEP-2010  
 PROJECT LEADER: C.P.WILLIAMS DRAWN BY: M.FESSEL  
 DESIGNED BY: R.S.YOUNG CHECKED BY: R.S.YOUNG  
 BRIDGE 8 MAINLINE CROSS SECTIONS 2 SHEET 53 OF 124