


10+25

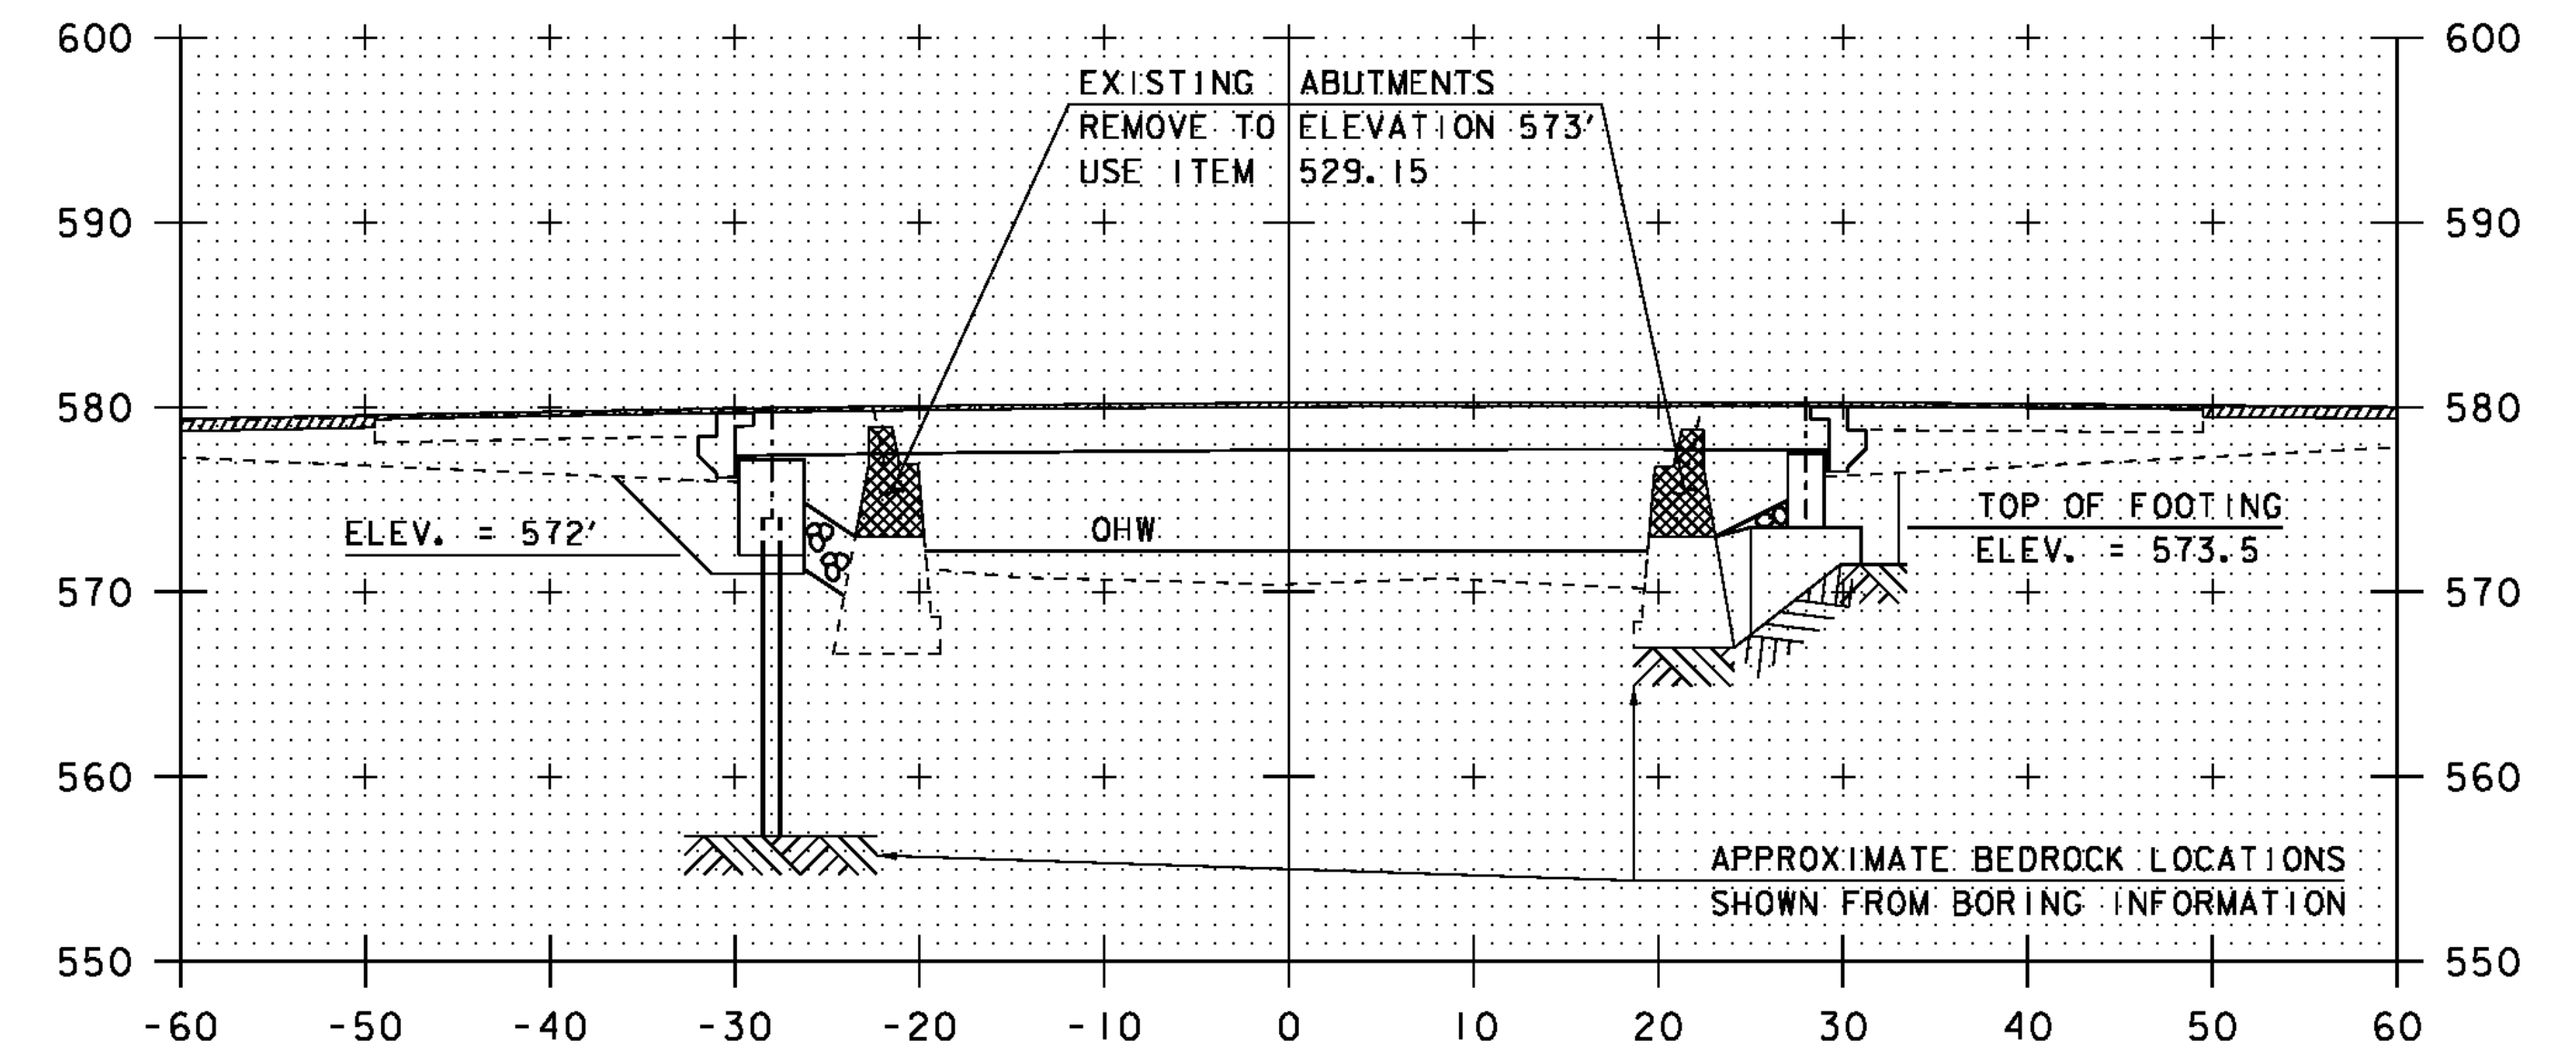


10+75


BEGIN STONE FILL, TYPE III  
 GEOTEXTILE UNDER STONE FILL  
 GRUBBING MATERIAL  
 UNCLASSIFIED CHANNEL EXCAVATION  
 STA 10+50.35 LT

END GRUBBING MATERIAL  
 STA 10+57.00 LT AND RT

END REMOVAL OF GRAVEL BAR  
 STA 10+61.00 RT

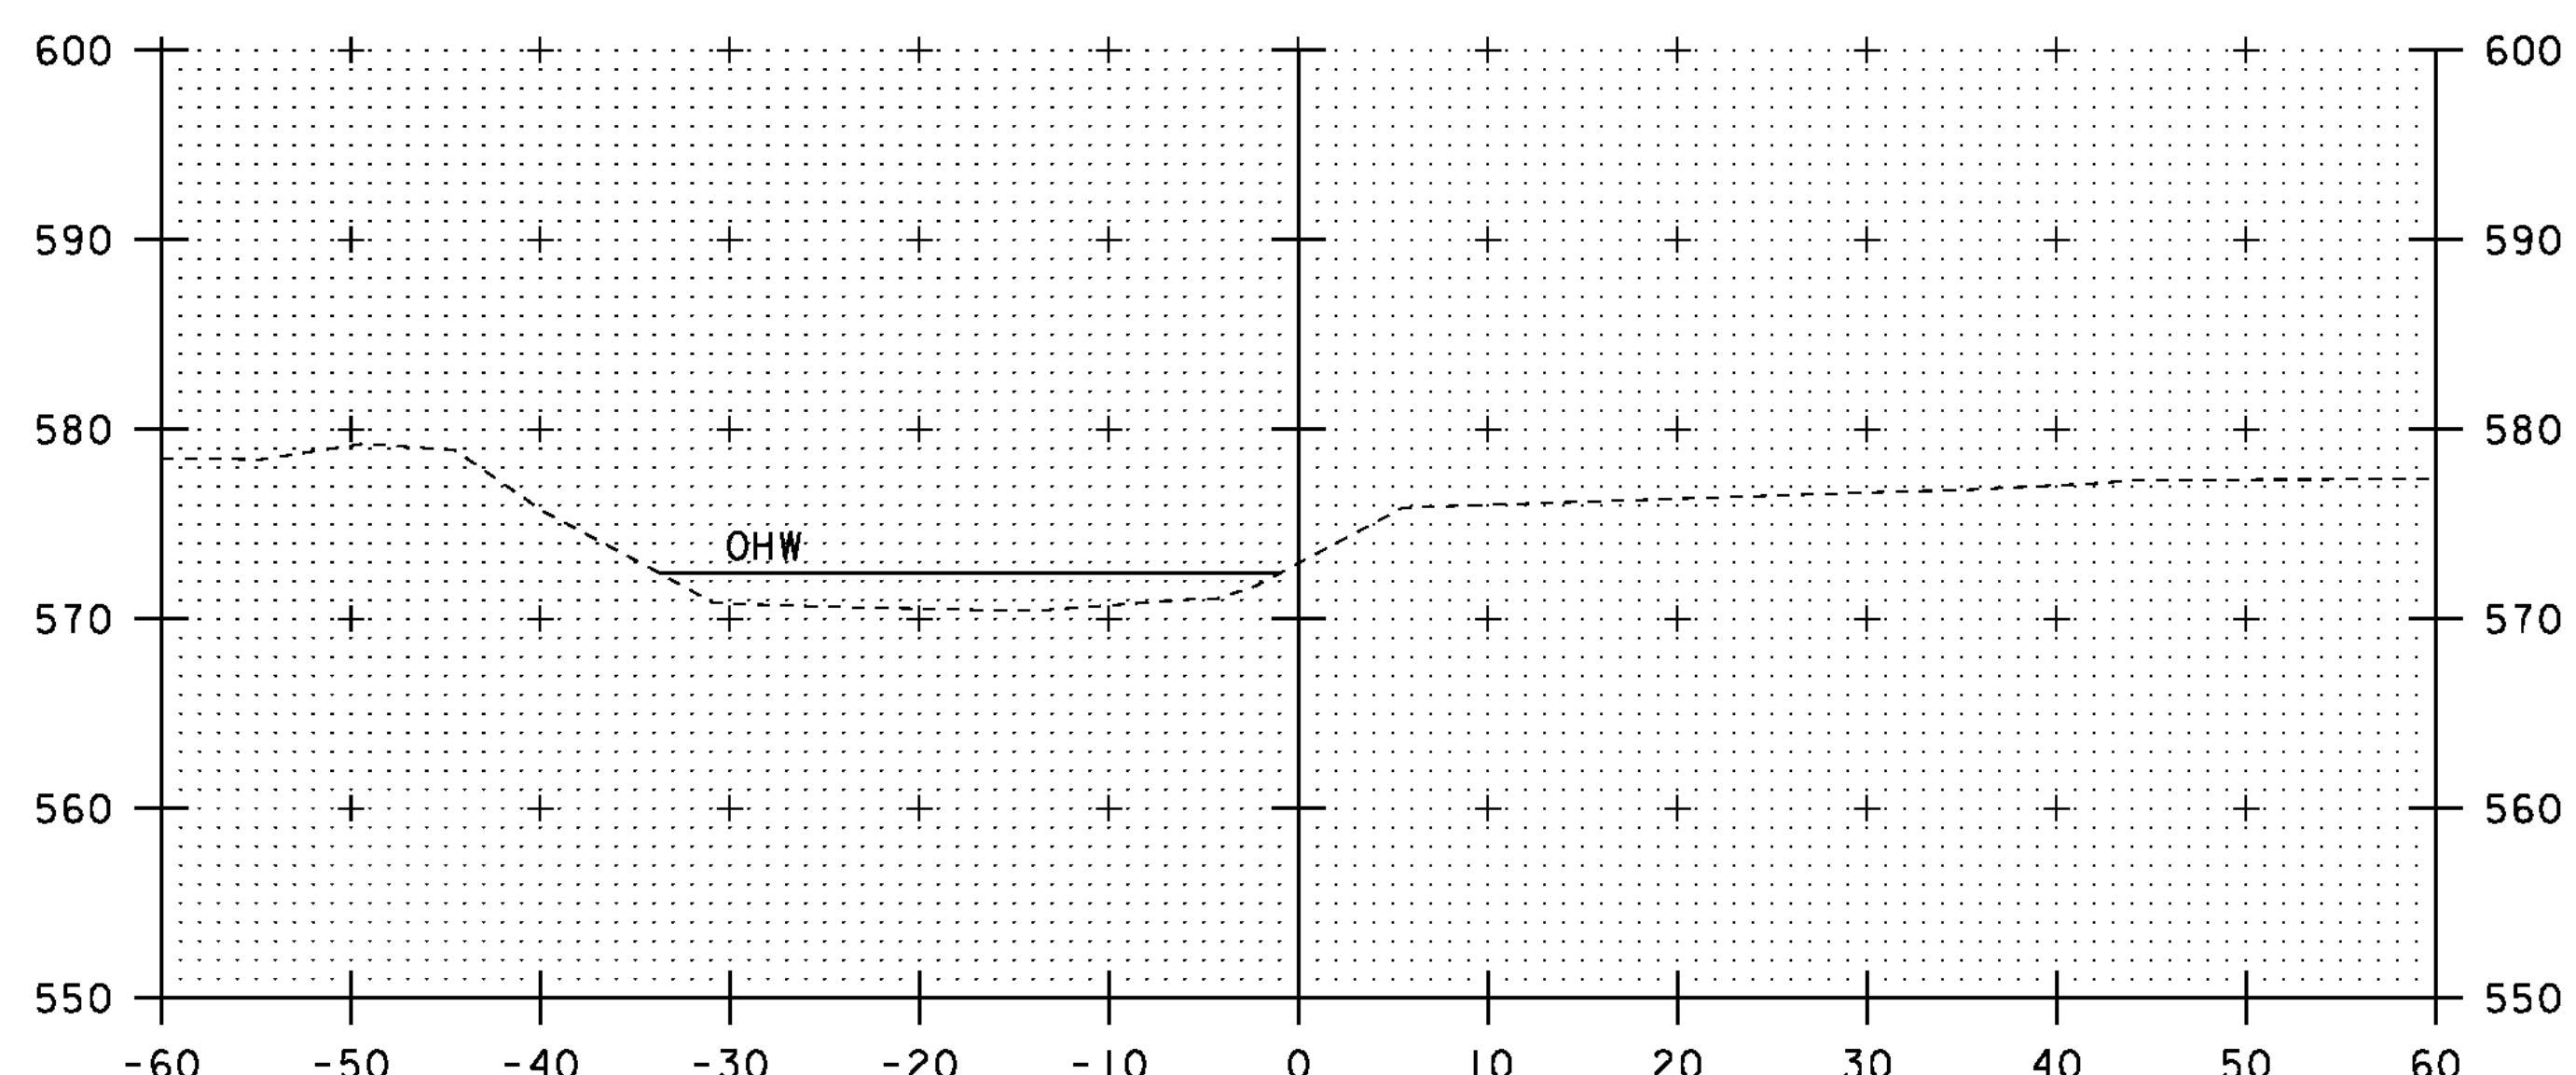


10+00

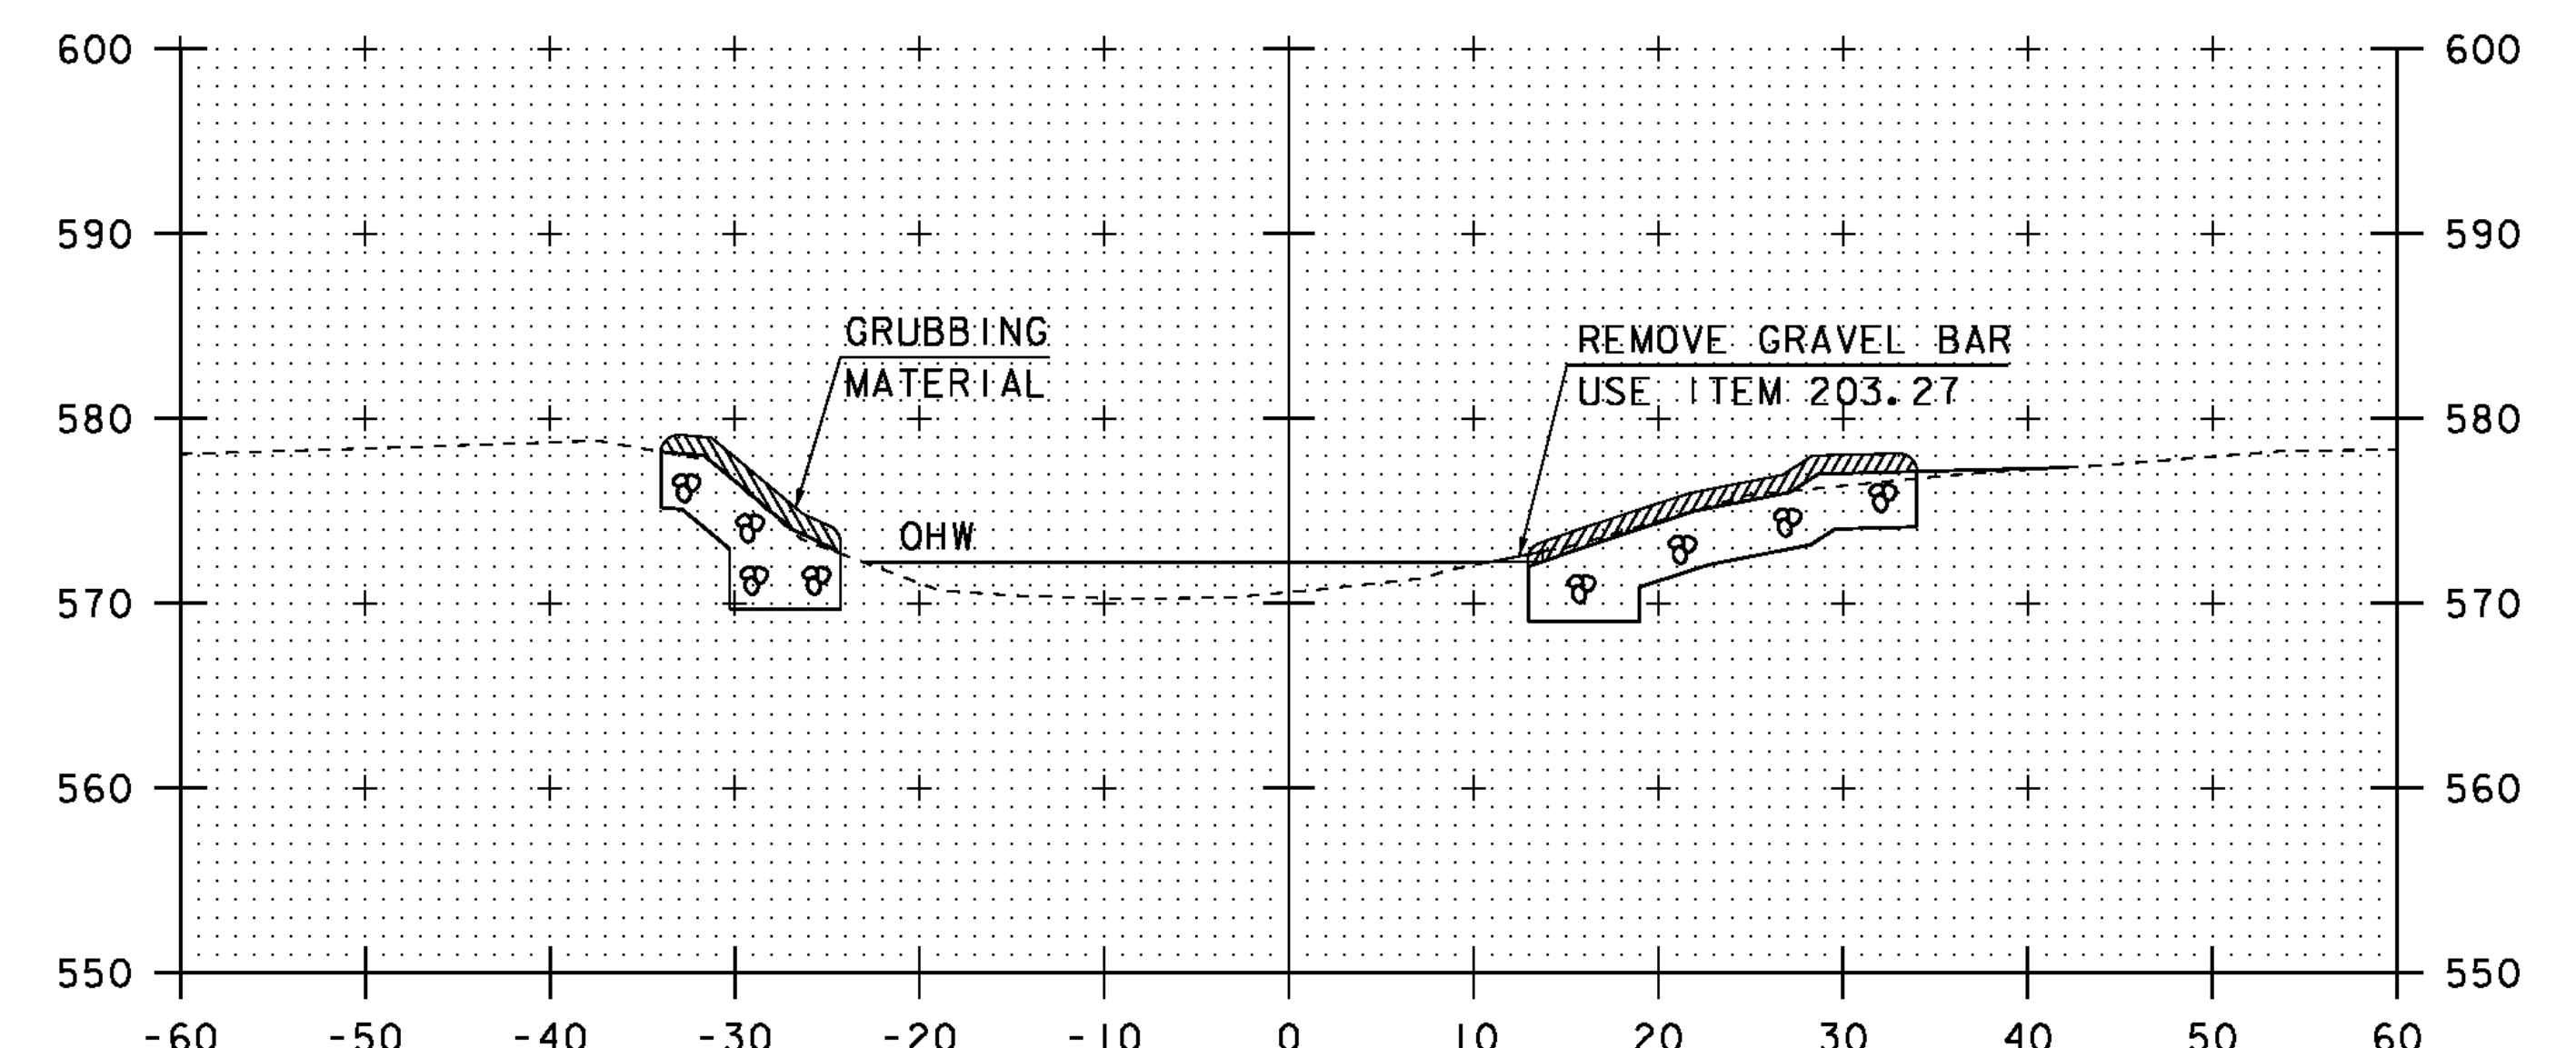

10+50

BEGIN REMOVAL OF GRAVEL BAR  
 STONE FILL, TYPE III  
 GEOTEXTILE UNDER STONE FILL  
 GRUBBING MATERIAL  
 STA 10+41.30 RT  
 UNCLASSIFIED CHANNEL EXCAVATION  
 STA 10+48.00 RT

STA. 10+00 TO STA. 10+75

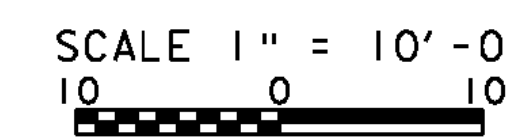

PROJECT NAME: CHESTER  
 PROJECT NUMBER: BRF 025-1(28)

FILE NAME: s84e061/Str/xsl.dgn  
 PROJECT LEADER: C.P.WILLIAMS  
 DESIGNED BY: R.S.YOUNG  
 BRIDGE 8 CHANNEL CROSS SECTIONS I

PLOT DATE: 20-SEP-2010  
 DRAWN BY: M.FESSEL  
 CHECKED BY: R.S.YOUNG  
 SHEET 54 OF 124