



END STONE FILL, TYPE III  
 GEOTEXTILE UNDER STONE FILL  
 GRUBBING MATERIAL  
 UNCLASSIFIED CHANNEL EXCAVATION  
 STA 11+04.00 LT

11+25

END STONE FILL, TYPE III  
 GEOTEXTILE UNDER STONE FILL  
 GRUBBING MATERIAL  
 UNCLASSIFIED CHANNEL EXCAVATION  
 STA 11+10.00 RT

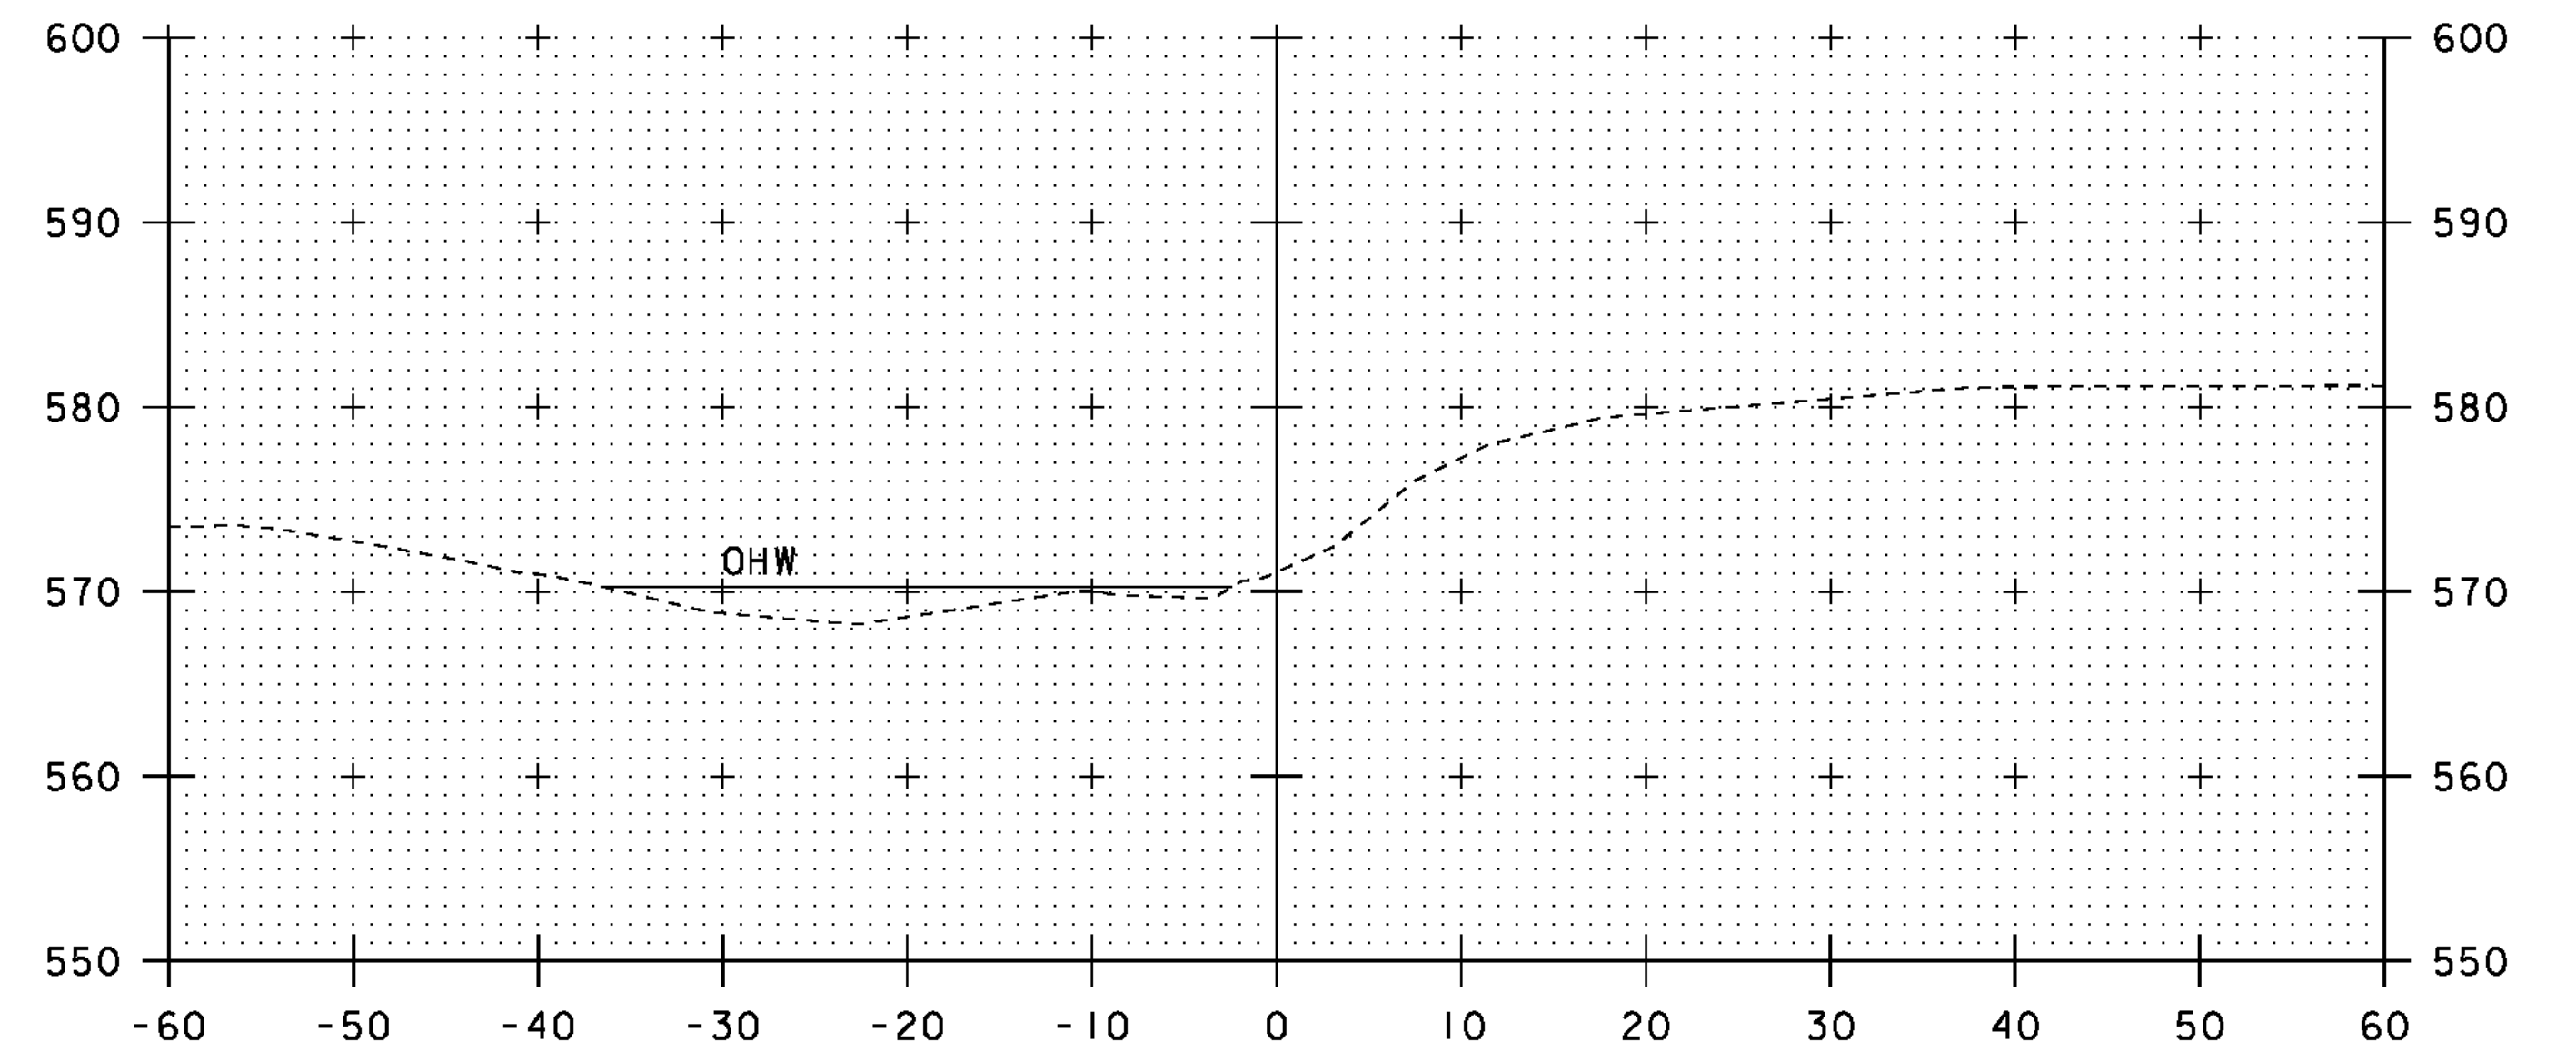


11+75

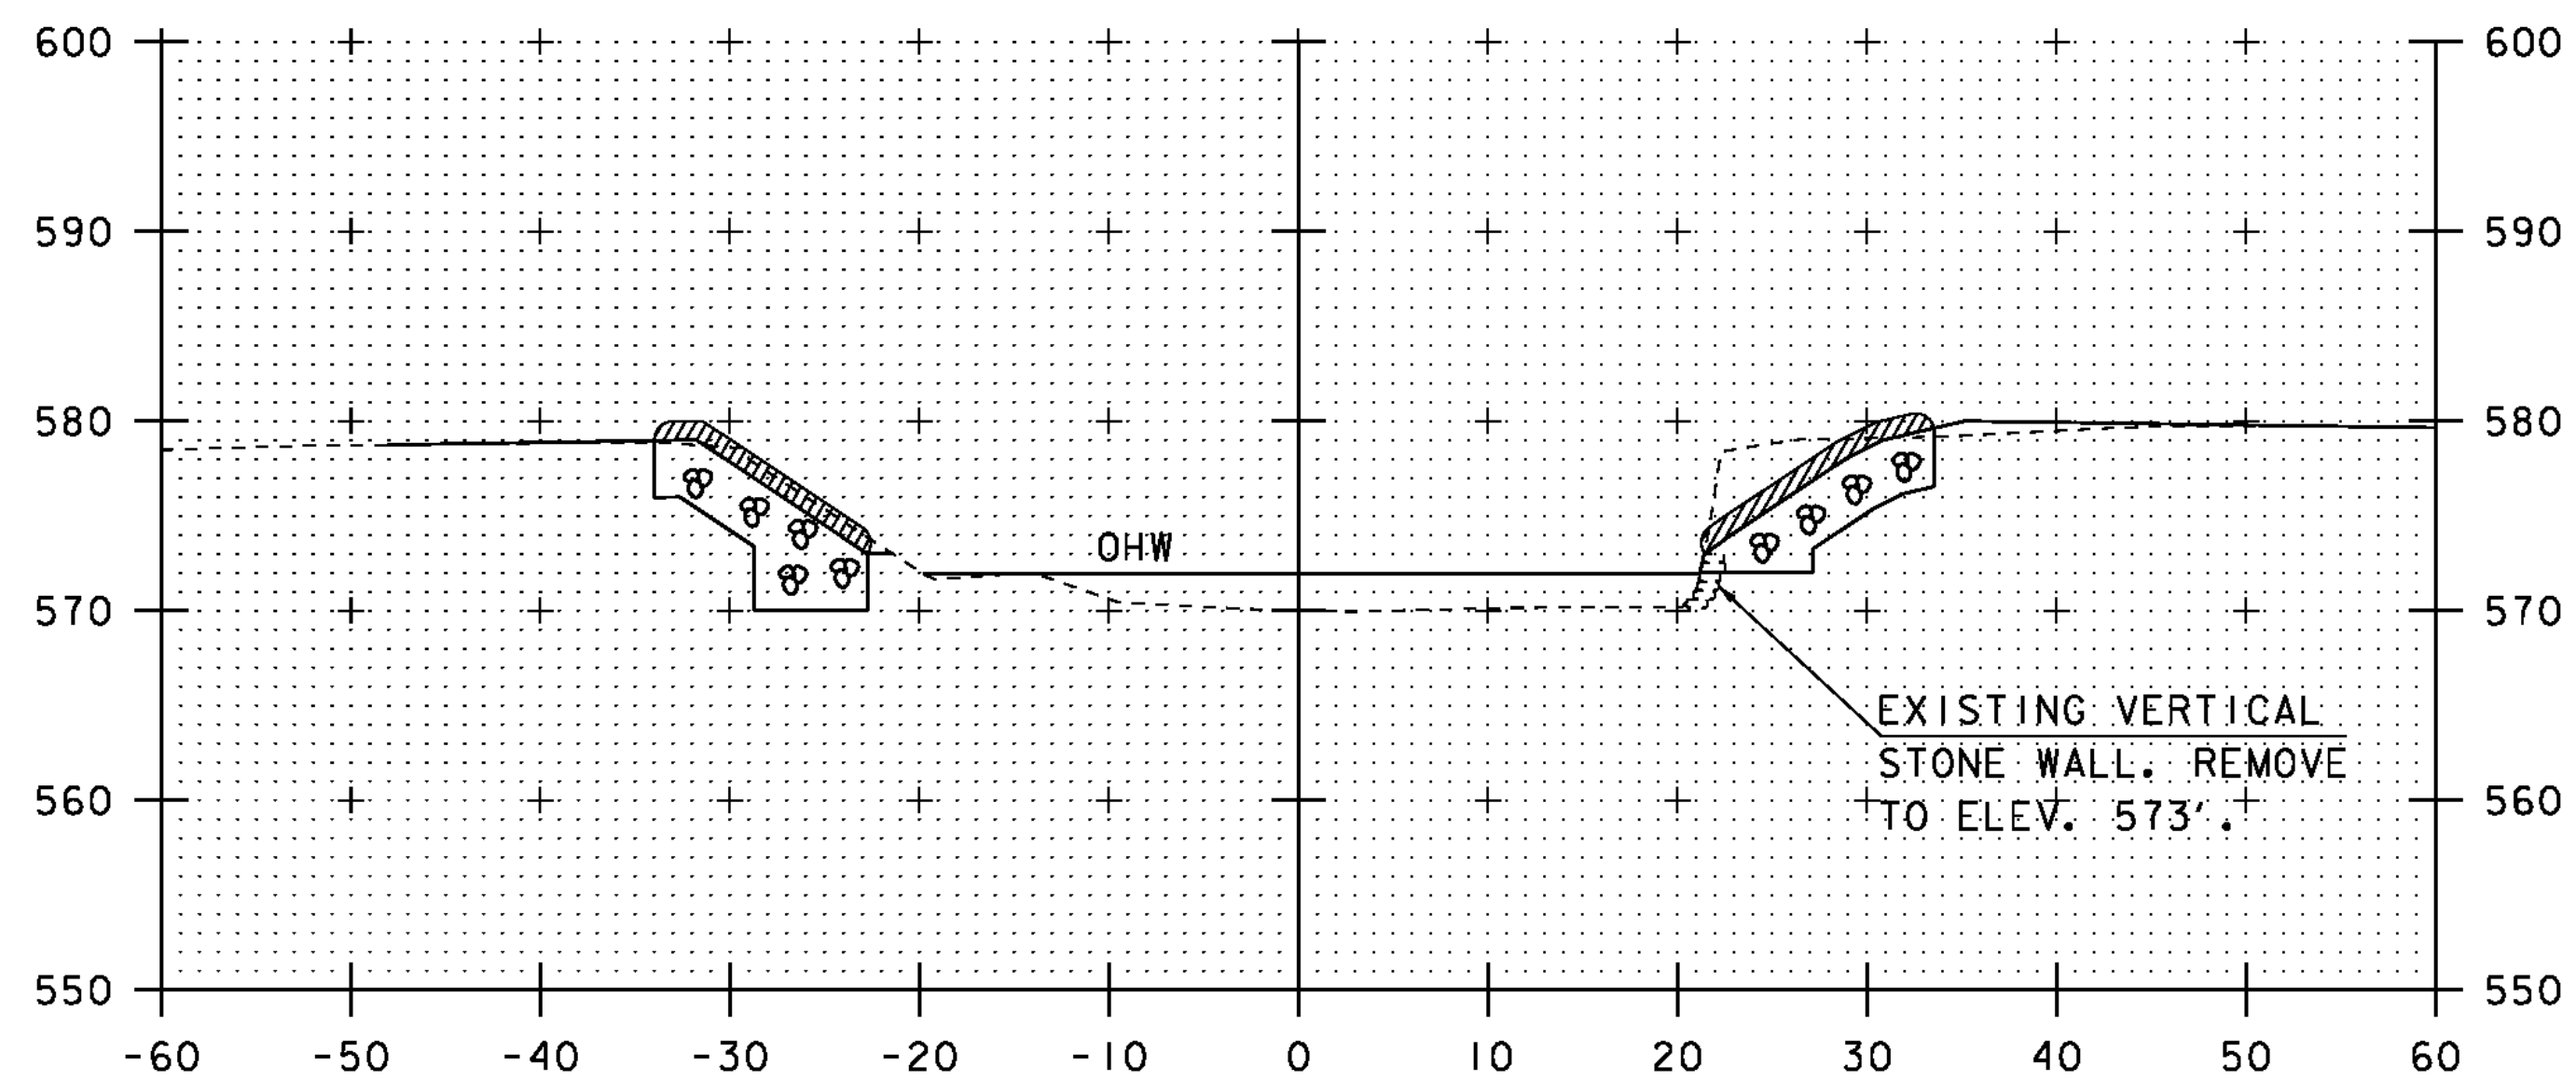

11+00

BEGIN GRUBBING MATERIAL  
 STA 10+96.50 LT AND RT

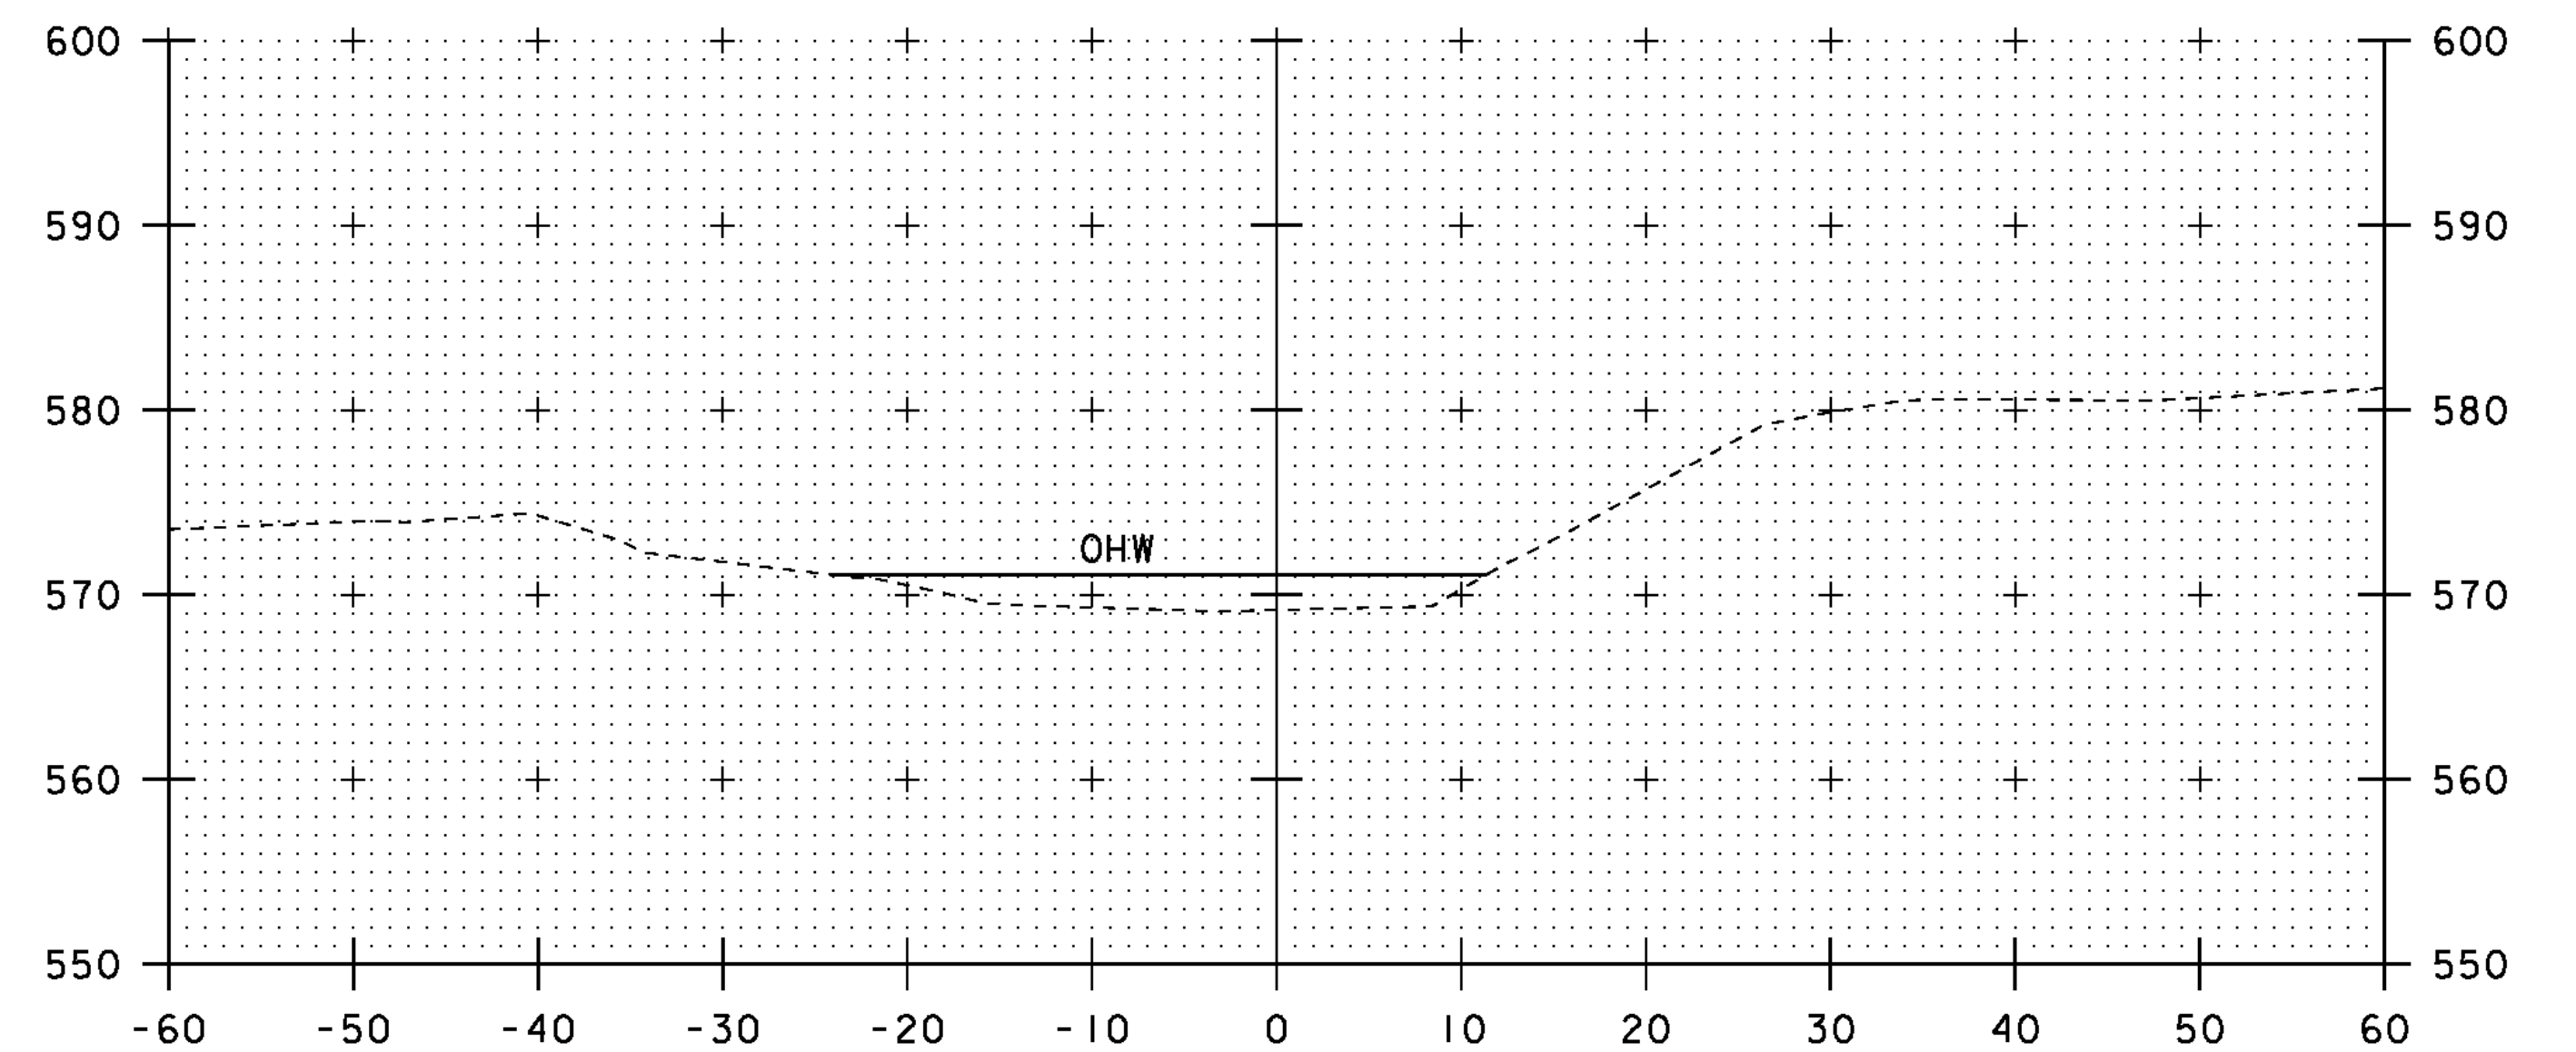

11+50

STA. 11+00 TO STA. 11+75

SCALE 1" = 10' - 0  
 10 0 10

PROJECT NAME: CHESTER  
 PROJECT NUMBER: BRF 025-1(28)

FILE NAME: s84e061/Str/xsl.dgn  
 PROJECT LEADER: C.P.WILLIAMS  
 DESIGNED BY: R.S.YOUNG  
 BRIDGE 8 CHANNEL CROSS SECTIONS 2

PLOT DATE: 20-SEP-2010  
 DRAWN BY: M.FESSEL  
 CHECKED BY: R.S.YOUNG  
 SHEET 55 OF 124