


TYPICAL ROADWAY SECTION
SCALE 1" = 3'-0"

** 1/4" TYPE IV OVER
1/4" TYPE IV OVER
2 1/2" TYPE II OVER
2 1/2" TYPE II

NOTE:
PAVEMENT SHALL BE A MARSHALL MIX PAID
FOR UNDER THE ITEM 406.25, "BITUMINOUS CONCRETE PAVEMENT".

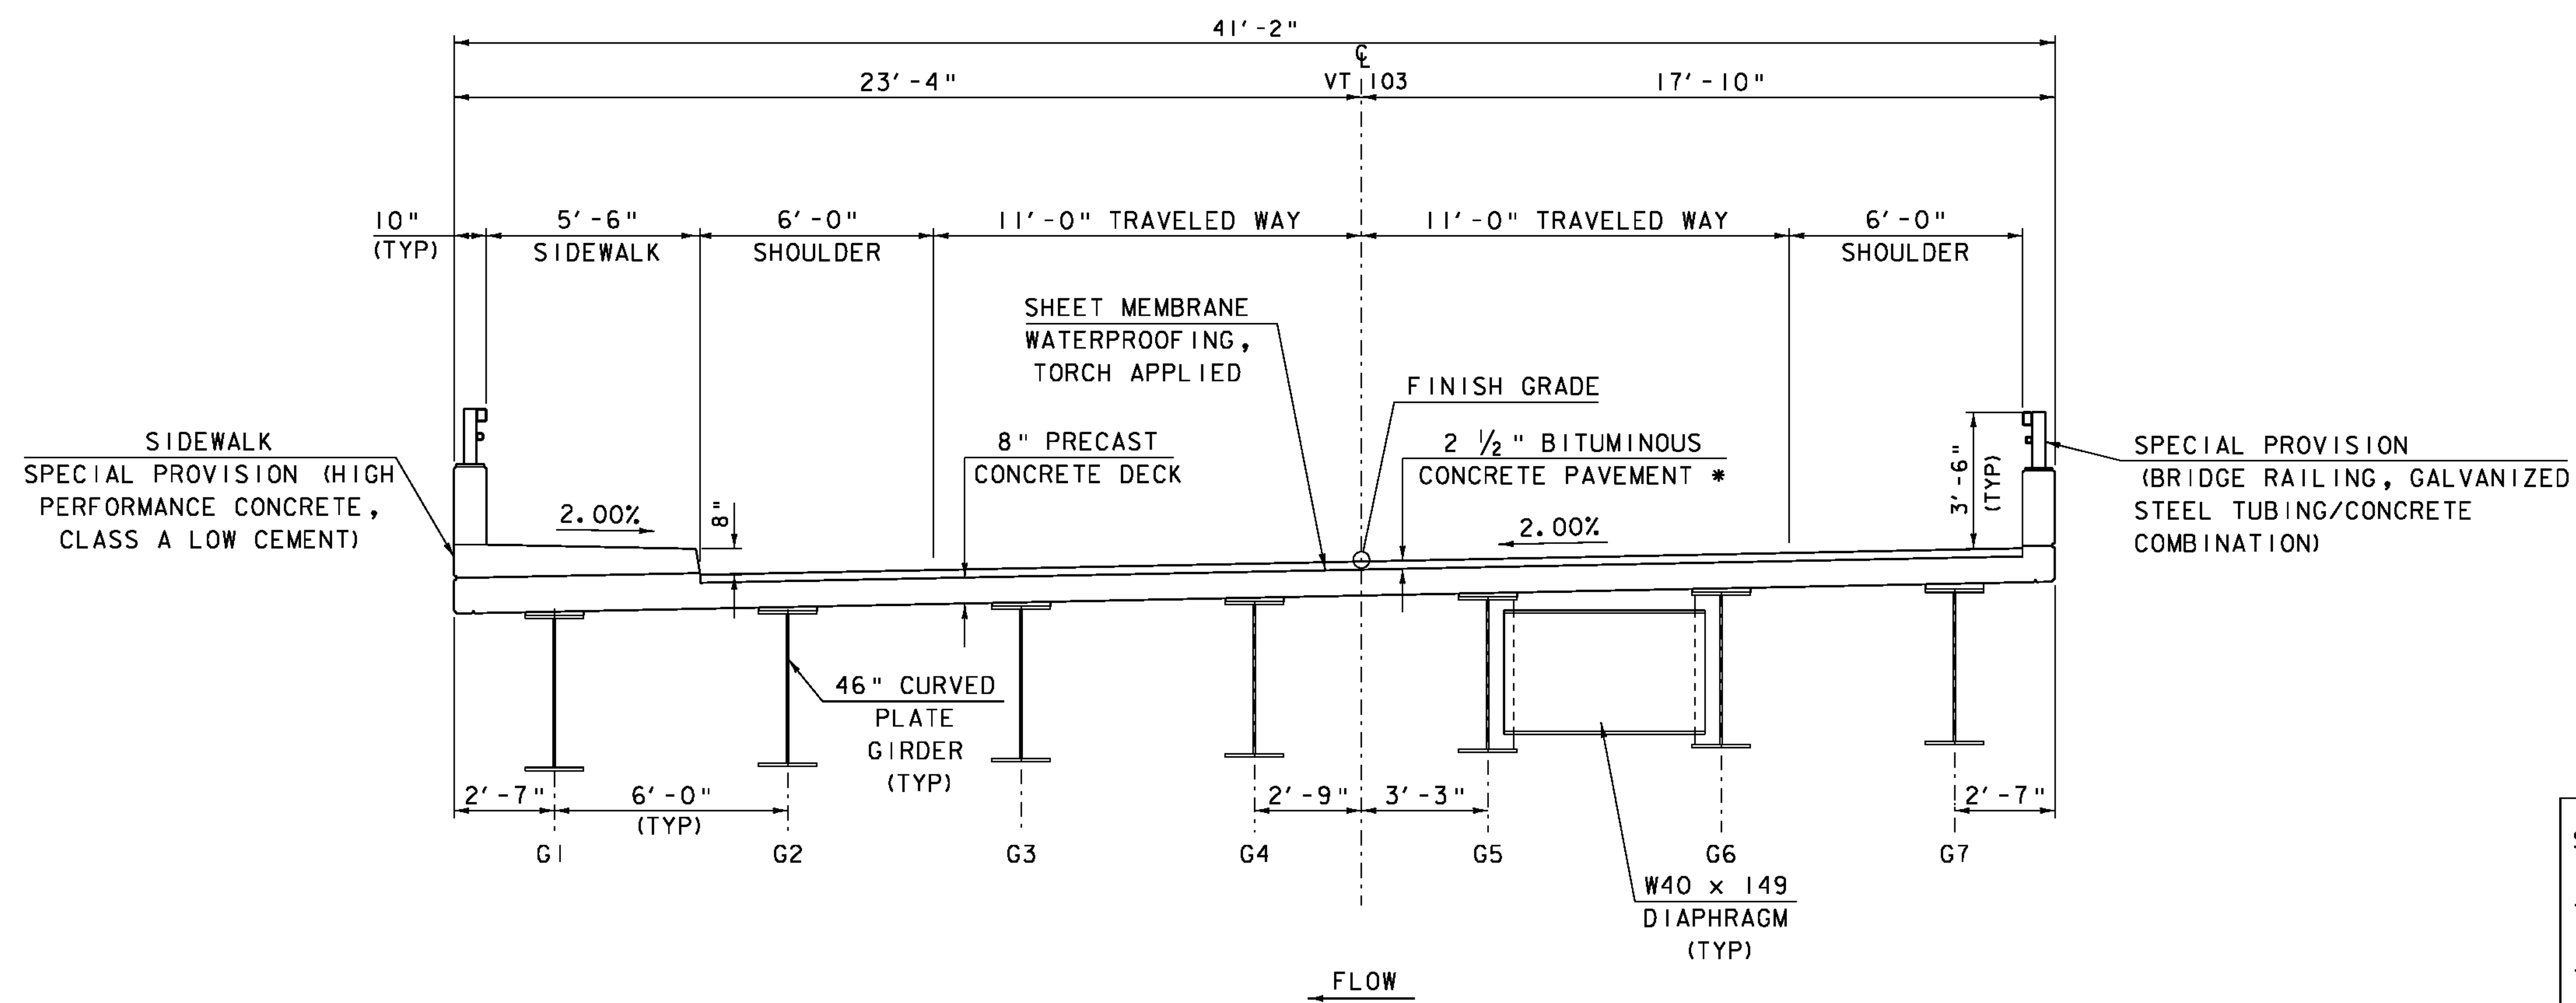

TYPICAL BRIDGE SECTION
SCALE 1" = 3'-0"

* 1/4" TYPE IV OVER
1/4" TYPE IV
NOTE: ALL TRANSVERSE
DIMENSIONS ARE RADIAL

MATERIAL TOLERANCES
(IF USED ON PROJECT)

SURFACE	
- PAVEMENT (TOTAL THICKNESS)	+/- 1/4"
- AGGREGATE SURFACE COURSE	+/- 1/2"
SUBBASE	+/- 1"
SAND BORROW	+/- 1"

PROJECT NAME: CHESTER
PROJECT NUMBER: BRF 025-1(37)

FILE NAME: Structures\s95b168typ.dgn PLOT DATE: 20-SEP-2010
PROJECT LEADER: C.P.WILLIAMS DRAWN BY: D.D.BEARD
DESIGNED BY: H.I.SALLS CHECKED BY: R.S.YOUNG
BRIDGE 9 TYPICAL SECTIONS SHEET 65 OF 124

