


LAYOUT #2

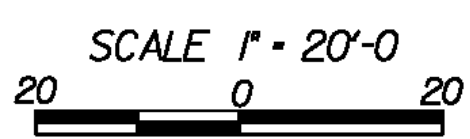

PROJECT NAME:	CHESTER	FILE NAME:	95b168\s95b168bdr.dgn	PLOT DATE:	20-SEP-2010
PROJECT NUMBER:	BRF 025-(K37)	PROJECT LEADER:	C.P.WILLIAMS	DRAWN BY:	D.D.BEARD
		DESIGNED BY:	R.S.YOUNG	CHECKED BY:	R.S.YOUNG
		BRIDGE 9 LAYOUT SHEET #2		SHEET 68	OF 124