

- NOTES:
1. THE CONTRACTOR SHALL PROVIDE TEMPORARY TRAFFIC BARRIER AS POSITIVE PROTECTION DURING THE BRIDGE CLOSURE. PAYMENT SHALL BE UNDER ITEM 621.90 "TEMPORARY TRAFFIC BARRIER".
 2. ANY REQUIRED LINE STRIPING TARGETS SHALL BE INCIDENTAL TO ITEM 641.10 "TRAFFIC CONTROL"
 3. EXISTING CONFLICTING PAVEMENT MARKINGS SHALL BE COVERED WITH BLACK PAVEMENT MARKING MASK.

VT 103 NORTH APPROACH SIGNS

VT 103 SOUTH APPROACH SIGNS


TEMPORARY 4" WHITE LINE
 STA 11+00 RT/LT - 31+00 RT/LT
 STA 52+50 RT/LT - 15+25 RT/LT

TEMPORARY 4" YELLOW LINE (DBL)
 STA 11+00 - 31+00
 STA 52+50 - 15+25

LEGEND

□	TYPE III BARRICADE
⊠	TYPE III (MOD) BARRICADE
▬	TEMPORARY TRAFFIC BARRIER

TRAFFIC CONTROL LAYOUT

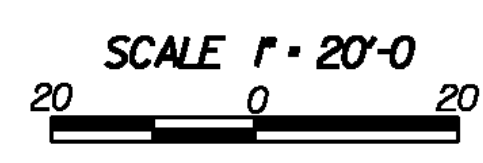

PROJECT NAME: CHESTER	PLOT DATE: 20-SEP-2010
PROJECT NUMBER: BRF 025-1(37)	DRAWN BY: D.D.BEARD
FILE NAME: s95b168detour.dgn	CHECKED BY: E.L.RUSTAY
PROJECT LEADER: C.P.WILLIAMS	SHEET 73 OF 124
DESIGNED BY: R.S.YOUNG	
BRIDGE 9 TRAFFIC CONTROL LAYOUT	