


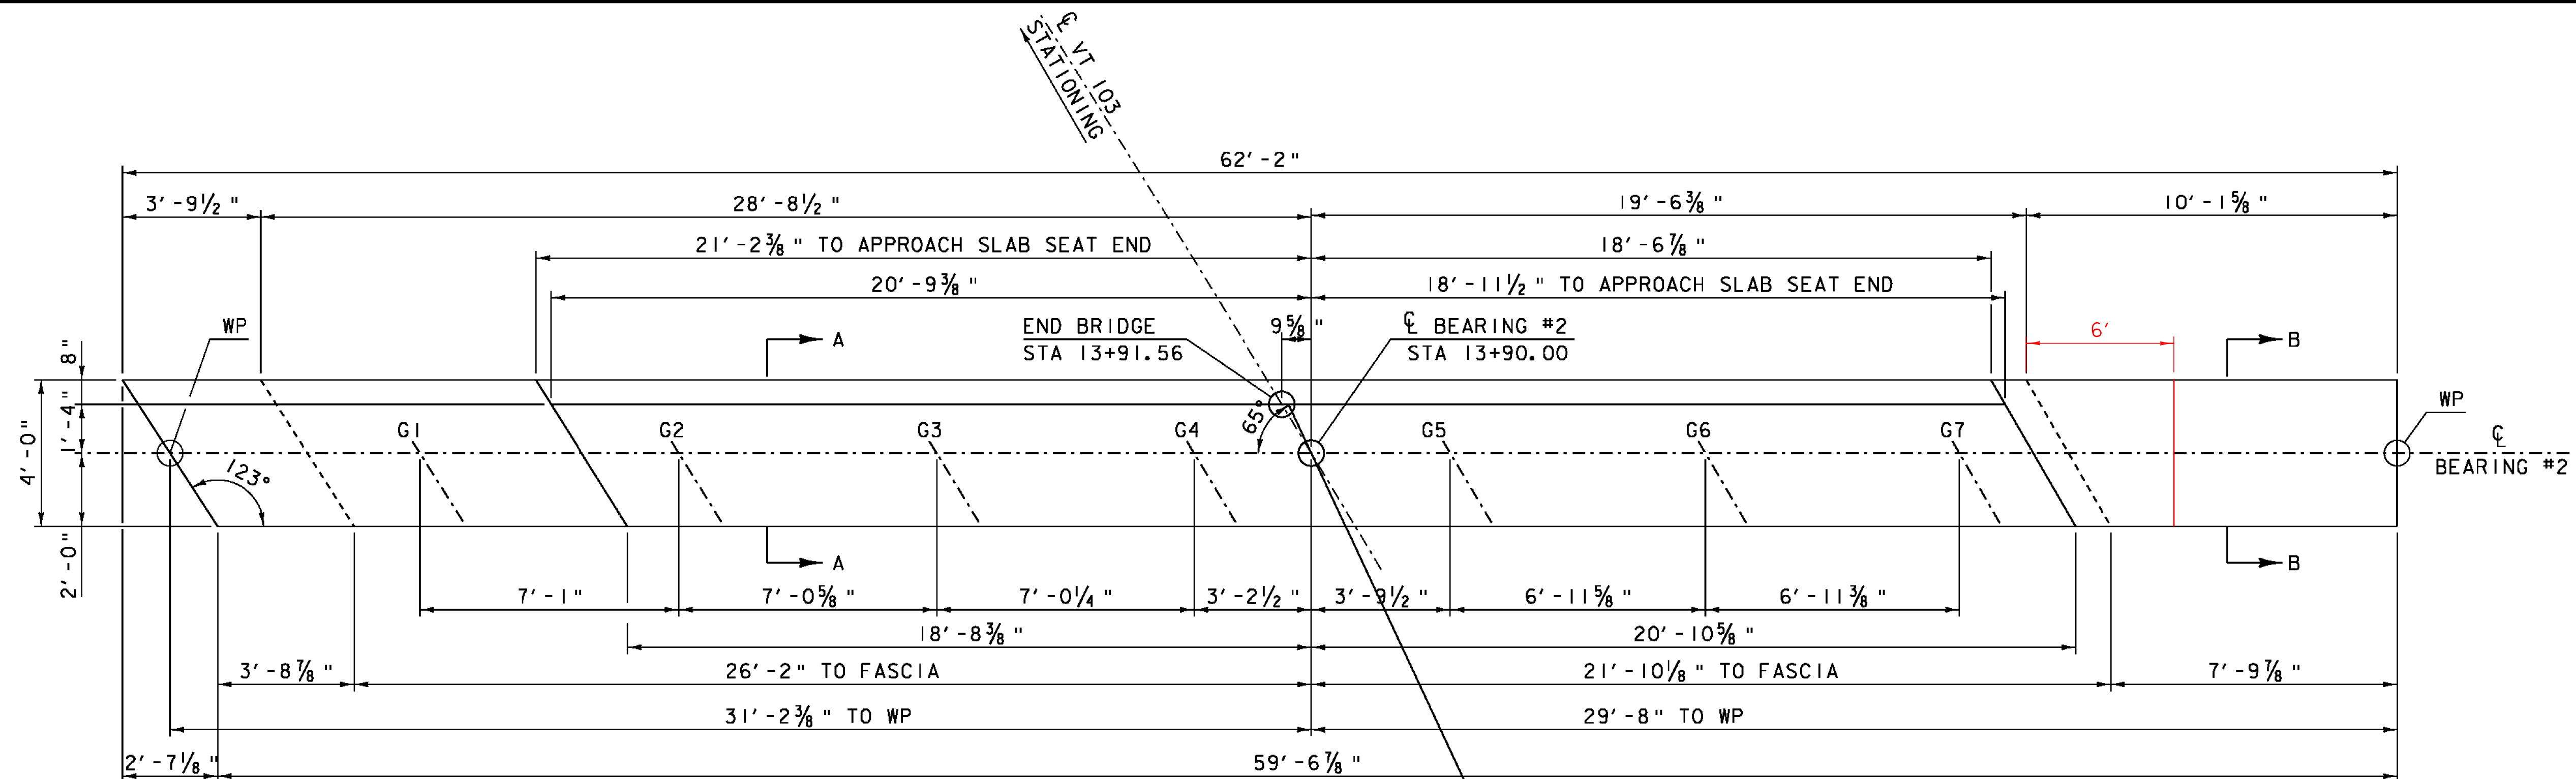

NOTE:


NF = NEAR FACE
 FF = FAR FACE
 EF = EACH FACE
 ▲ = CUT TO FIT IN FIELD
 3" CLEAR, UNLESS OTHERWISE
 SPECIFIED ON THE PLANS.
 2'-2" BAR LAP UNLESS OTHERWISE
 SPECIFIED ON THE PLANS.

ABUTMENT #2 PLAN

SCALE $\frac{3}{8}" = 1'-0"$

SEE SHEET 96 FOR SECTIONS "A-A" & "B-B"

ABUTMENT #2, WW4
 FIELD CHANGES:
 LOWERED CONCRETE HEIGHT
 AND ANGLED WINGWALL

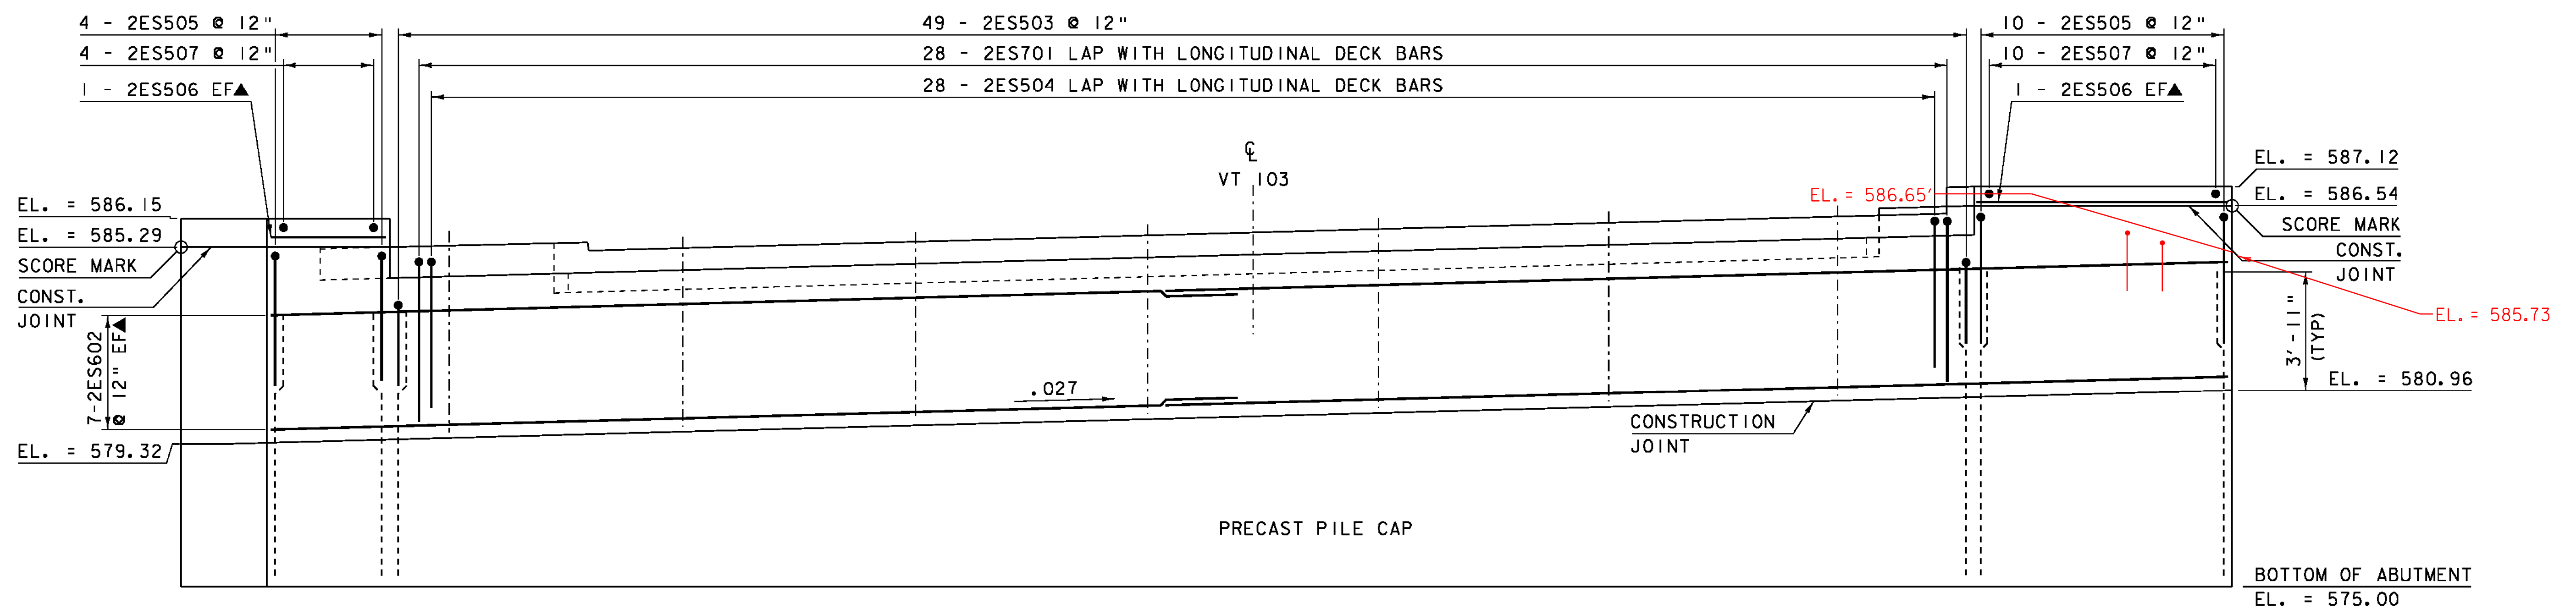

ABUTMENT #2 ELEVATION

SCALE $\frac{3}{8}" = 1'-0"$

SCALE $\frac{3}{8}" = 1'-0"$
 1 0 1 2 3 4

PROJECT NAME: CHESTER
 PROJECT NUMBER: BRF 025-1(37)

FILE NAME: 95b168\95b168sub.dgn
 PROJECT LEADER: C.P.WILLIAMS
 DESIGNED BY: R.S.YOUNG
 BRIDGE 9 ABUTMENT 2 DETAILS

PLOT DATE: 20-SEP-2010
 DRAWN BY: D.D.BEARD
 CHECKED BY: R.S.YOUNG
 SHEET 93 OF 124