


WINGWALL 2 PLAN VIEW
SCALE 1/2" = 1'-0"

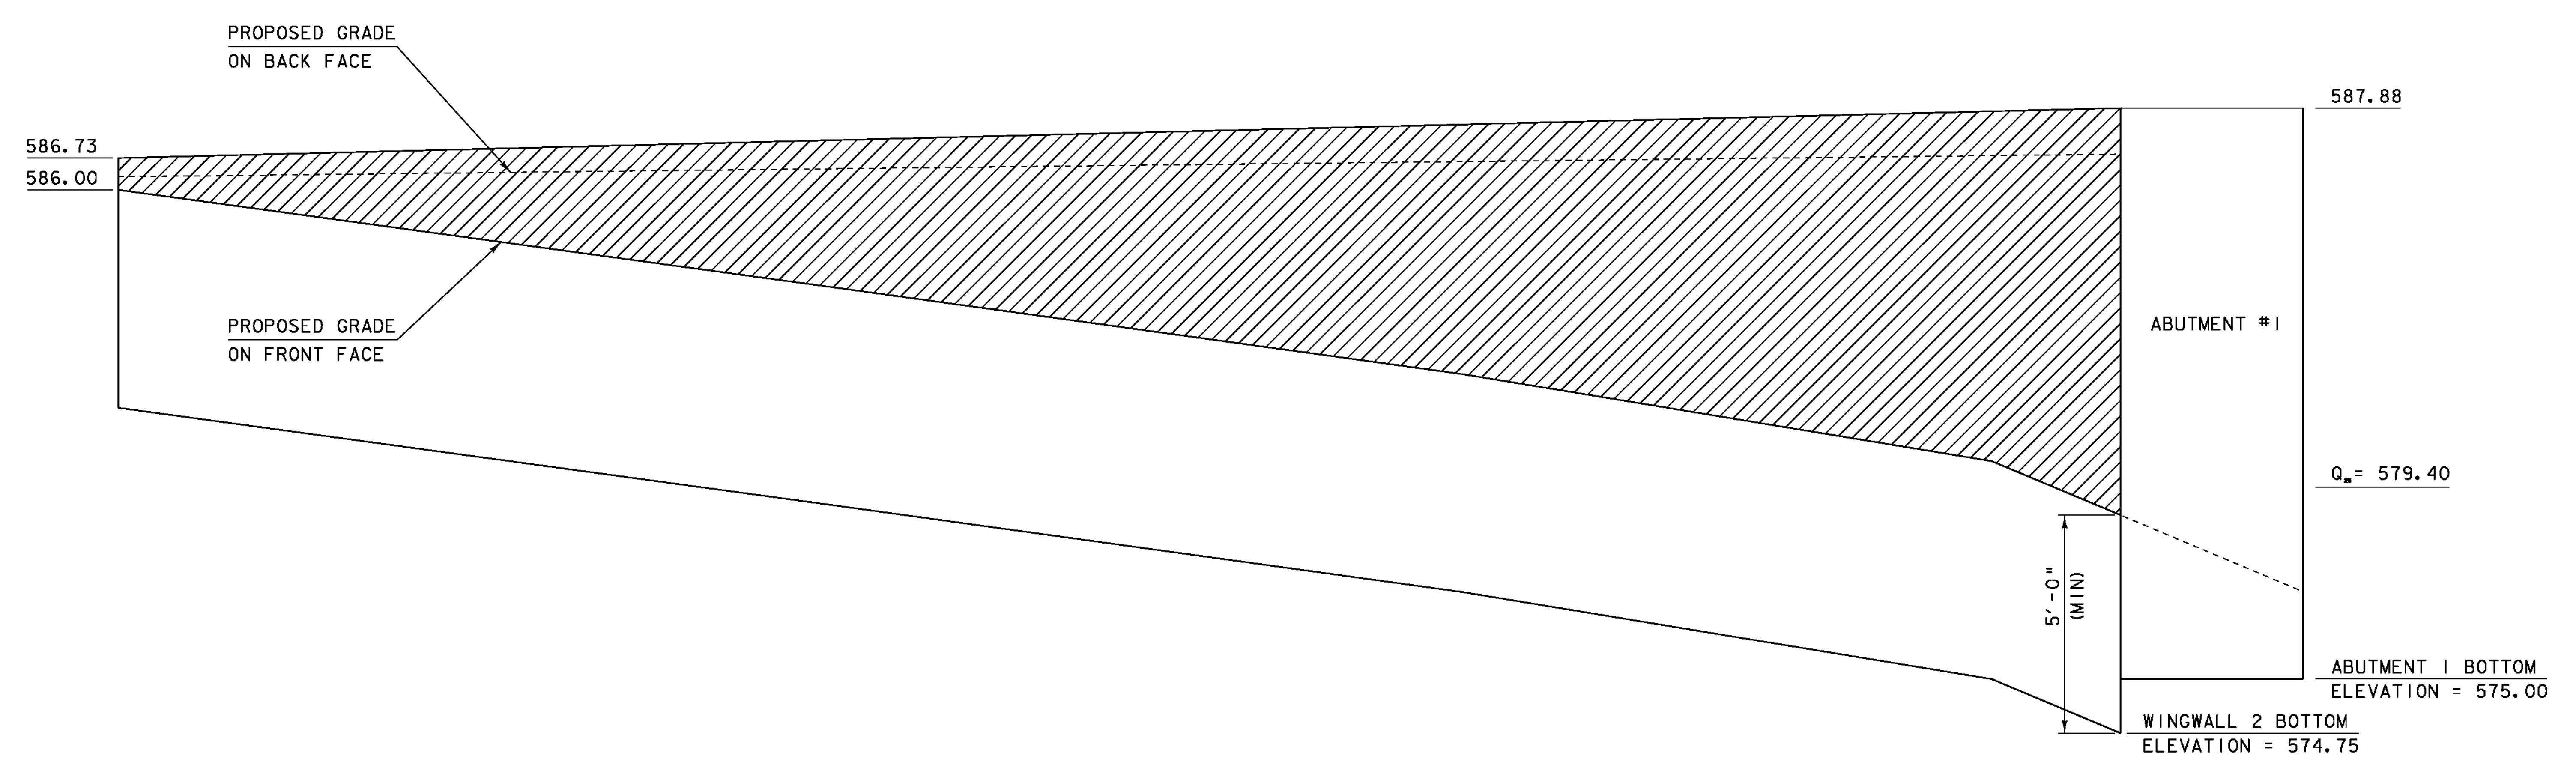

WINGWALL 2 ELEVATION VIEW
SCALE 1/2" = 1'-0"

PAY LIMITS OF ITEM 900.670 "SPECIAL PROVISION (RETAINING WALL)"

SEE SHEET 98 FOR
ADDITIONAL INFORMATION
AND TYPICAL SECTION

PROJECT NAME:	CHESTER
PROJECT NUMBER:	BRF 025-1(37)
FILE NAME:	95b168\95b168sub.dgn
PROJECT LEADER:	C.P.WILLIAMS
DESIGNED BY:	R.S.YOUNG
BRIDGE 9 WINGWALL 2 DETAILS	
PLOT DATE:	21-SEP-2010
DRAWN BY:	D.D.BEARD
CHECKED BY:	E.R.CHARBONNEAU
SHEET	97 OF 124

