
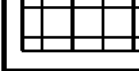


EPSC FINAL CONDITIONS

LEGEND

-  EROSION CONTROL MATTING
-  SEEDED AREA

PROJECT NAME: CHESTER
 PROJECT NUMBER: BRF 025-1(37)
 FILE NAME: 95b168\s95b168bdr_ero.dgn PLOT DATE: 20-SEP-2010
 PROJECT LEADER: C.P.WILLIAMS DRAWN BY: D.D.BEARD
 DESIGNED BY: R.S.YOUNG CHECKED BY: R.S.YOUNG
 BRIDGE 9 EPSC FINAL CONDITIONS SHEET III OF 124

