



52+50

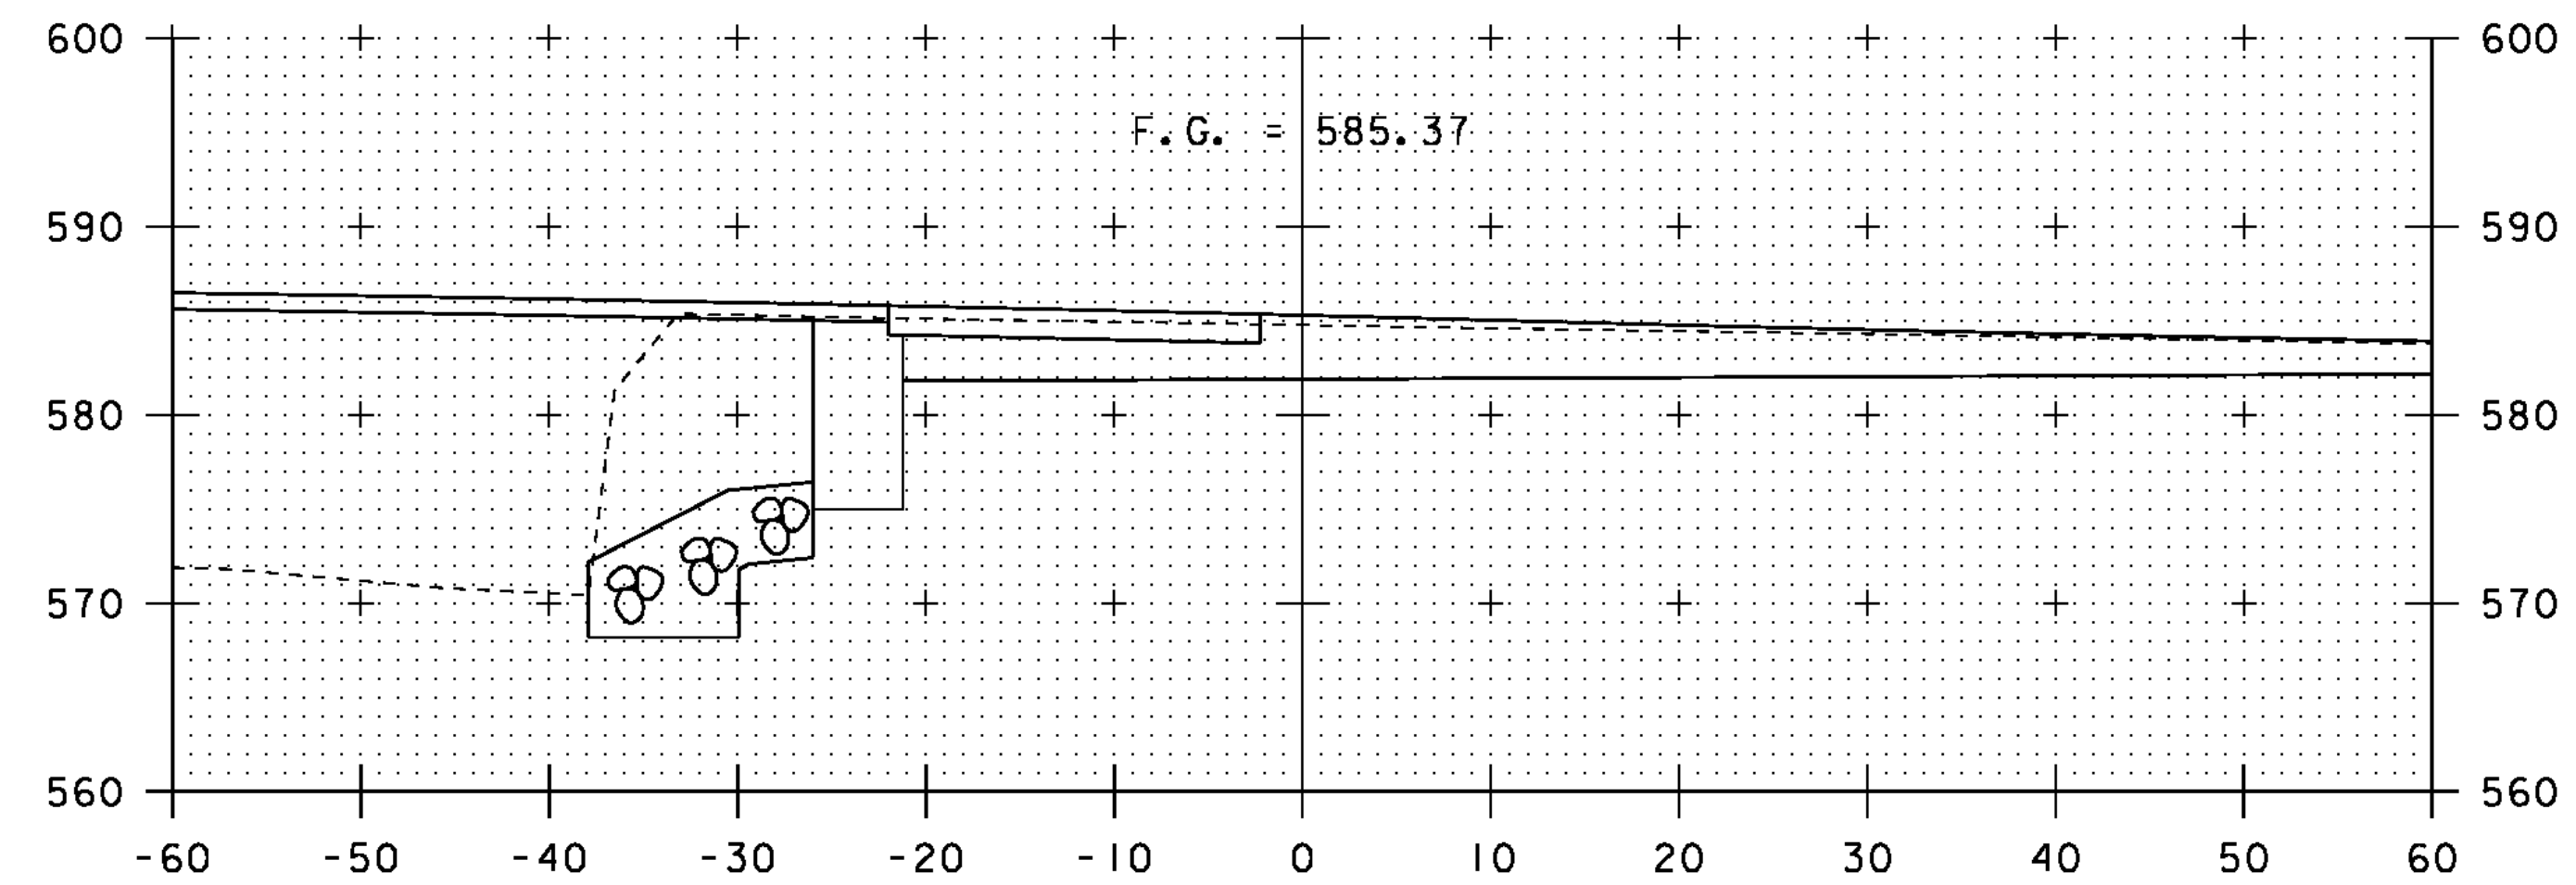


53+23


= STA 14+13.29 @ VT 103

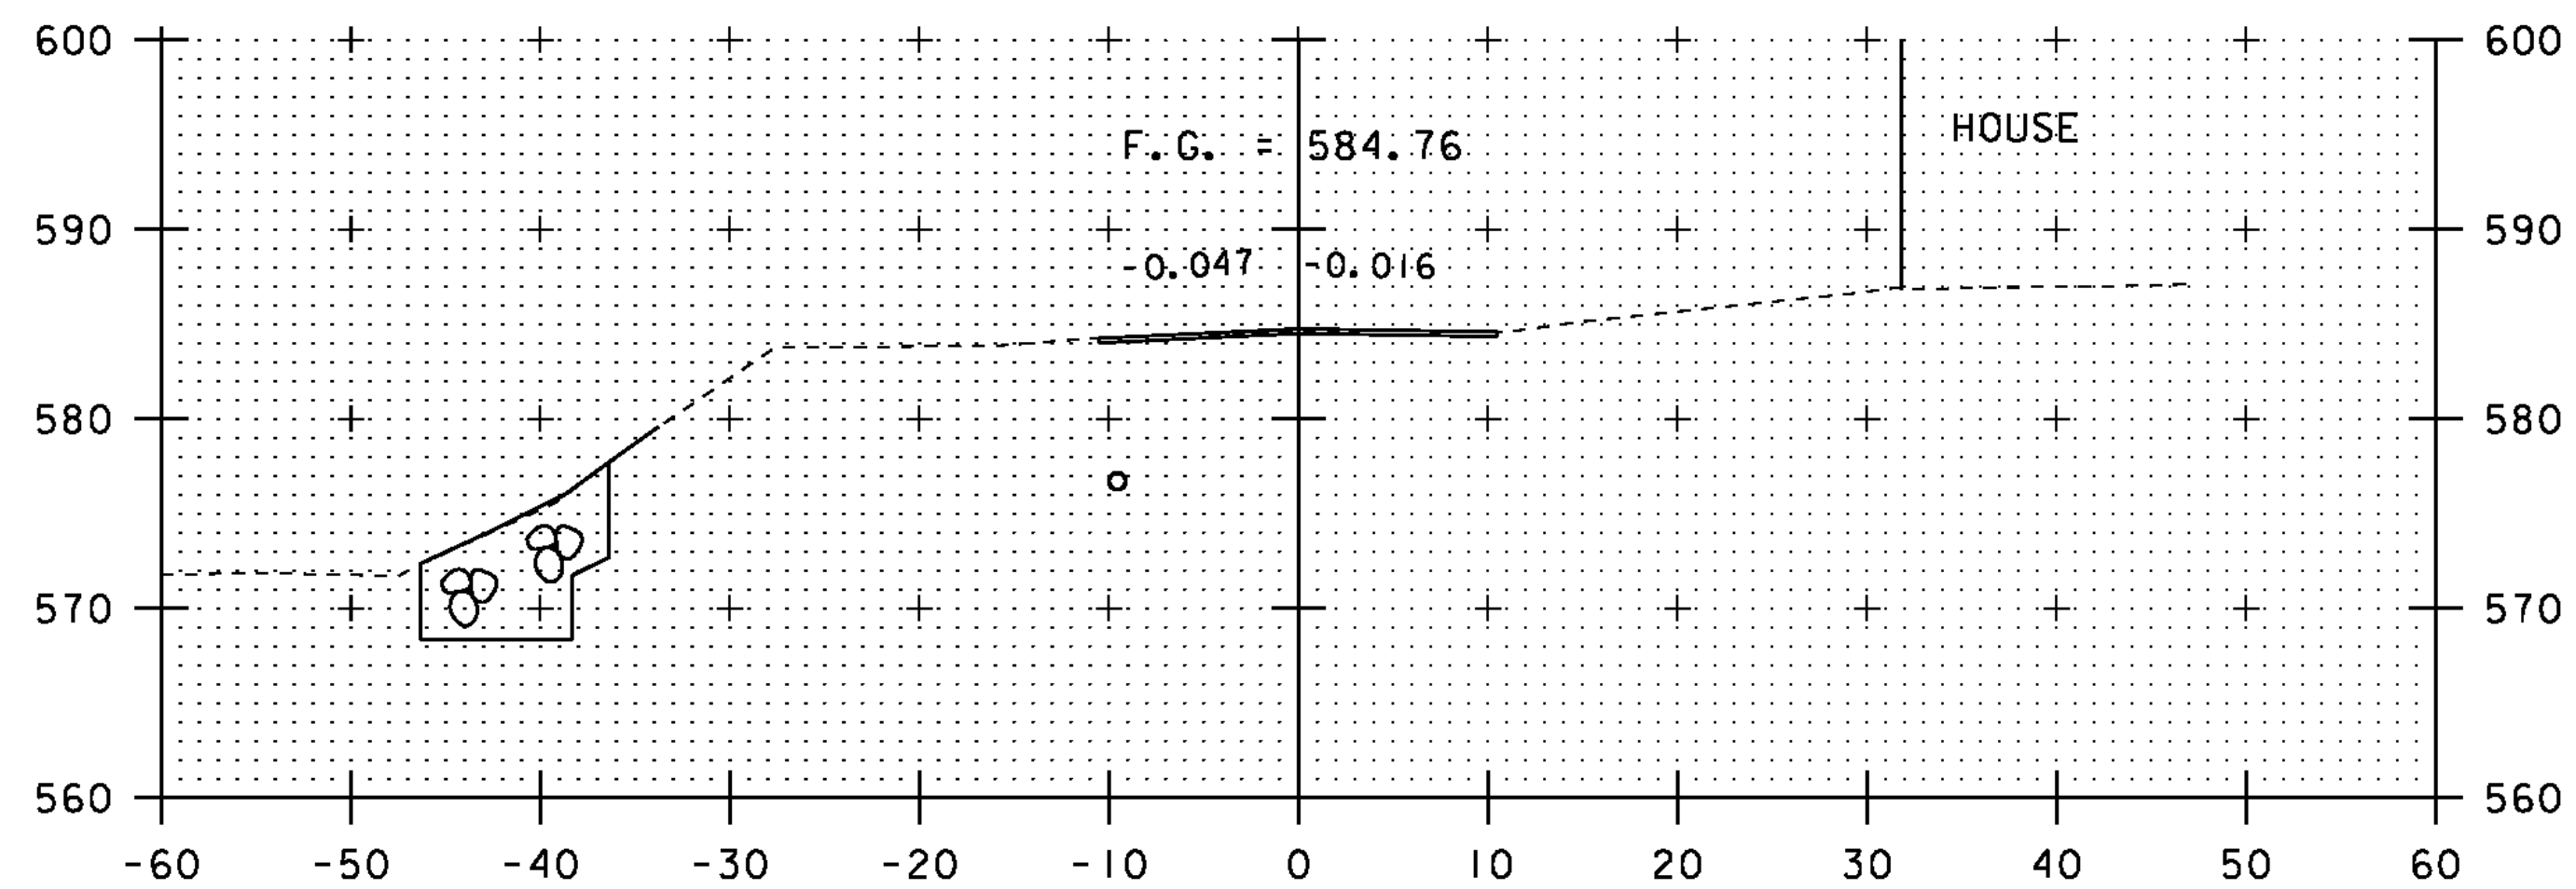


52+25

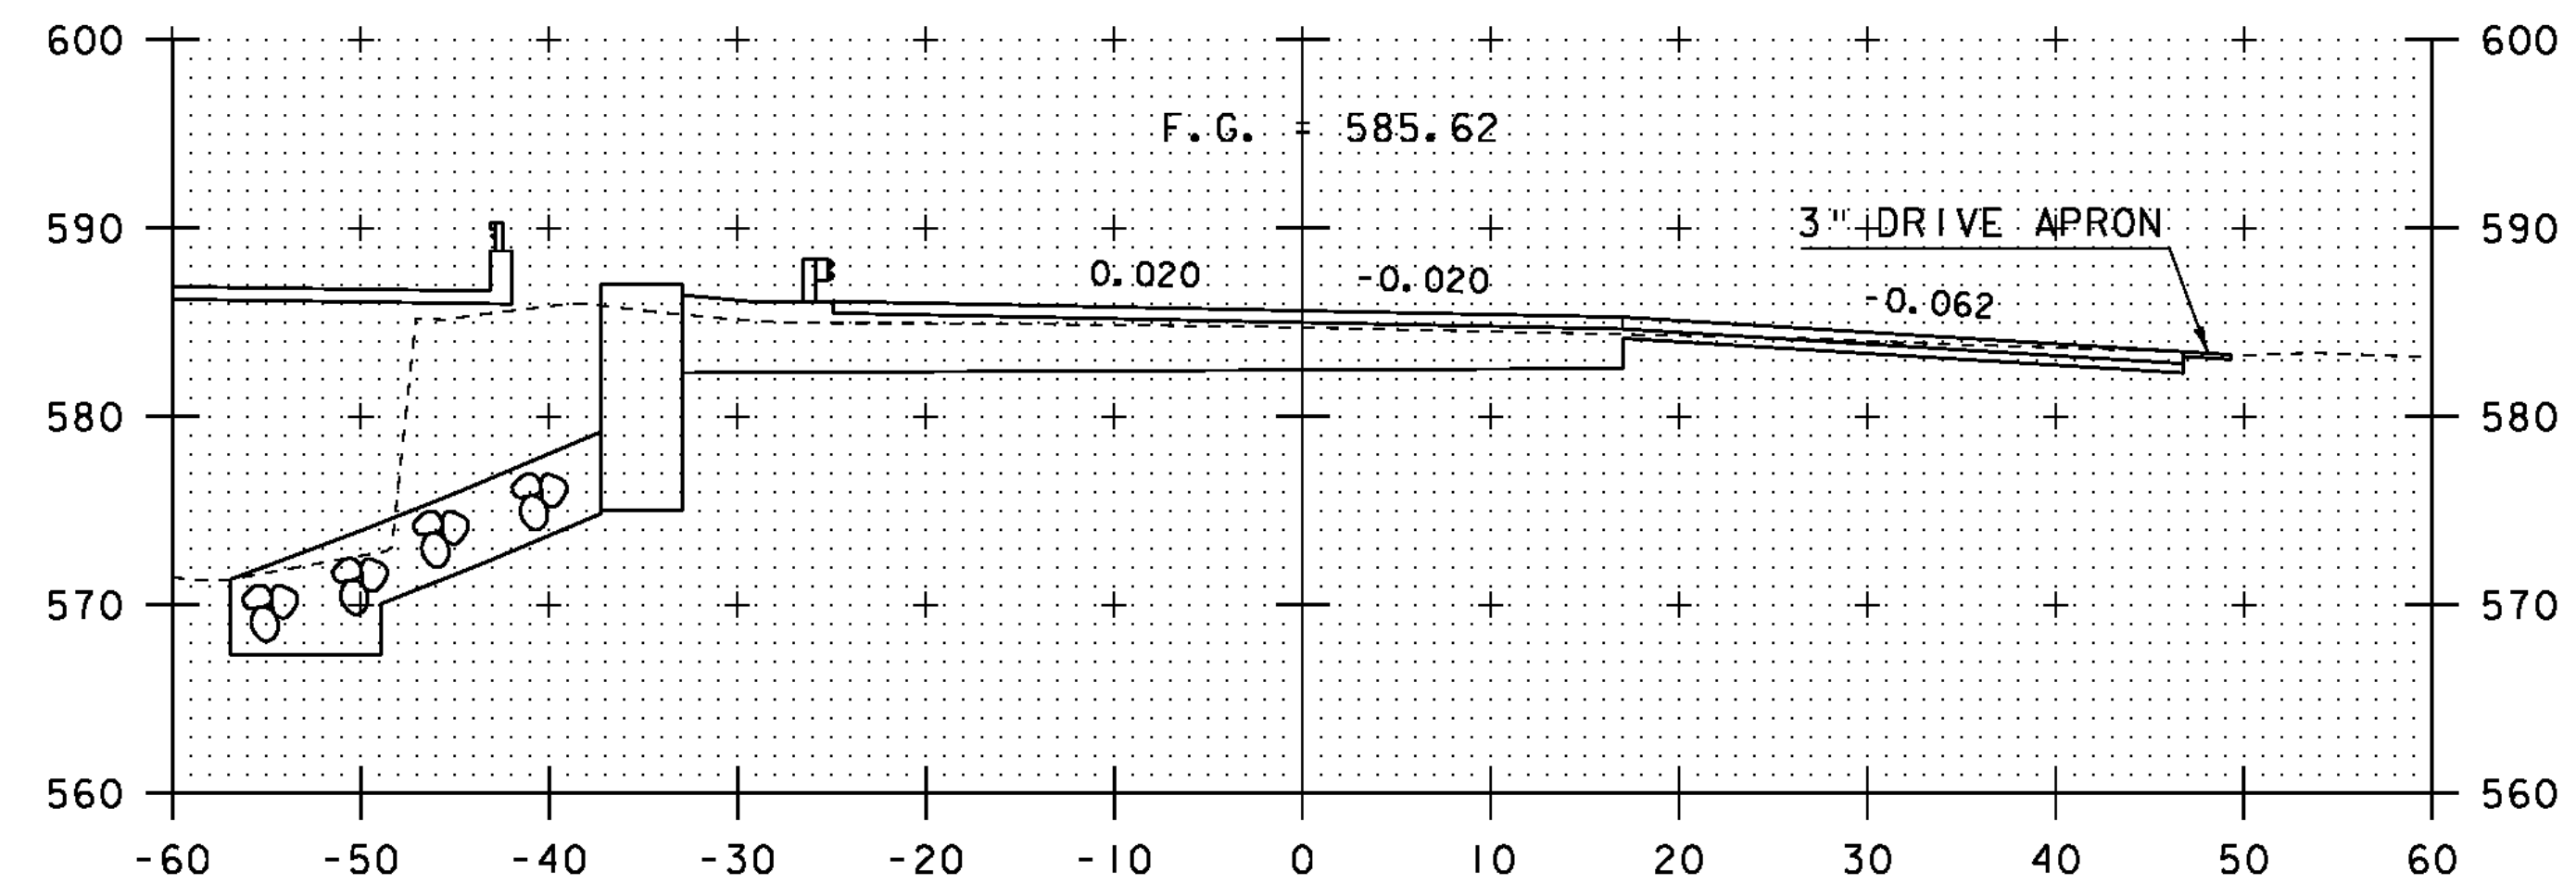

53+00

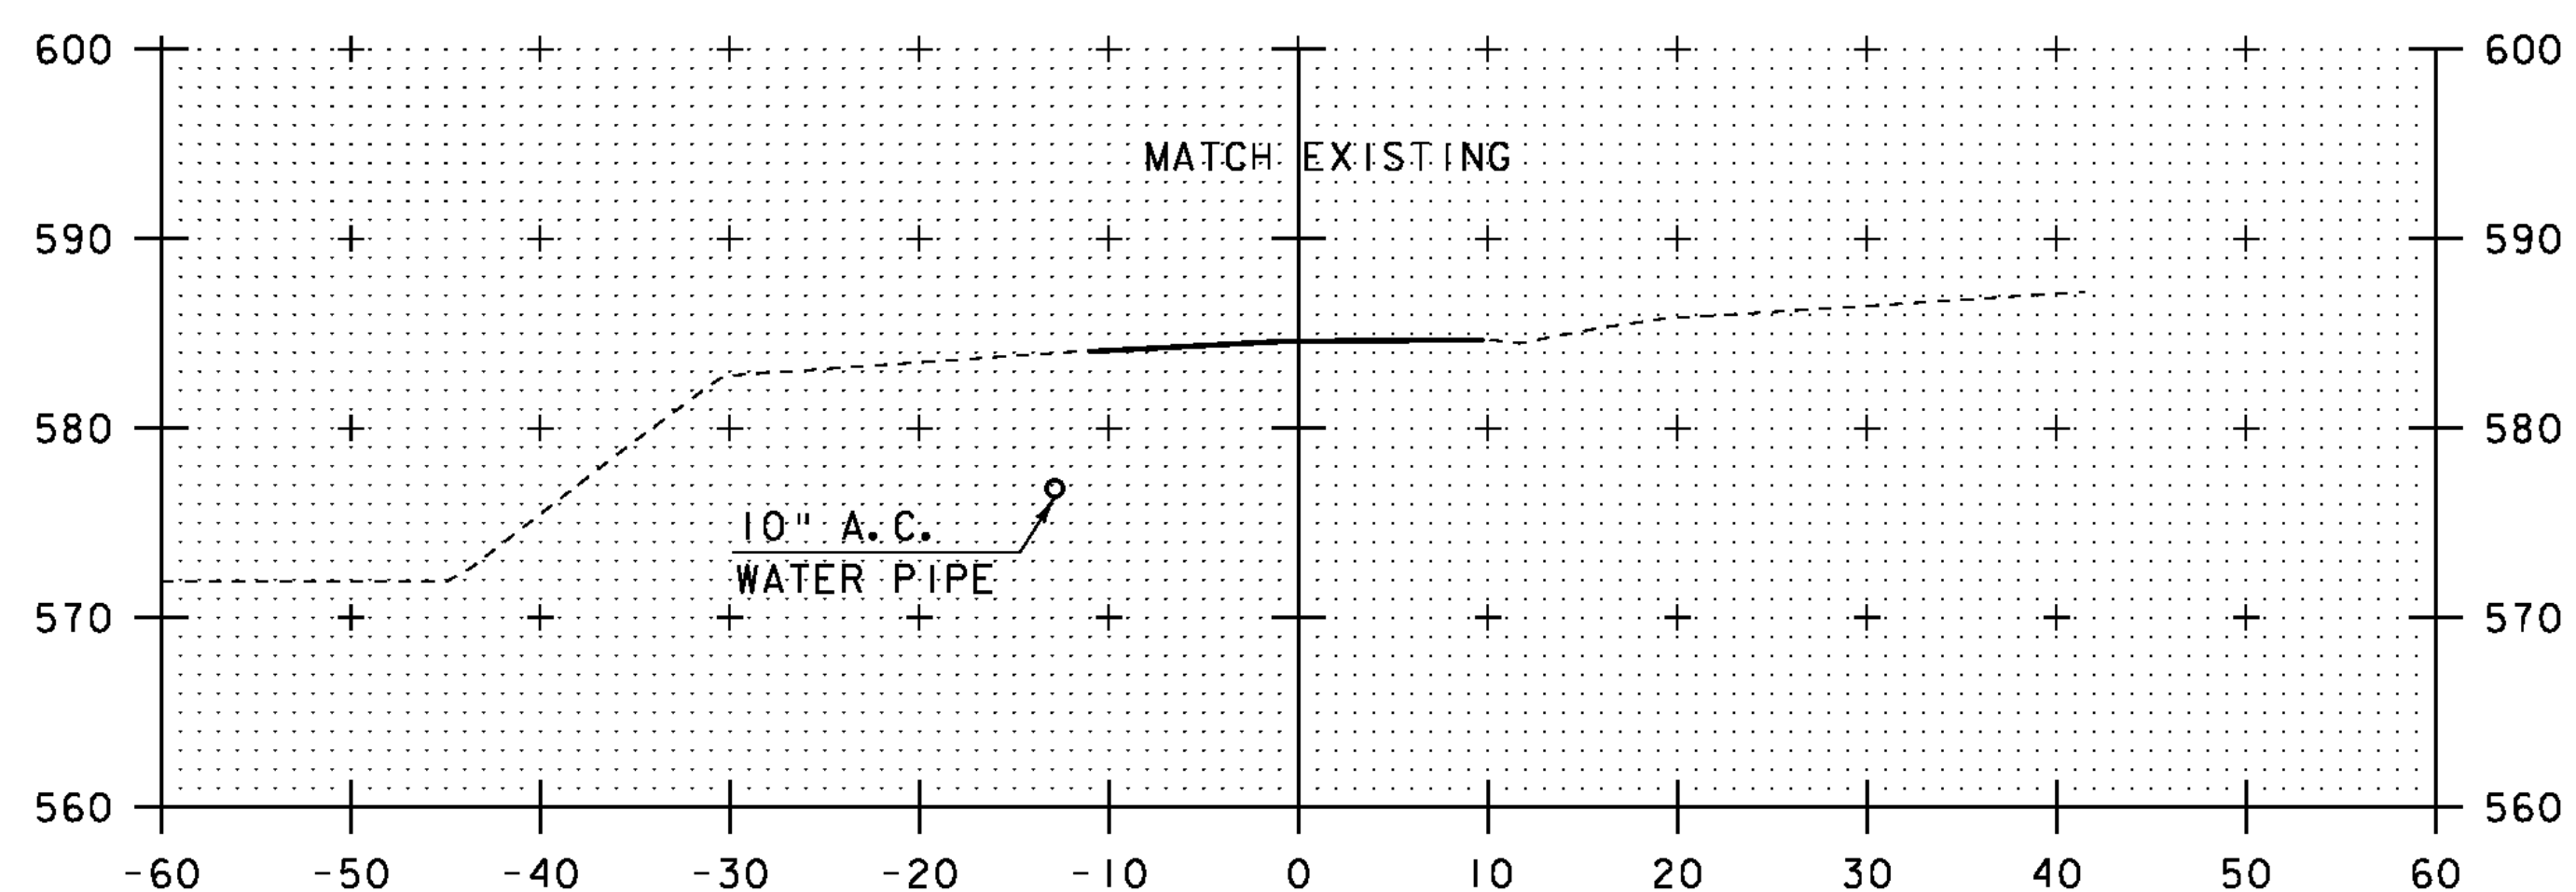

52+00

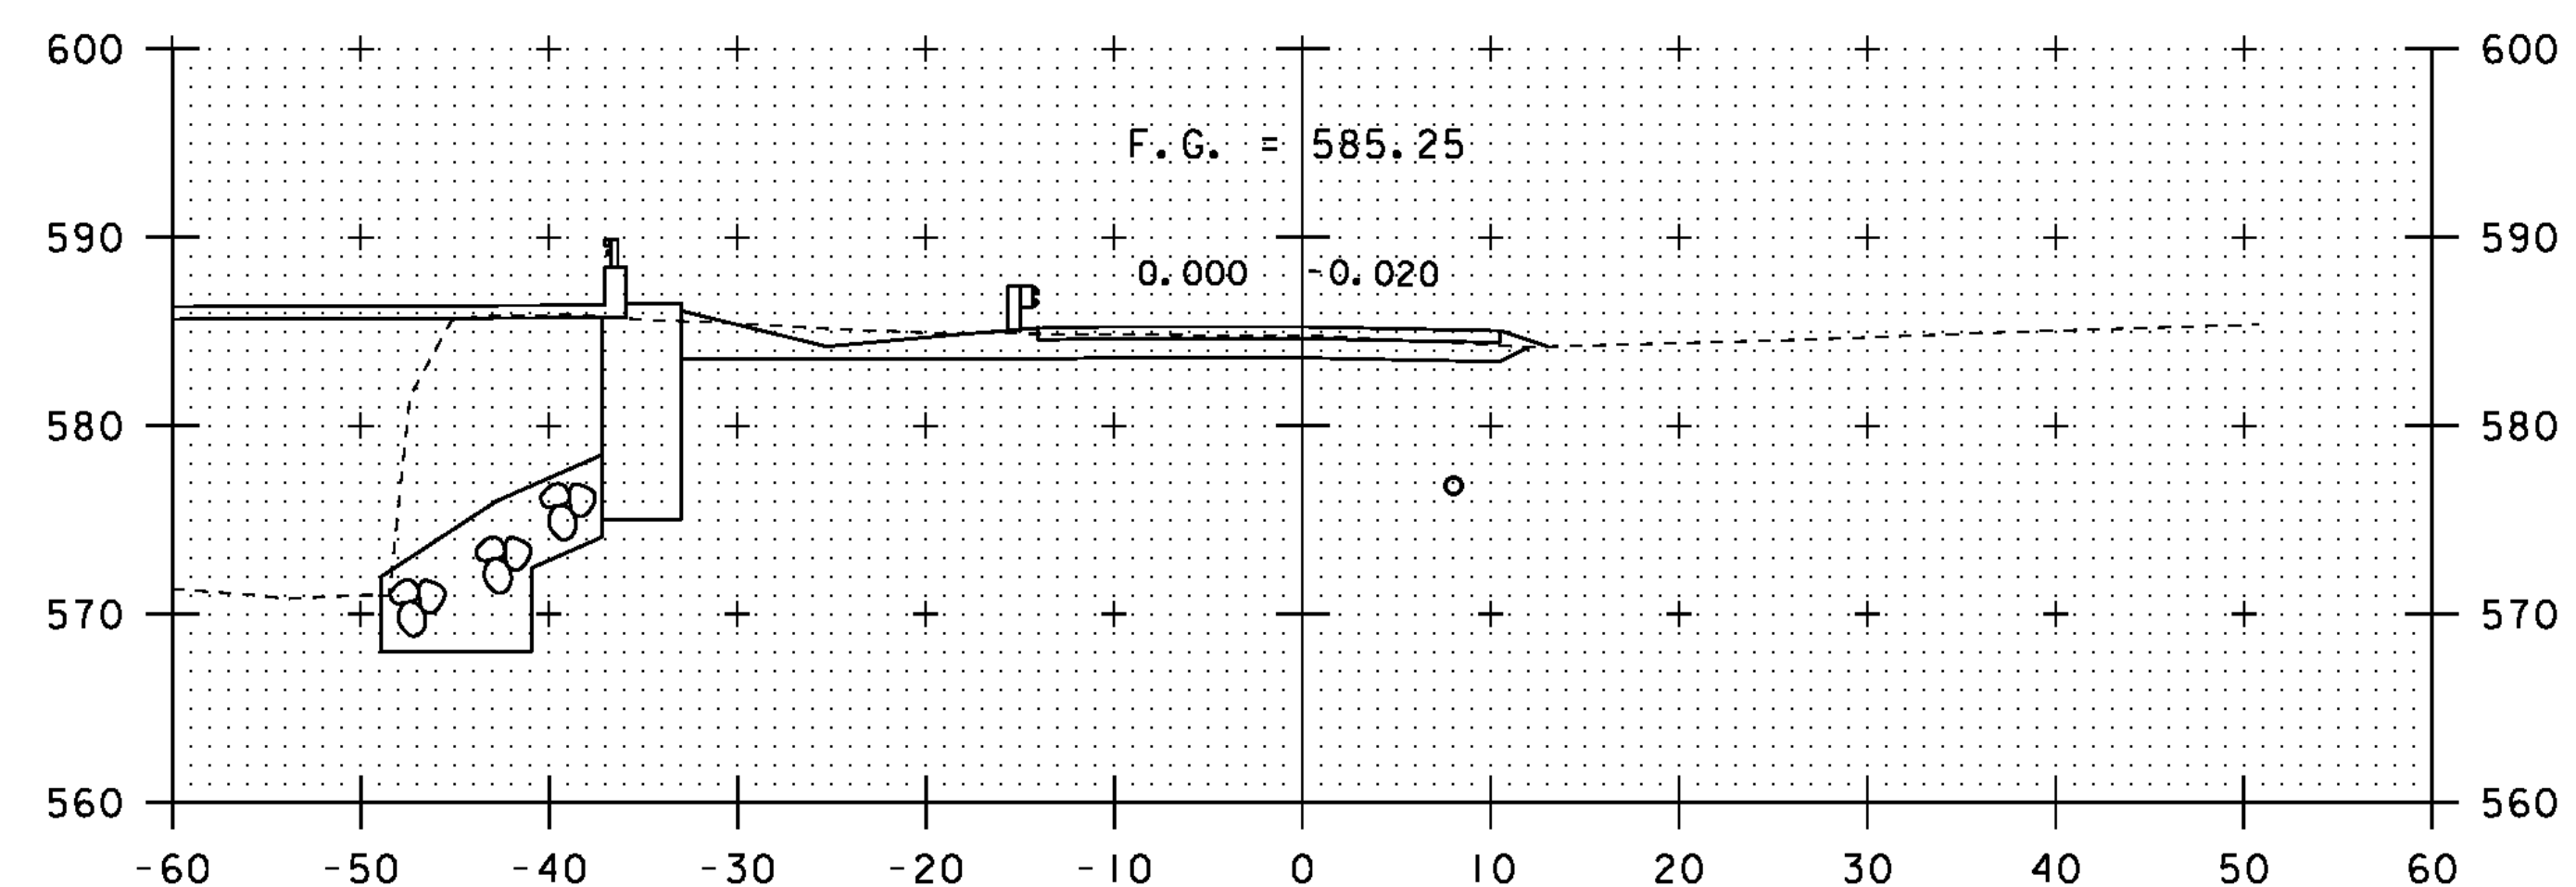

52+75



STA. 52+00 TO STA. 53+23

PROJECT NAME: CHESTER	
PROJECT NUMBER: BRF 025-(K37) SC	
FILE NAME:	PLOT DATE: 20-SEP-2010
PROJECT LEADER: C.P.WILLIAMS	DRAWN BY: D.D.BEARD
DESIGNED BY: R.S.YOUNG	CHECKED BY: R.S.YOUNG
BRIDGE 9 TH 72 CROSS SECTIONS	SHEET 119 OF 124