



EXISTING ABUTMENT, REMOVE TO  
 ELEVATION 582.00'. USE ITEM 529.15  
 "REMOVAL OF STRUCTURE".

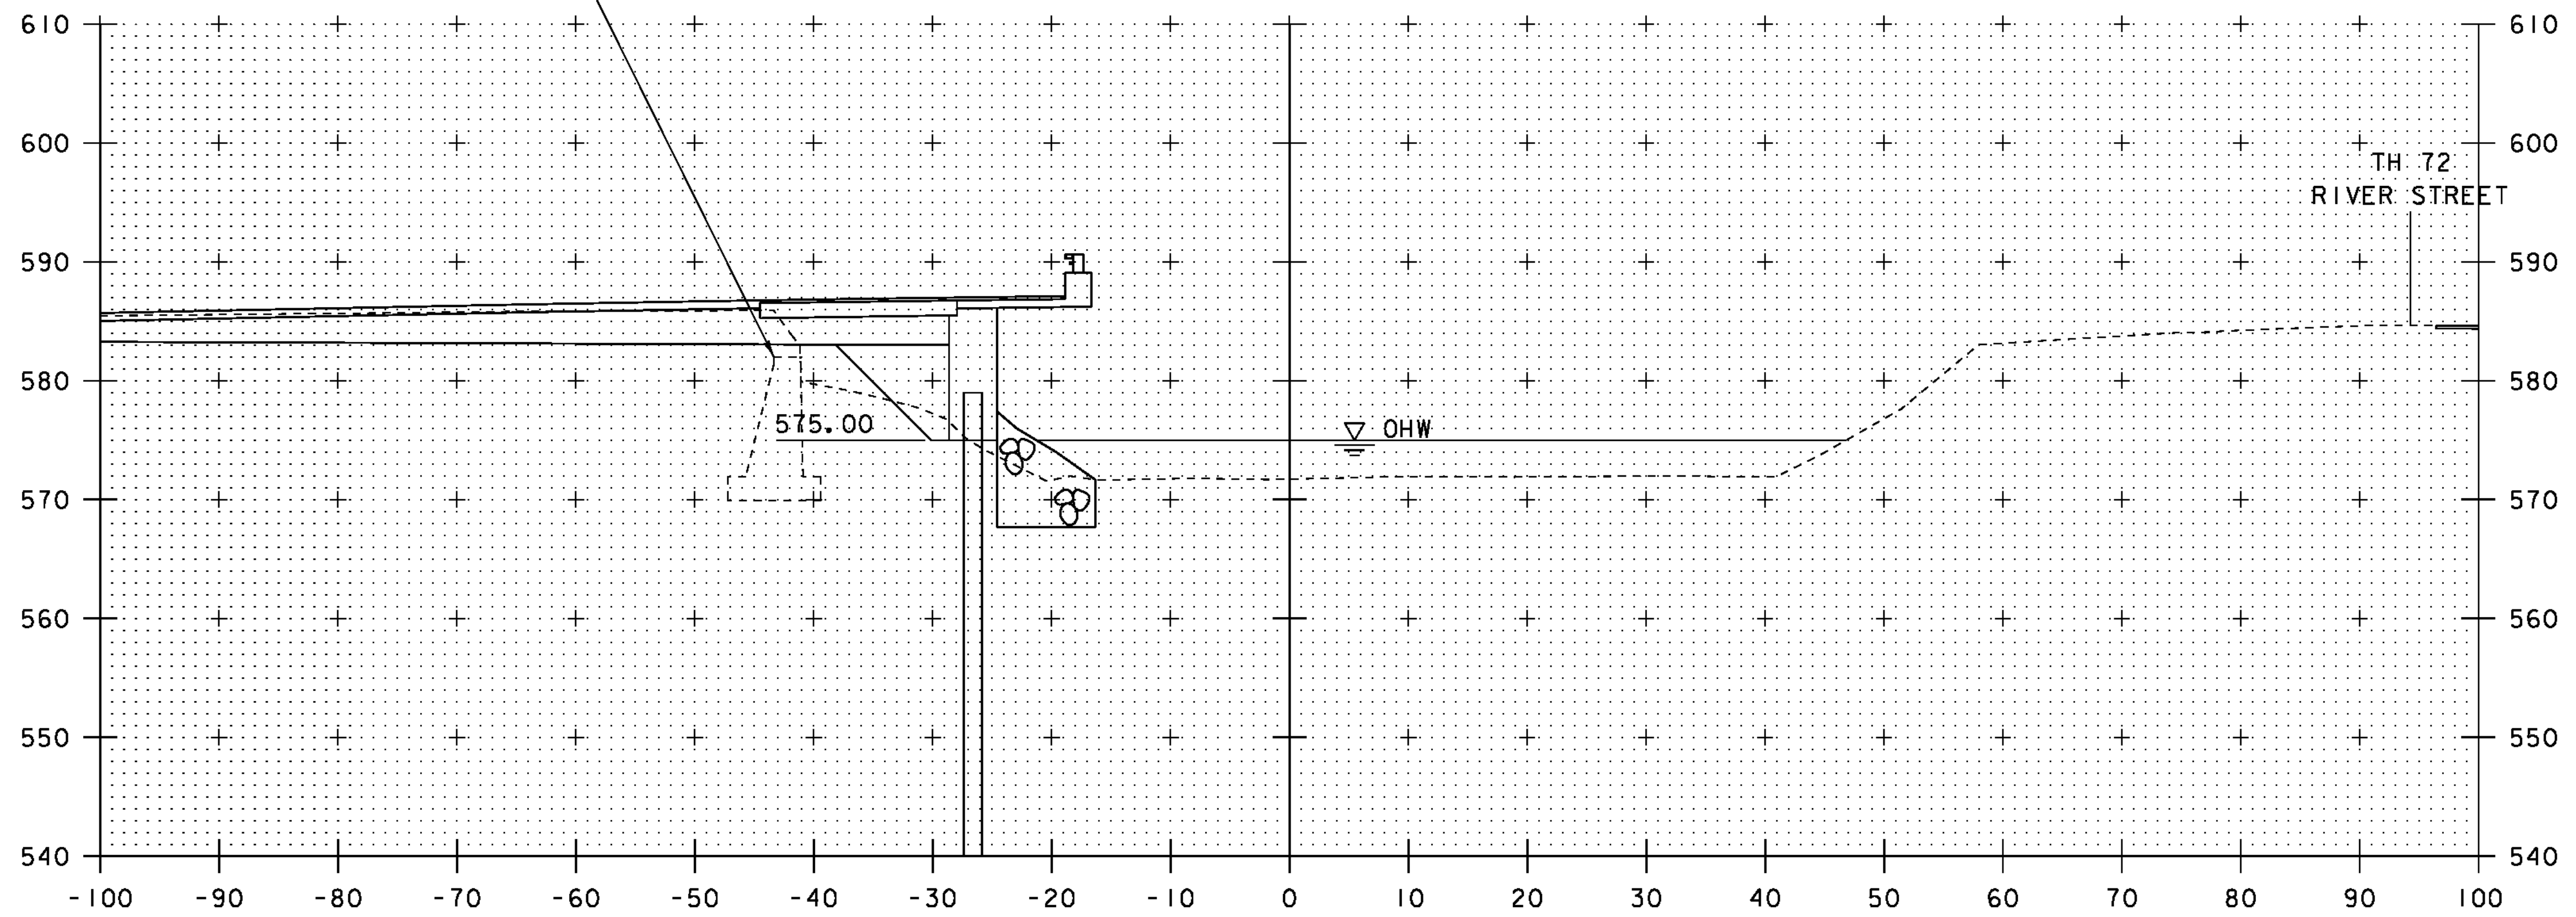

STA: 61+90.50 RT  
 BEGIN UNCLASSIFIED CHANNEL EXCAVATION  
 BEGIN GEOTEXTILE UNDER STONE FILL  
 BEGIN STONE FILL TYPE IV  
 BEGIN GRUBBING MATERIAL

61+75

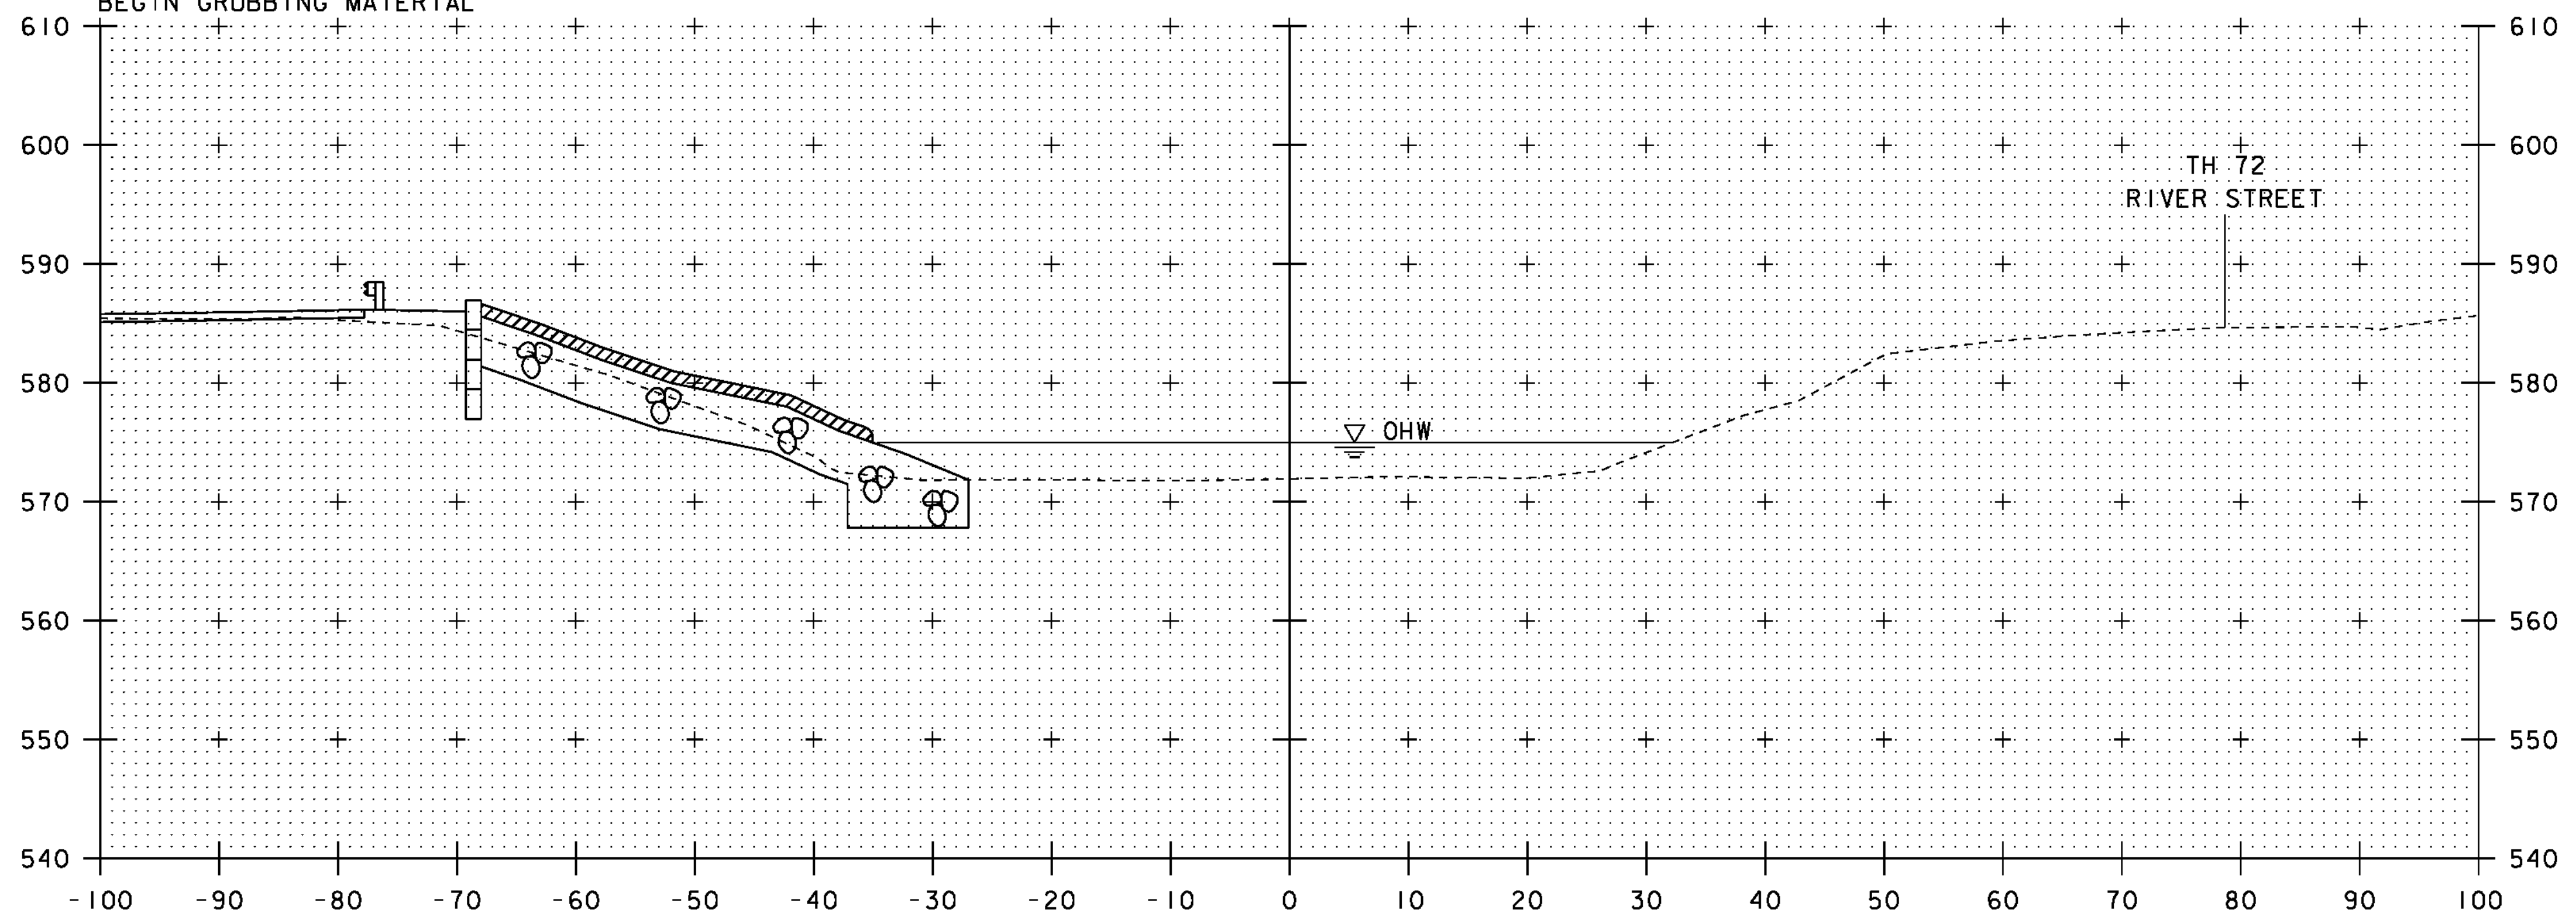

61+50



STA. 61+50 TO STA. 61+75

PROJECT NAME: CHESTER

PROJECT NUMBER: BRF 025-(K37) SC

FILE NAME: s95b168xs2.dgn

PROJECT LEADER: C.P.WILLIAMS

DESIGNED BY: R.S.YOUNG

BRIDGE 9 CHANNEL CROSS SECTIONS

PLOT DATE: 20-SEP-2010

DRAWN BY: D.D.BEARD

CHECKED BY: R.S.YOUNG

SHEET 121 OF 124