
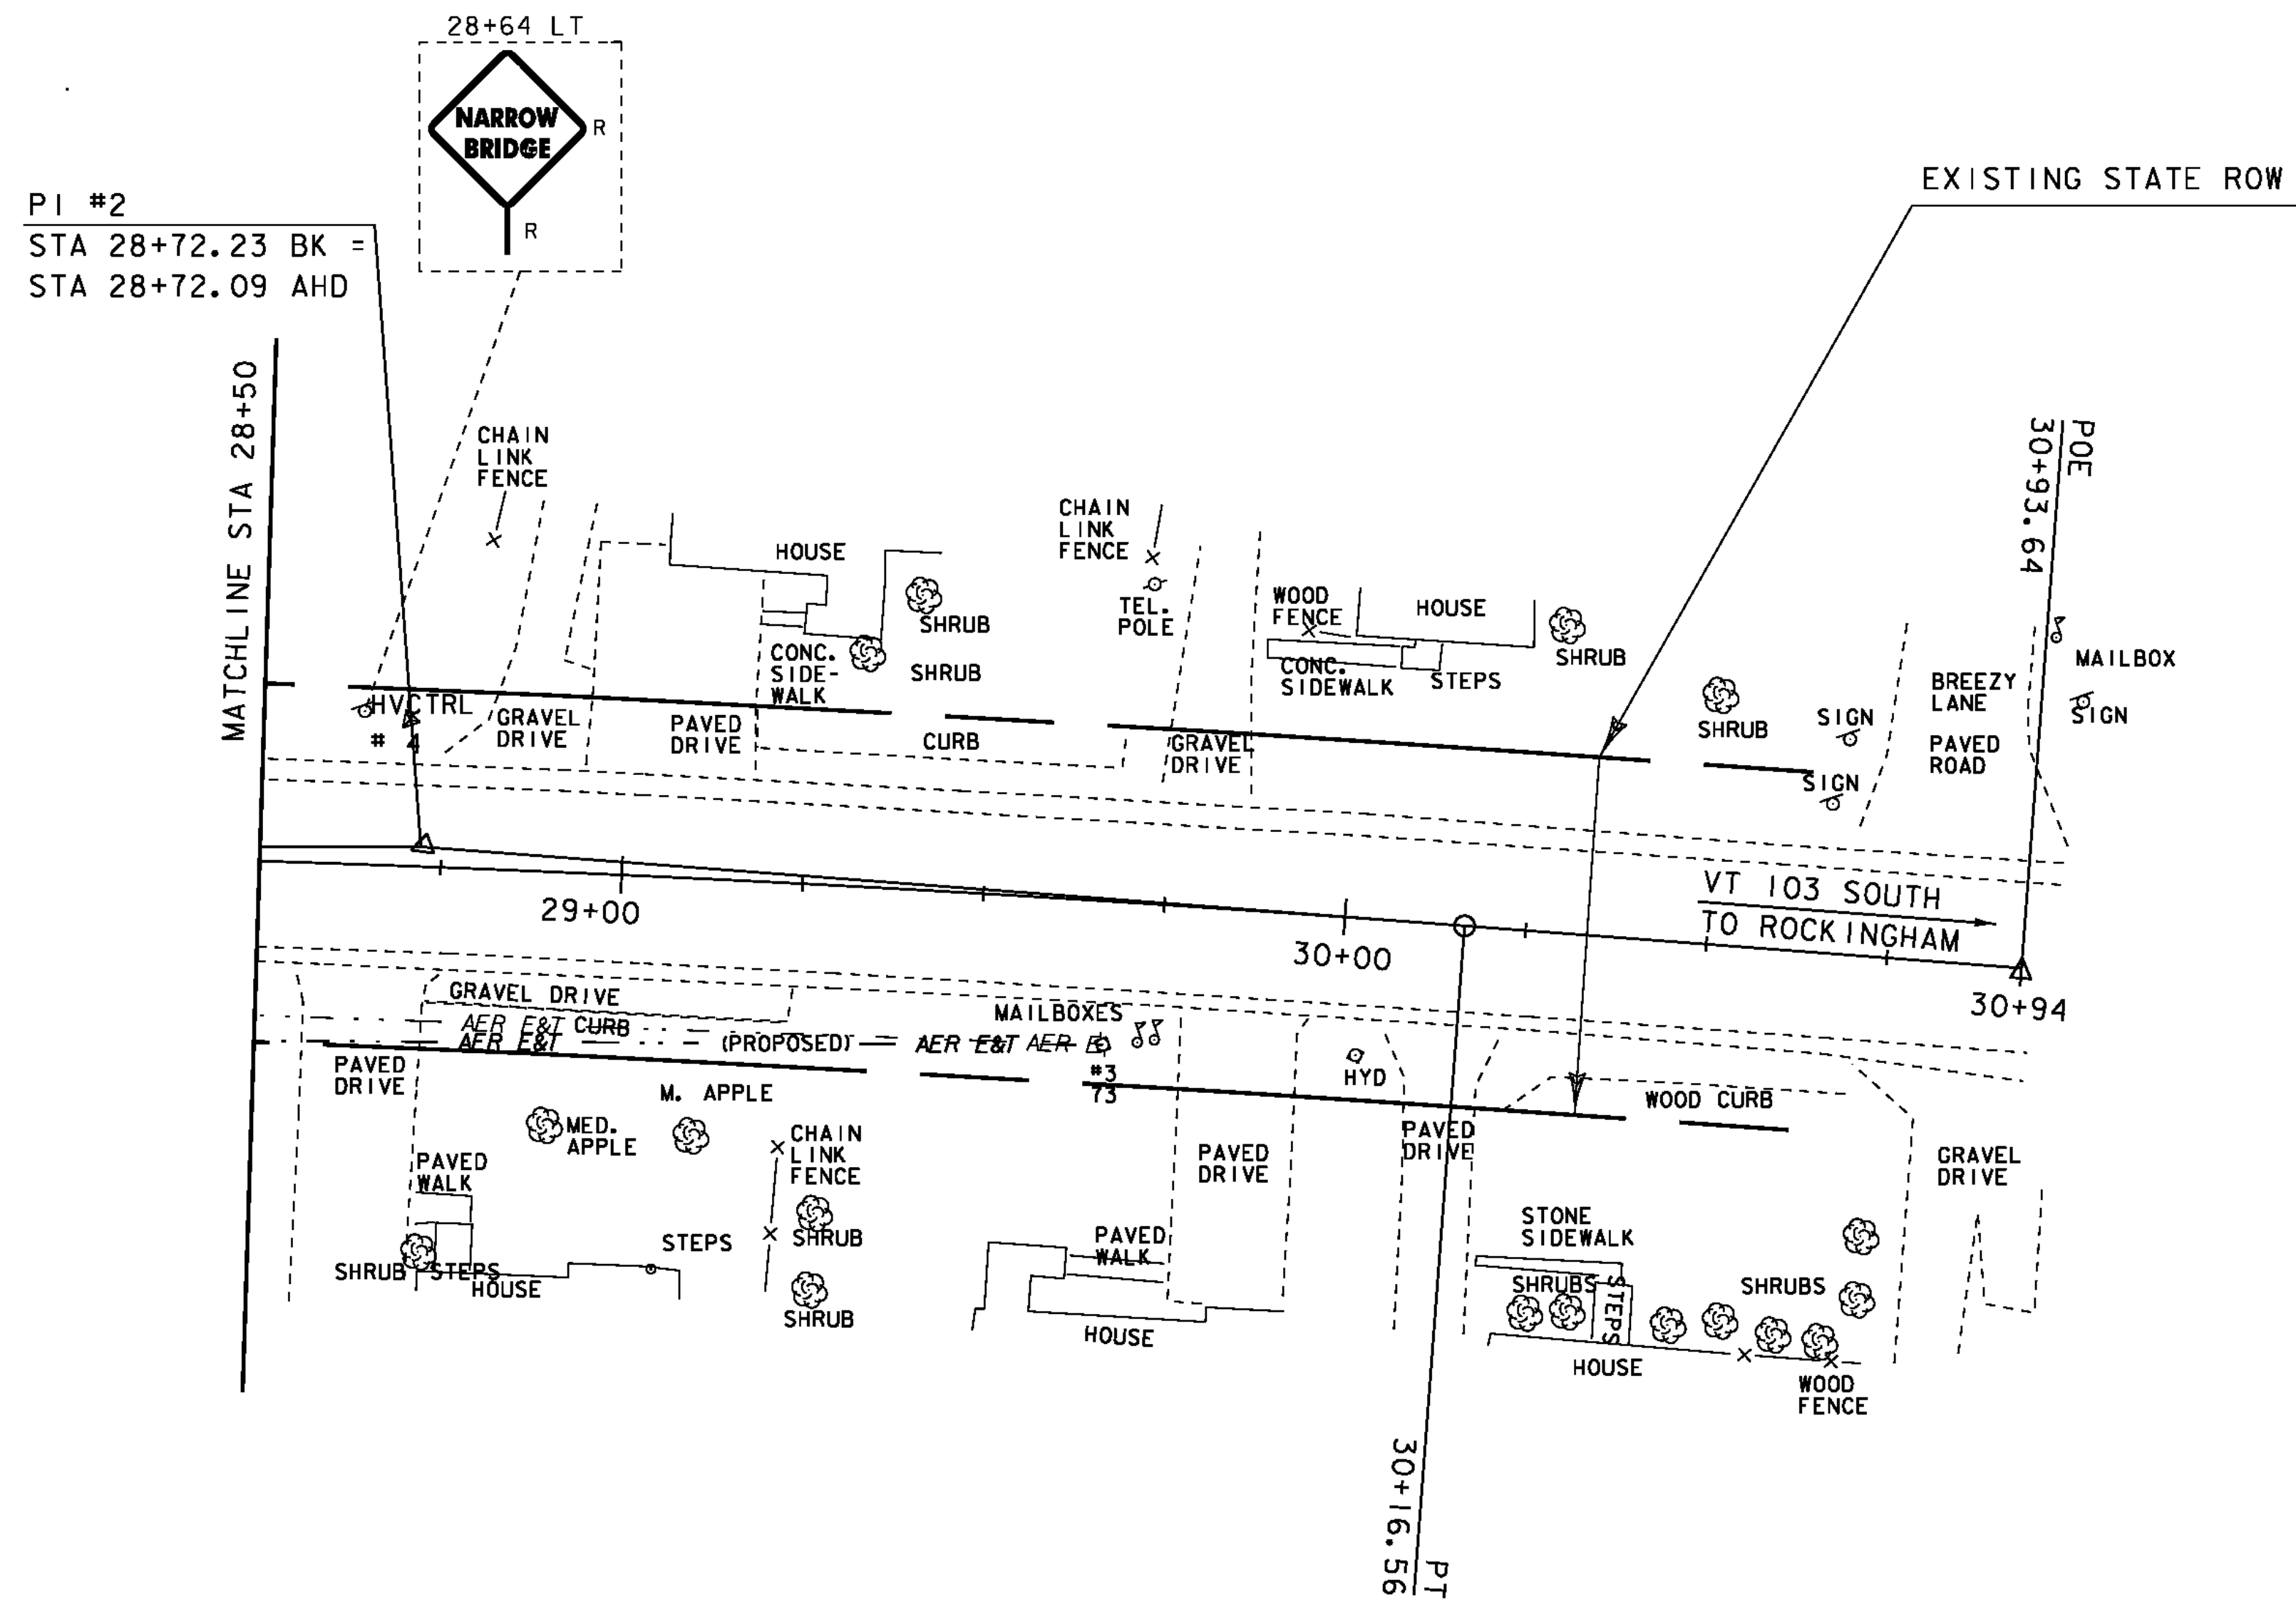


REMOVING SIGNS
STA 28+64 LT

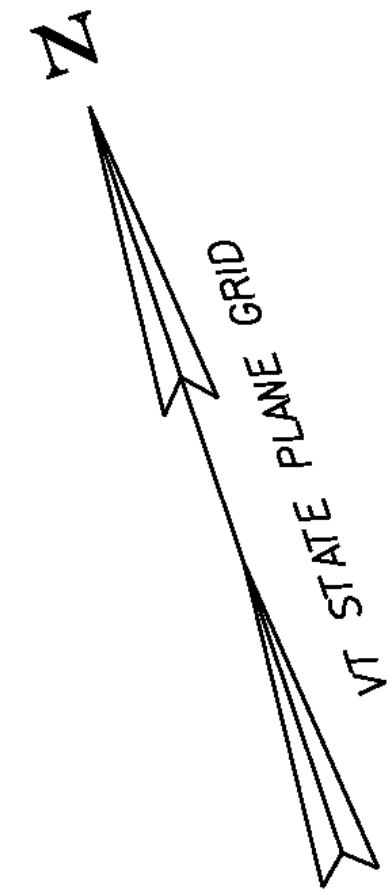

LAYOUT 2

SCALE 1" = 20'-0"
20 0 20

PROJECT NAME: CHESTER	PLOT DATE: 20-SEP-2010
PROJECT NUMBER: BRF 025-1(28)	DRAWN BY: M.FESSEL
FILE NAME: 84e061/Str/bdr.dgn	CHECKED BY: R.S.YOUNG
PROJECT LEADER: C.P.WILLIAMS	SHEET 18 OF 124
DESIGNED BY: R.S.YOUNG	
BRIDGE 8 LAYOUT 2	