


PLAN
SCALE: 1" = 10'-0"

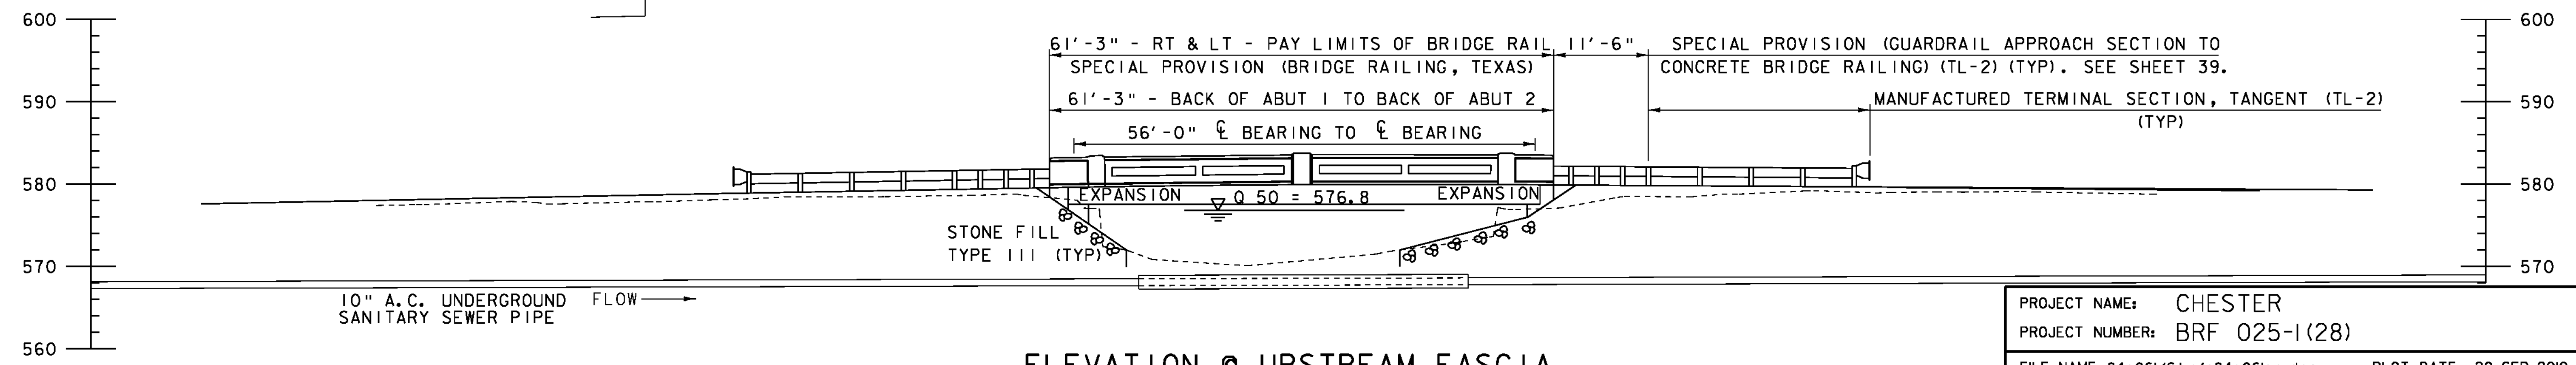

ELEVATION @ UPSTREAM FASCIA
SCALE: 1" = 10'-0"

PROJECT NAME:	CHESTER	FILE NAME:	84e061/Str/s84e06ipe.dgn	PLOT DATE:	20-SEP-2010
PROJECT NUMBER:	BRF 025-1(28)	PROJECT LEADER:	C.P.WILLIAMS	DRAWN BY:	M.FESSEL
		DESIGNED BY:	R.S.YOUNG	CHECKED BY:	R.S.YOUNG
		BRIDGE 8 PLAN AND ELEVATION		SHEET	26 OF 124

