


**LEGEND**

- AER E&T — AERIAL ELECTRIC & TELEPHONE
- ARCH — ARCHEOLOGICAL AREA
- HISTORIC — HISTORIC AREA
- P — PROPERTY LINE
- L — RIPARIAN BUFFER
- S — SANITARY SEWER PIPE

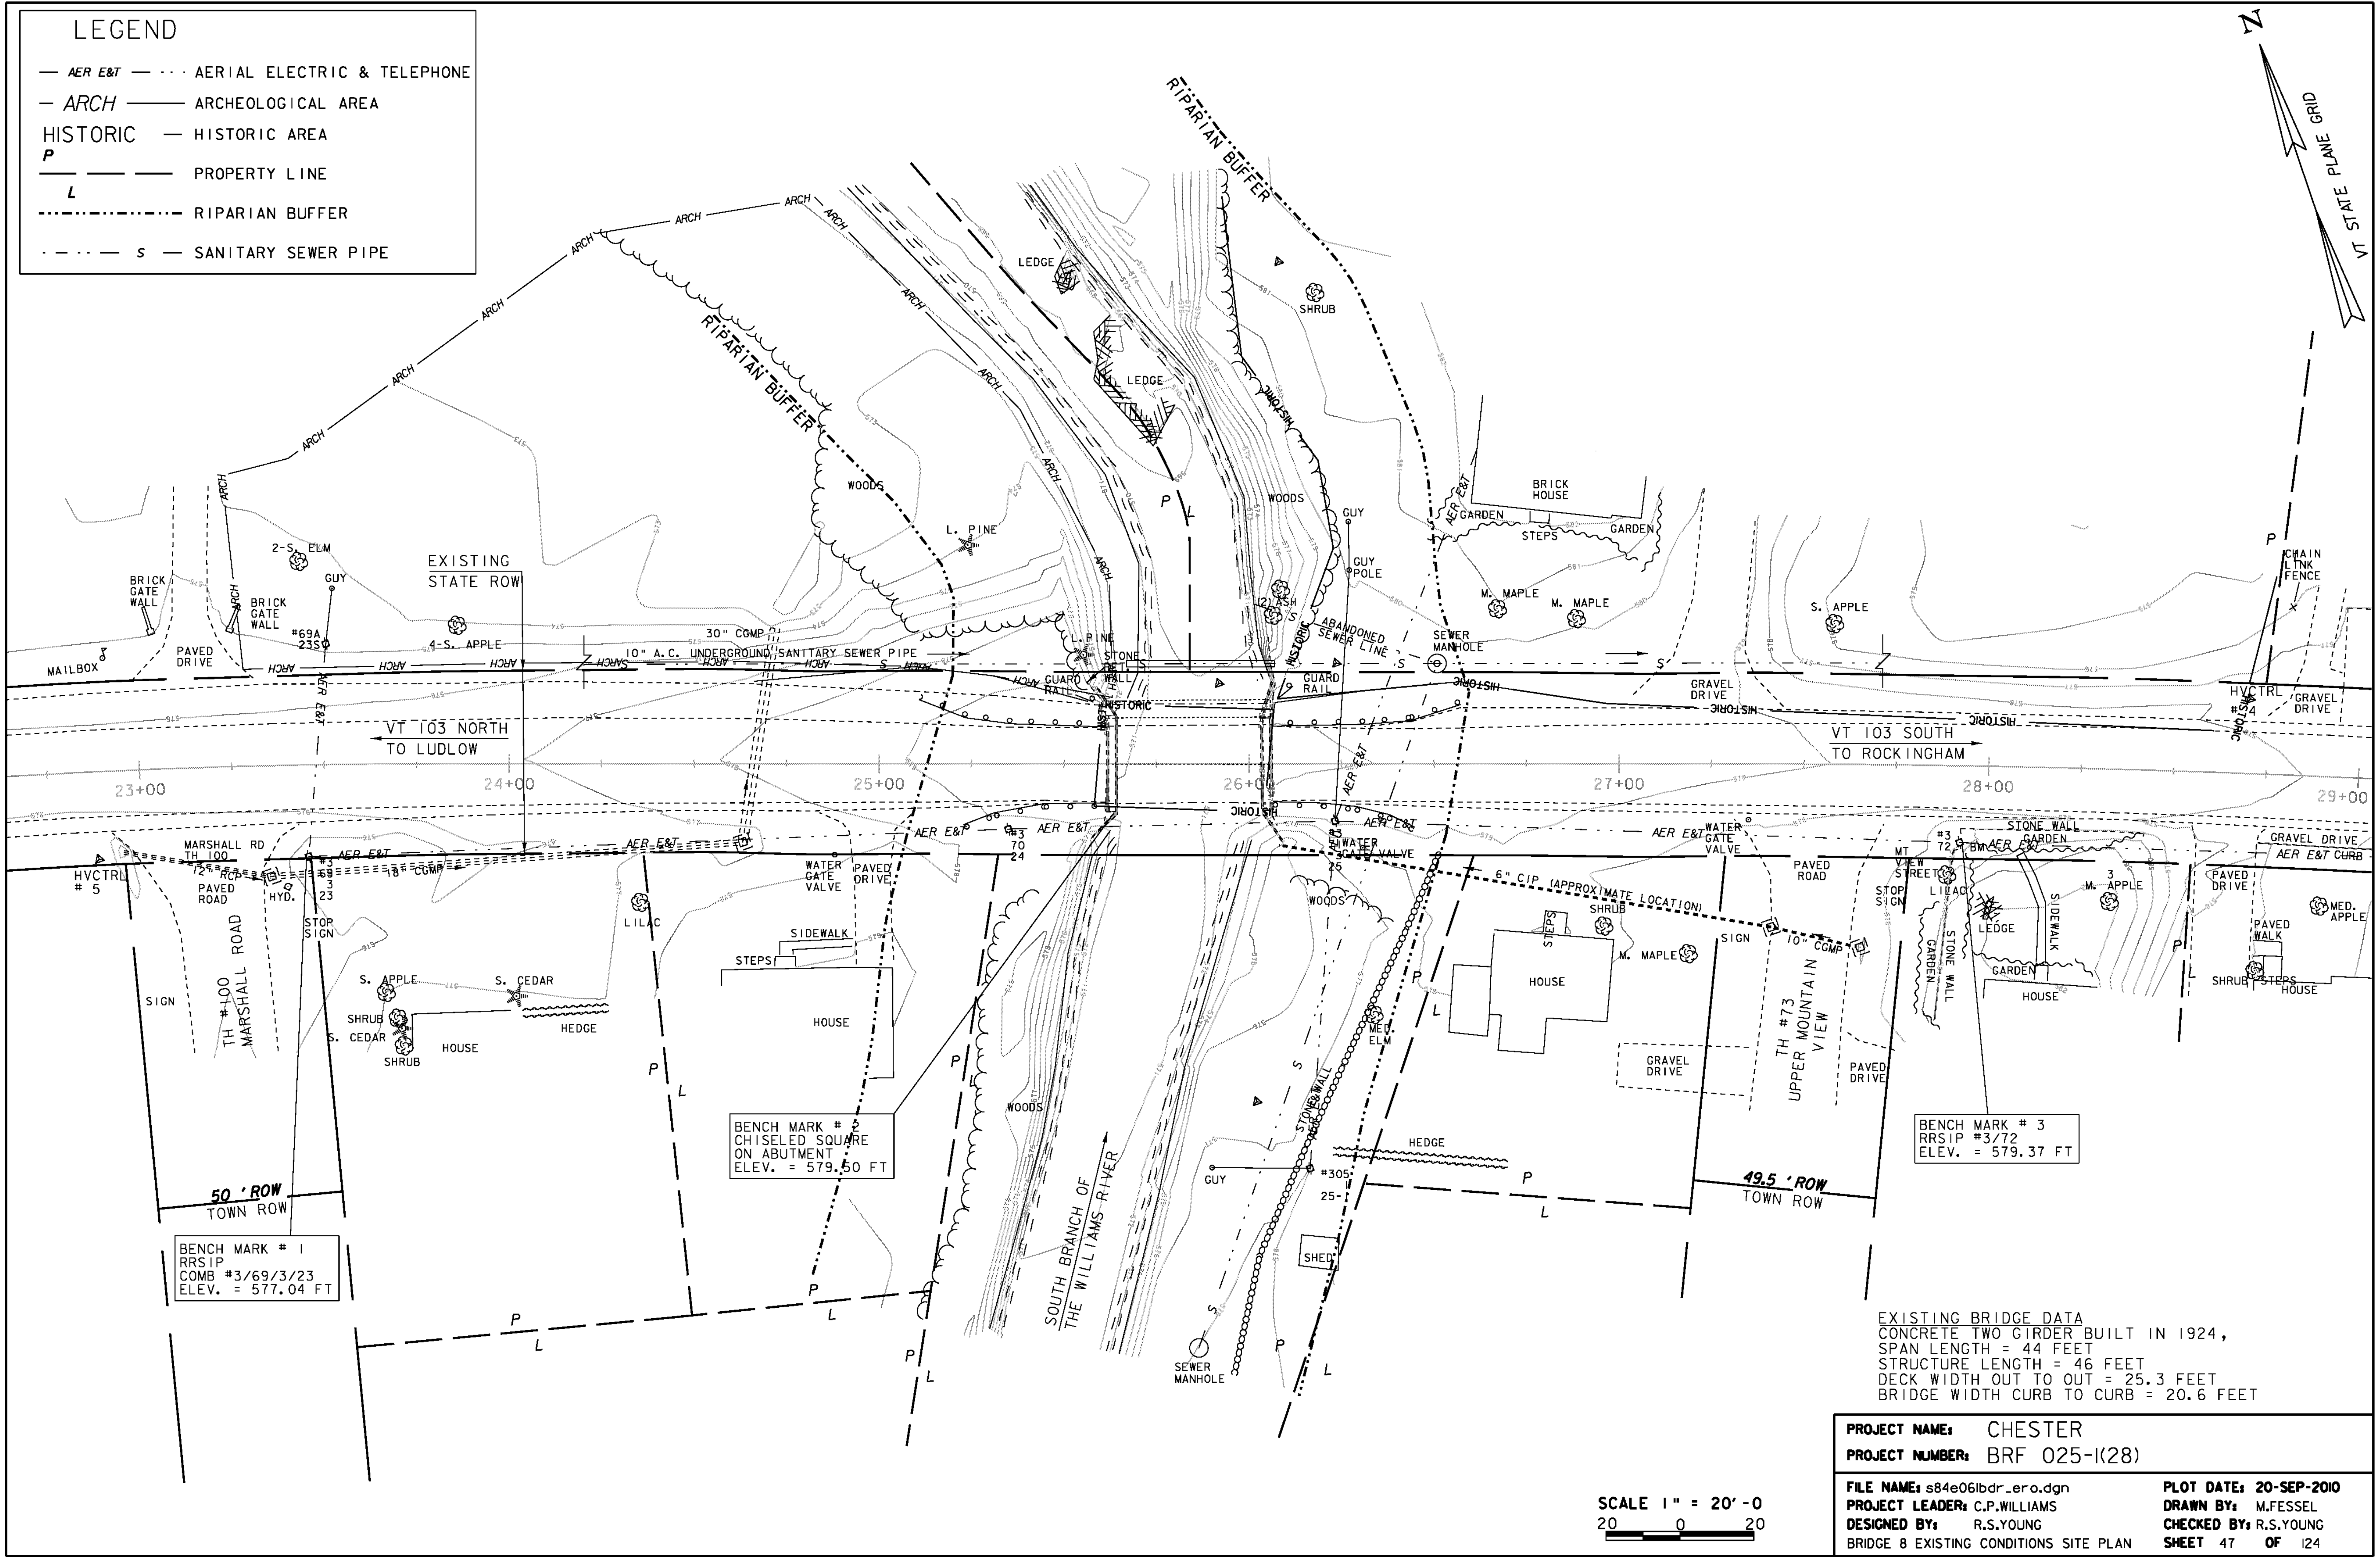

EXISTING BRIDGE DATA  
 CONCRETE TWO GIRDER BUILT IN 1924,  
 SPAN LENGTH = 44 FEET  
 STRUCTURE LENGTH = 46 FEET  
 DECK WIDTH OUT TO OUT = 25.3 FEET  
 BRIDGE WIDTH CURB TO CURB = 20.6 FEET

**PROJECT NAME:** CHESTER  
**PROJECT NUMBER:** BRF 025-1(28)  
**FILE NAME:** s84e06lbr\_ero.dgn  
**PROJECT LEADER:** C.P.WILLIAMS  
**DESIGNED BY:** R.S.YOUNG  
**BRIDGE 8 EXISTING CONDITIONS SITE PLAN**  
**PLOT DATE:** 20-SEP-2010  
**DRAWN BY:** M.FESSEL  
**CHECKED BY:** R.S.YOUNG  
**SHEET 47 OF 124**

SCALE 1" = 20'-0"  
 20 0 20