
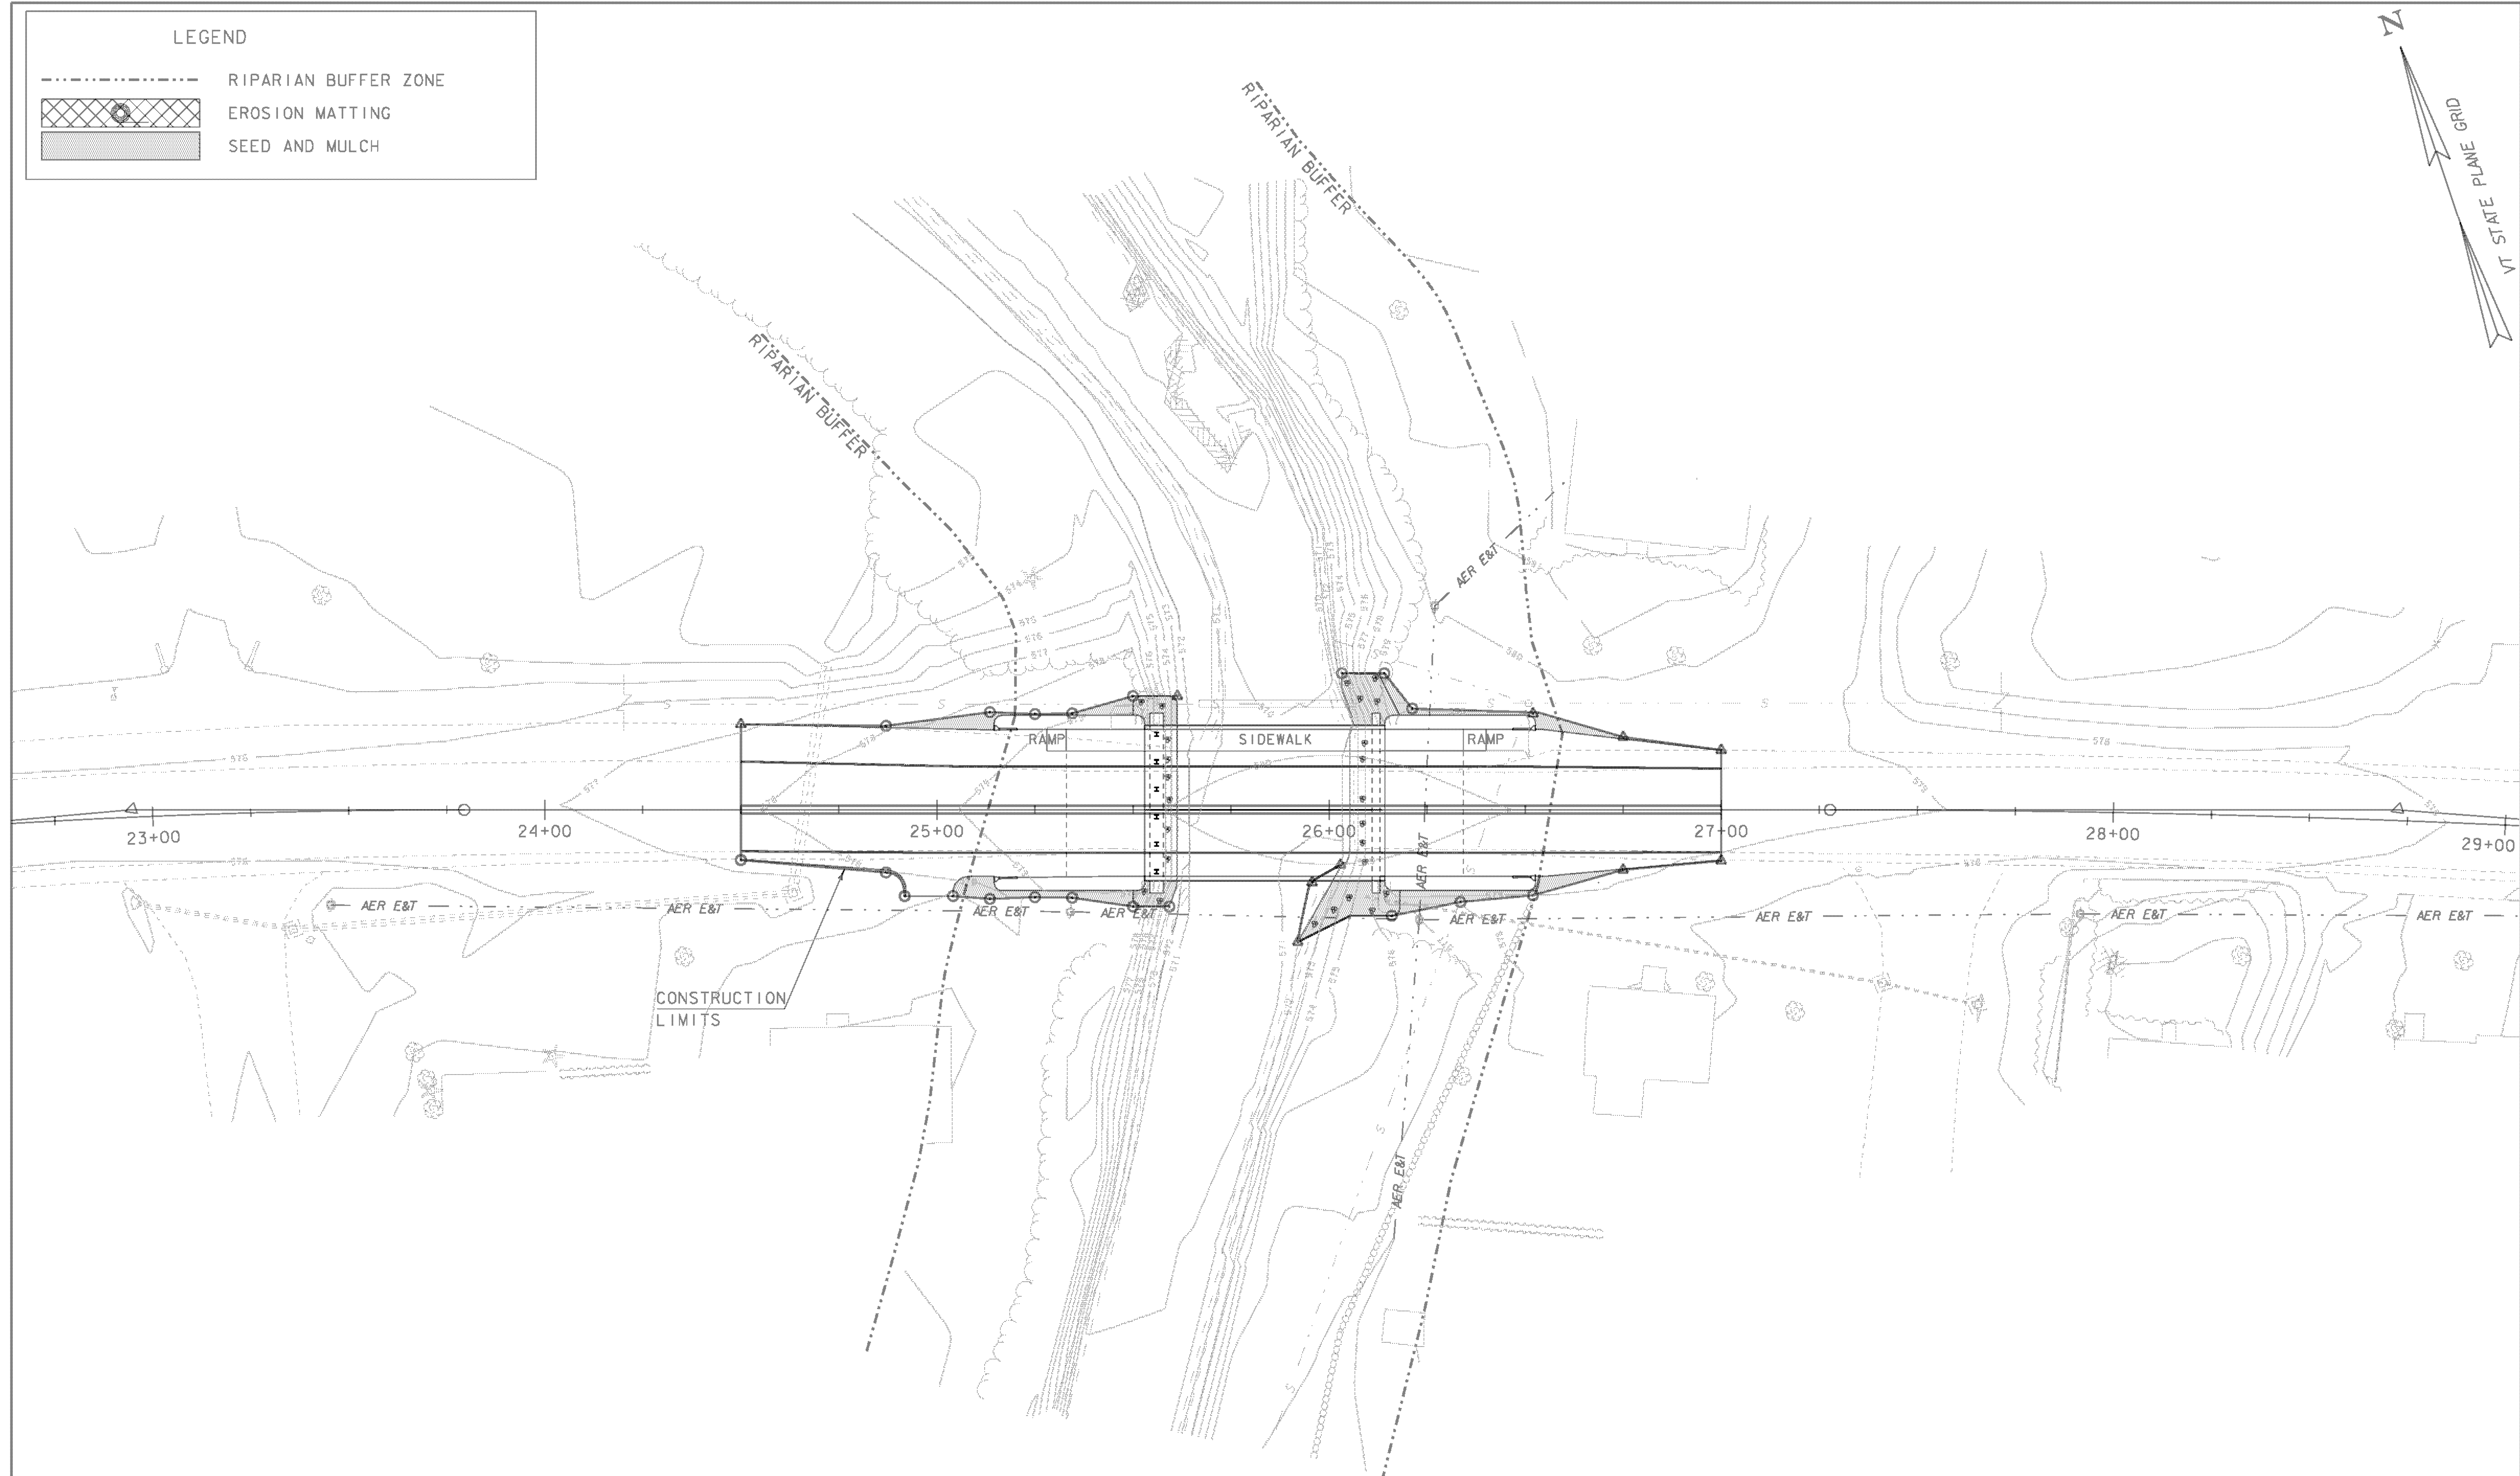


LEGEND

-  RIPARIAN BUFFER ZONE
-  EROSION MATTING
-  SEED AND MULCH

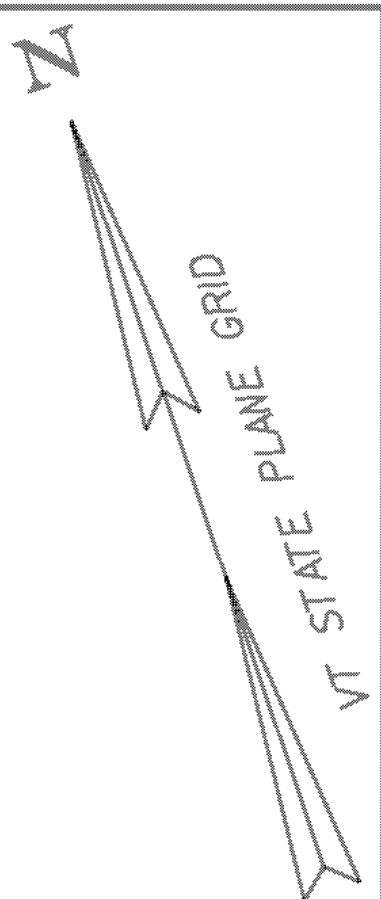

PROJECT NAME:	CHESTER	PLOT DATE:	20-SEP-2010
PROJECT NUMBER:	BRF 025-1(28)	DRAWN BY:	M.FESSEL
FILE NAME:	s84e06lbr_ero.dgn	CHECKED BY:	R.S.YOUNG
PROJECT LEADER:	C.P.WILLIAMS		
DESIGNED BY:	R.S.YOUNG		
BRIDGE 8 FINAL CONDITIONS SITE PLAN		SHEET	49 OF 124

SCALE 1" = 20'-0"  
