


VT RT 103 BANKING DIAGRAM
 HORIZONTAL SCALE : 1" = 20'-0"
 VERTICAL SCALE : 1" = .02' /'

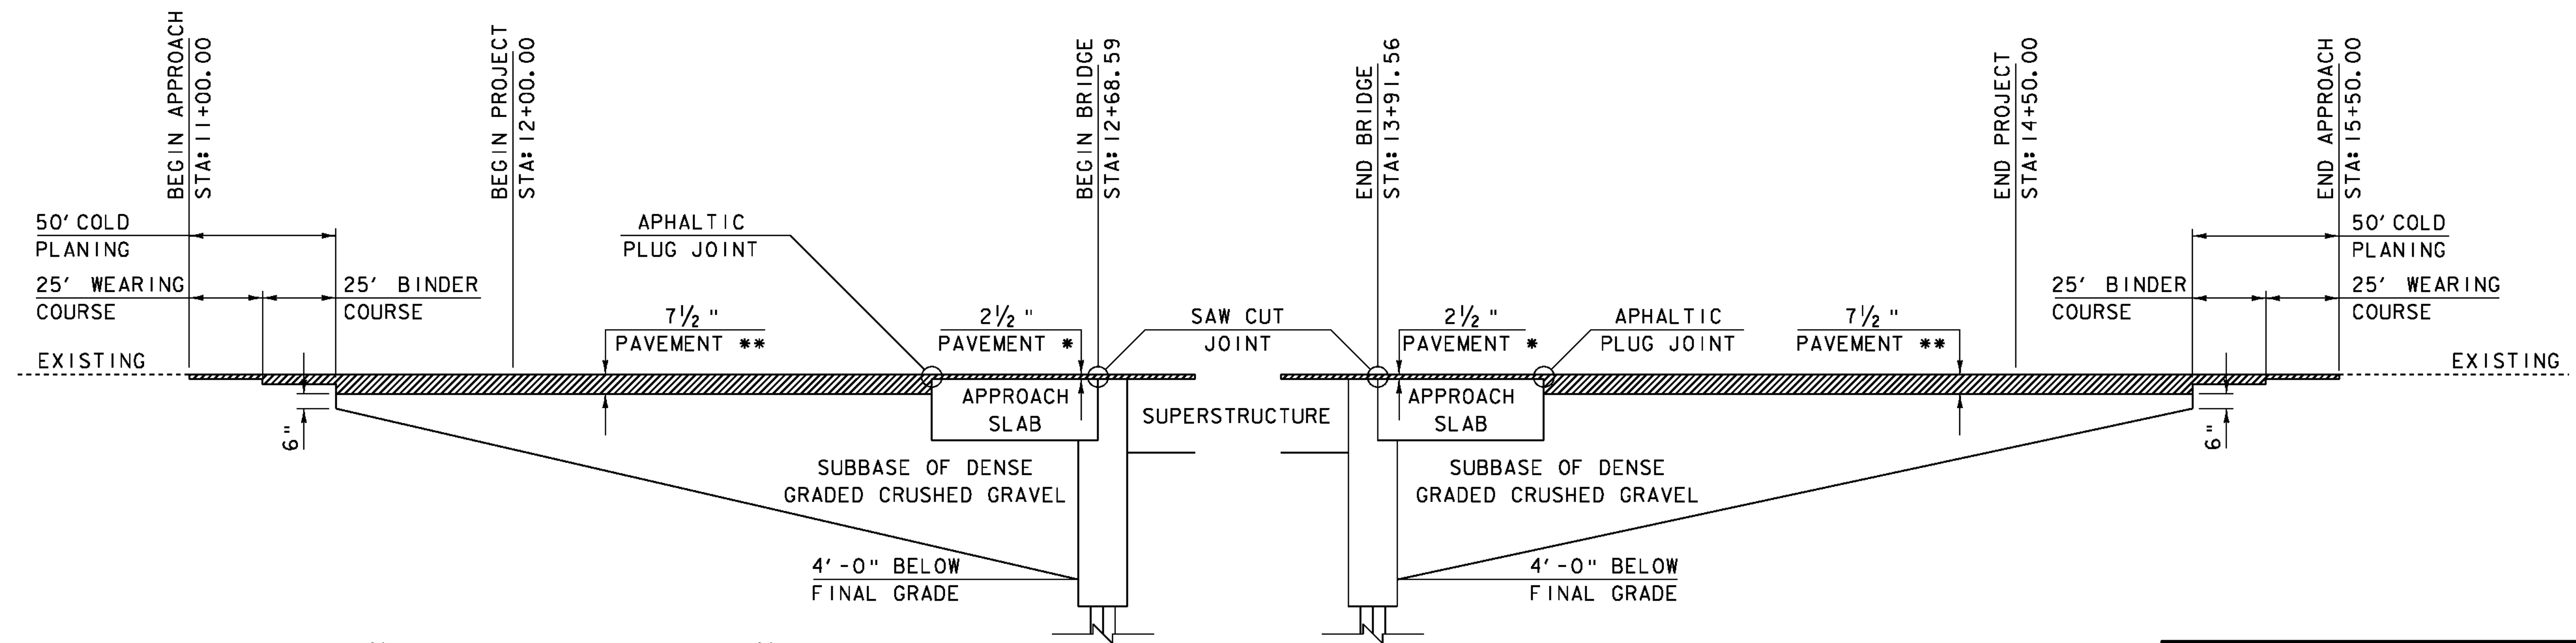

- ** 1/4" TYPE IV OVER
 1/4" TYPE IV OVER
 2 1/2" TYPE II OVER
 2 1/2" TYPE II
- * 1/4" TYPE IV OVER
 1/4" TYPE IV

VT RT 103 TRANSITION DIAGRAMS

N. T. S.

PROJECT NAME:	CHESTER
PROJECT NUMBER:	BRF 025-1(37)
FILE NAME:	95b168\s95b168pro. dgn
PROJECT LEADER:	C.P.WILLIAMS
DESIGNED BY:	R.S.YOUNG
BRIDGE 9 BANKING & TRANSITION DIAGRAM	
PLOT DATE:	20-SEP-2010
DRAWN BY:	D.D.BEARD
CHECKED BY:	R.S.YOUNG
SHEET 71	OF 124