



ABUTMENT #1 PLAN
 SCALE 3/8" = 1'-0"
 SEE SHEET 96 FOR SECTIONS "A-A" & "B-B"

ABUTMENT #1, WW1
 FIELD CHANGES
 LOWERED CONCRETE HEIGHT
 AND ANGLED WING WALL

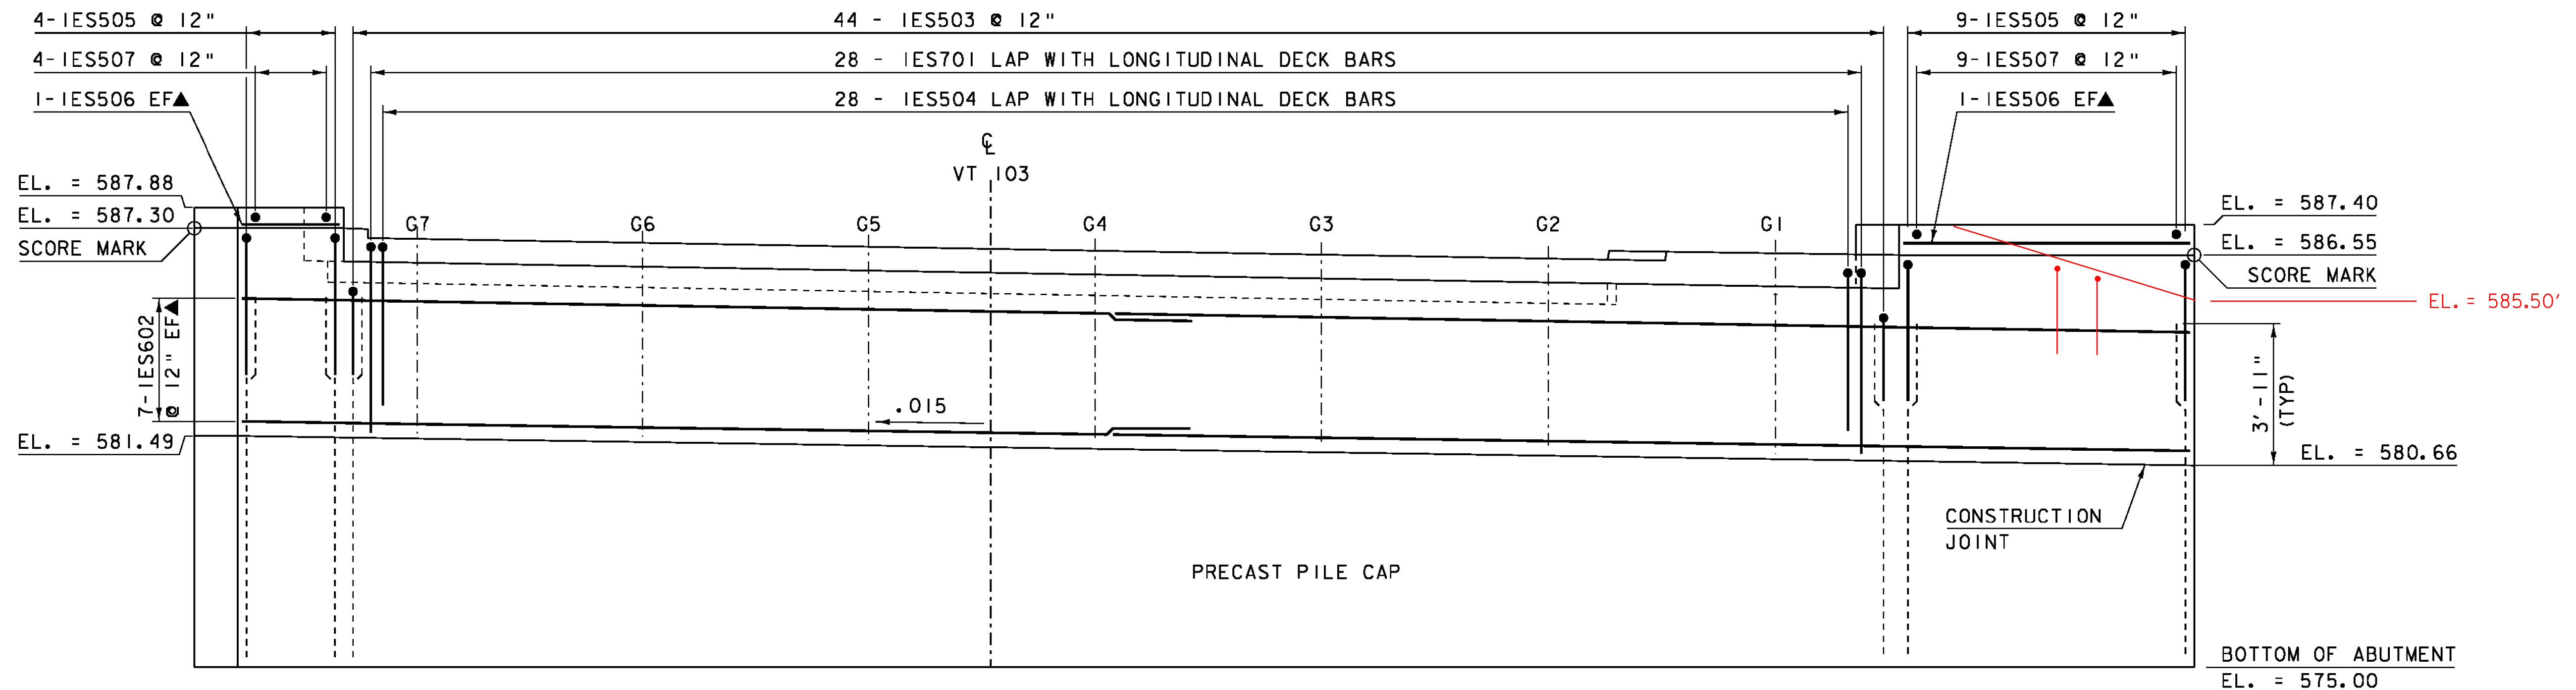

ABUTMENT #1 ELEVATION
 SCALE 3/8" = 1'-0"

NOTE:
 NF = NEAR FACE
 FF = FAR FACE
 EF = EACH FACE
 ▲ = CUT TO FIT IN FIELD
 3" CLEAR, UNLESS OTHERWISE
 SPECIFIED ON THE PLANS.
 2'-2" BAR LAP UNLESS OTHERWISE
 SPECIFIED ON THE PLANS.

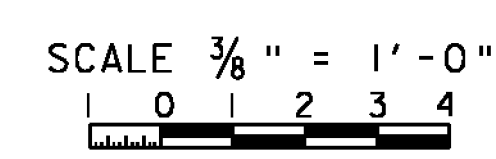

PROJECT NAME: CHESTER	PLOT DATE: 20-SEP-2010
PROJECT NUMBER: BRF 025-1(37)	DRAWN BY: D.D.BEARD
FILE NAME: 95b168\s95b168sub.dgn	CHECKED BY: R.S.YOUNG
PROJECT LEADER: C.P.WILLIAMS	SHEET 92 OF 124
DESIGNED BY: R.S.YOUNG	