

NOTE:


- NF = NEAR FACE
- FF = FAR FACE
- EF = EACH FACE
- ▲ = CUT TO FIT IN FIELD
- 3" CLEAR, UNLESS OTHERWISE SPECIFIED ON THE PLANS.
- 2'-2" BAR LAP UNLESS OTHERWISE SPECIFIED ON THE PLANS.

ABUTMENT #2 PLAN

SCALE 3/8" = 1'-0"


SEE SHEET 96 FOR SECTIONS "A-A" & "B-B"

ABUTMENT #2, WW4
FIELD CHANGES:
LOWERED CONCRETE HEIGHT
AND ANGLED WINGWALL

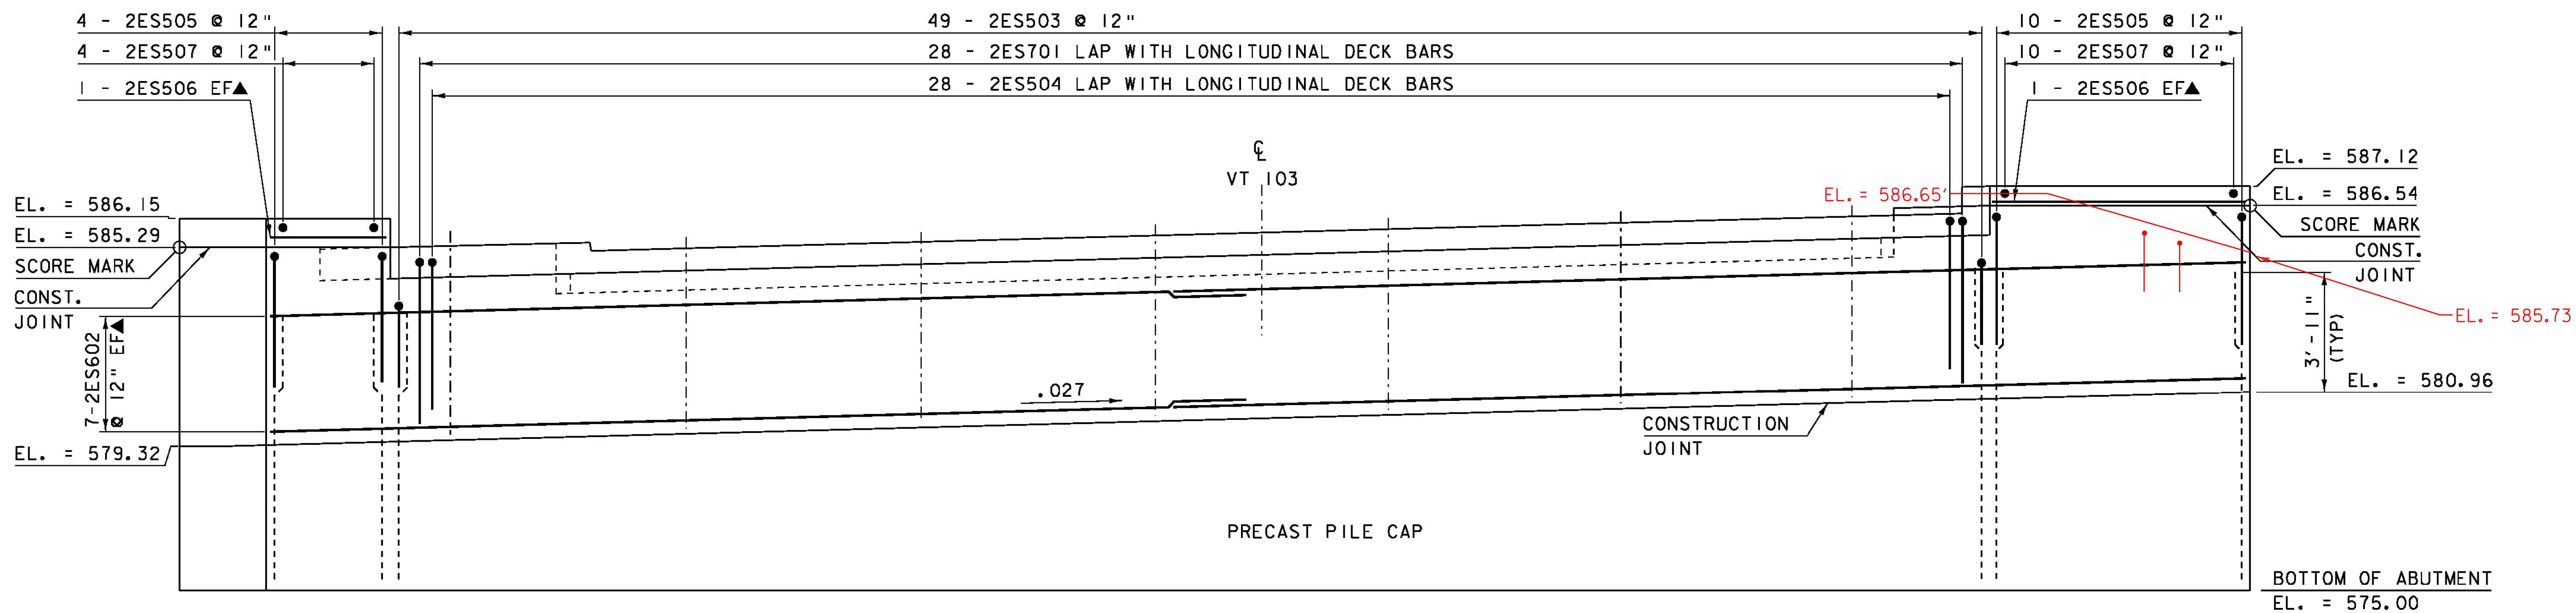

ABUTMENT #2 ELEVATION

SCALE 3/8" = 1'-0"

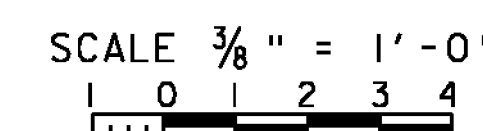

PROJECT NAME: CHESTER	PLOT DATE: 20-SEP-2010
PROJECT NUMBER: BRF 025-1(37)	DRAWN BY: D.D.BEARD
FILE NAME: 95b168\s95b168sub.dgn	CHECKED BY: R.S.YOUNG
PROJECT LEADER: C.P.WILLIAMS	SHEET 93 OF 124
DESIGNED BY: R.S.YOUNG	