
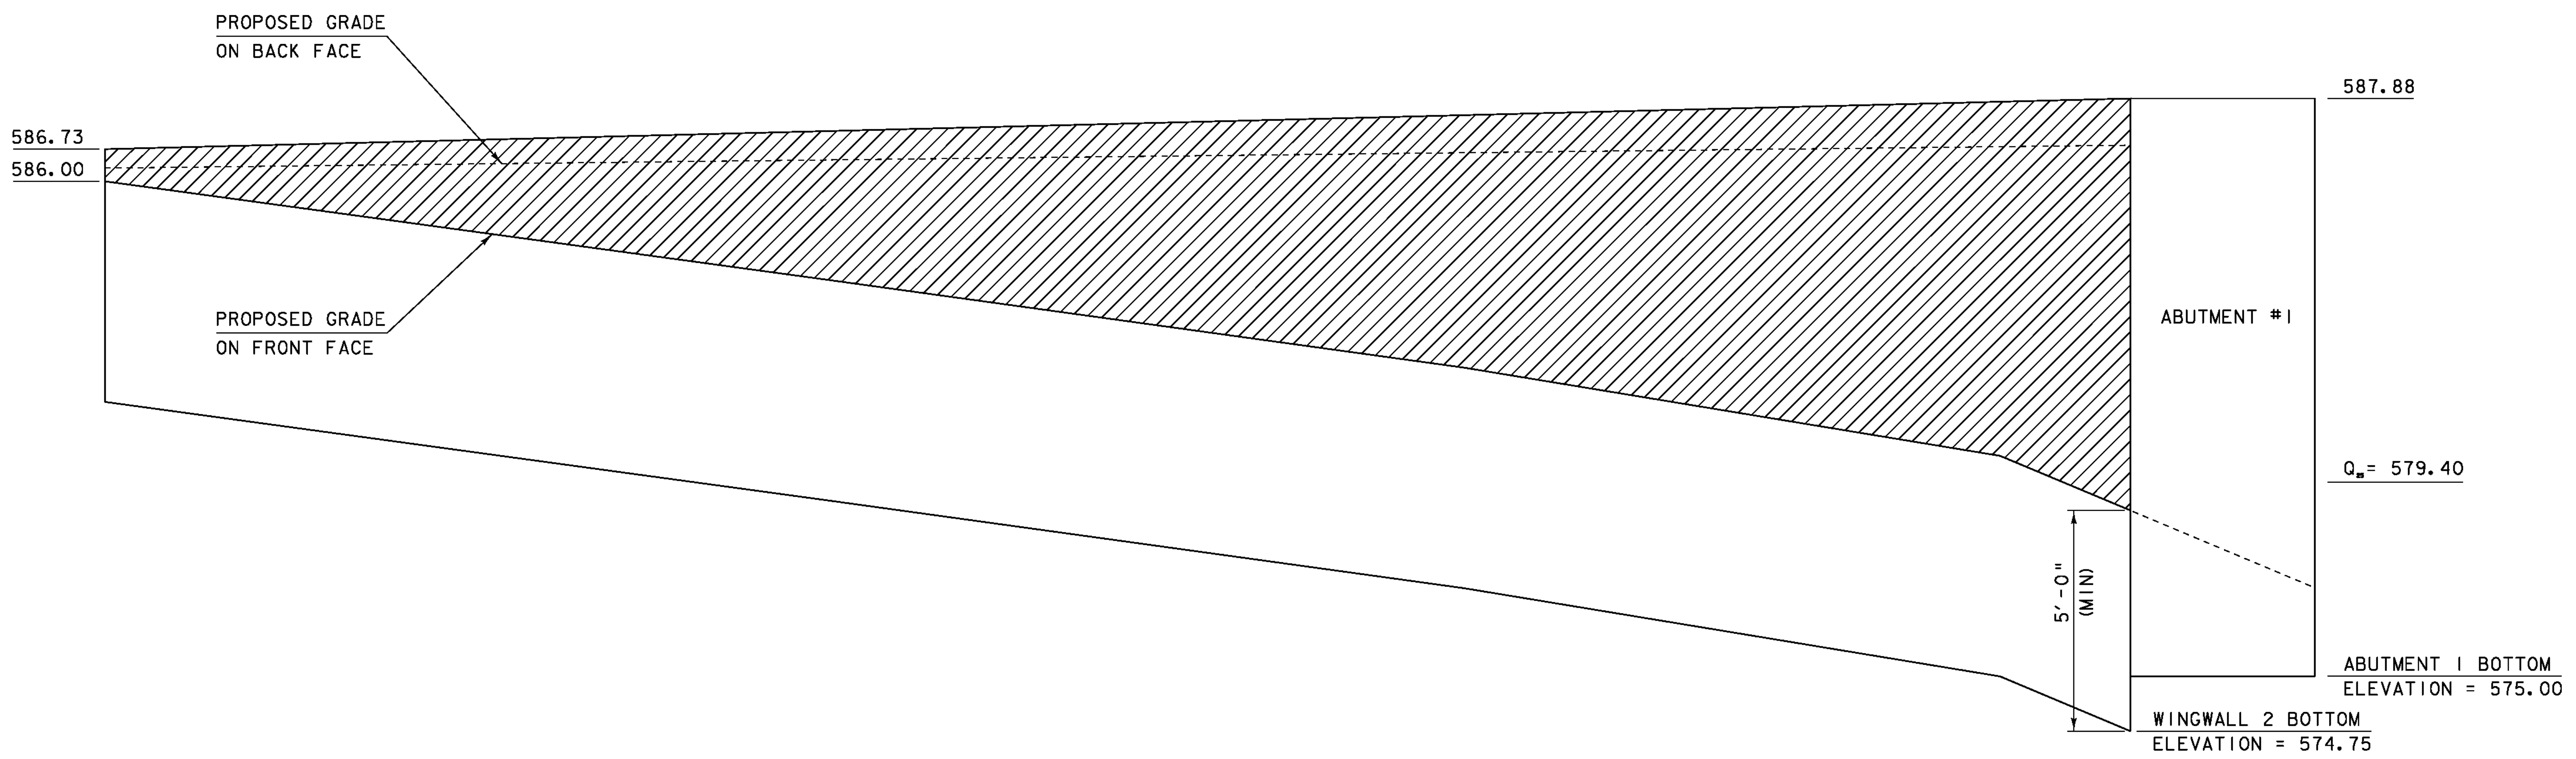


WINGWALL 2 PLAN VIEW
SCALE 1/2" = 1'-0"

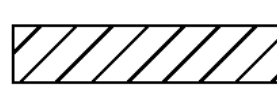

WINGWALL 2 ELEVATION VIEW
SCALE 1/2" = 1'-0"

 PAY LIMITS OF ITEM 900.670 "SPECIAL PROVISION (RETAINING WALL)"

SEE SHEET 98 FOR
ADDITIONAL INFORMATION
AND TYPICAL SECTION

PROJECT NAME:	CHESTER	PLOT DATE:	21-SEP-2010
PROJECT NUMBER:	BRF 025-1(37)	DRAWN BY:	D.D.BEARD
FILE NAME:	95b168\s95b168sub.dgn	CHECKED BY:	E.R.CHARBONNEAU
PROJECT LEADER:	C.P.WILLIAMS	SHEET	97 OF 124
DESIGNED BY:	R.S.YOUNG		
BRIDGE 9 WINGWALL 2 DETAILS			

