



BEGIN APPROACH  
STATION 11+00.00

11+00

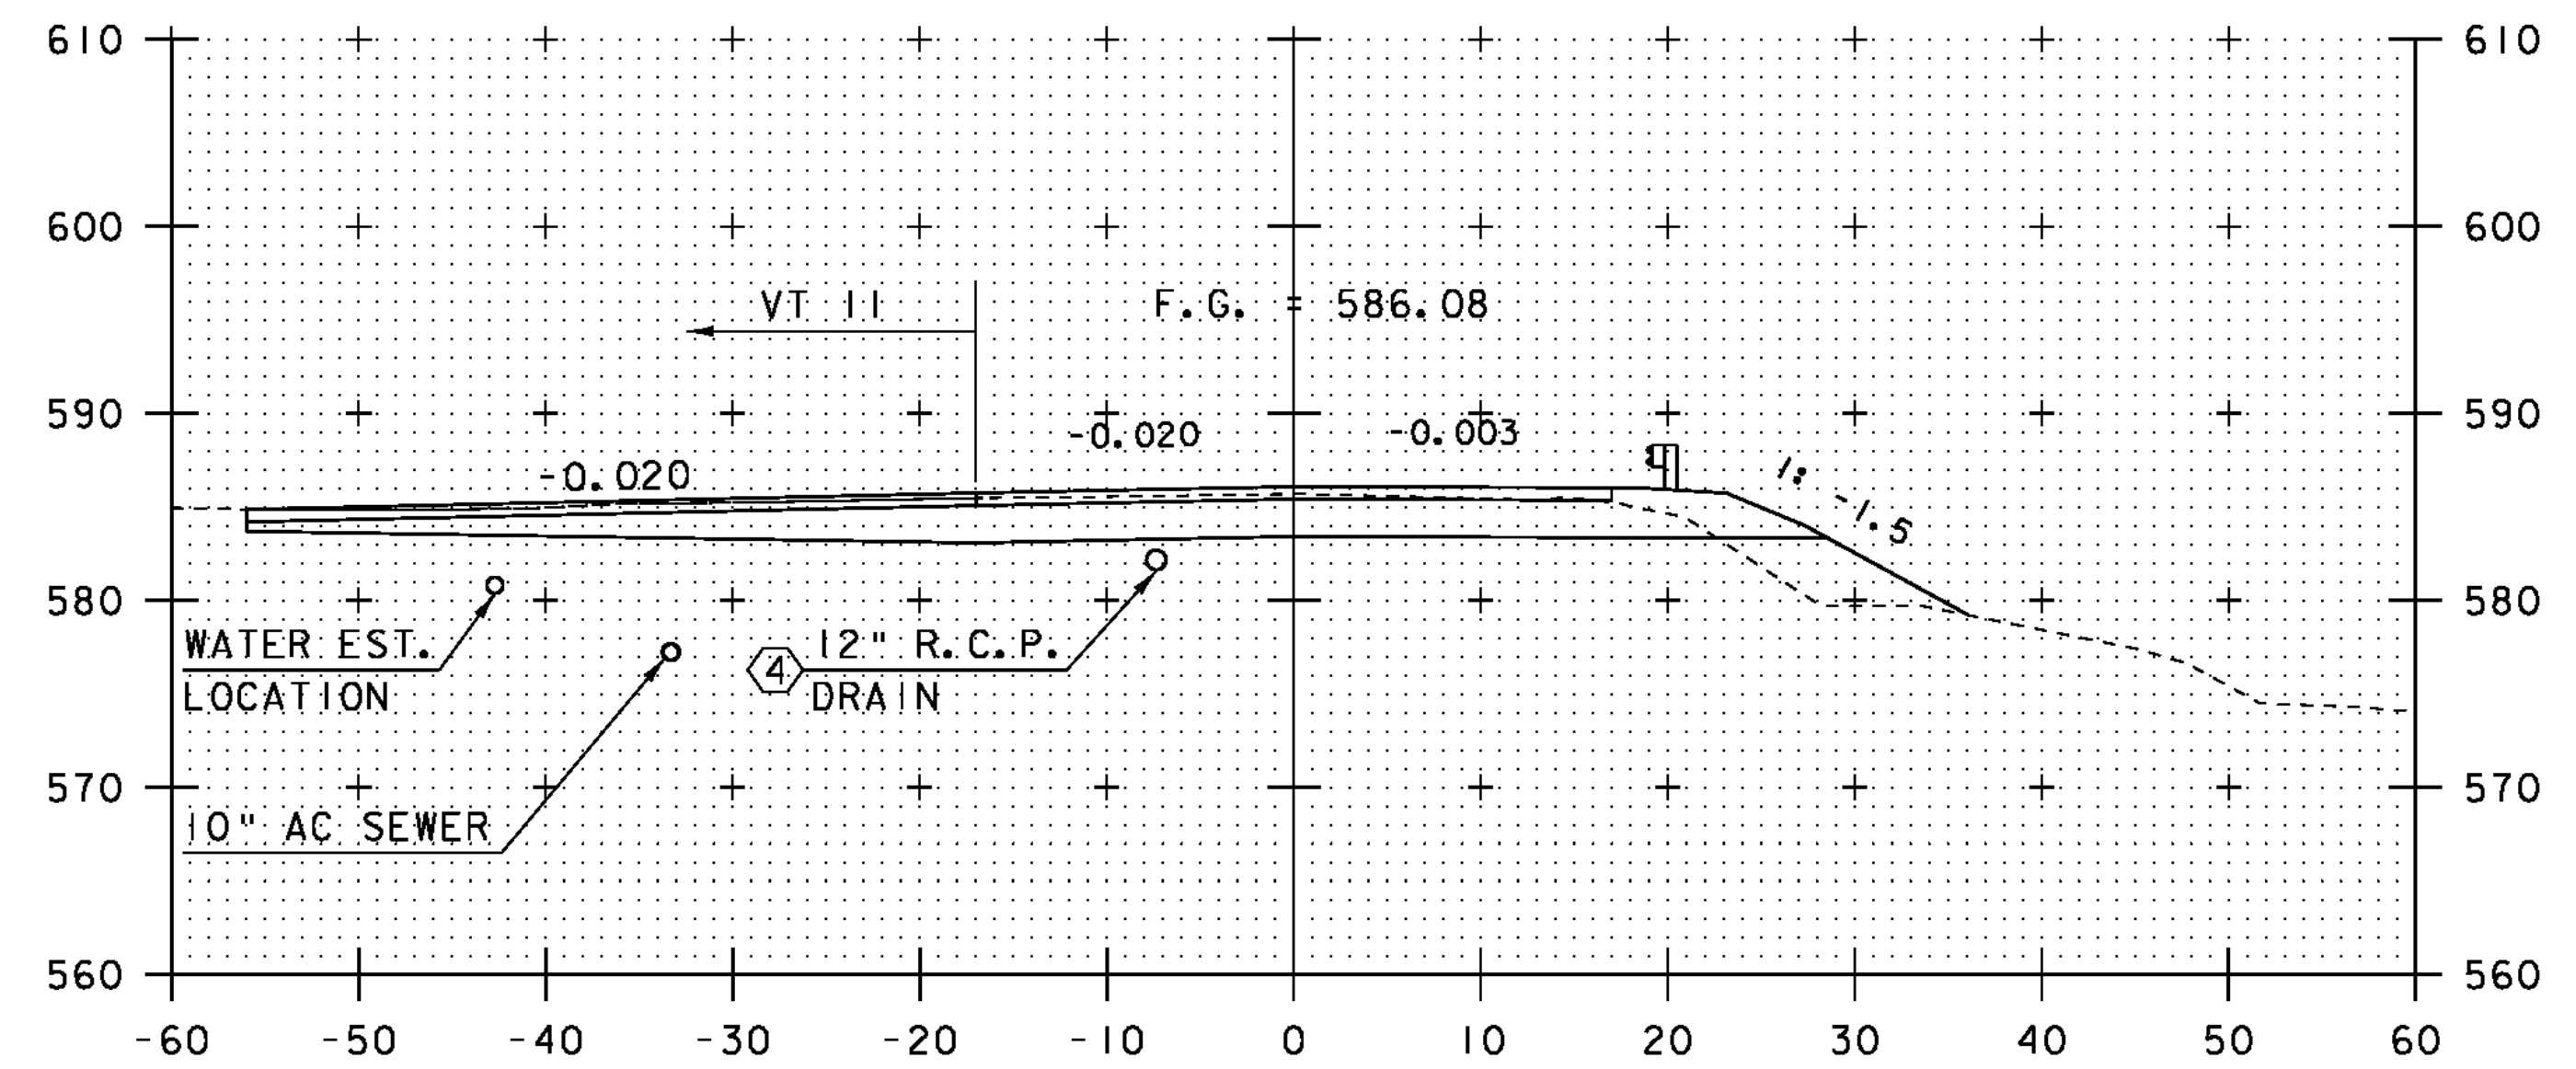


BEGIN PROJECT  
STATION 12+00.00

12+00

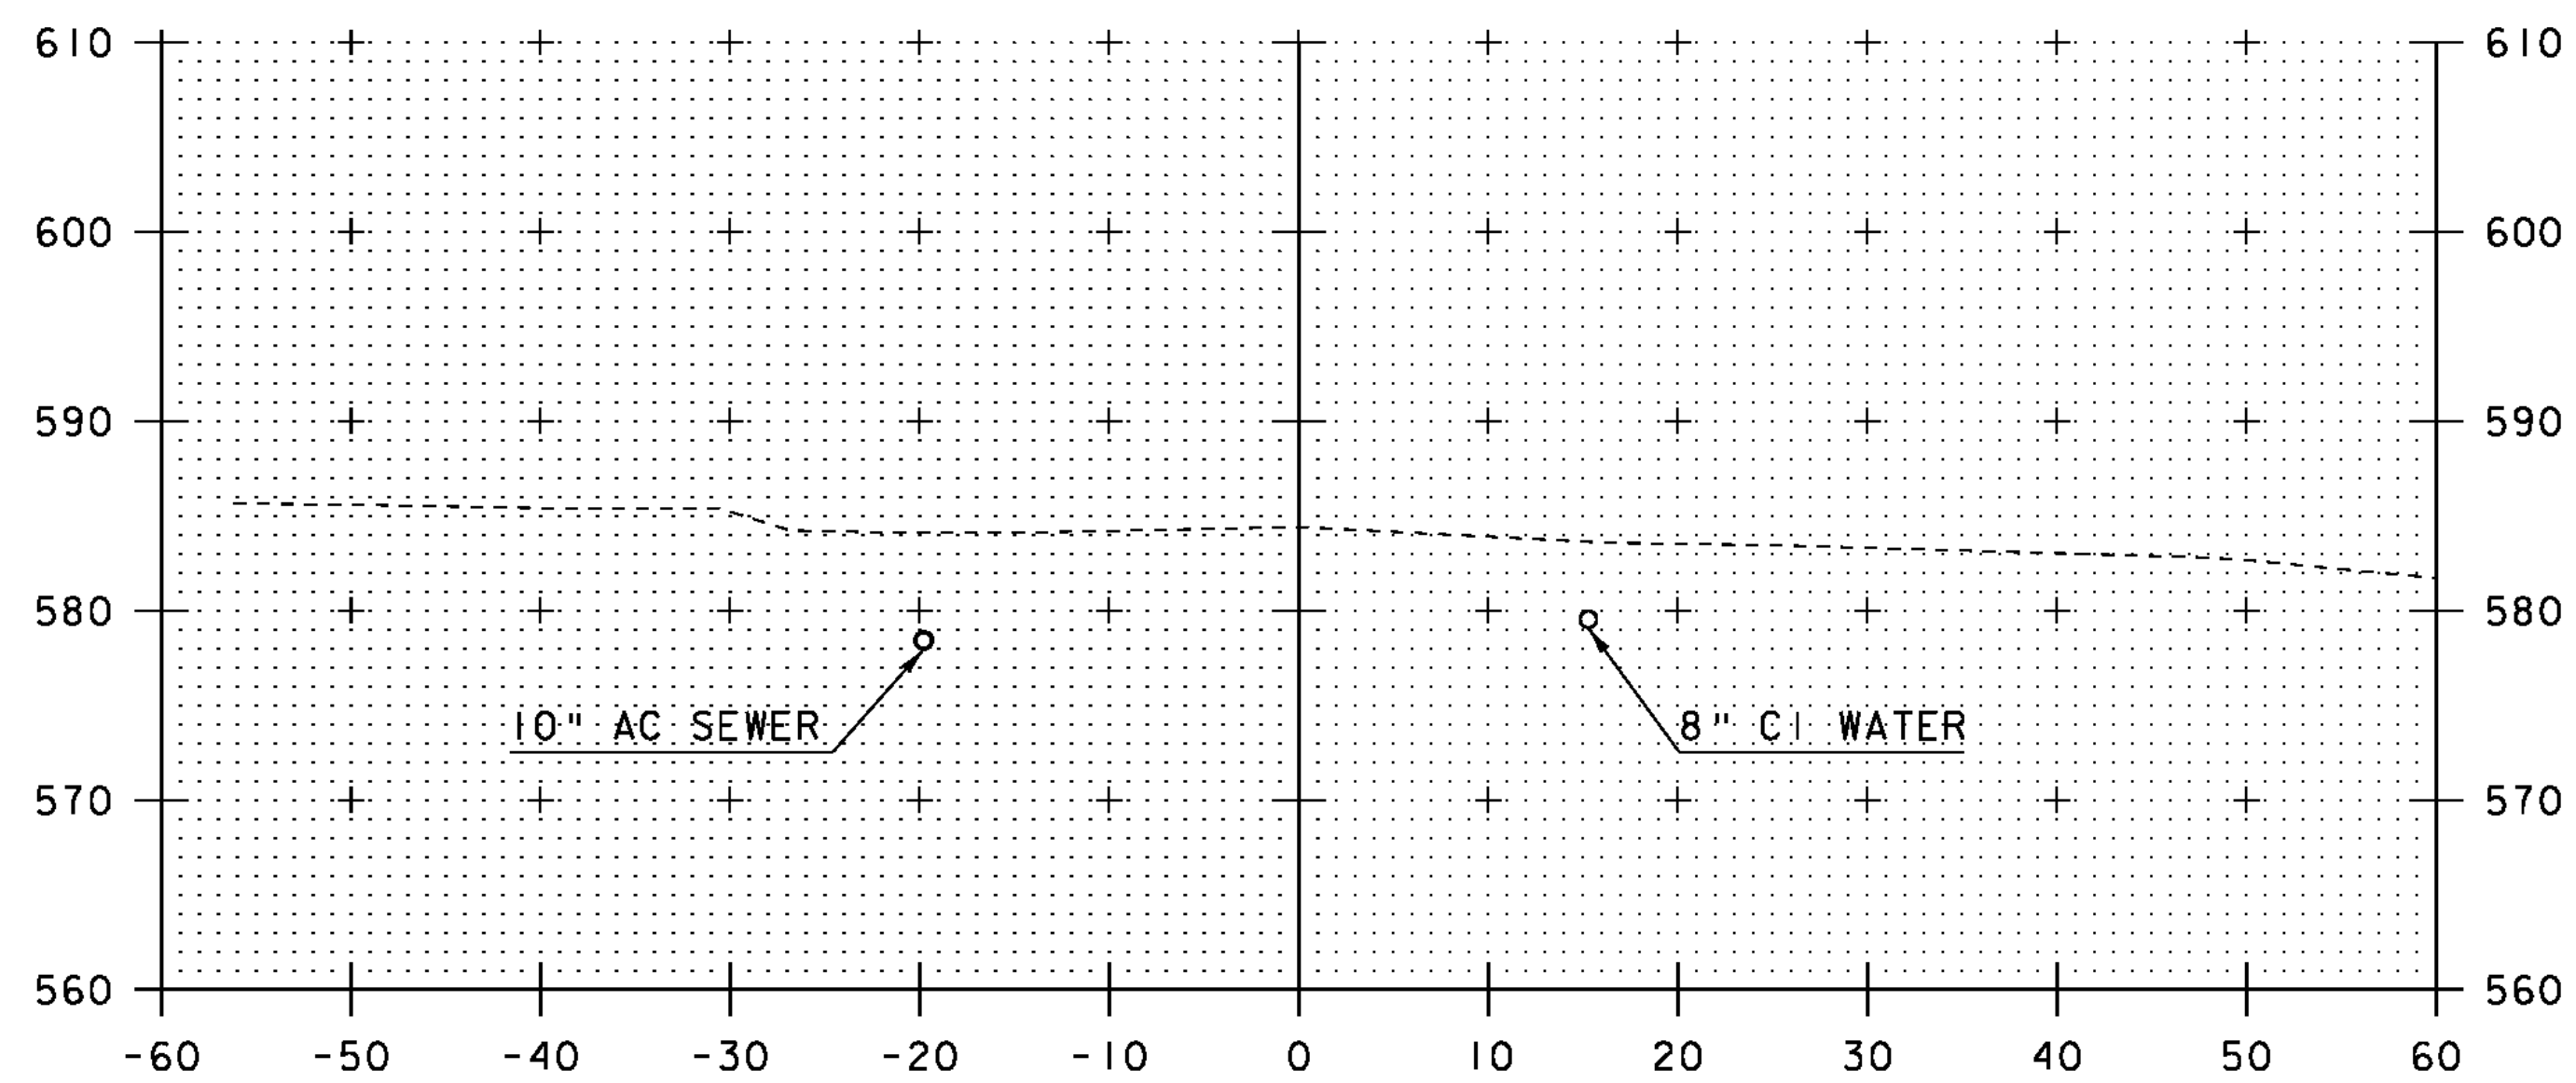

10+50

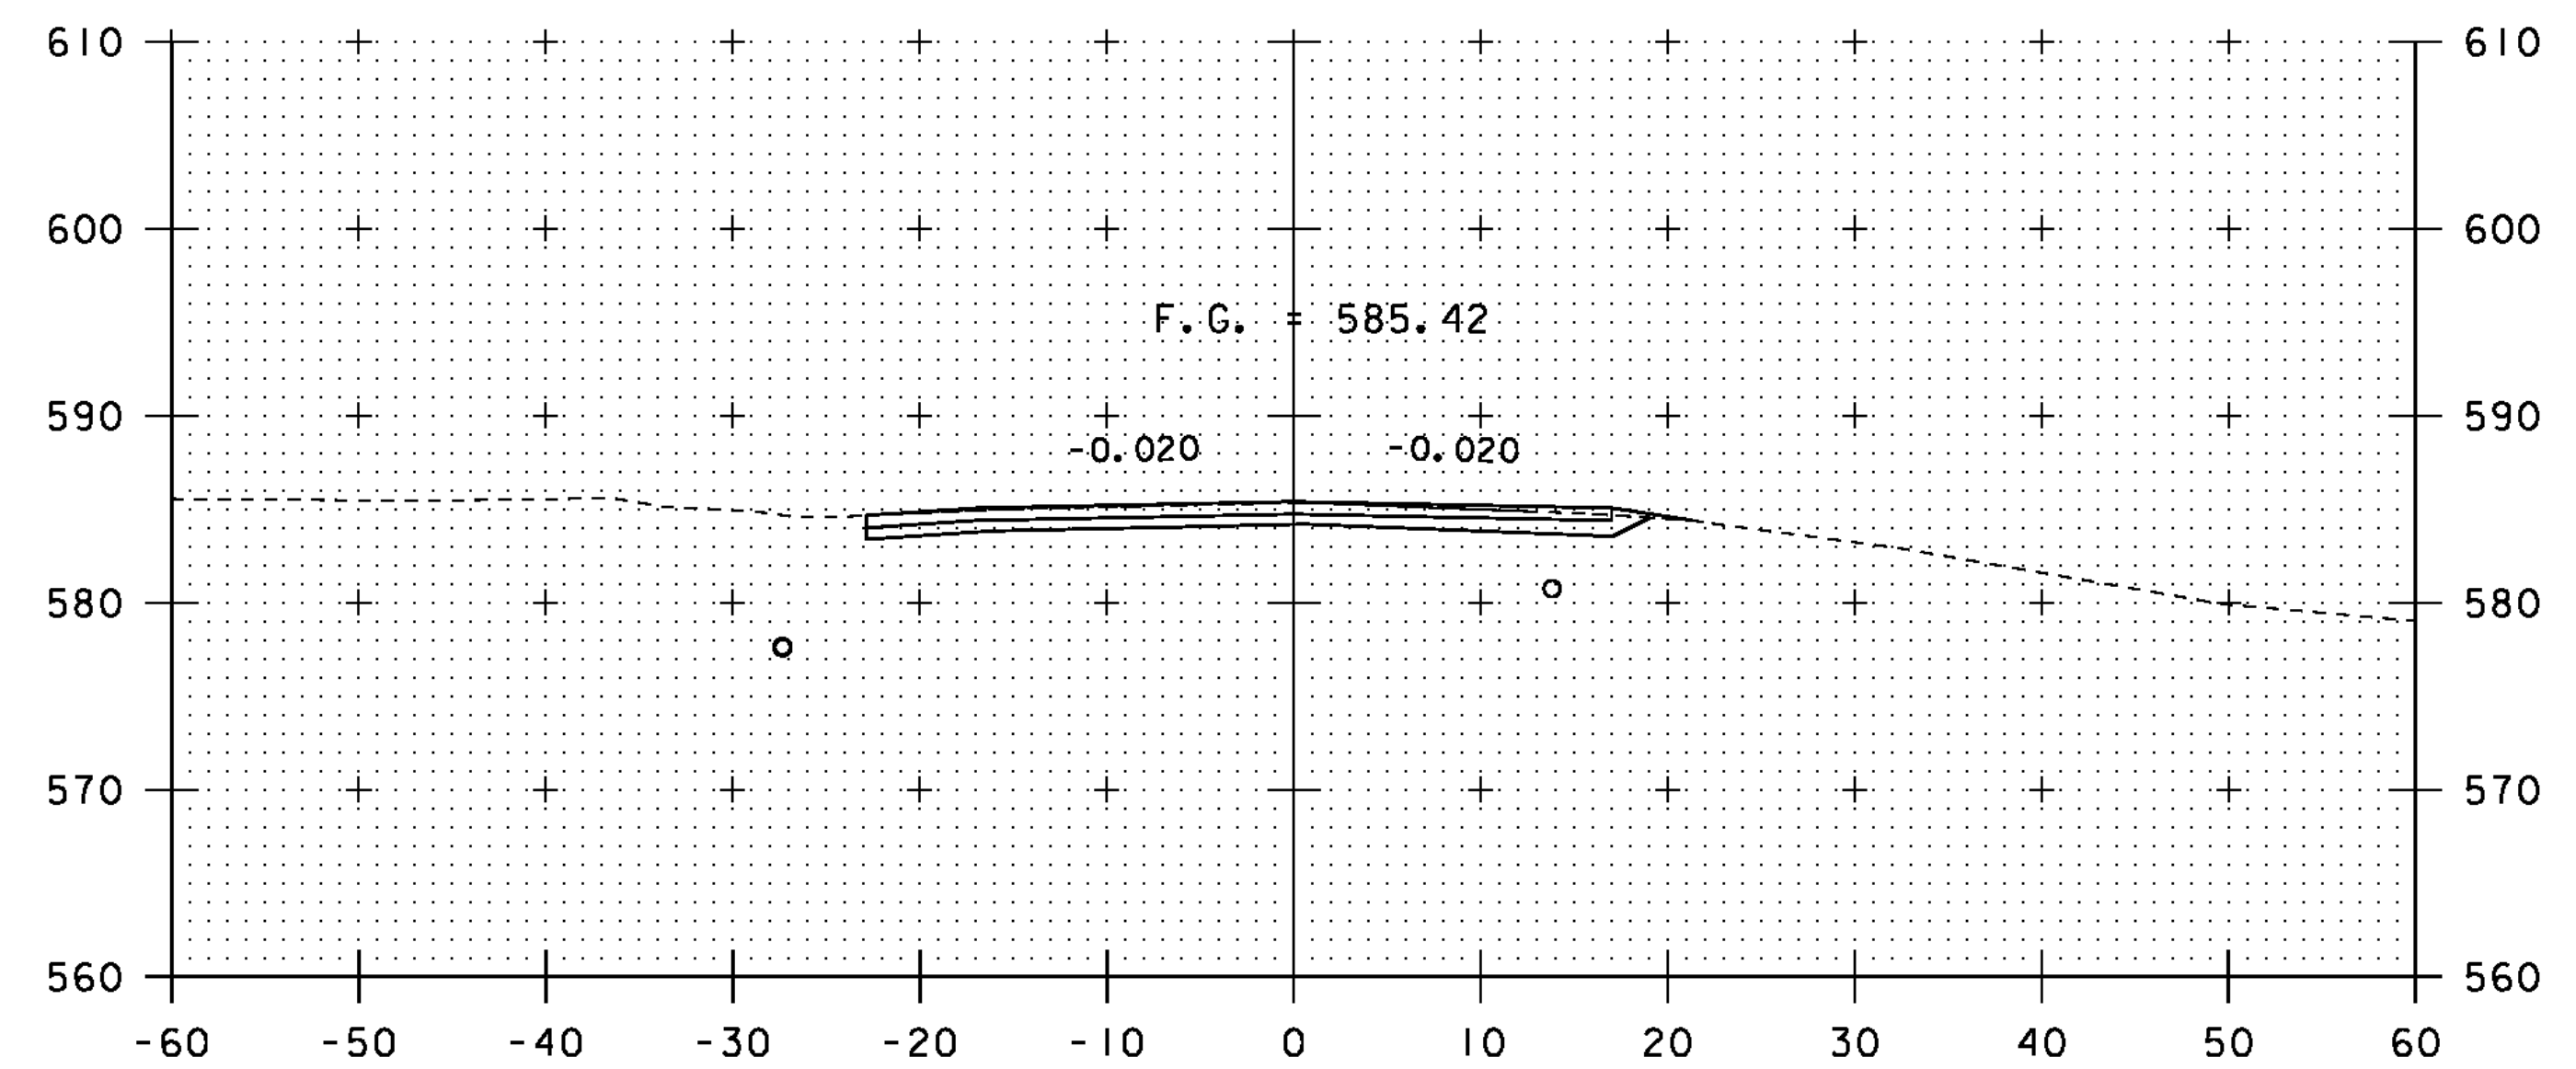

11+50



STA. 10+50 TO STA. 12+00

PROJECT NAME: CHESTER

PROJECT NUMBER: BRF 025-1(37) SC

FILE NAME: s95b168xsl.dgn

PROJECT LEADER: C.P.WILLIAMS

DESIGNED BY: R.S.YOUNG

BRIDGE 9 MAINLINE CROSS SECTIONS

PLOT DATE: 20-SEP-2010

DRAWN BY: D.D.BEARD

CHECKED BY: R.S.YOUNG

SHEET 115 OF 124