




52+50

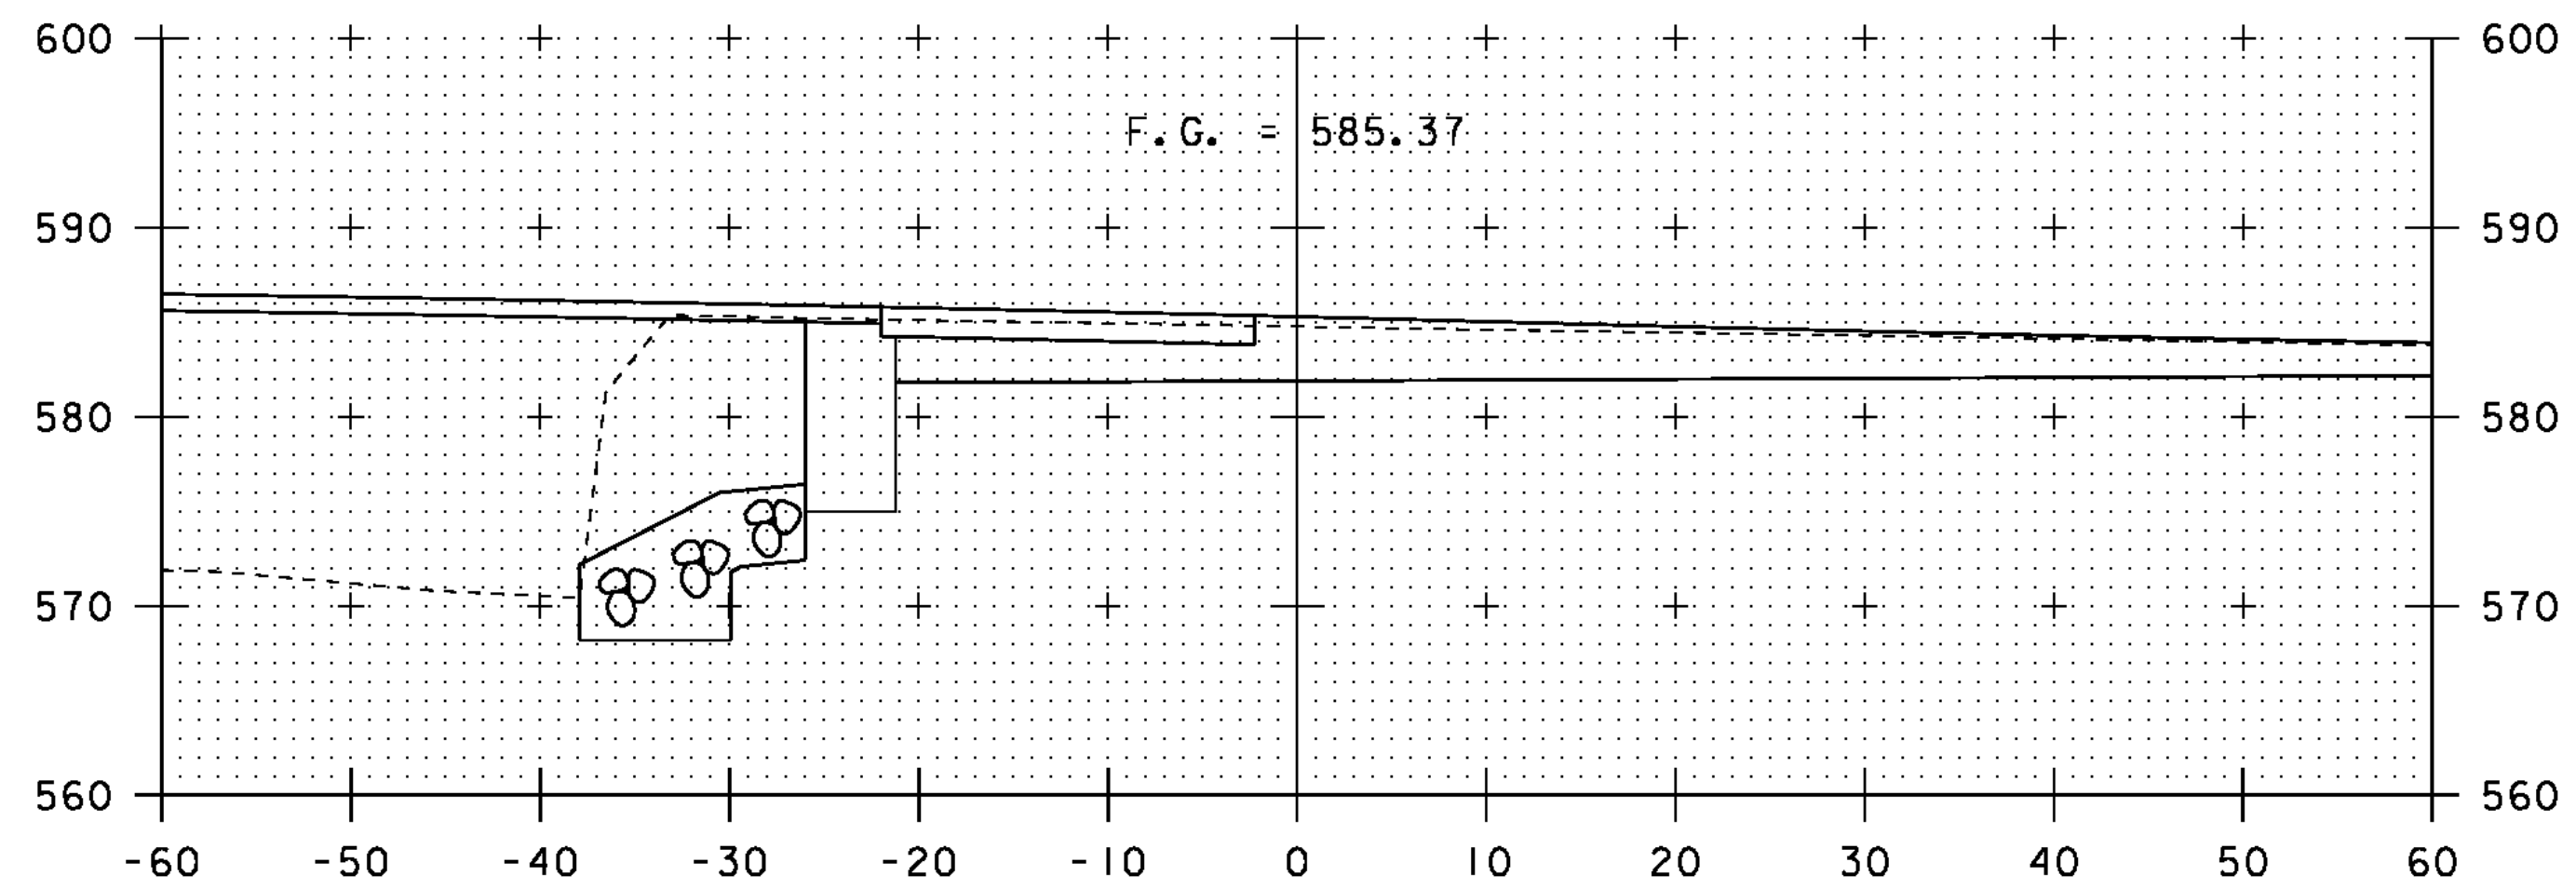


53+23
=STA 14+13.29 CL VT 103

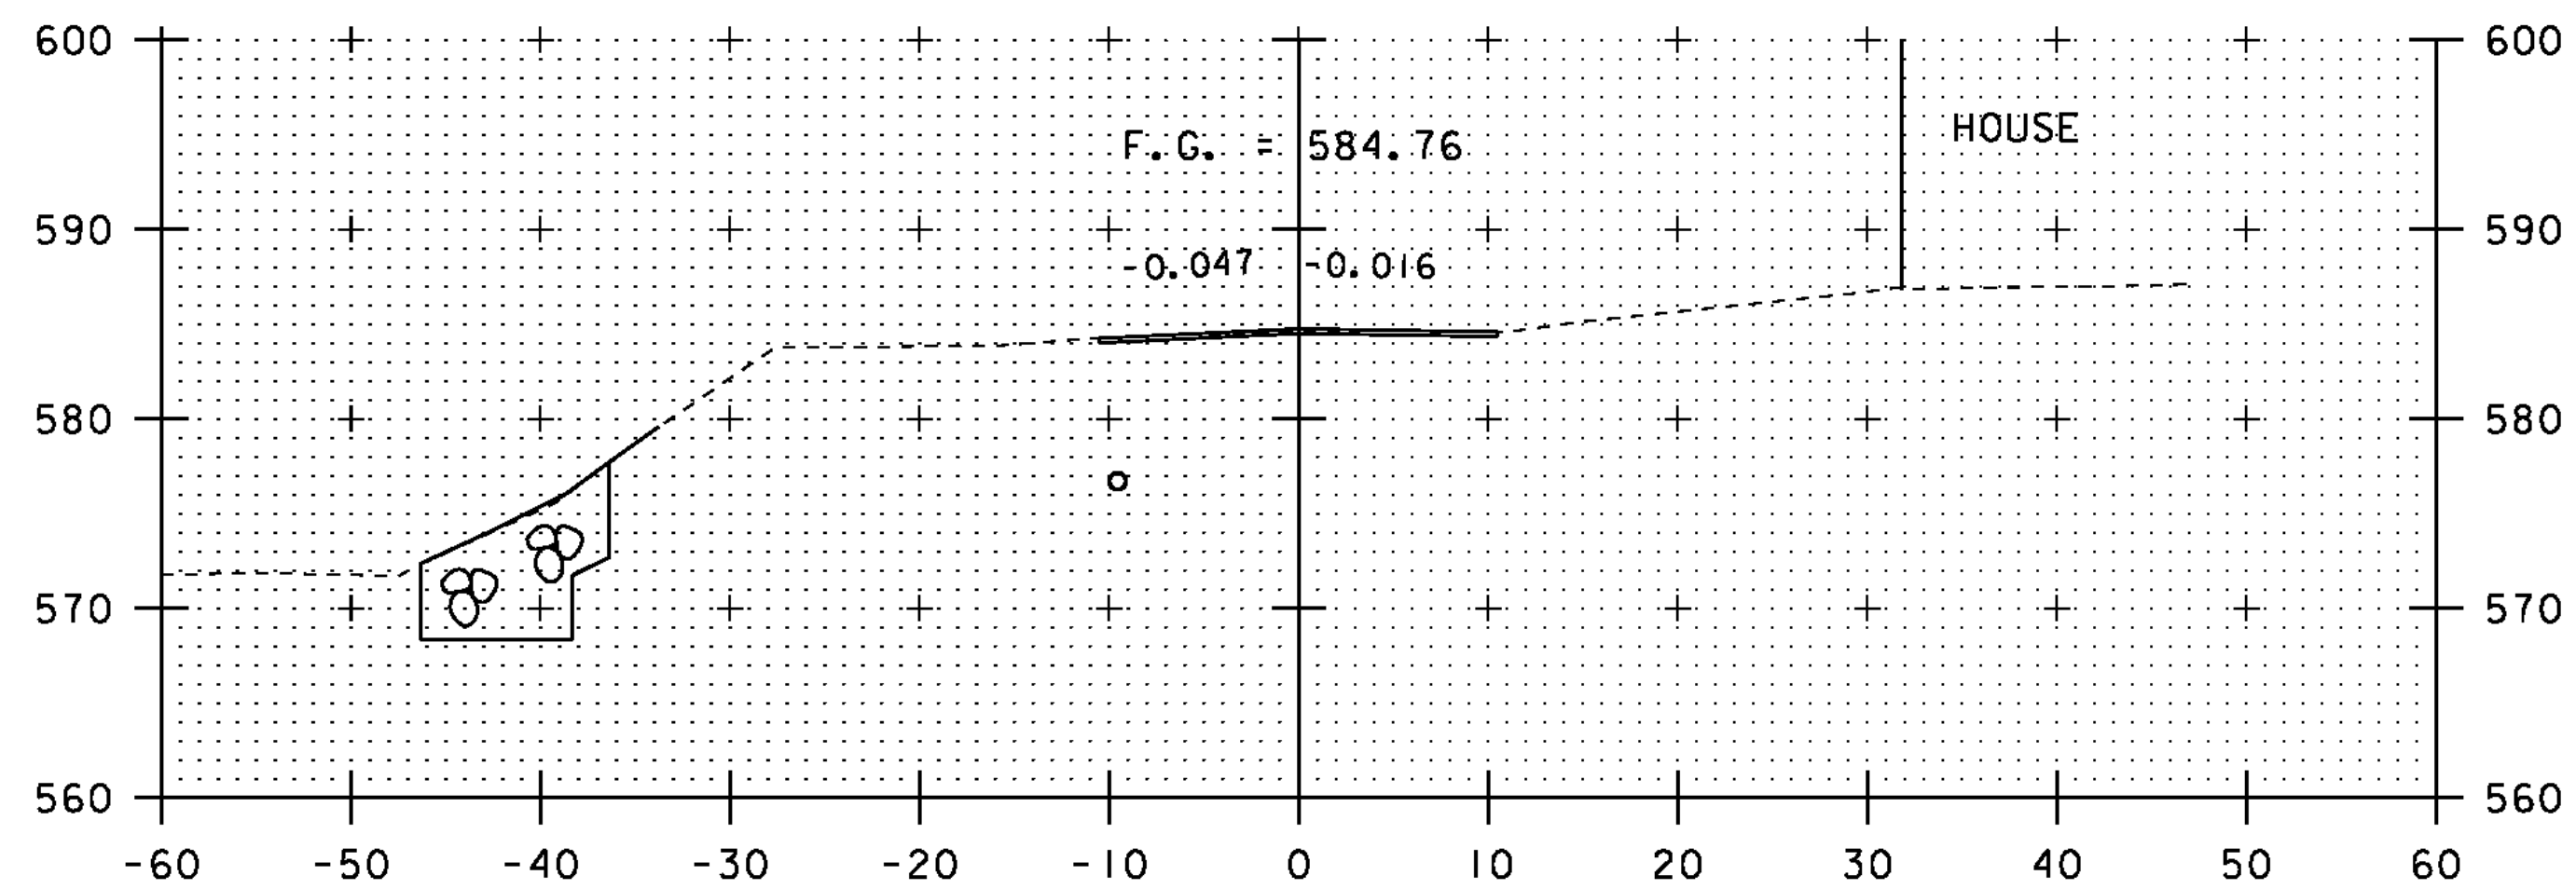


52+25

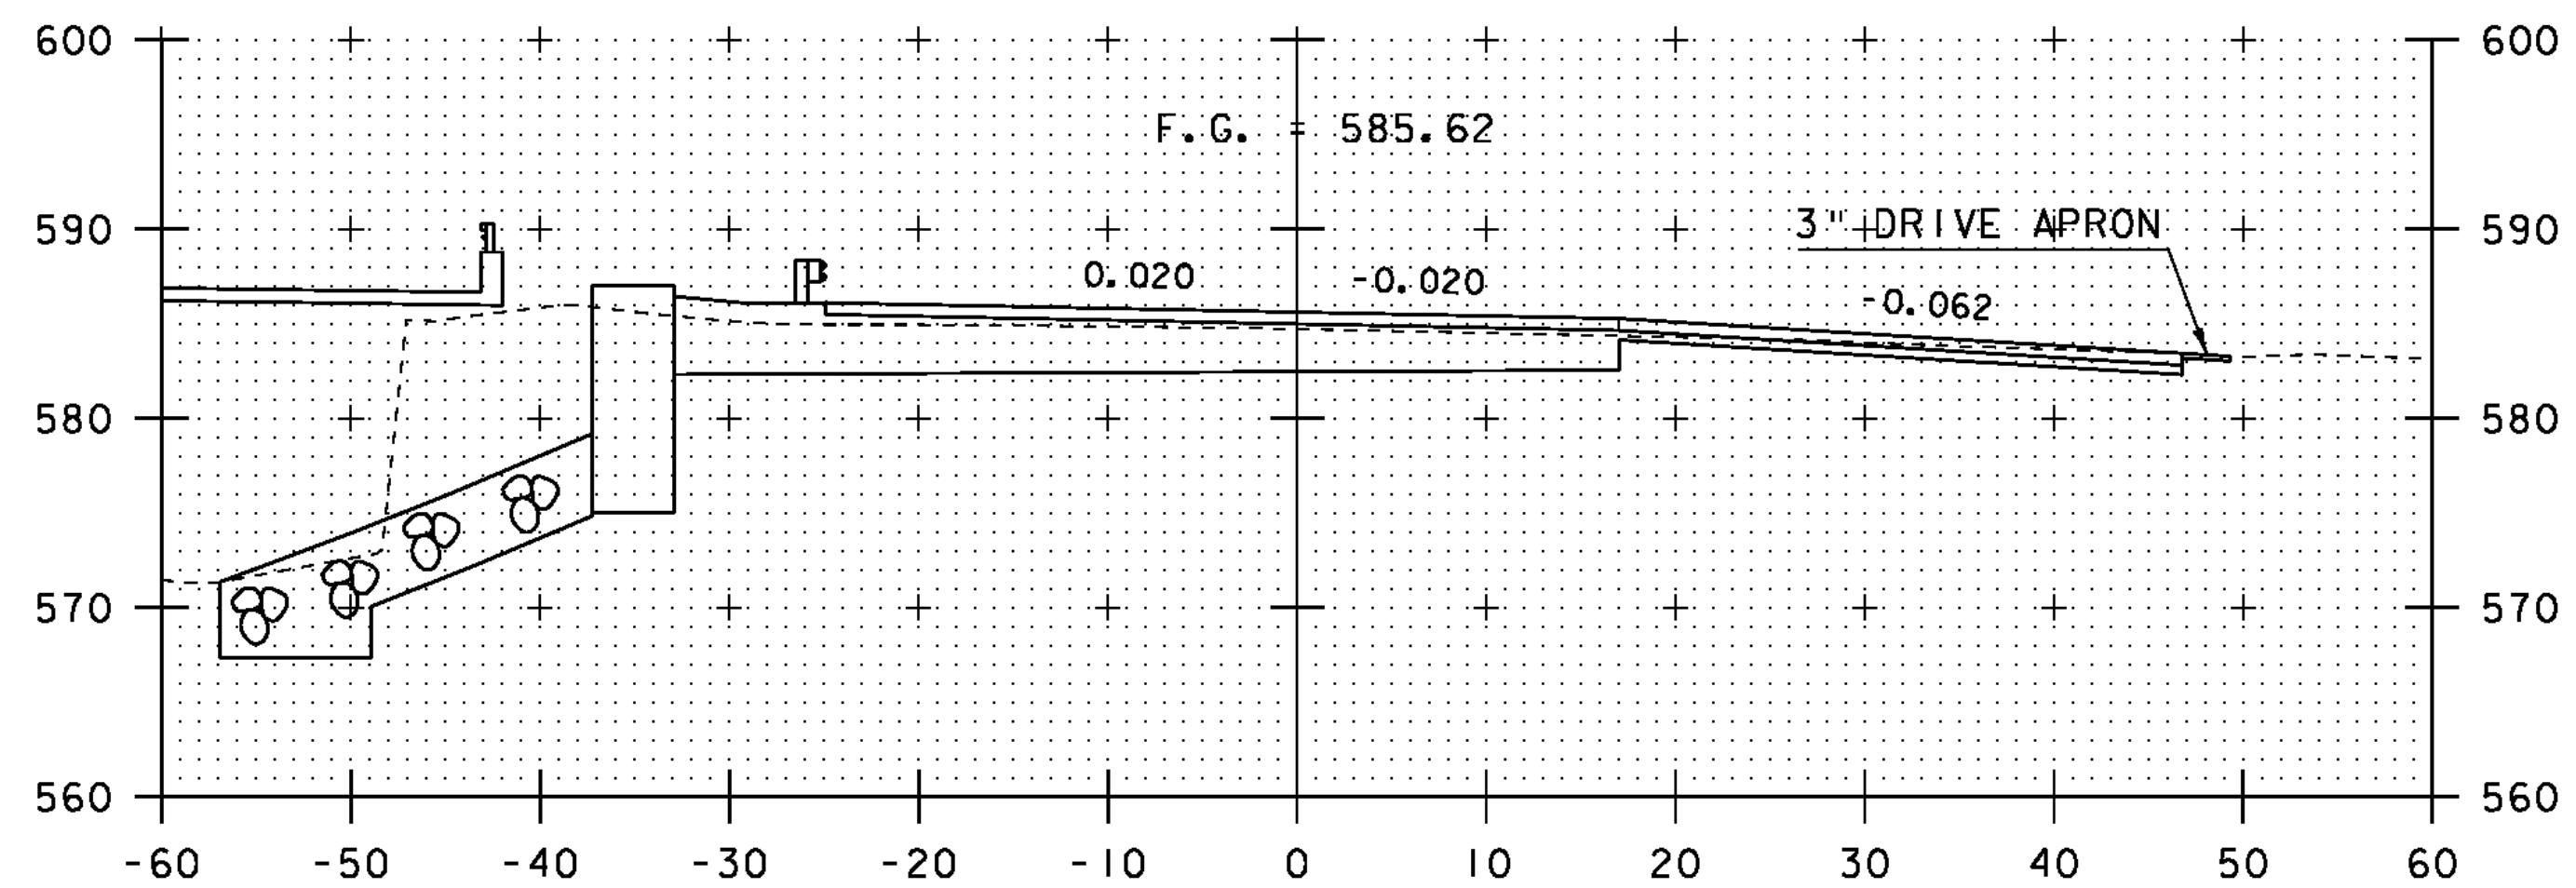

53+00

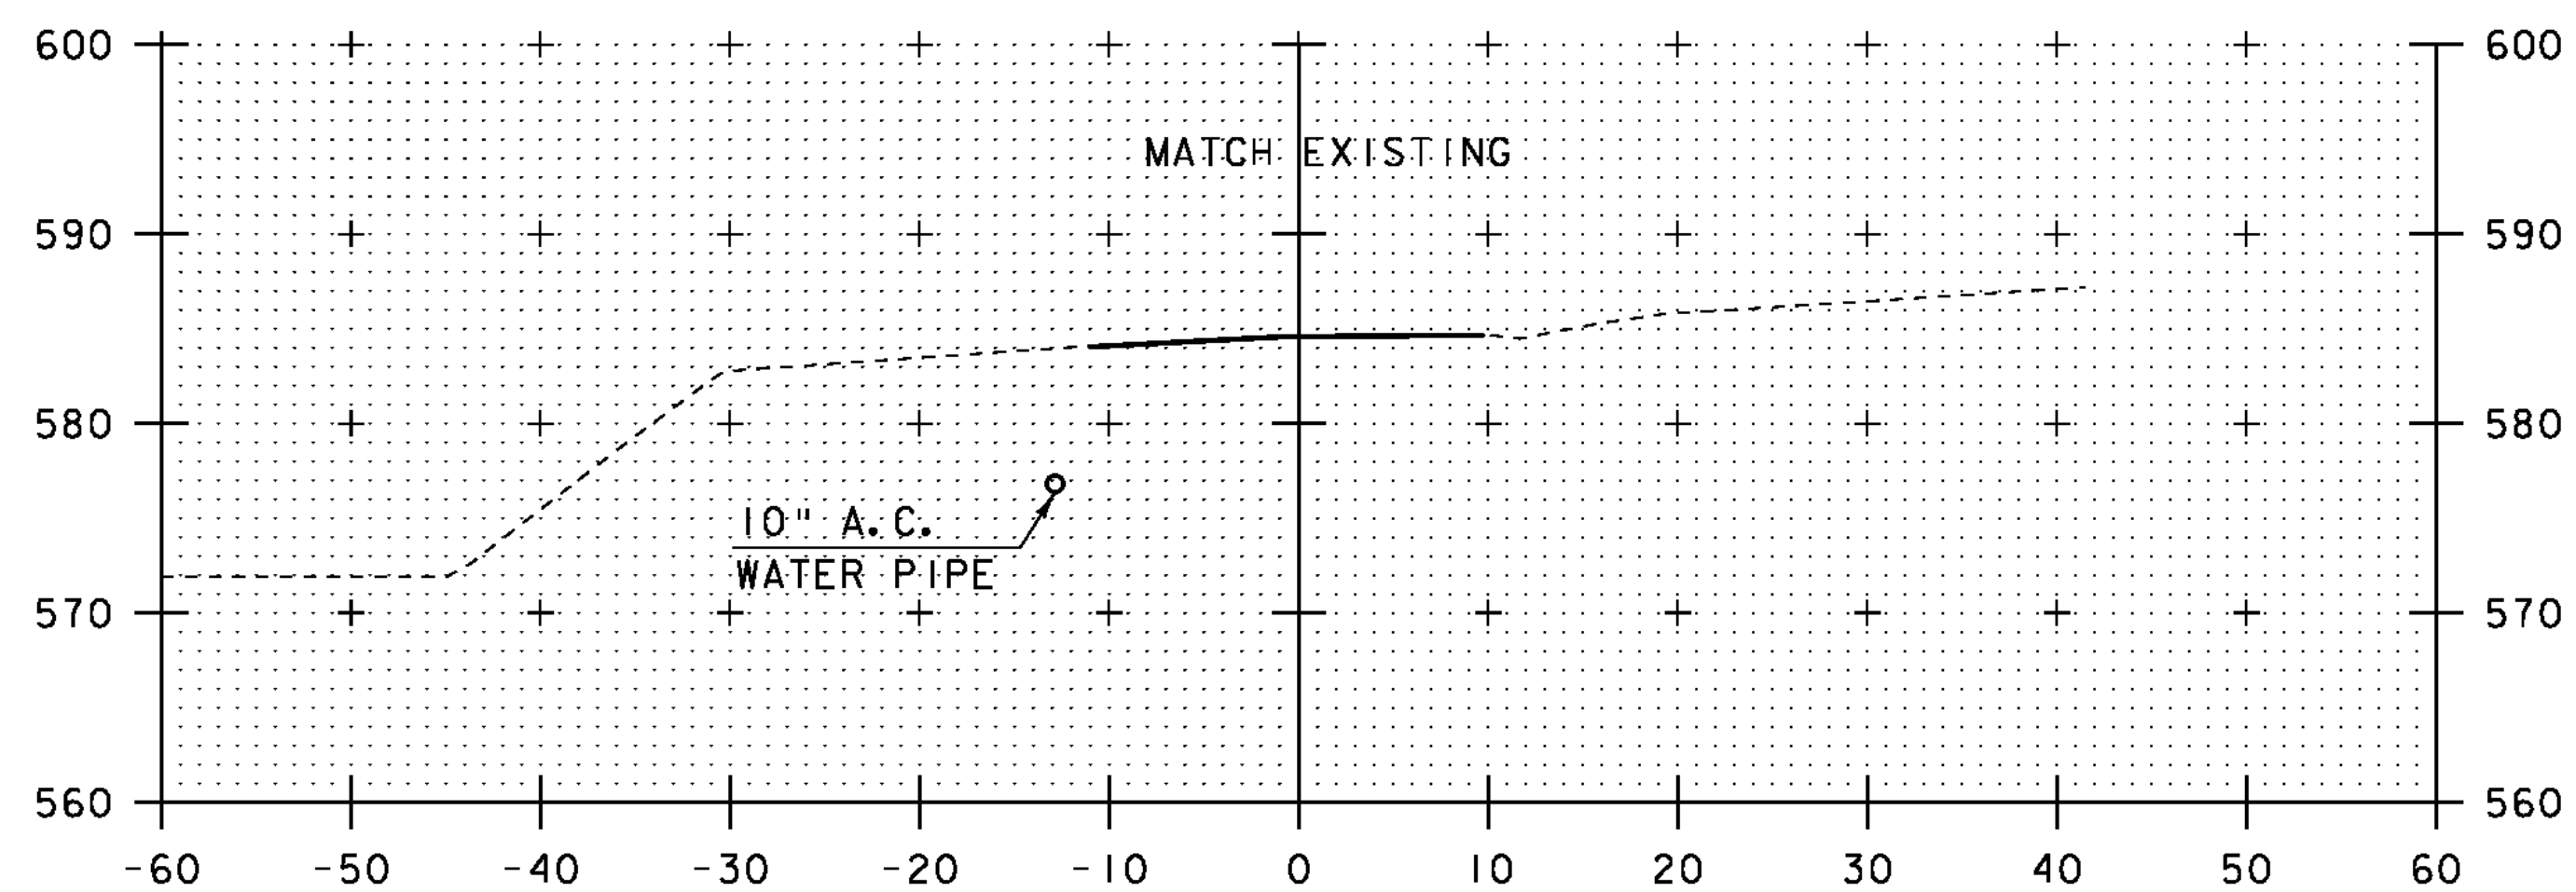

52+00

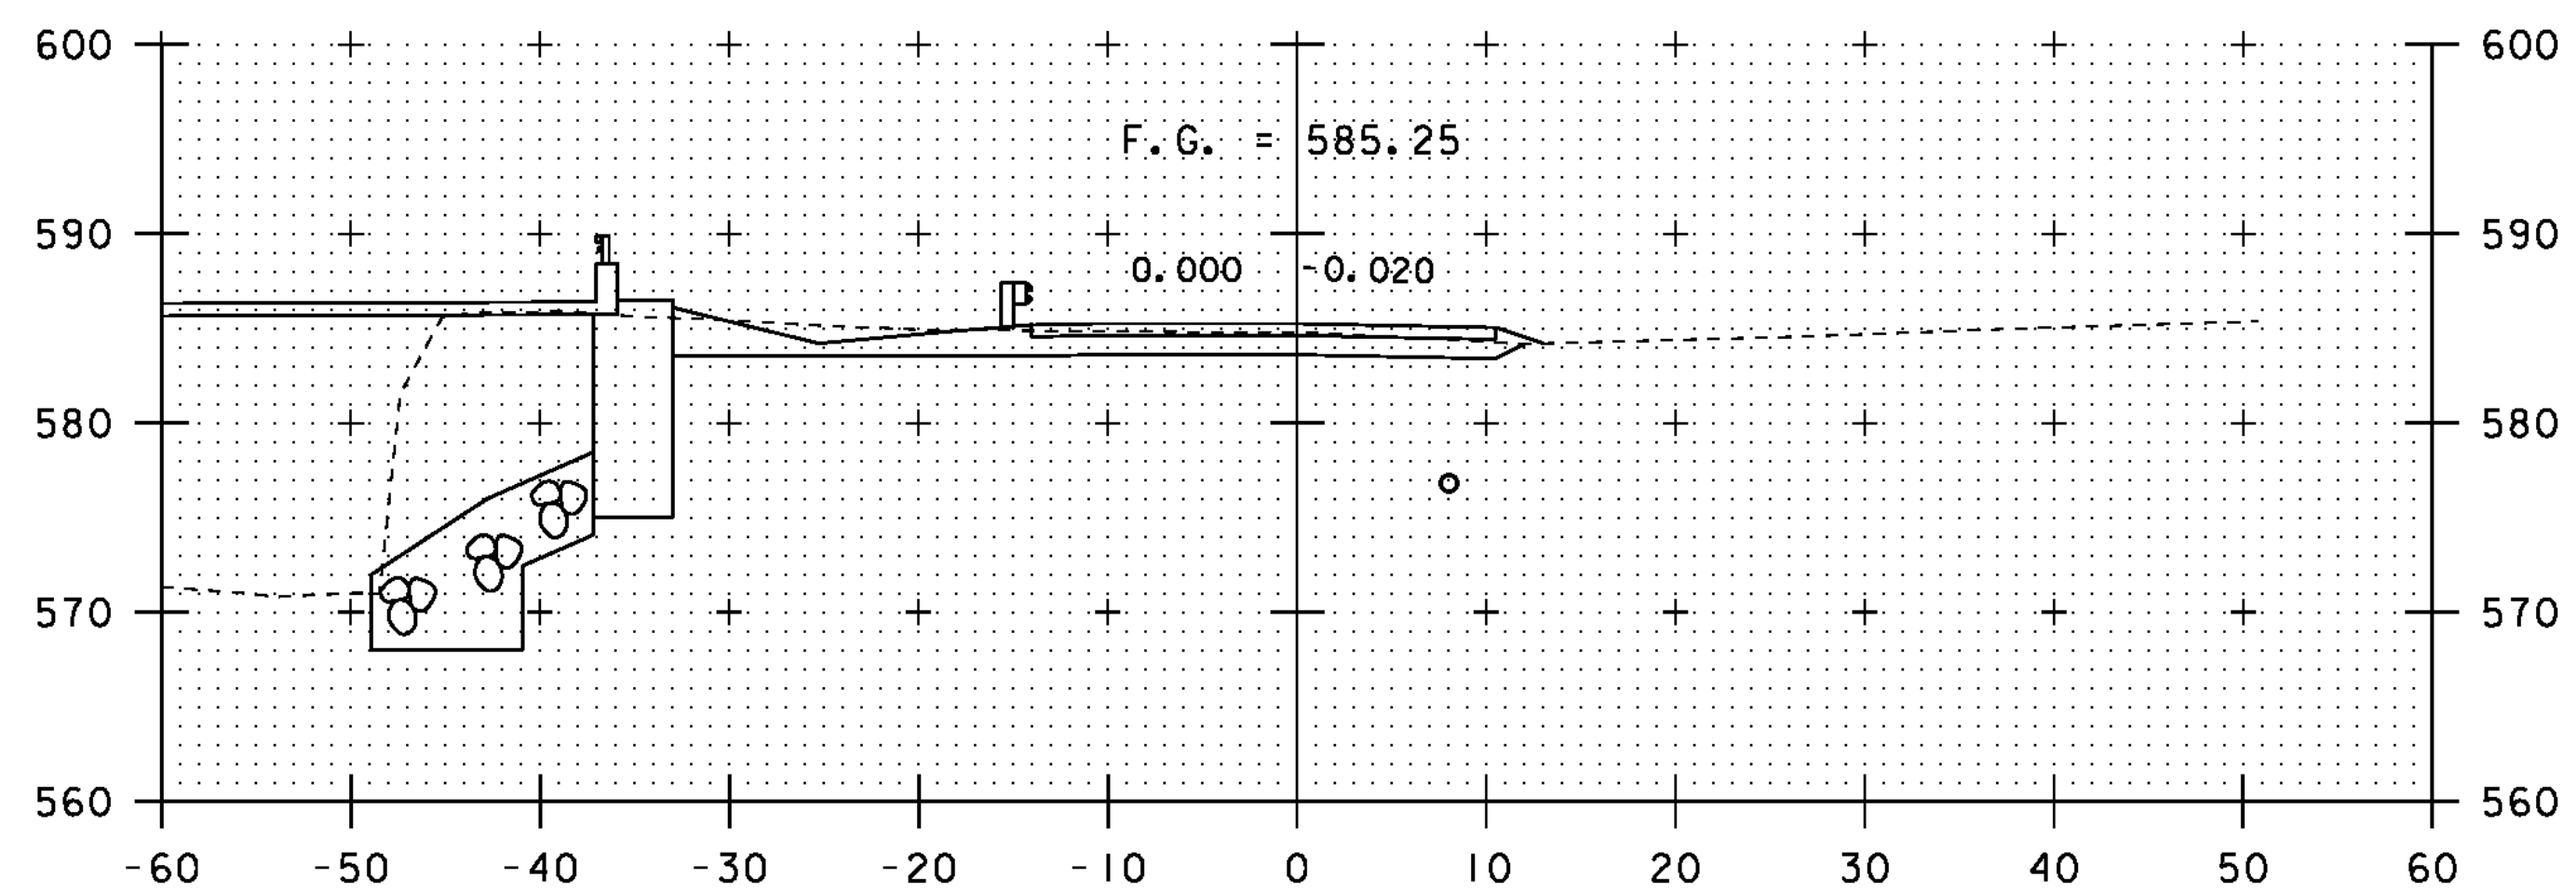

52+75



STA. 52+00 TO STA. 53+23

PROJECT NAME: CHESTER
 PROJECT NUMBER: BRF 025-1(37) SC
 FILE NAME:
 PROJECT LEADER: C.P.WILLIAMS
 DESIGNED BY: R.S.YOUNG
 BRIDGE 9 TH 72 CROSS SECTIONS

PLOT DATE: 20-SEP-2010
 DRAWN BY: D.D.BEARD
 CHECKED BY: R.S.YOUNG
 SHEET 119 OF 124