


61+25



61+00

STA: 61+06.80 LT
 BEGIN UNCLASSIFIED CHANNEL EXCAVATION
 BEGIN GEOTEXTILE UNDER STONE FILL
 BEGIN STONE FILL TYPE IV
 BEGIN GRUBBING MATERIAL

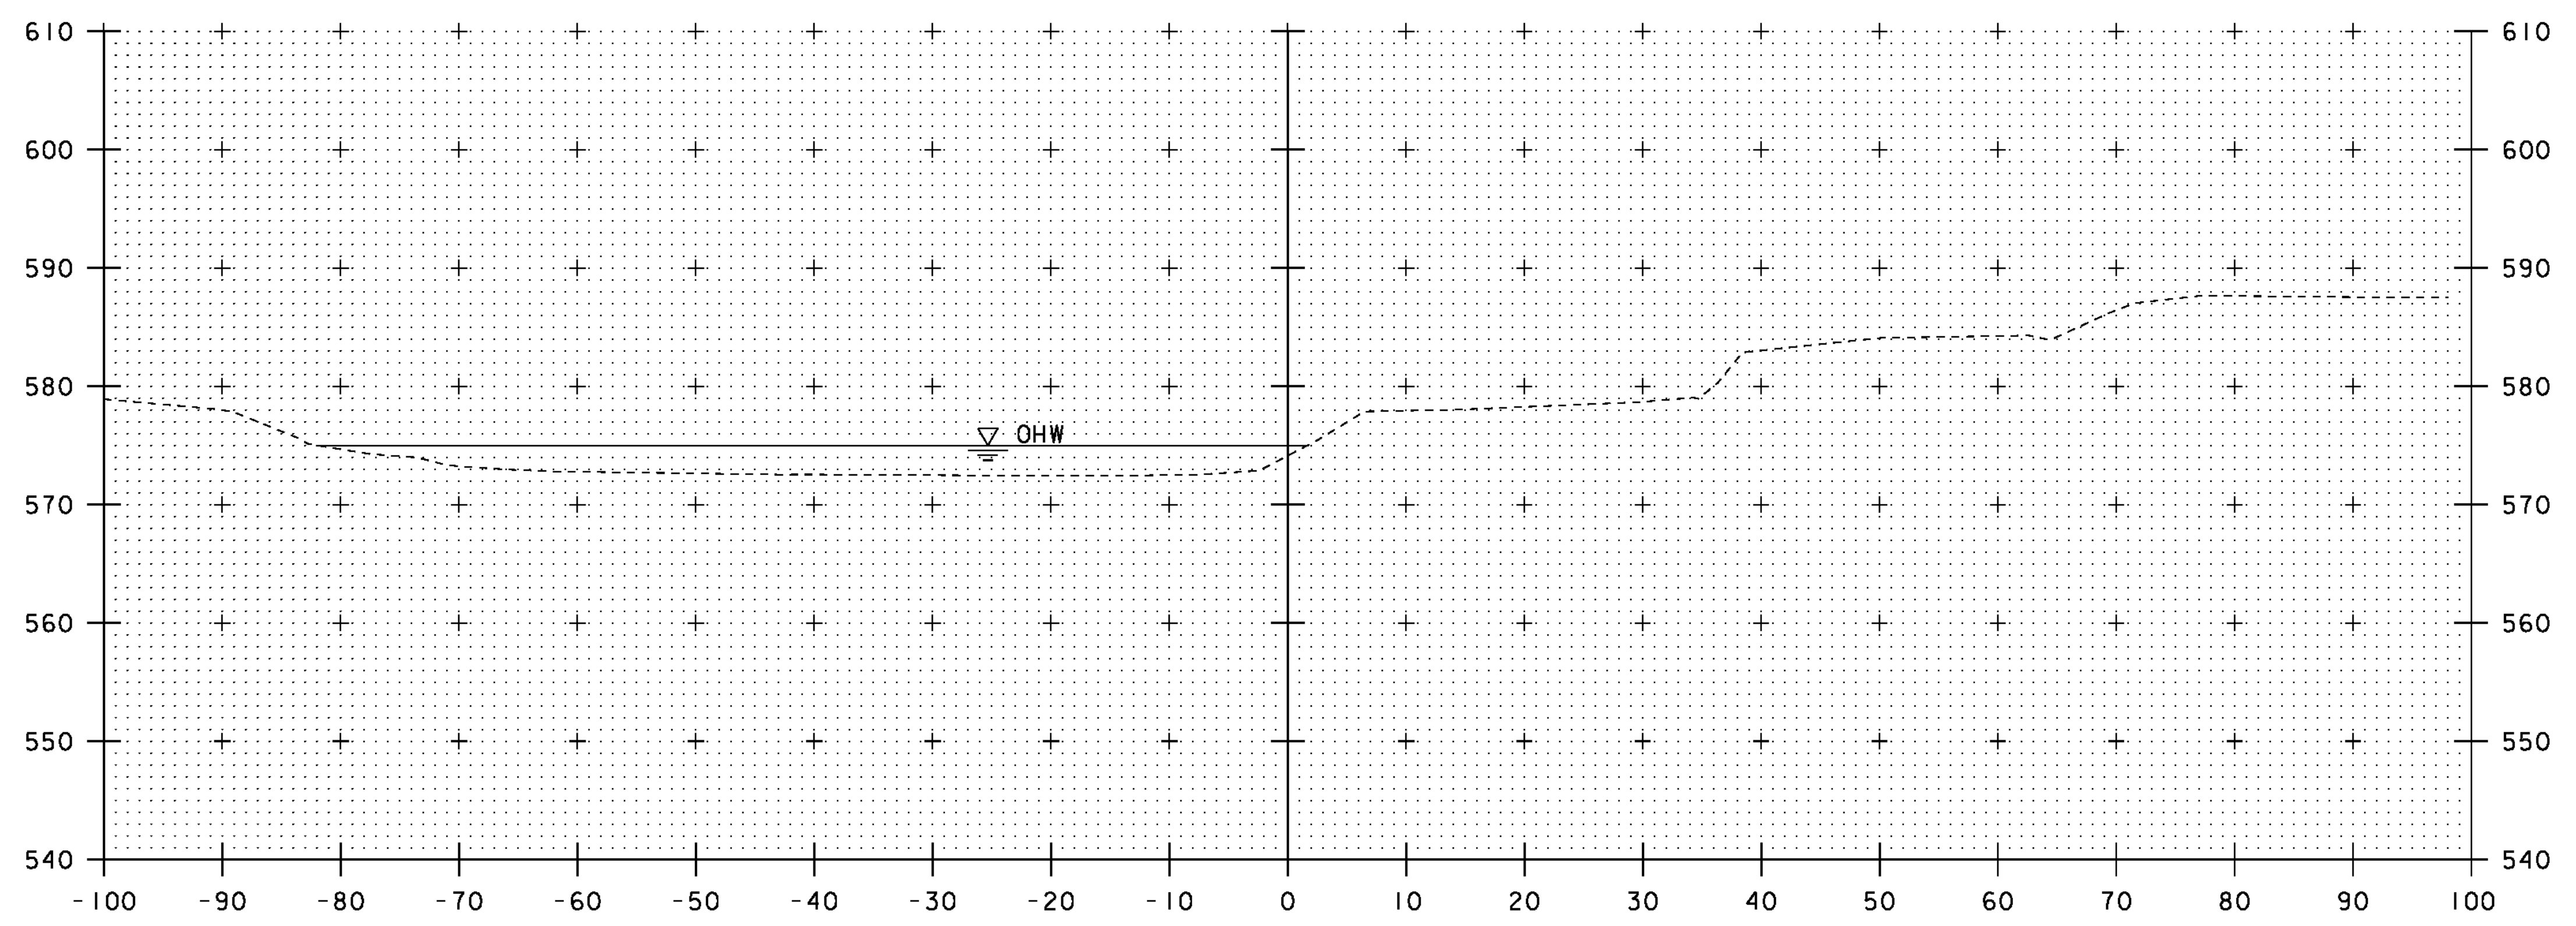

STA. 61+00 TO STA. 61+25

PROJECT NAME: CHESTER	
PROJECT NUMBER: BRF 025-I(37) SC	
FILE NAME: s95b168xs1.dgn	PLOT DATE: 20-SEP-2010
PROJECT LEADER: C.P.WILLIAMS	DRAWN BY: D.D.BEARD
DESIGNED BY: R.S.YOUNG	CHECKED BY: R.S.YOUNG
BRIDGE 9 CHANNEL CROSS SECTIONS	SHEET 120 OF 124