




12+50

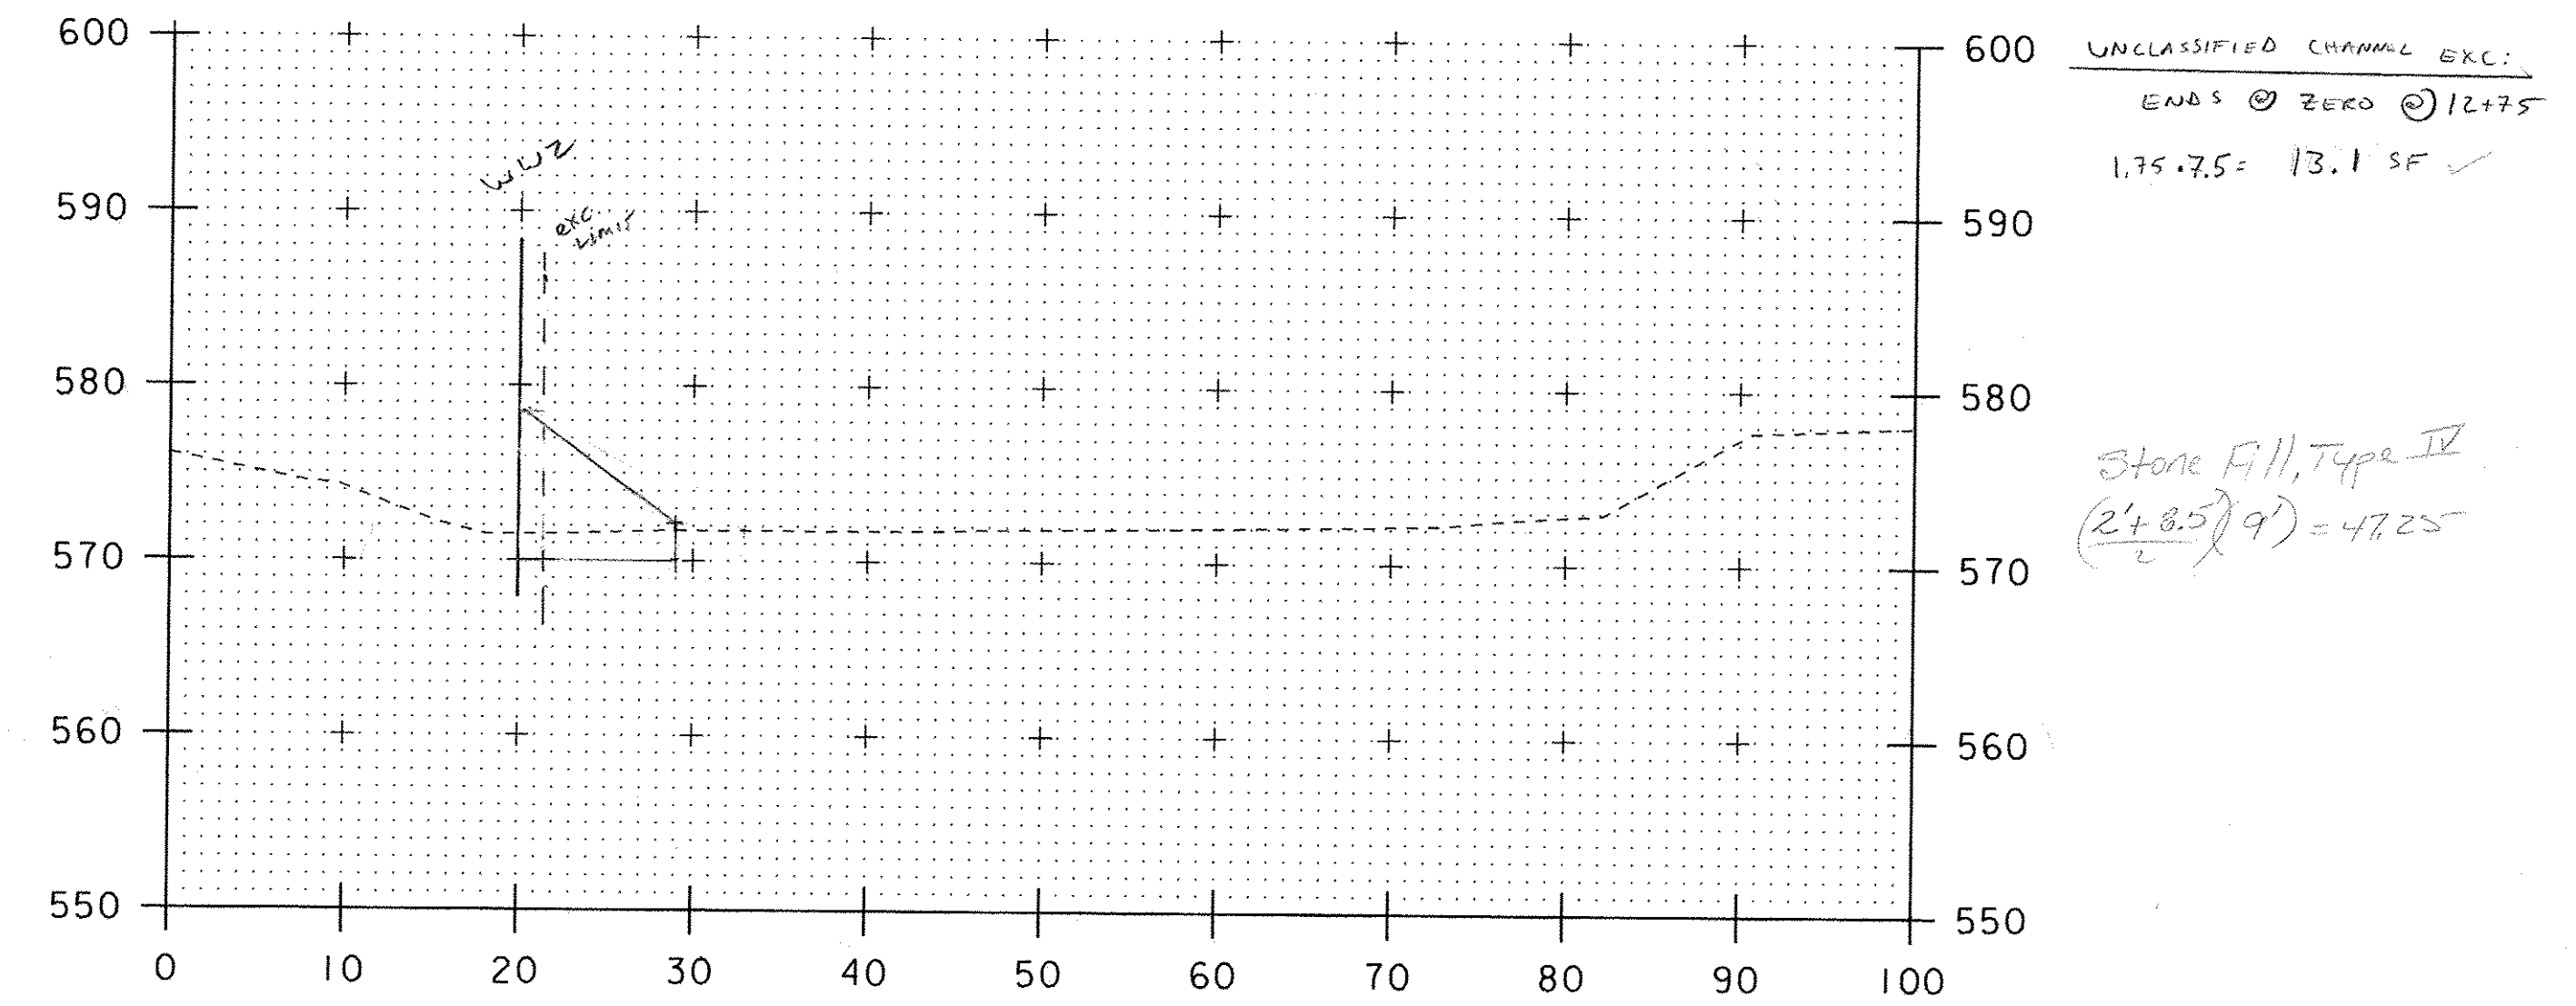


12+70 use for 12+65
corner of A-1/W.W.2

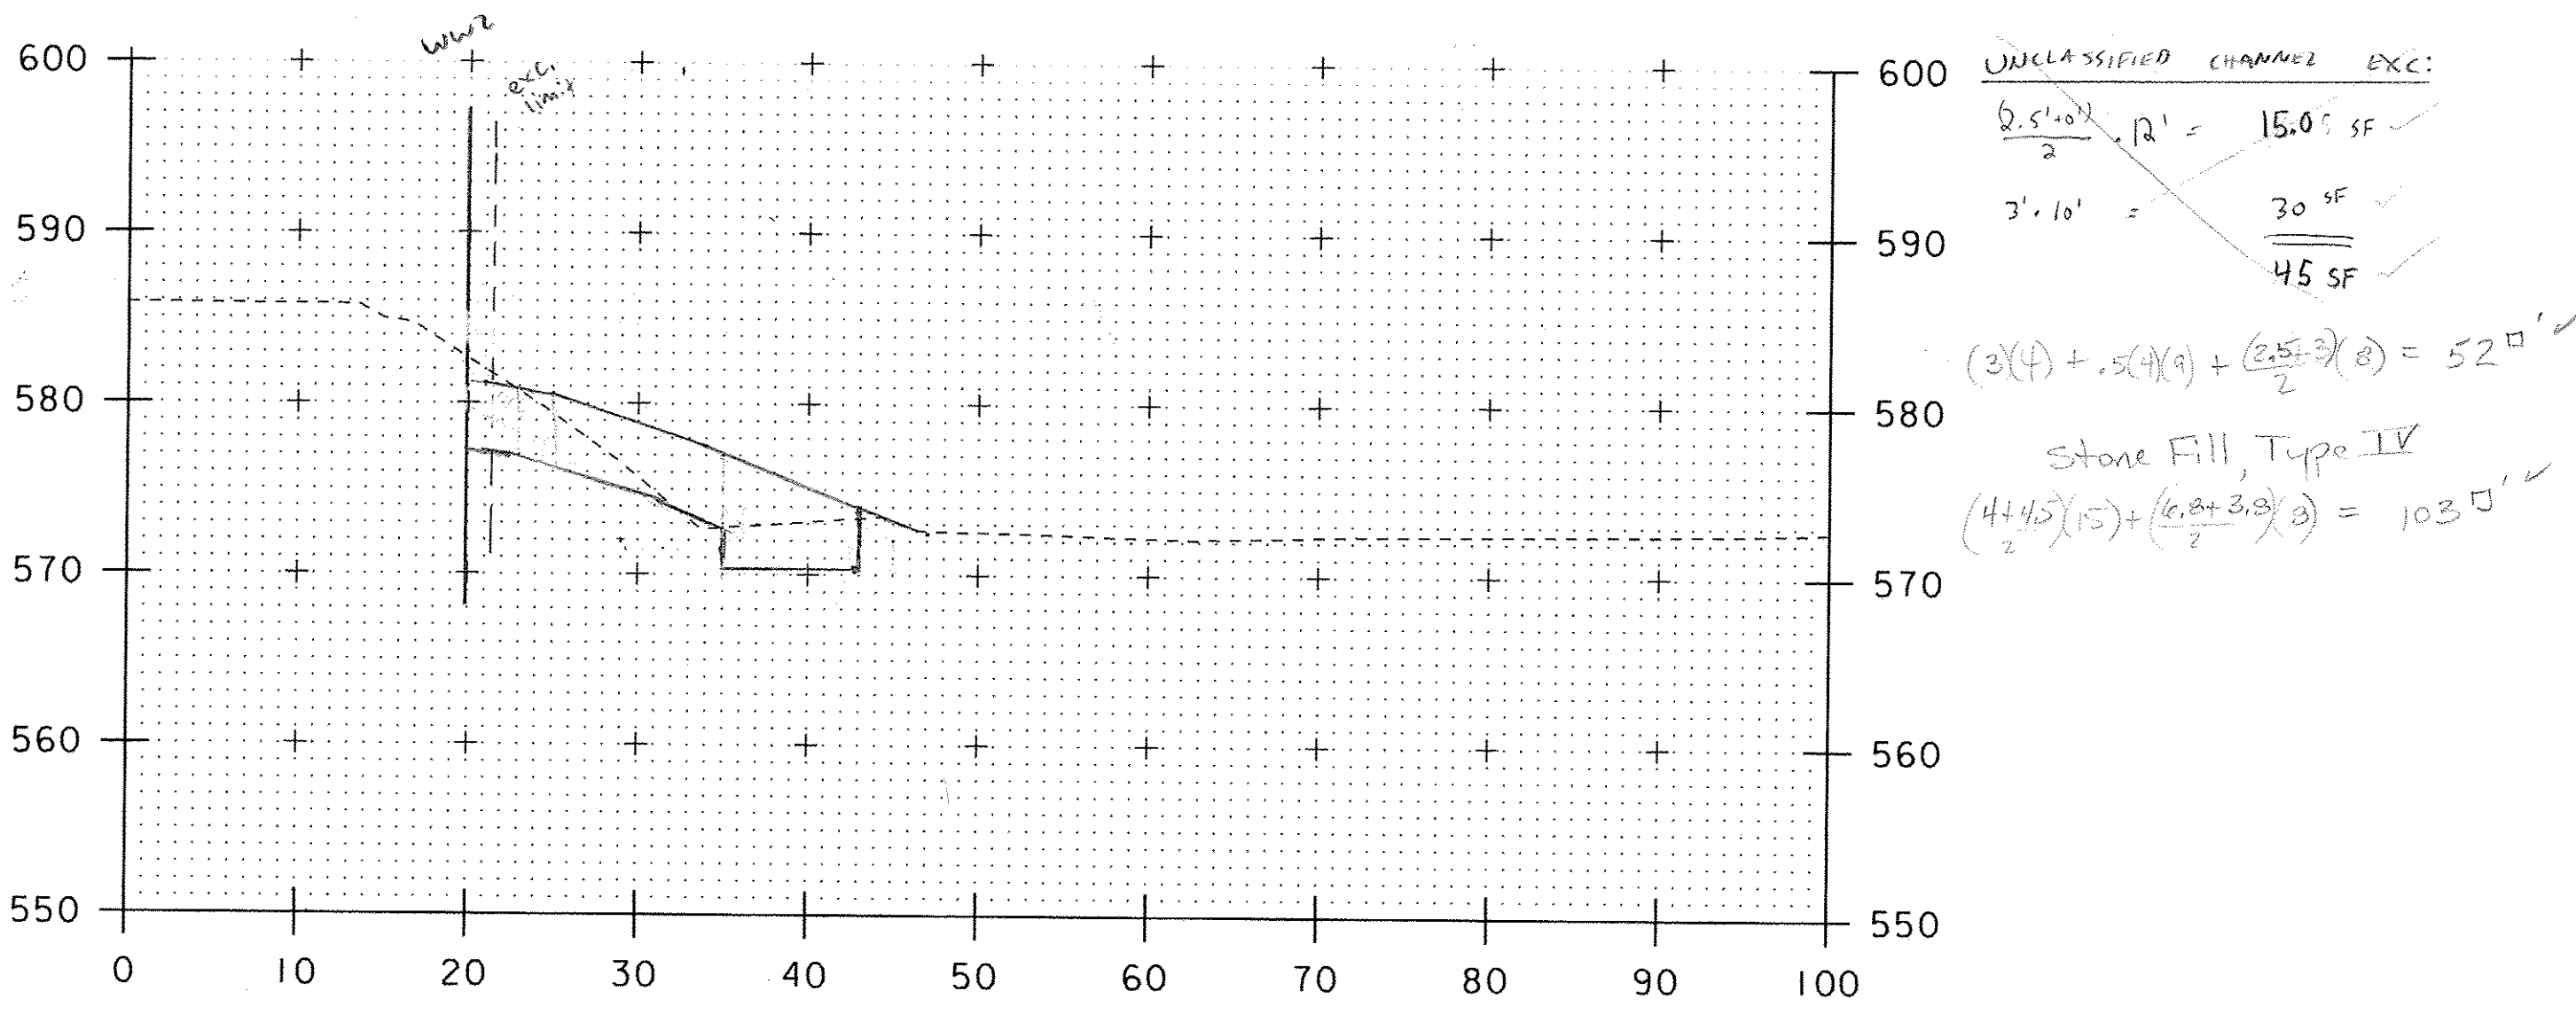

12+40

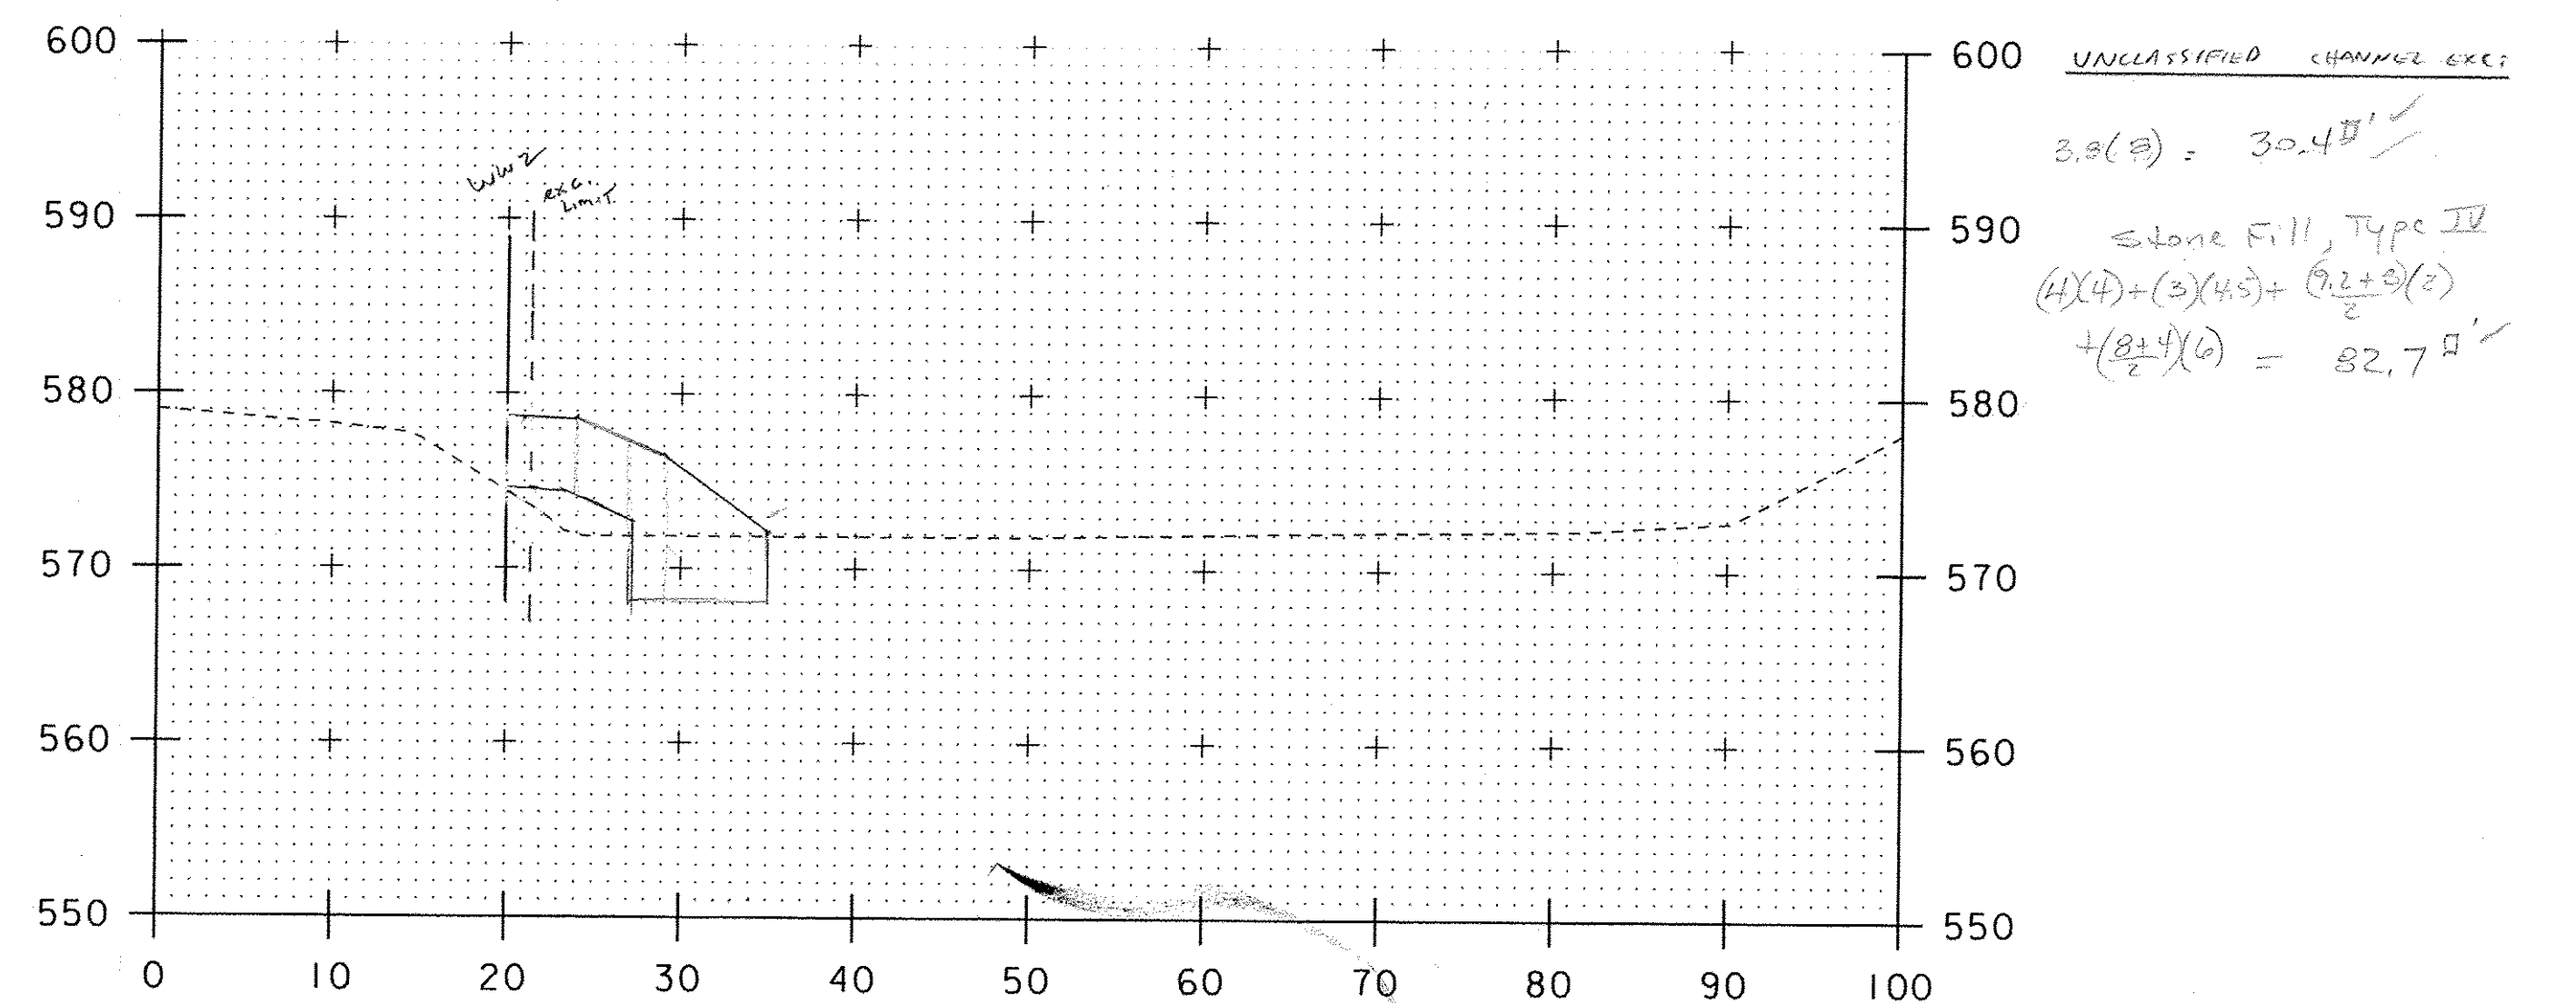

12+60

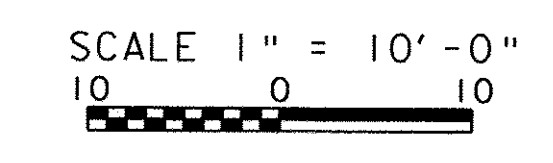

STA. 12+40 TO STA. 12+70

PROJECT NAME: CHESTER	PLOT DATE: 19-MAY-2011
PROJECT NUMBER: BRF 025-1(37)	DRAWN BY: D.D.BEARD
FILE NAME: s95bl68xsl.dgn	CHECKED BY: -----
PROJECT LEADER: C.P.WILLIAMS	SHEET 1 OF 1
DESIGNED BY: R.S.YOUNG	
CONSTRUCTION CROSS SECTIONS	