




14+10

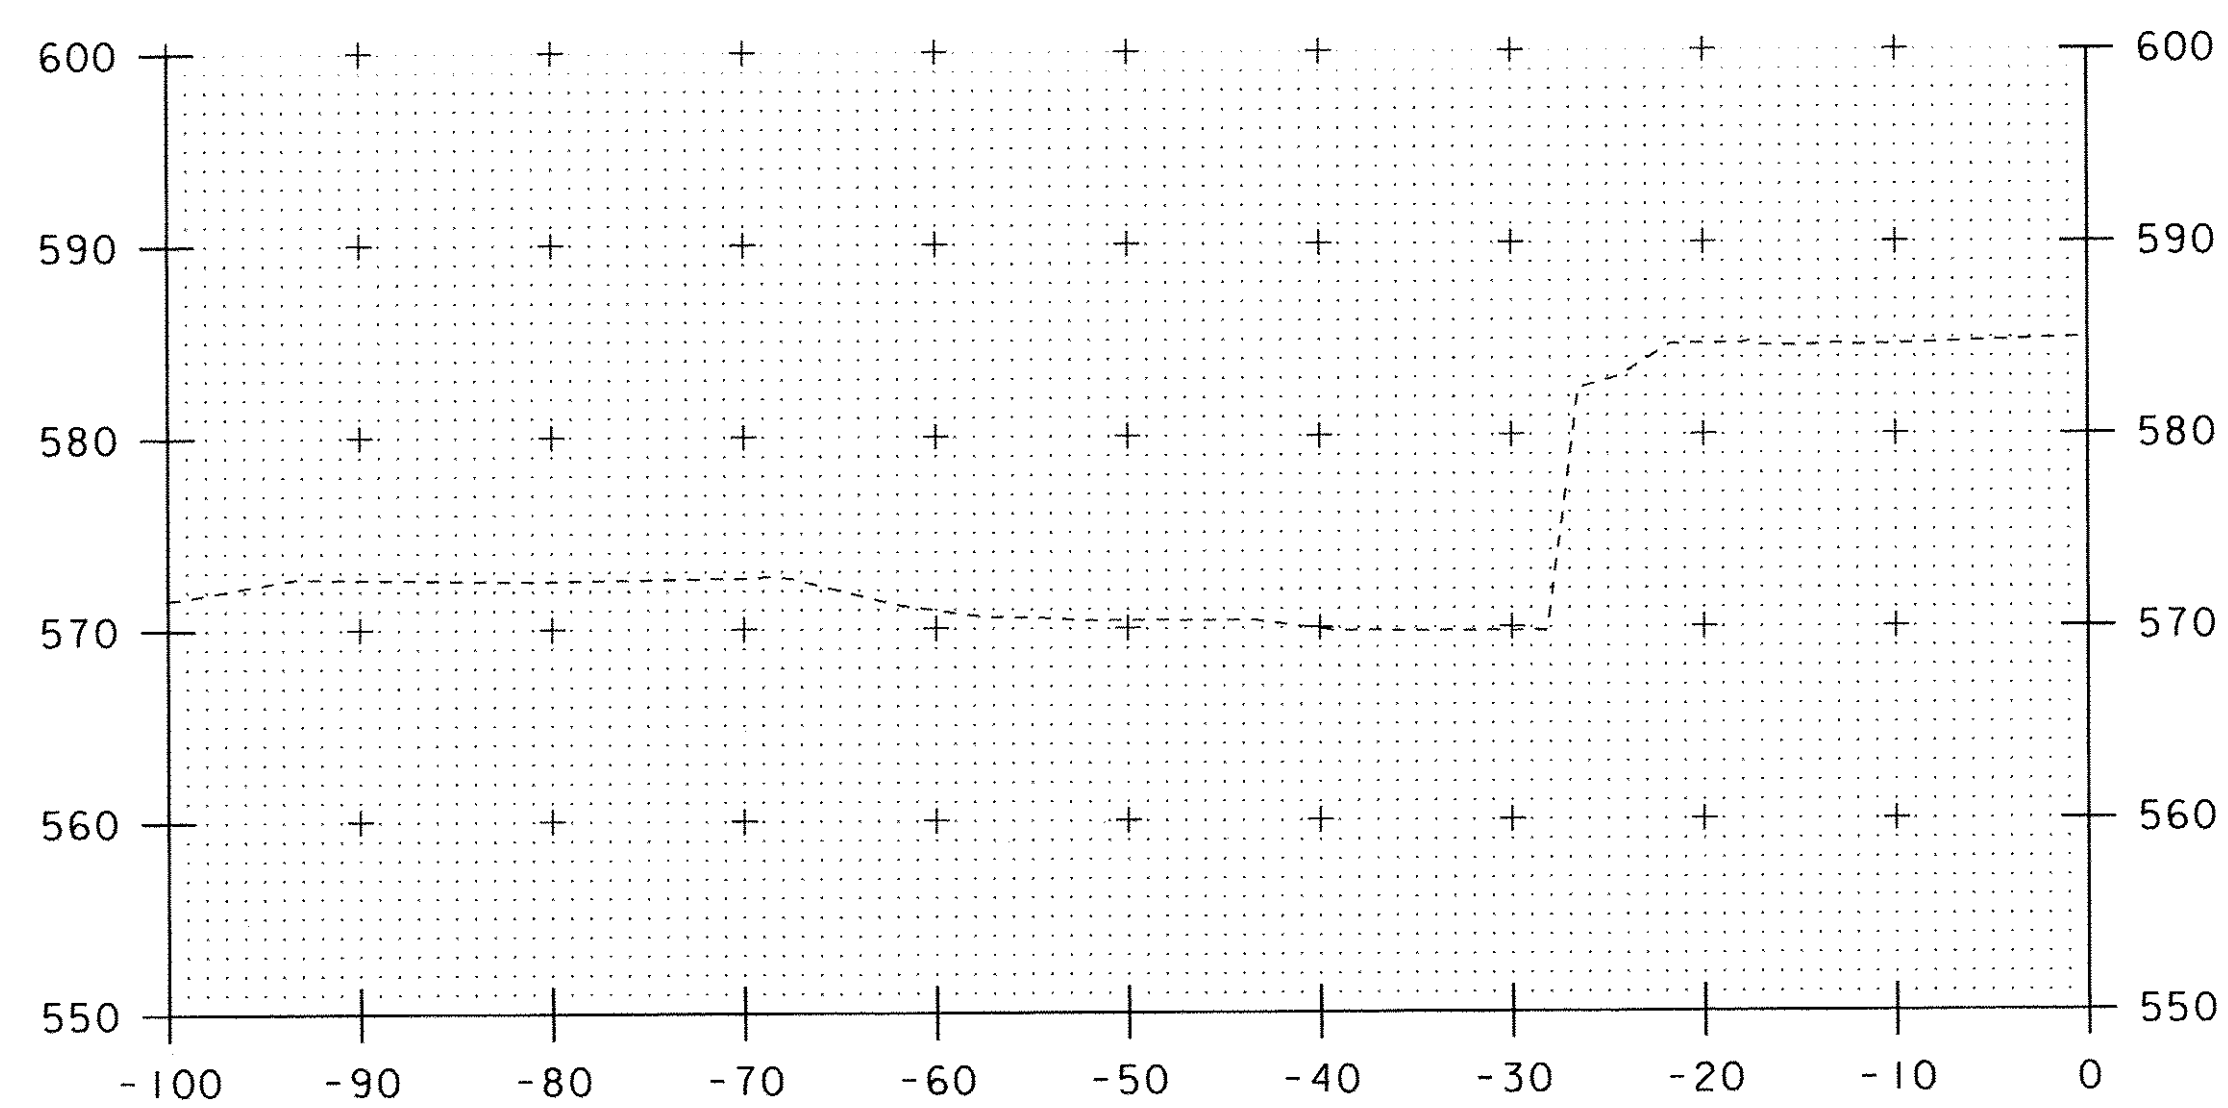

14+00

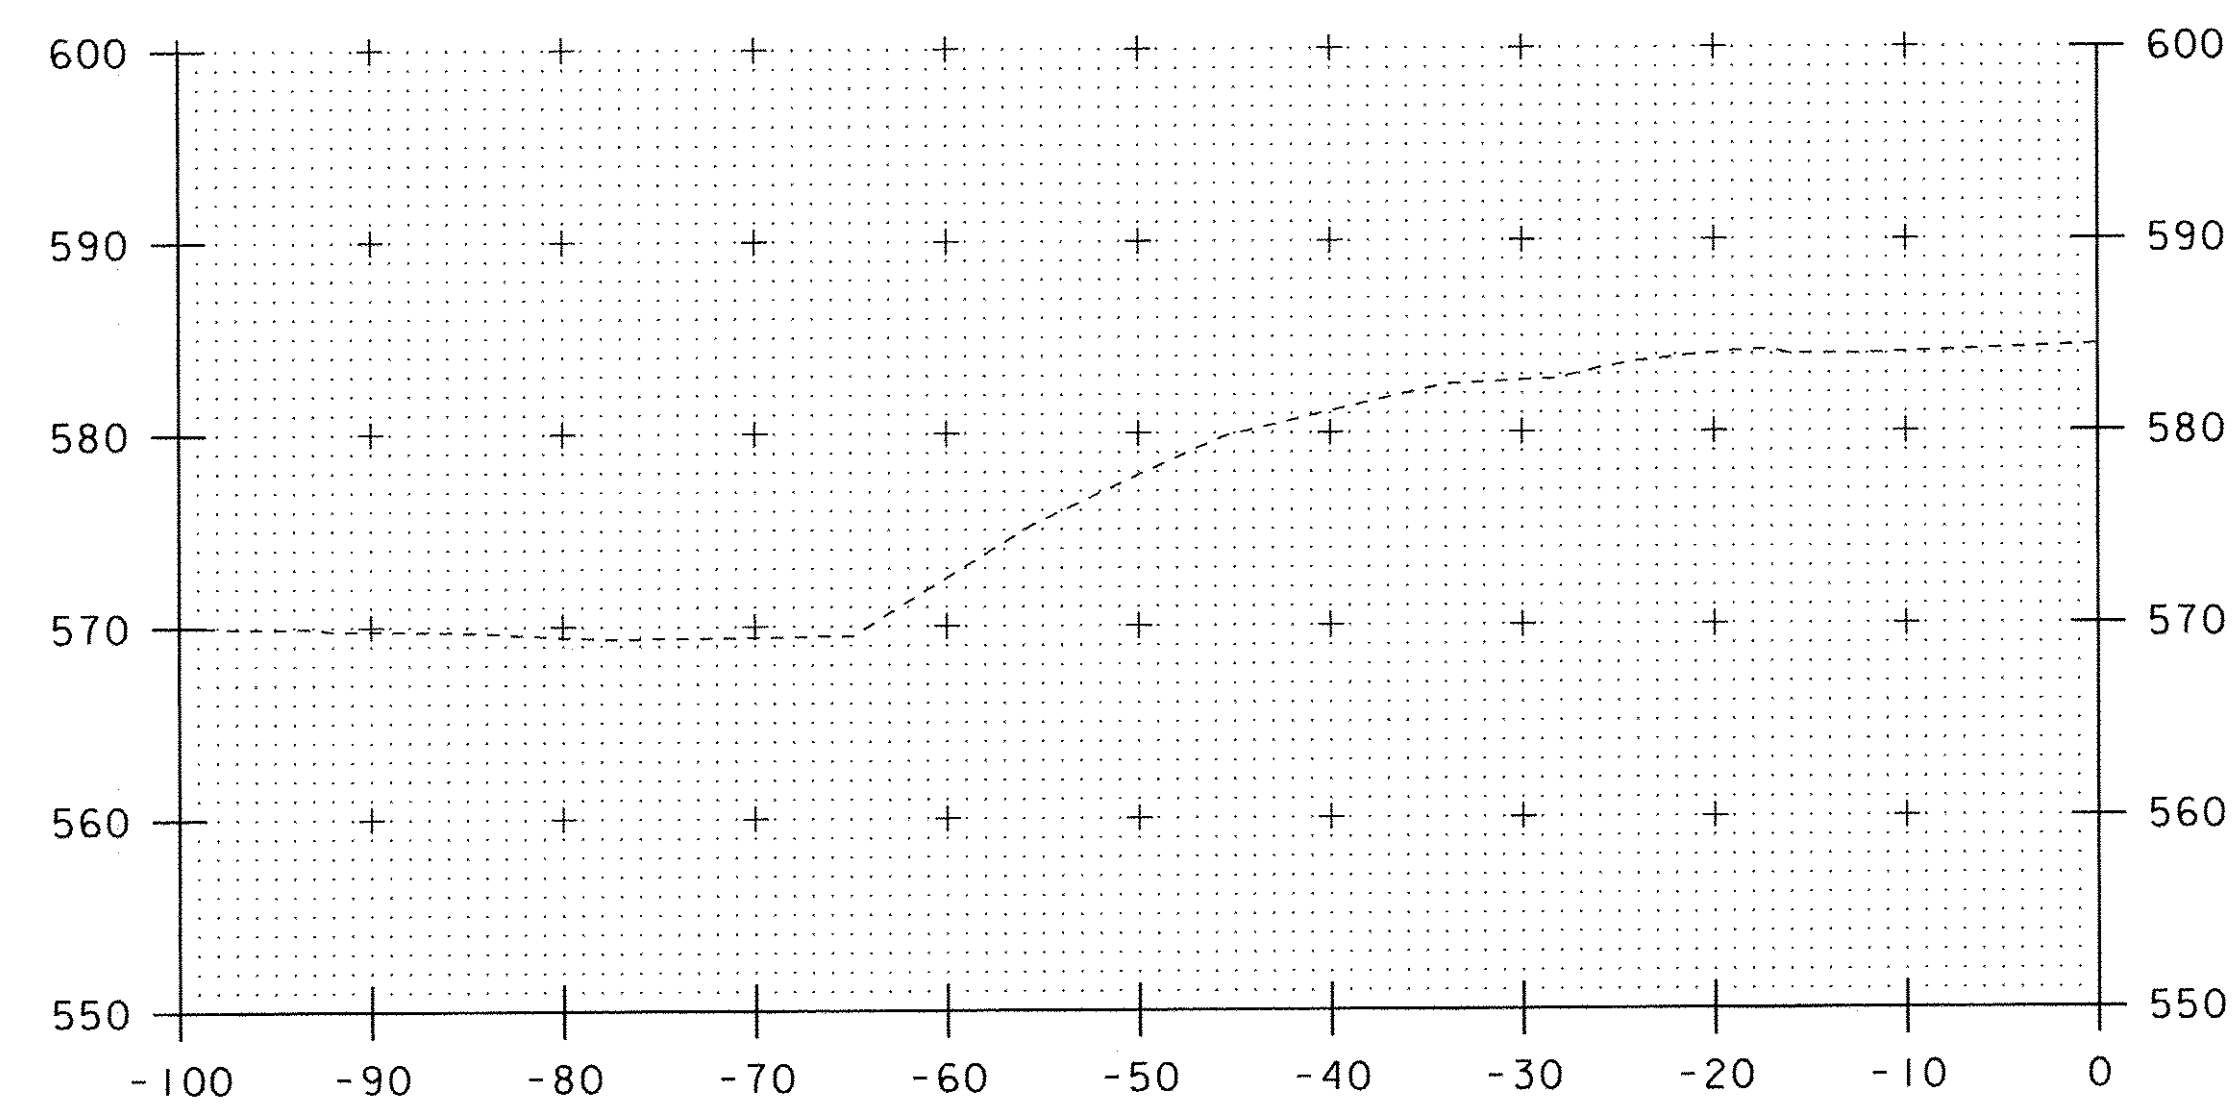

14+30

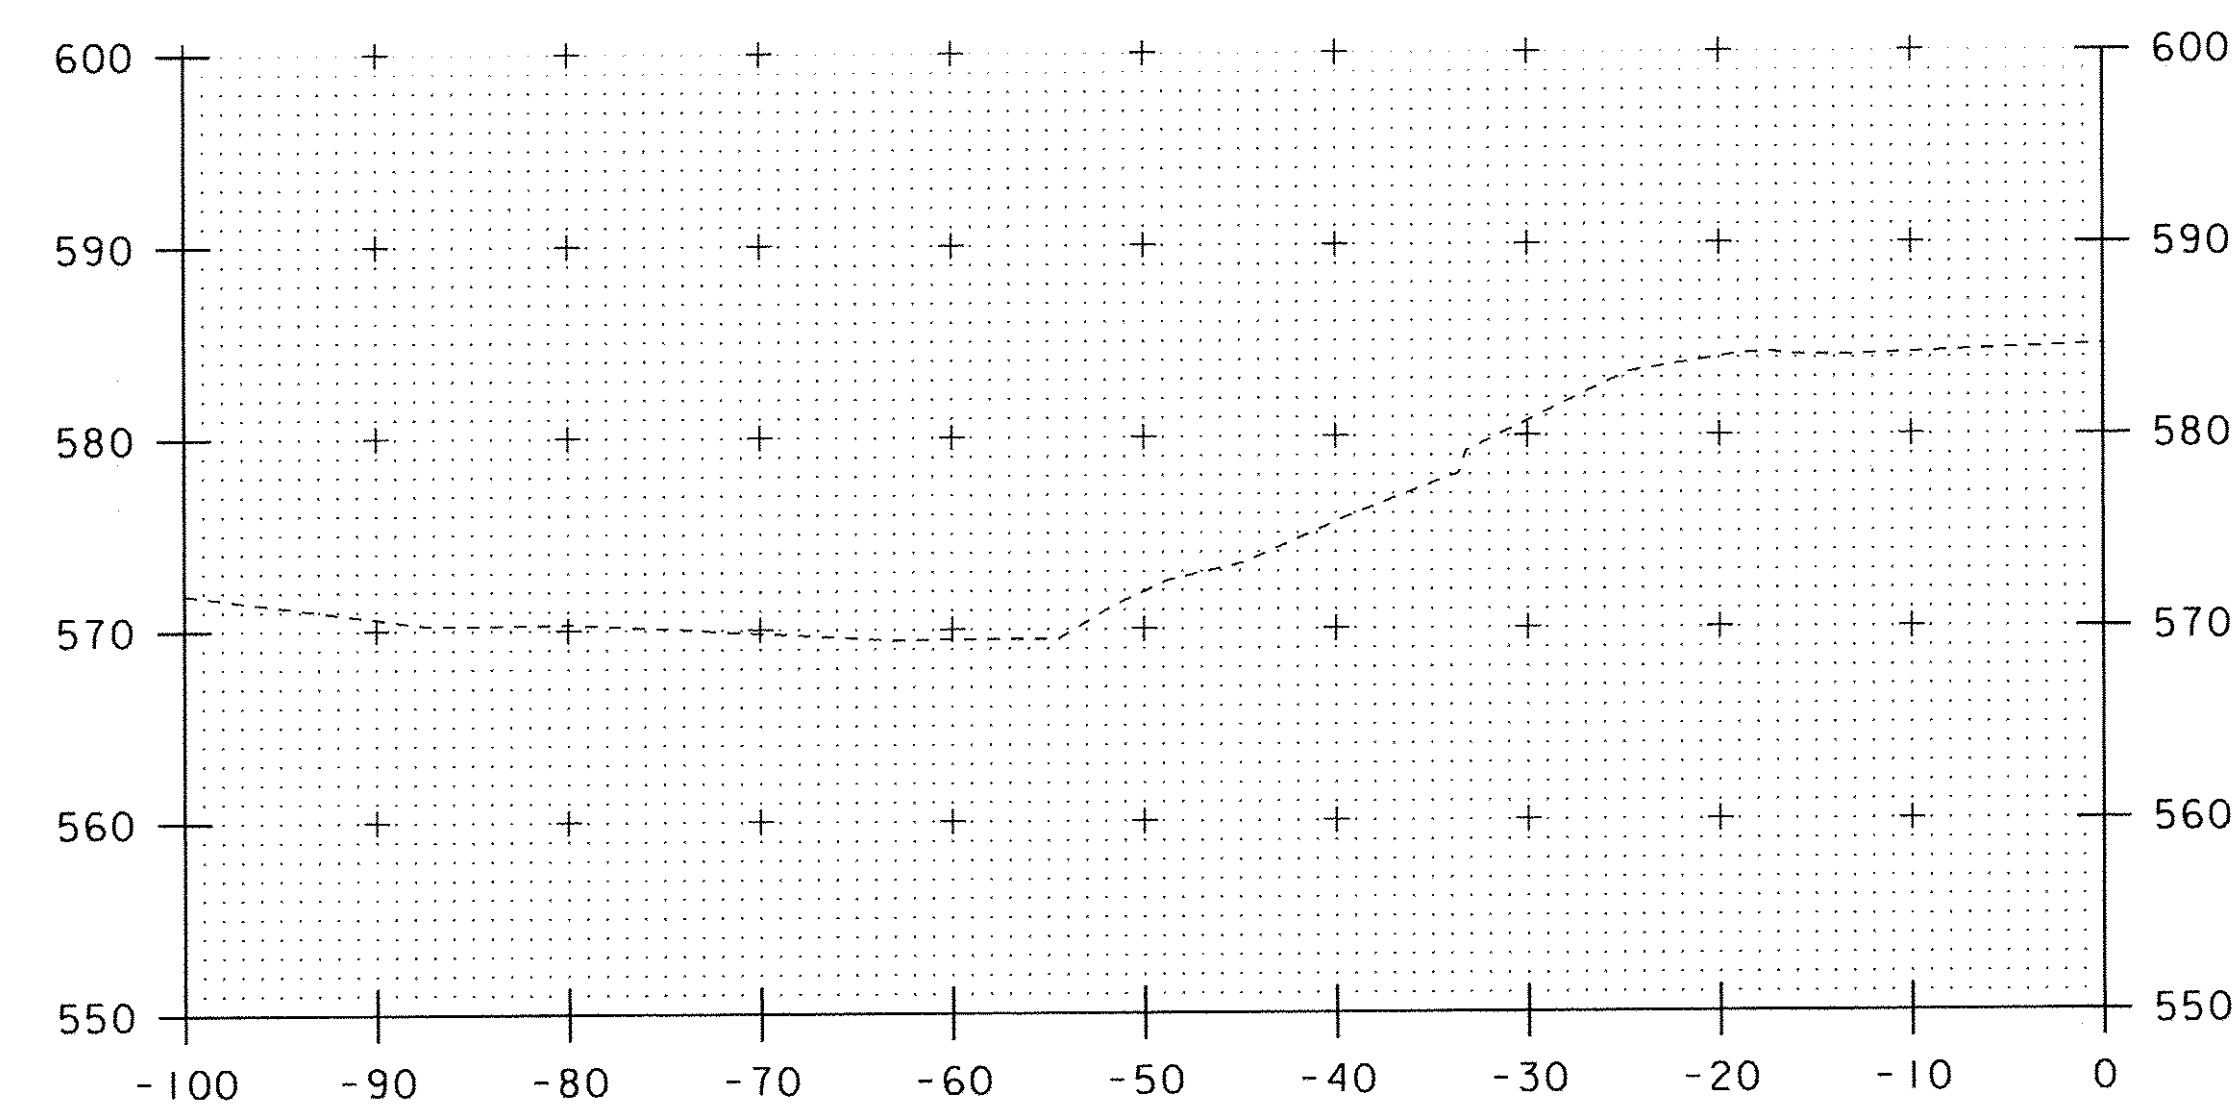

14+20

SCALE 1" = 10'-0"
 10 0 10

STA. 14+00 TO STA. 14+30

PROJECT NAME: CHESTER
 PROJECT NUMBER: BRF 025-1(37)

FILE NAME: s95b168xsl.dgn
 PROJECT LEADER: C.P.WILLIAMS
 DESIGNED BY: R.S.YOUNG
 CONSTRUCTION CROSS SECTIONS

PLOT DATE: 19-MAY-2011
 DRAWN BY: D.D.BEARD
 CHECKED BY: -----
 SHEET 1 OF 1