


14+50

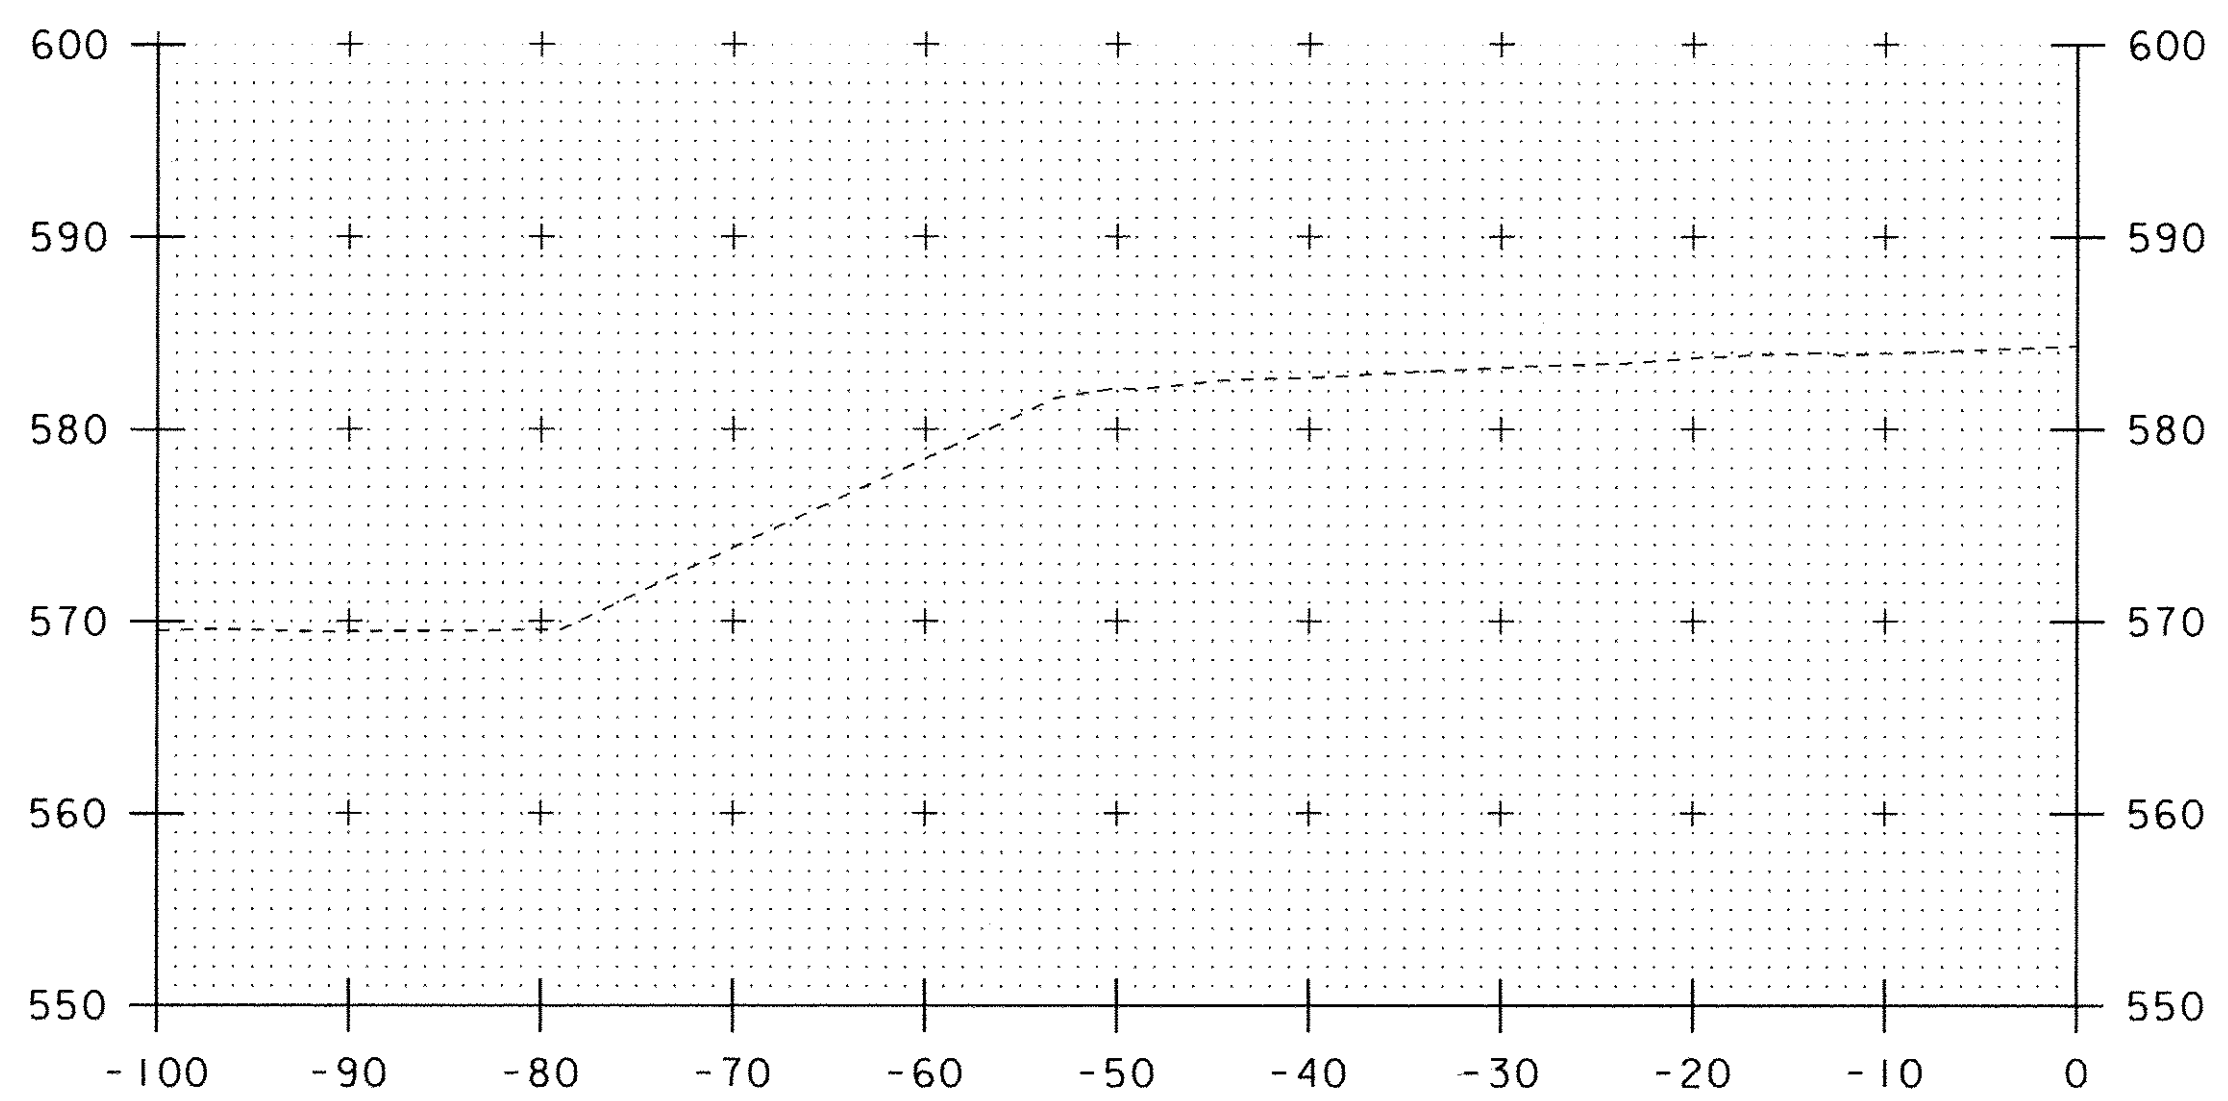

14+40

SCALE 1" = 10'-0"  
 10 0 10

STA. 14+40 TO STA. 14+50

PROJECT NAME: CHESTER  
 PROJECT NUMBER: BRF 025-1(37)

FILE NAME: s95b168xsl.dgn  
 PROJECT LEADER: C.P.WILLIAMS  
 DESIGNED BY: R.S.YOUNG  
 CONSTRUCTION CROSS SECTIONS

PLOT DATE: 19-MAY-2011  
 DRAWN BY: D.D.BEARD  
 CHECKED BY: -----  
 SHEET 1 OF 1