



10

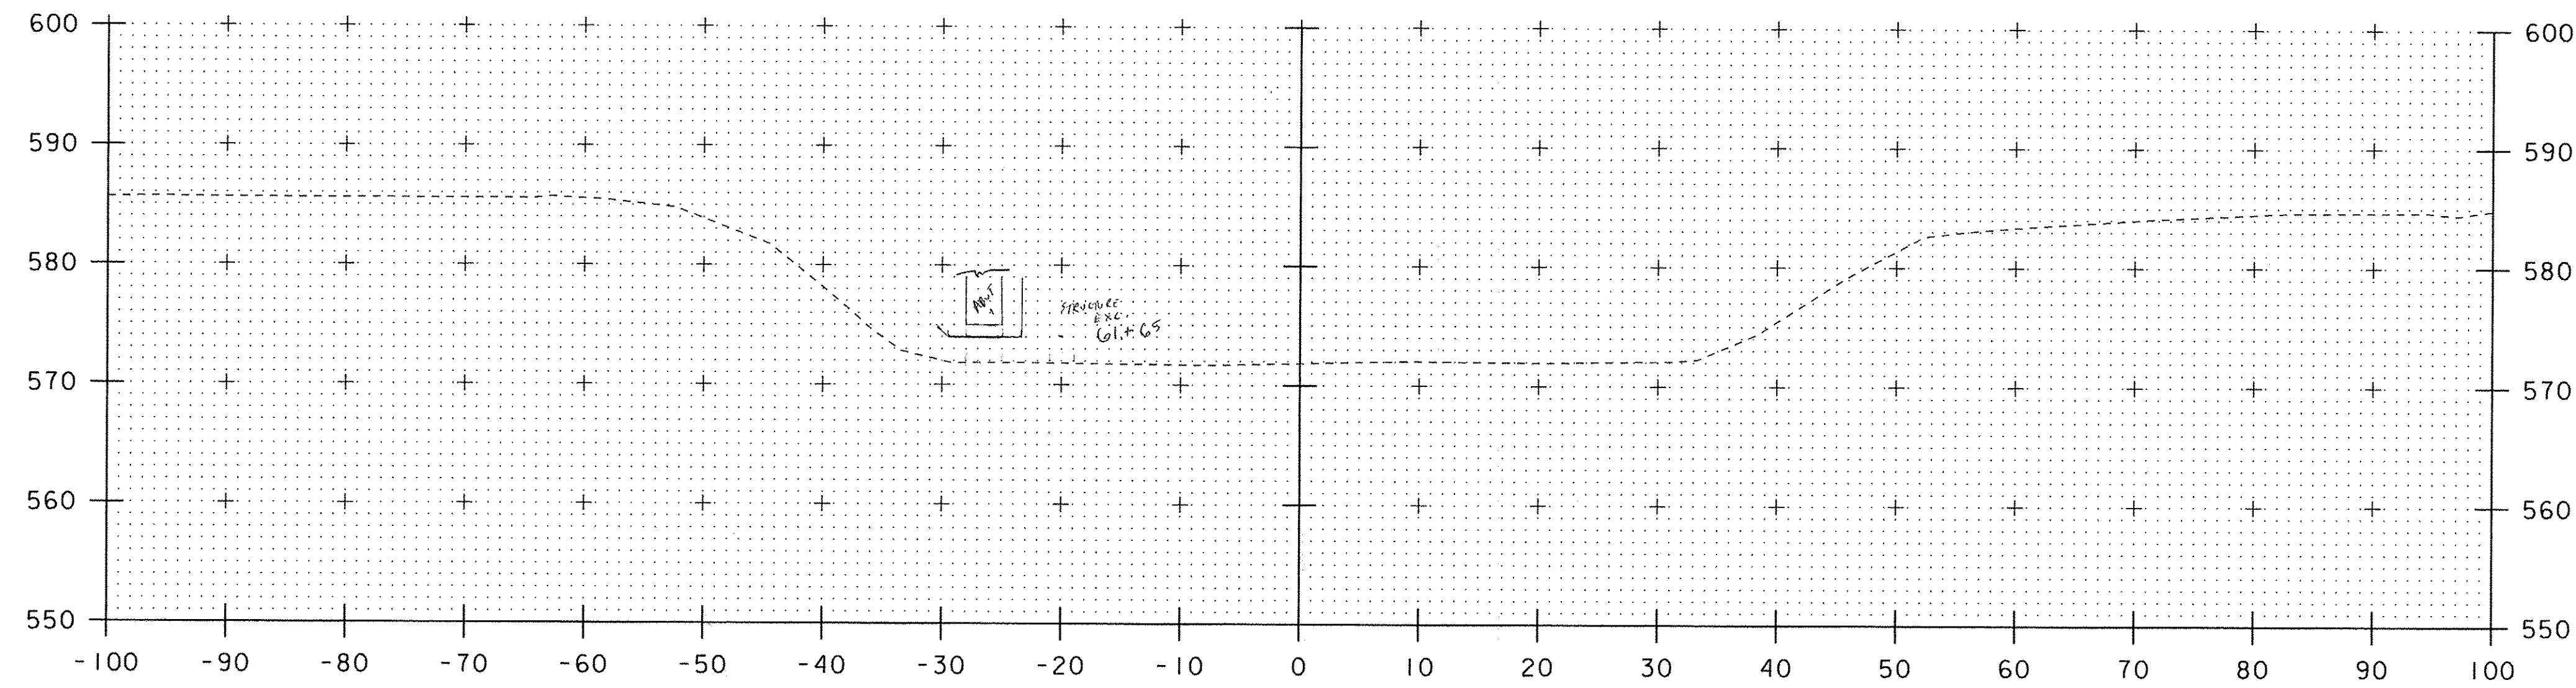

61+60

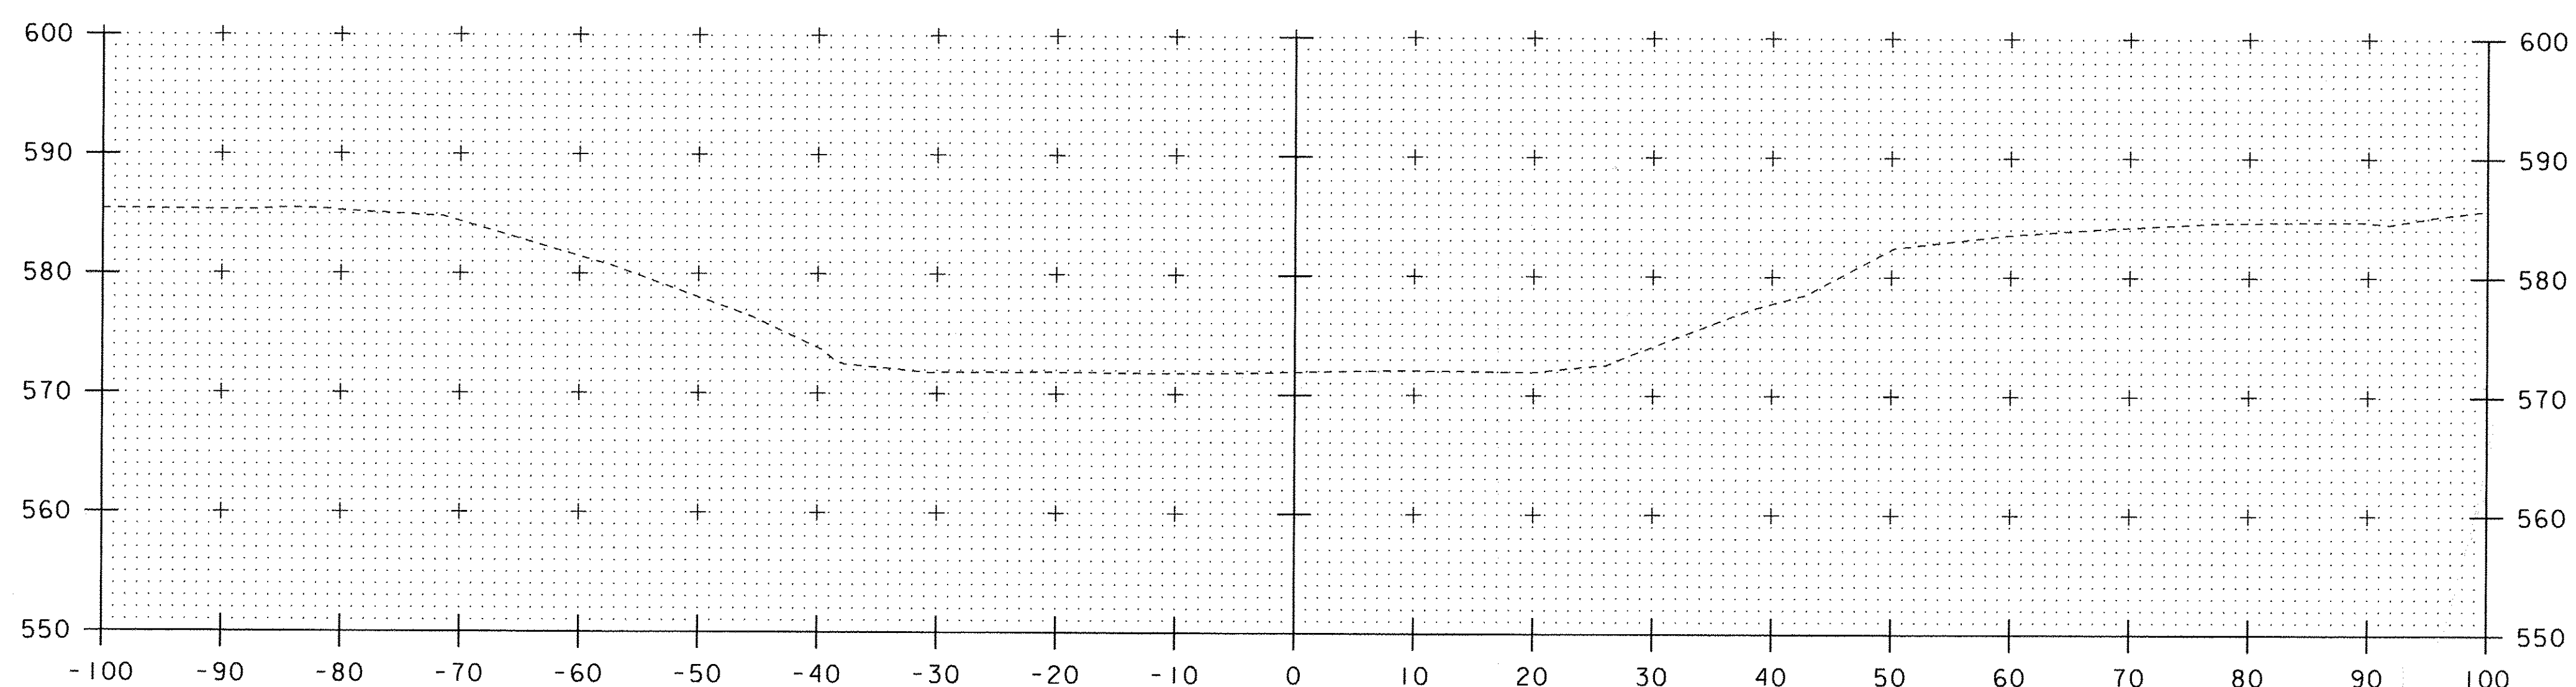

61+50

SCALE 1" = 10'-0"
 10 0 10
 STA. 61+50 TO STA. 61+60

PROJECT NAME: CHESTER	PLOT DATE: 19-MAY-2011
PROJECT NUMBER: BRF 025-1(37)	DRAWN BY: D.D.BEARD
FILE NAME: s95b168xsl.dgn	CHECKED BY: -----
PROJECT LEADER: C.P.WILLIAMS	SHEET 1 OF 1
DESIGNED BY: R.S.YOUNG	
CONSTRUCTION CROSS SECTIONS	