


61+80

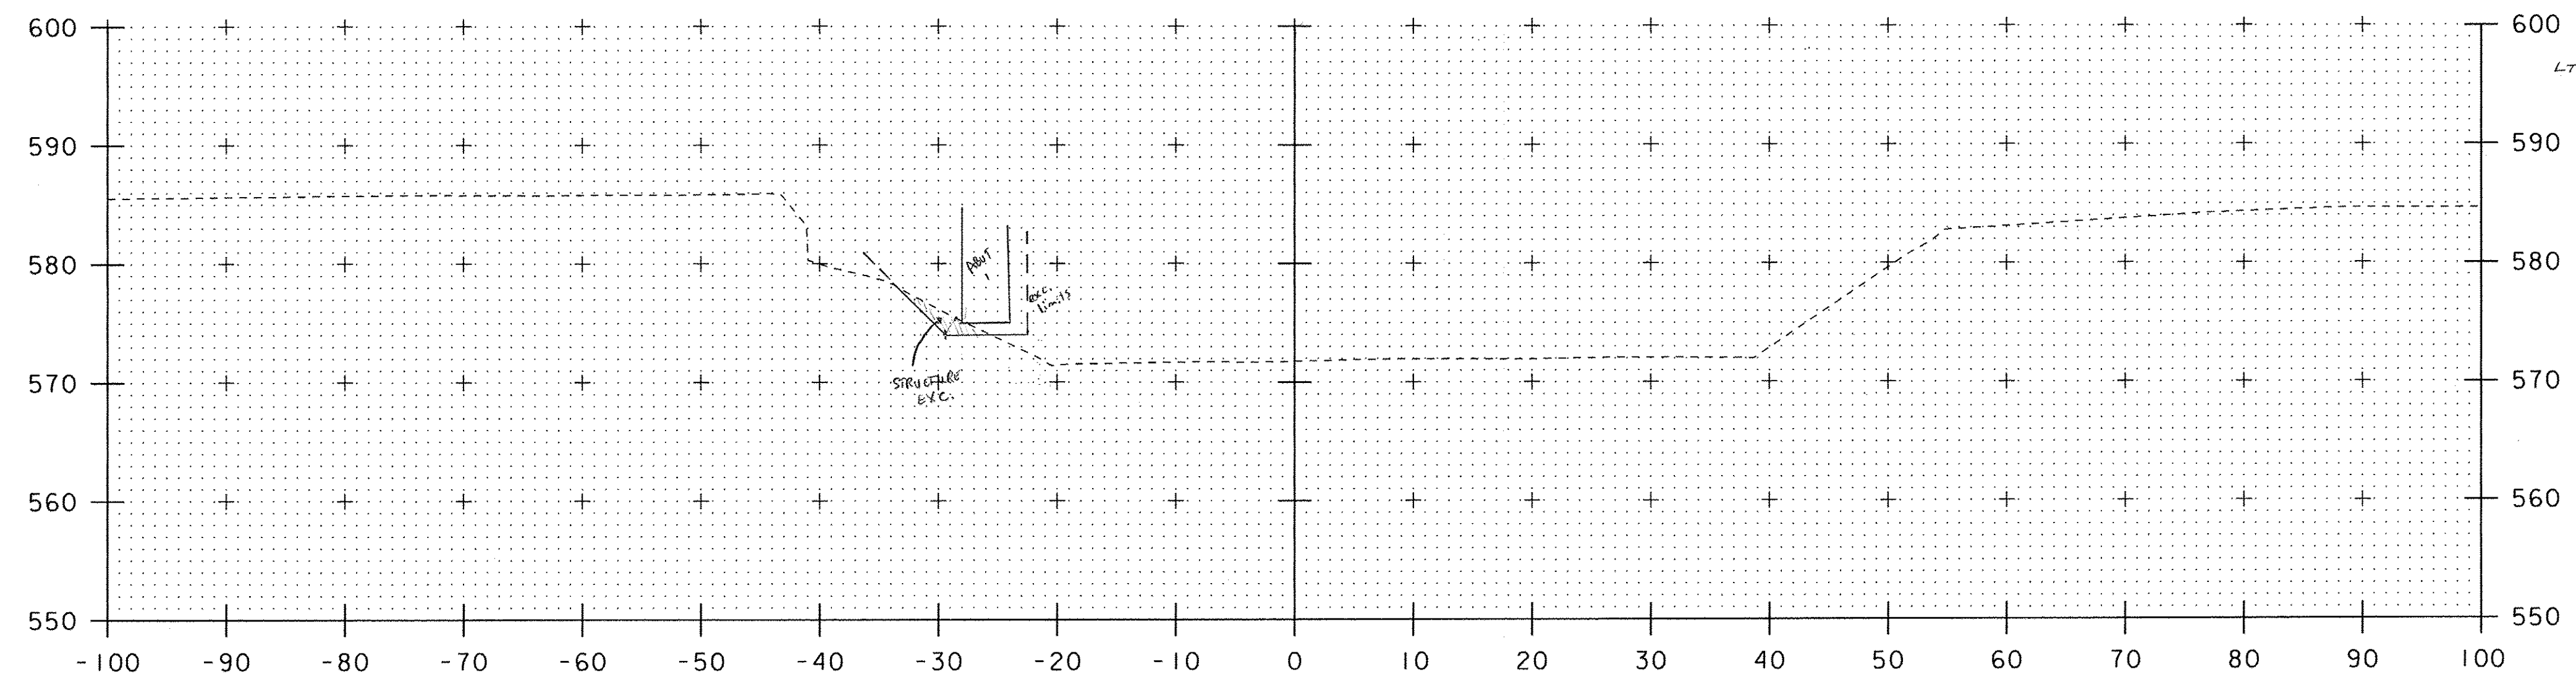

61+70

SCALE 1" = 10'-0"

STA. 62+00 TO STA. 62+80

PROJECT NAME: CHESTER
 PROJECT NUMBER: BRF 025-(137)

FILE NAME: s95b168xsl.dgn
 PROJECT LEADER: C.P.WILLIAMS
 DESIGNED BY: R.S.YOUNG
 CONSTRUCTION CROSS SECTIONS

PLOT DATE: 19-MAY-2011
 DRAWN BY: D.D.BEARD
 CHECKED BY: -----
 SHEET 1 OF 1