


62+00

UNCLASSIFIED CHANNEL EXC:  
 LT:  $1.5 \times 2' = 3 \text{ SF}$  ✓  
 $3' \times 10' = 30 \text{ SF}$  ✓  
33 SF ✓

STRUCTURE EXC:  
 LT:  $\frac{4'}{2} \times 9' = 18 \text{ SF}$  ✓  
 $\frac{4' \times 2'}{2} \times 1.5' = 15 \text{ SF}$  ✓  
33 SF ✓

UNCLASSIFIED CHANNEL EXC:  
 RT:  $\frac{10' \times 2'}{2} \times .9' = 30.375$  ✓  
 $\frac{5' \times 2'}{2} \times .8' = 3.4$  ✓  
64.375 ✓

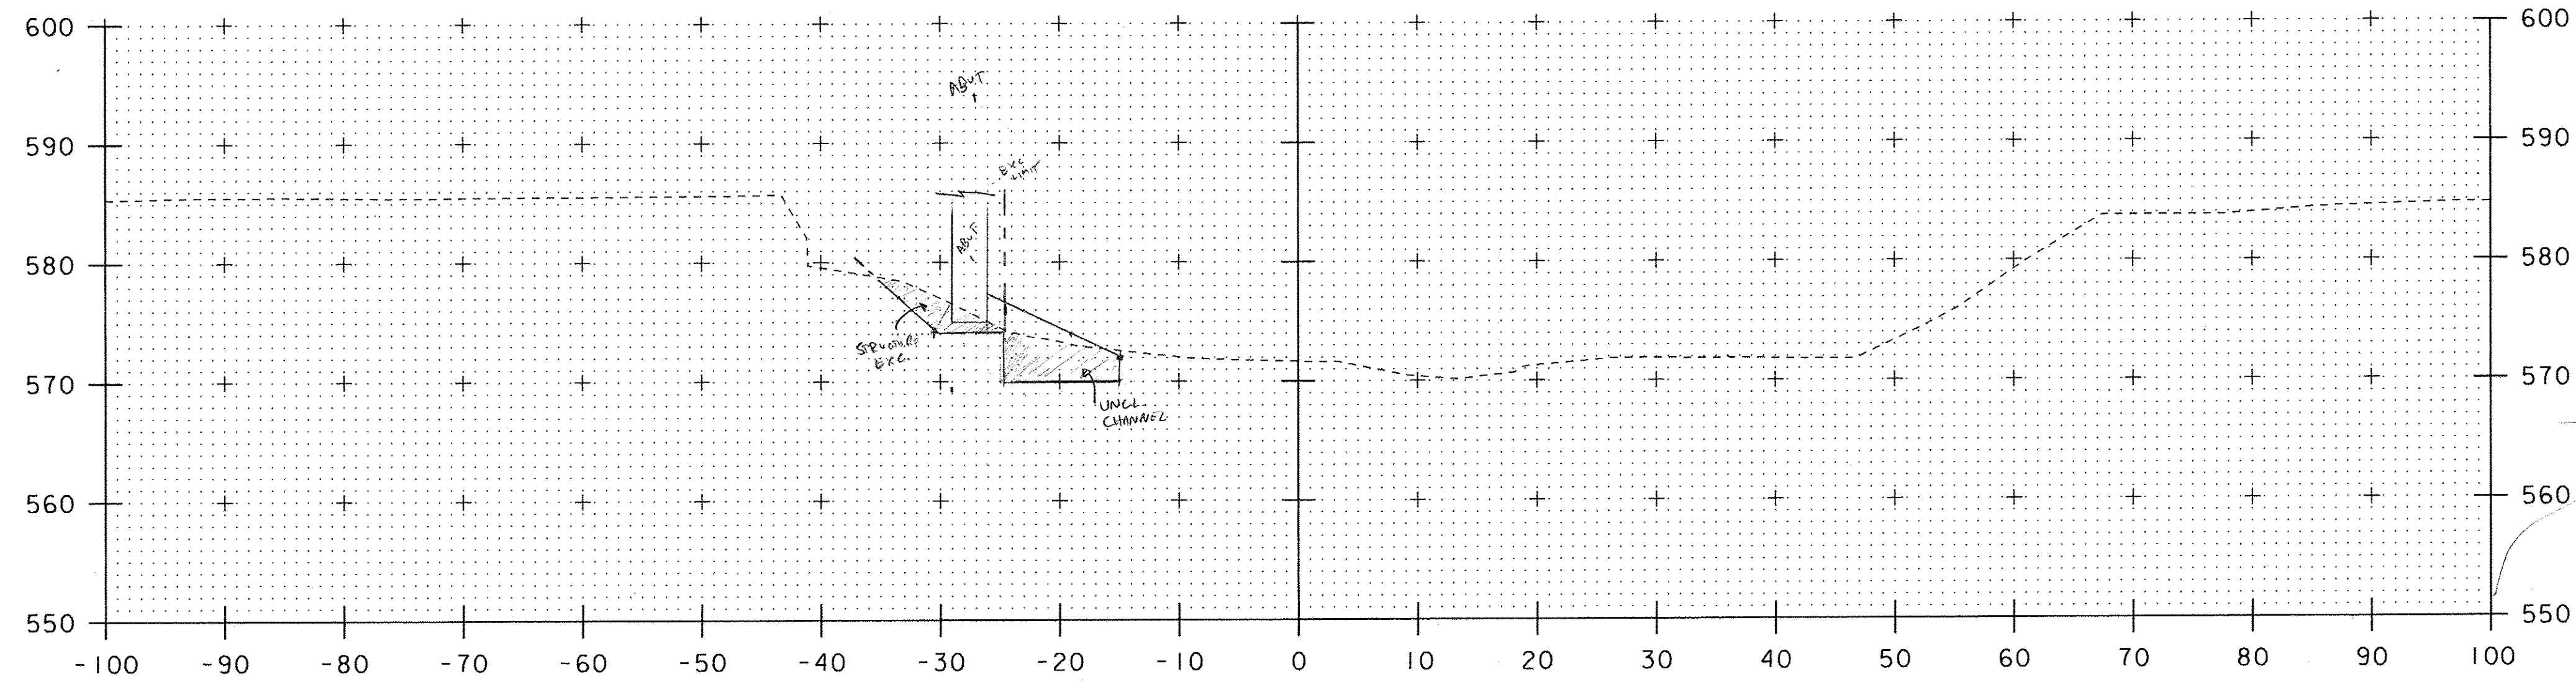

61+90

UNCLASSIFIED CHANNEL EXC:  
 LT:  $3.2' \times 9.5' = 30.9 \text{ SF}$  ✓

STRUCTURE EXCAVATION:  
 LT:  $\frac{6.5'}{2} \times 3 = 9.75 \text{ SF}$  ✓  
 $\frac{5'}{2} \times 3 = 7.5 \text{ SF}$  ✓  
17.25 SF ✓

UNCLASSIFIED CHANNEL EXC:  
 RT: STAYS @ 61+94 @ SAME AREA AS 62+00

SCALE 1" = 10'-0"  
 10 0 10

STA. 62+90 TO STA. 62+00

PROJECT NAME: CHESTER  
 PROJECT NUMBER: BRF 025-1(37)  
 FILE NAME: s95b168xsl.dgn  
 PROJECT LEADER: C.P.WILLIAMS  
 DESIGNED BY: R.S.YOUNG  
 CONSTRUCTION CROSS SECTIONS

PLOT DATE: 19-MAY-2011  
 DRAWN BY: D.D.BEARD  
 CHECKED BY: -----  
 SHEET 1 OF 1