


UNCLASSIFIED CHANNEL EXC:
 LT: ENDS @ 62+44

UNCLASSIFIED CHANNEL EXC:
 $RT: \frac{8.6}{2} \cdot 10' = 70 \text{ SF} \checkmark$

STRUCTURE EXC:
 $RT: 10' \cdot 7' = 70 \text{ SF} \checkmark$
 $10' \cdot 10' \cdot \frac{1}{2} = 50 \text{ SF} \checkmark$
 $120 \text{ SF} \checkmark$
 9/4

62+40

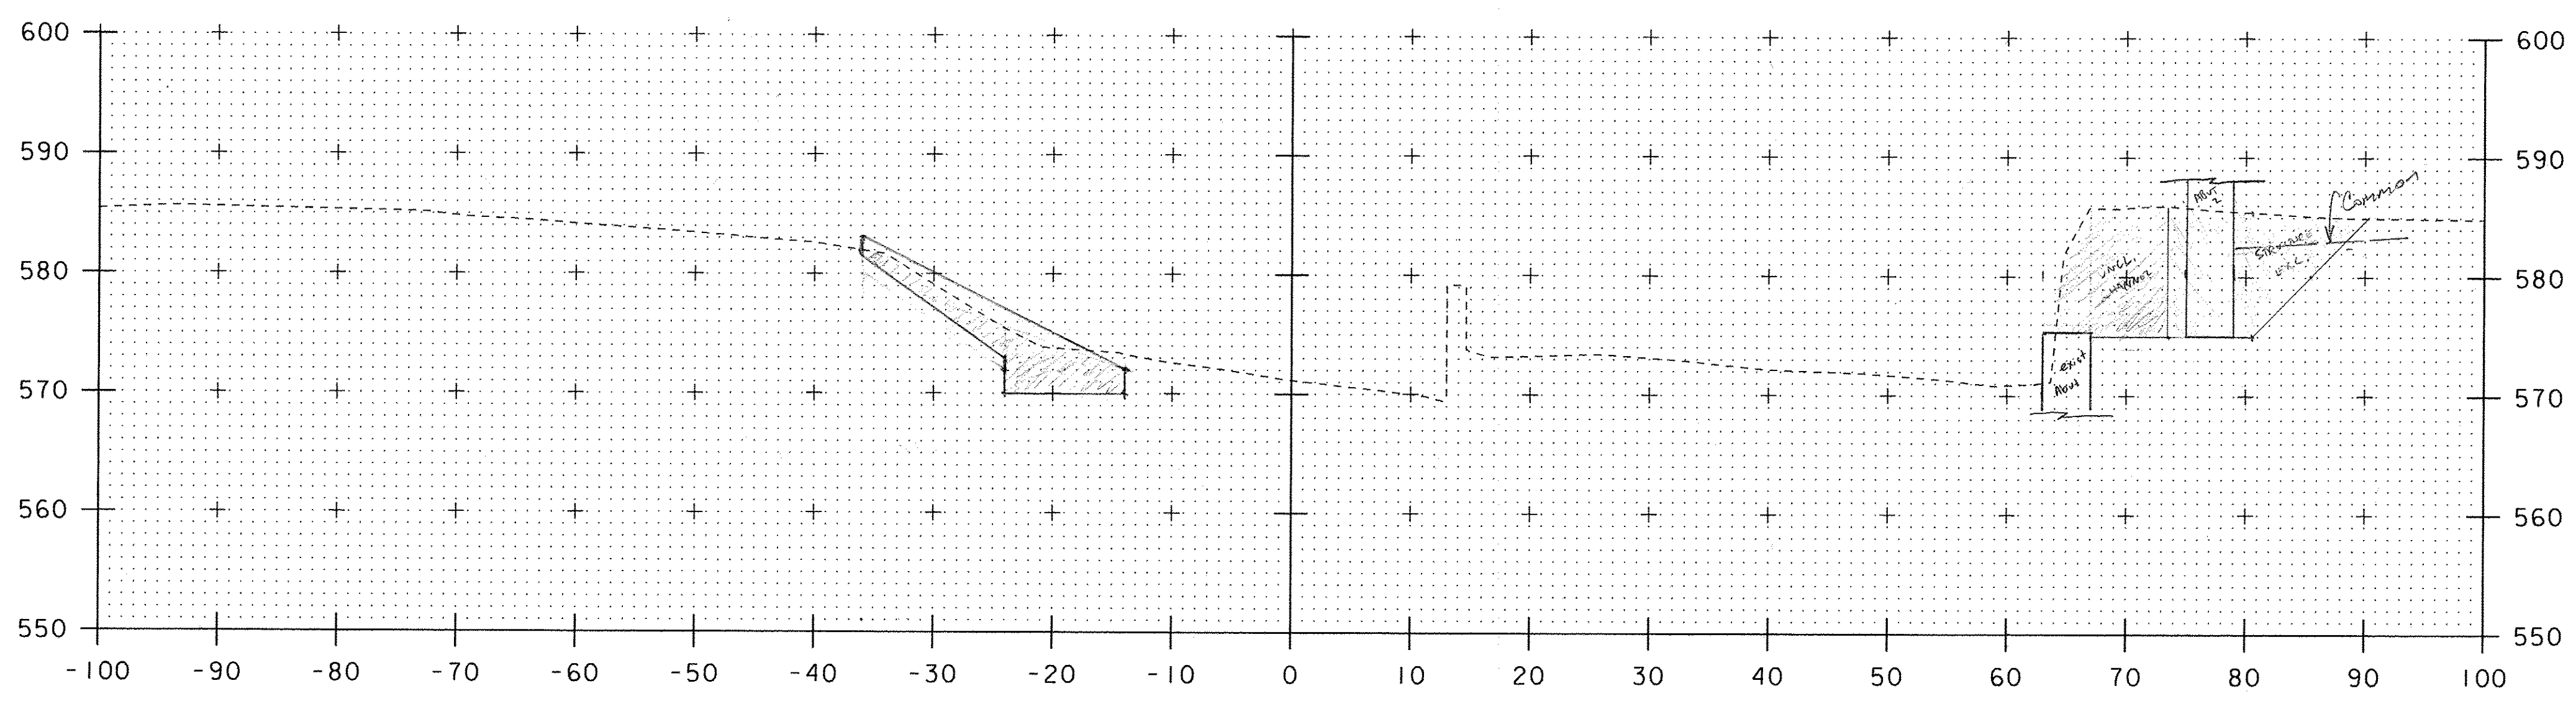

UNCLASSIFIED CHANNEL EXC:
 LT: $\frac{1' \cdot 2' \cdot 14' \cdot 14'}{2} = 21 \text{ SF} \checkmark$
 $3.25 \cdot 10 = 32.5 \text{ SF} \checkmark$
 $53.5 \text{ SF} \checkmark$

UNCLASSIFIED CHANNEL EXC:
 RT: $11' \cdot \frac{9.5 \cdot 17}{2} = 90.75 \text{ SF} \checkmark$

STRUCTURE EXC:
 RT:
 $10.5' \cdot 7' = 73.5 \text{ SF} \checkmark$
 $10' \cdot 10' \cdot \frac{1}{2} = 50 \text{ SF} \checkmark$
 $123.5 \text{ SF} \checkmark$

62+30

SCALE 1" = 10' - 0"
 10 0 10
 STA. 62+30 TO STA. 62+40

PROJECT NAME: CHESTER
 PROJECT NUMBER: BRF 025-(137)

FILE NAME: s95b168xsl.dgn
 PROJECT LEADER: C.P.WILLIAMS
 DESIGNED BY: R.S.YOUNG
 CONSTRUCTION CROSS SECTIONS

PLOT DATE: 19-MAY-2011
 DRAWN BY: D.D.BEARD
 CHECKED BY: -----
 SHEET 1 OF 1