


63+00

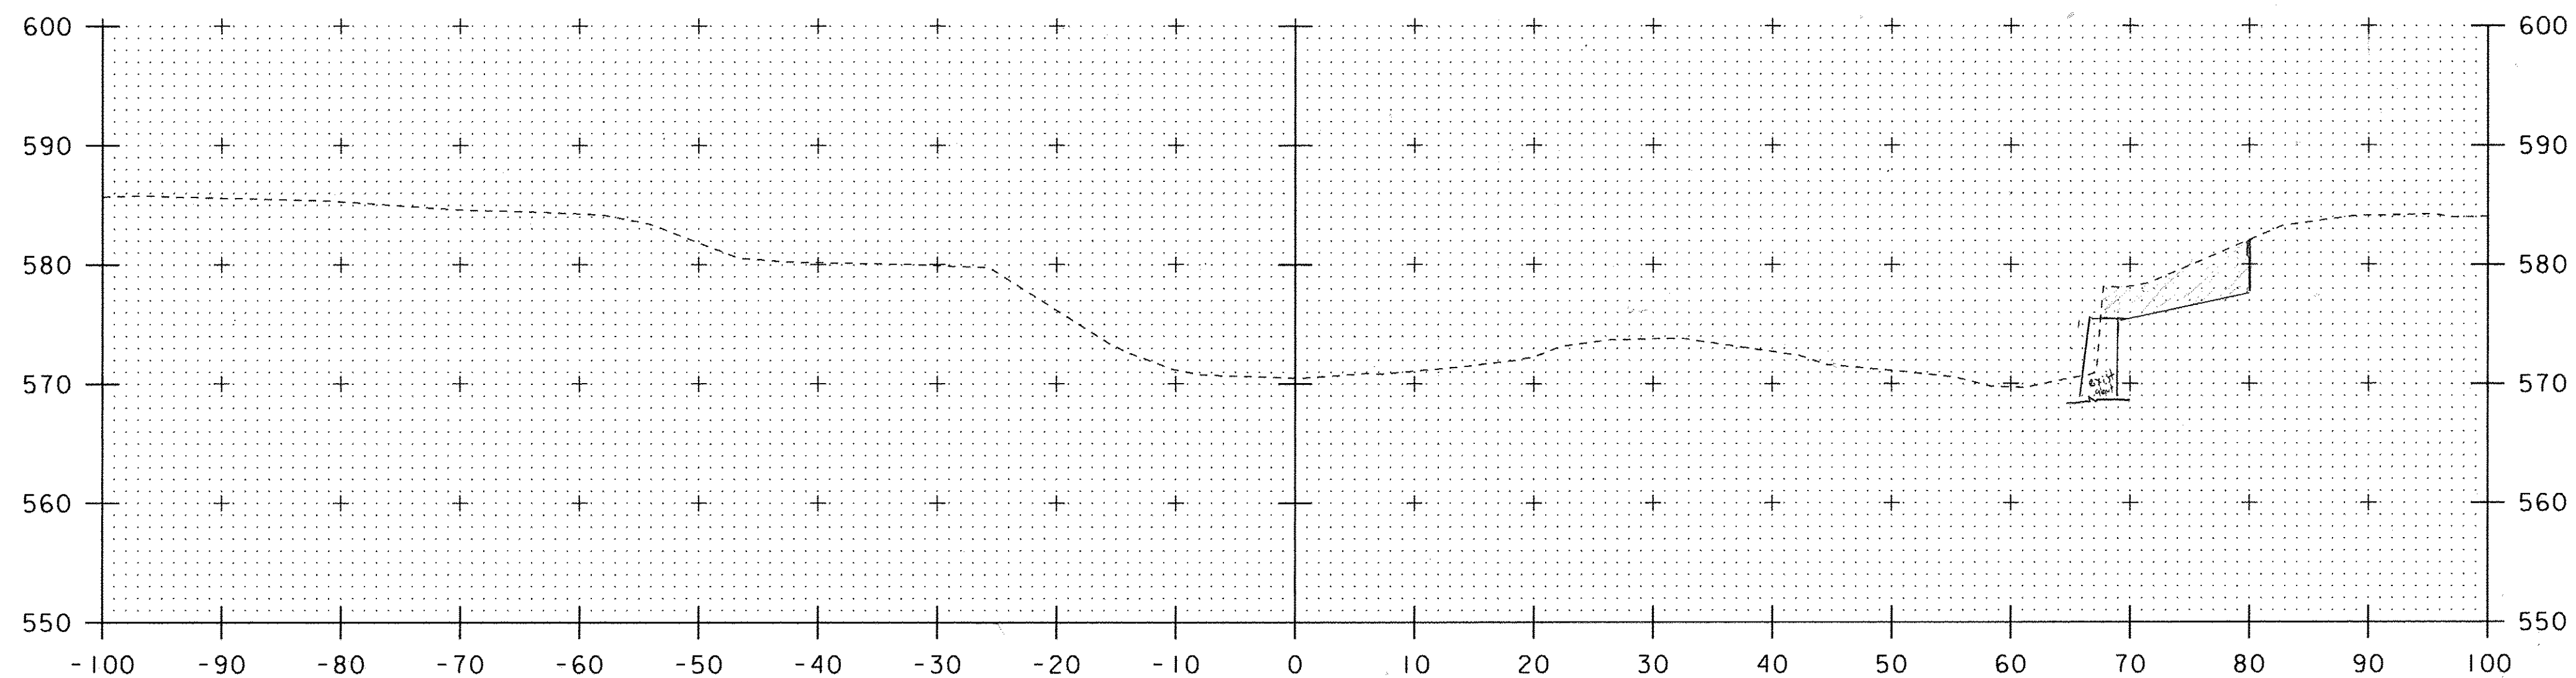

62+90

SCALE 1" = 10'-0"

STA. 62+90 TO STA. 63+00

PROJECT NAME: CHESTER	PLOT DATE: 19-MAY-2011
PROJECT NUMBER: BRF 025-1(37)	DRAWN BY: D.D.BEARD
FILE NAME: s95b168xsl.dgn	CHECKED BY: -----
PROJECT LEADER: C.P.WILLIAMS	SHEET 1 OF 1
DESIGNED BY: R.S.YOUNG	
CONSTRUCTION CROSS SECTIONS	