




14+50

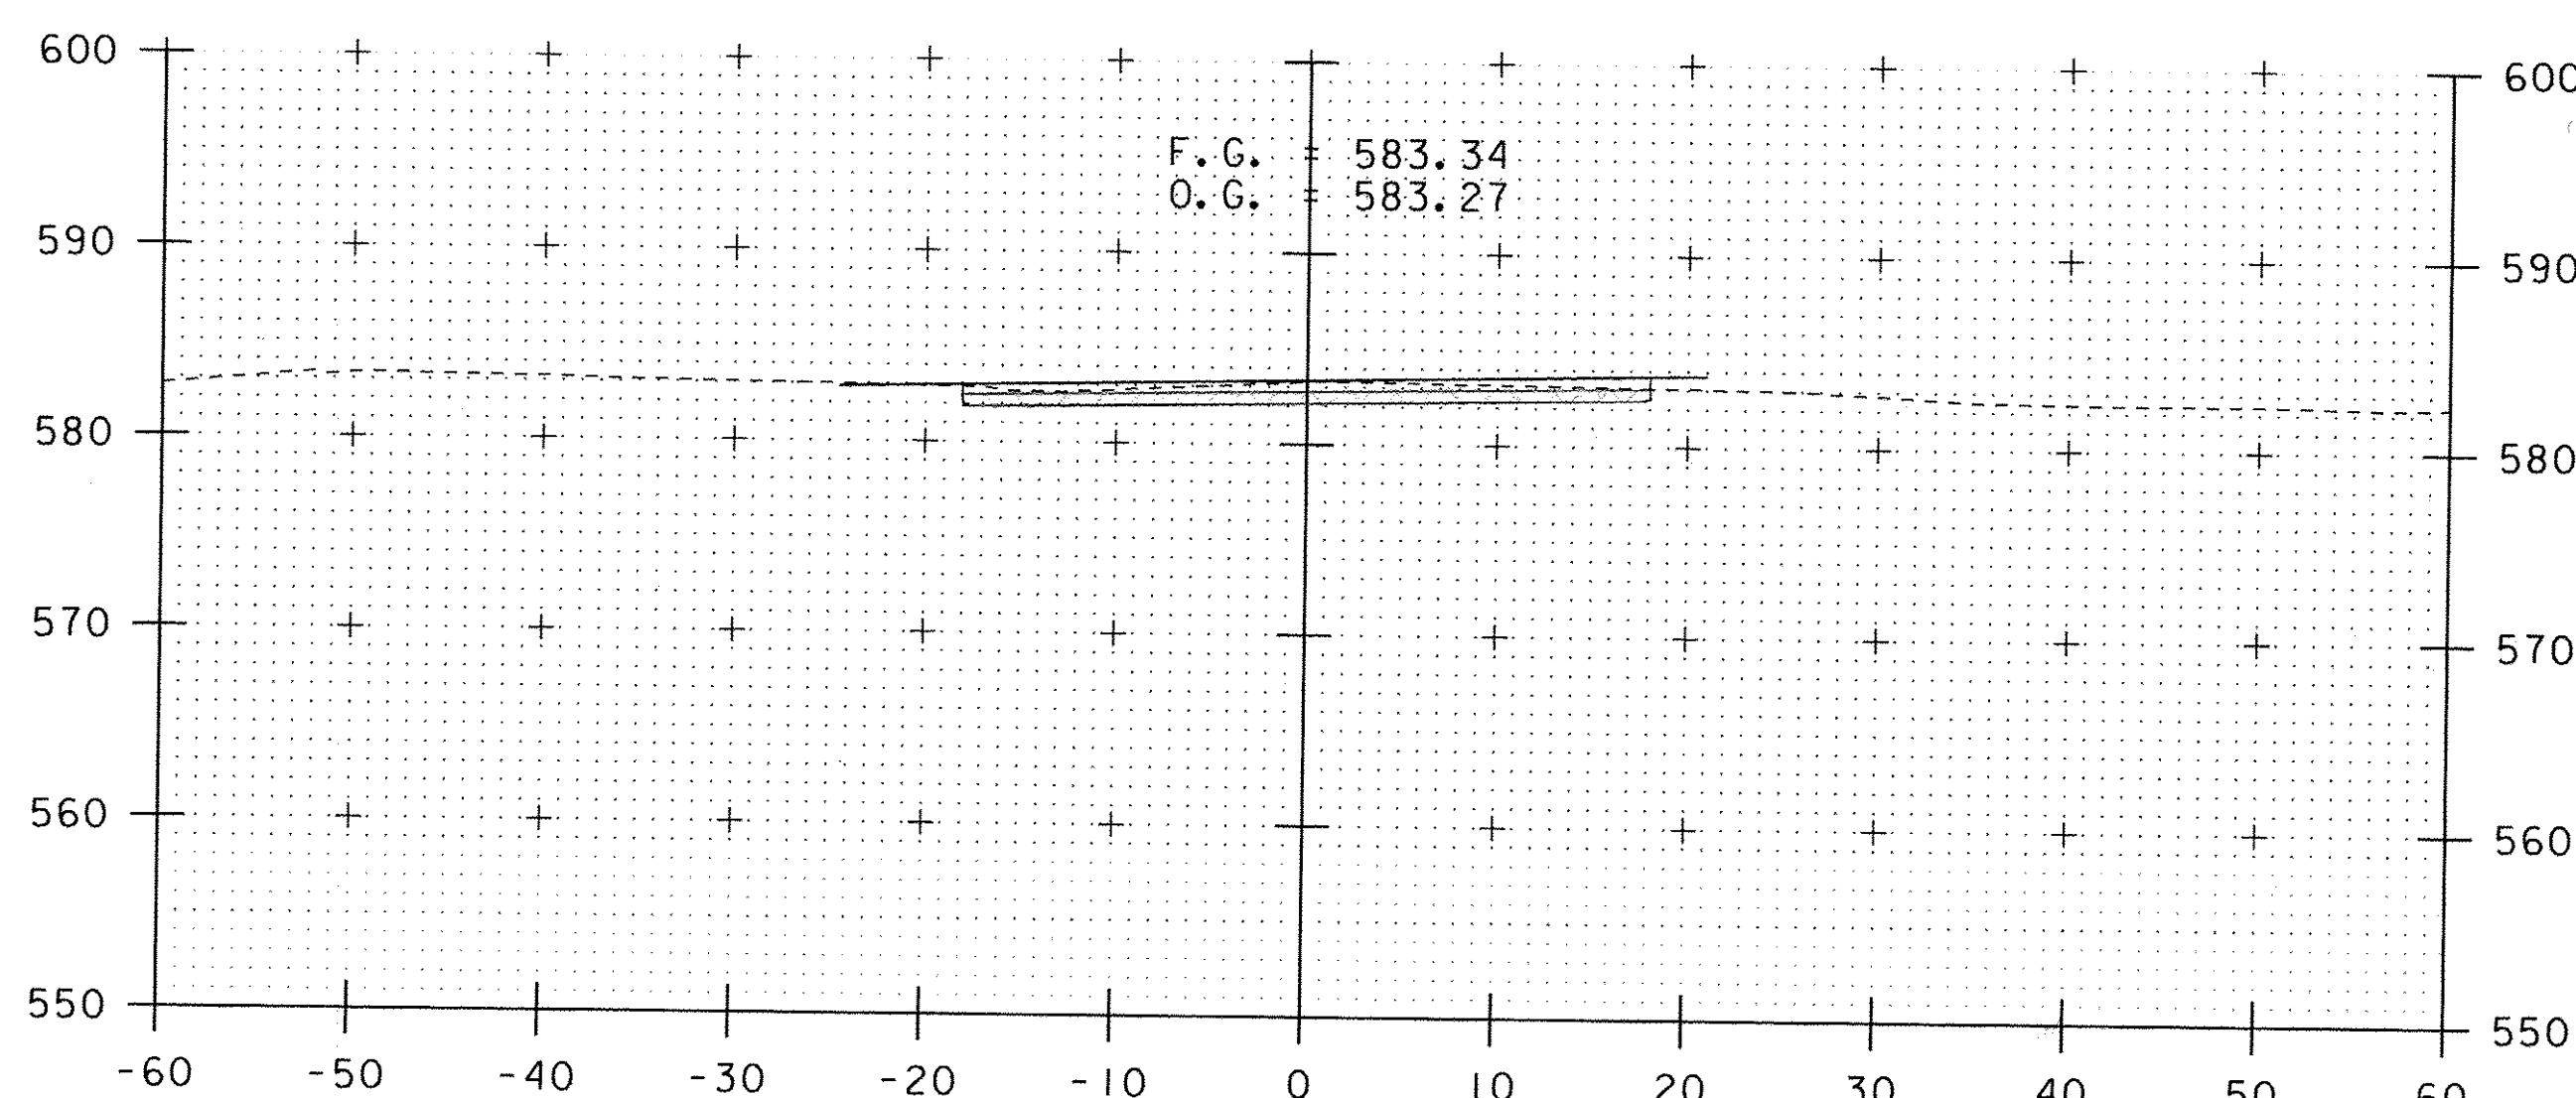


15+00

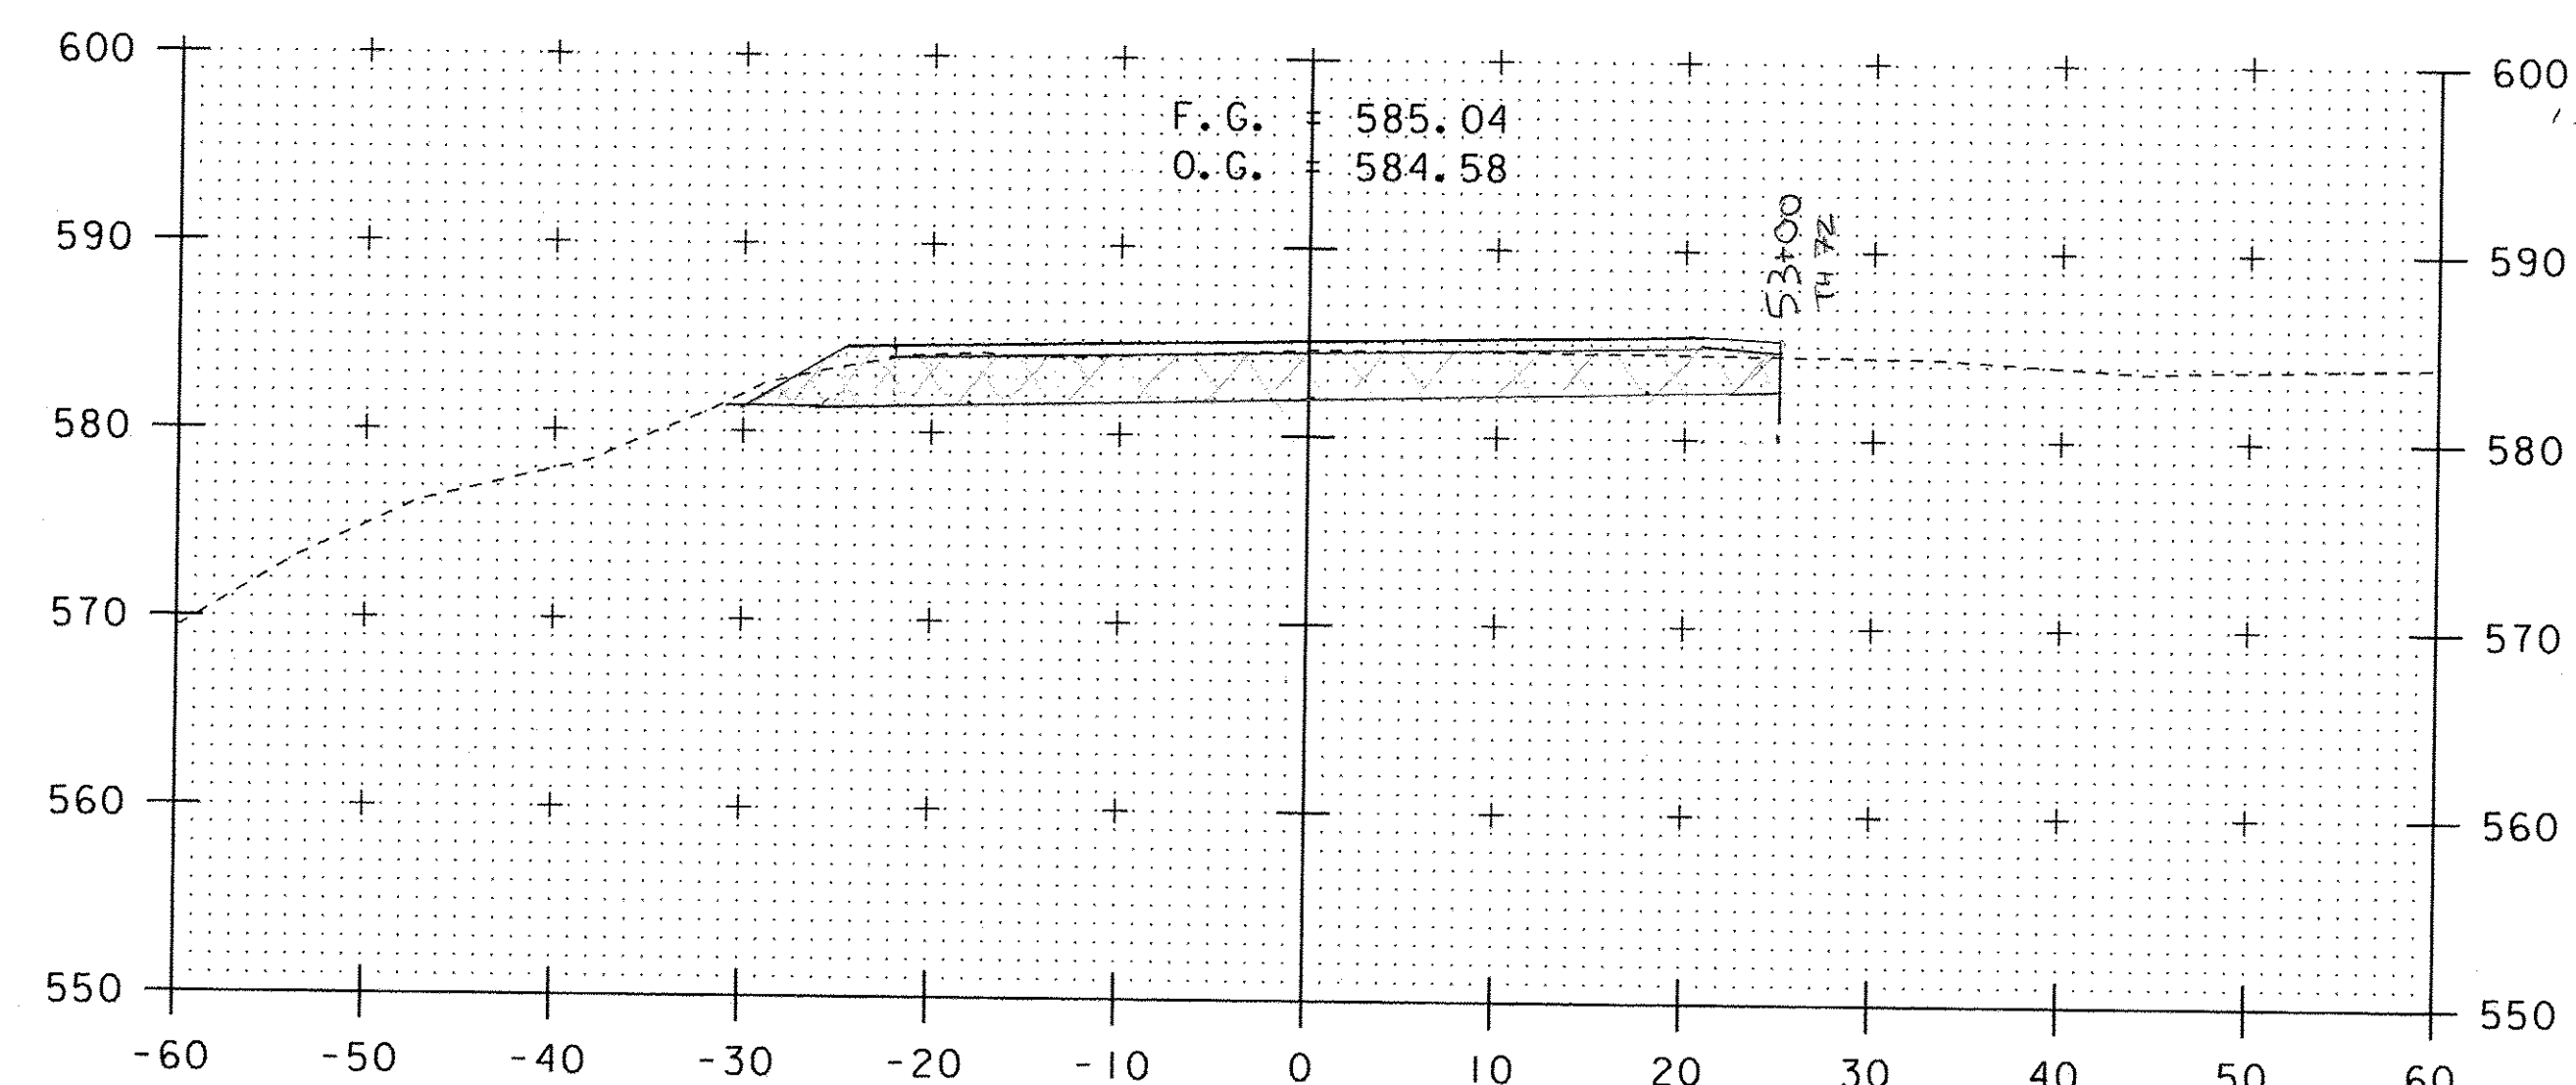

14+25

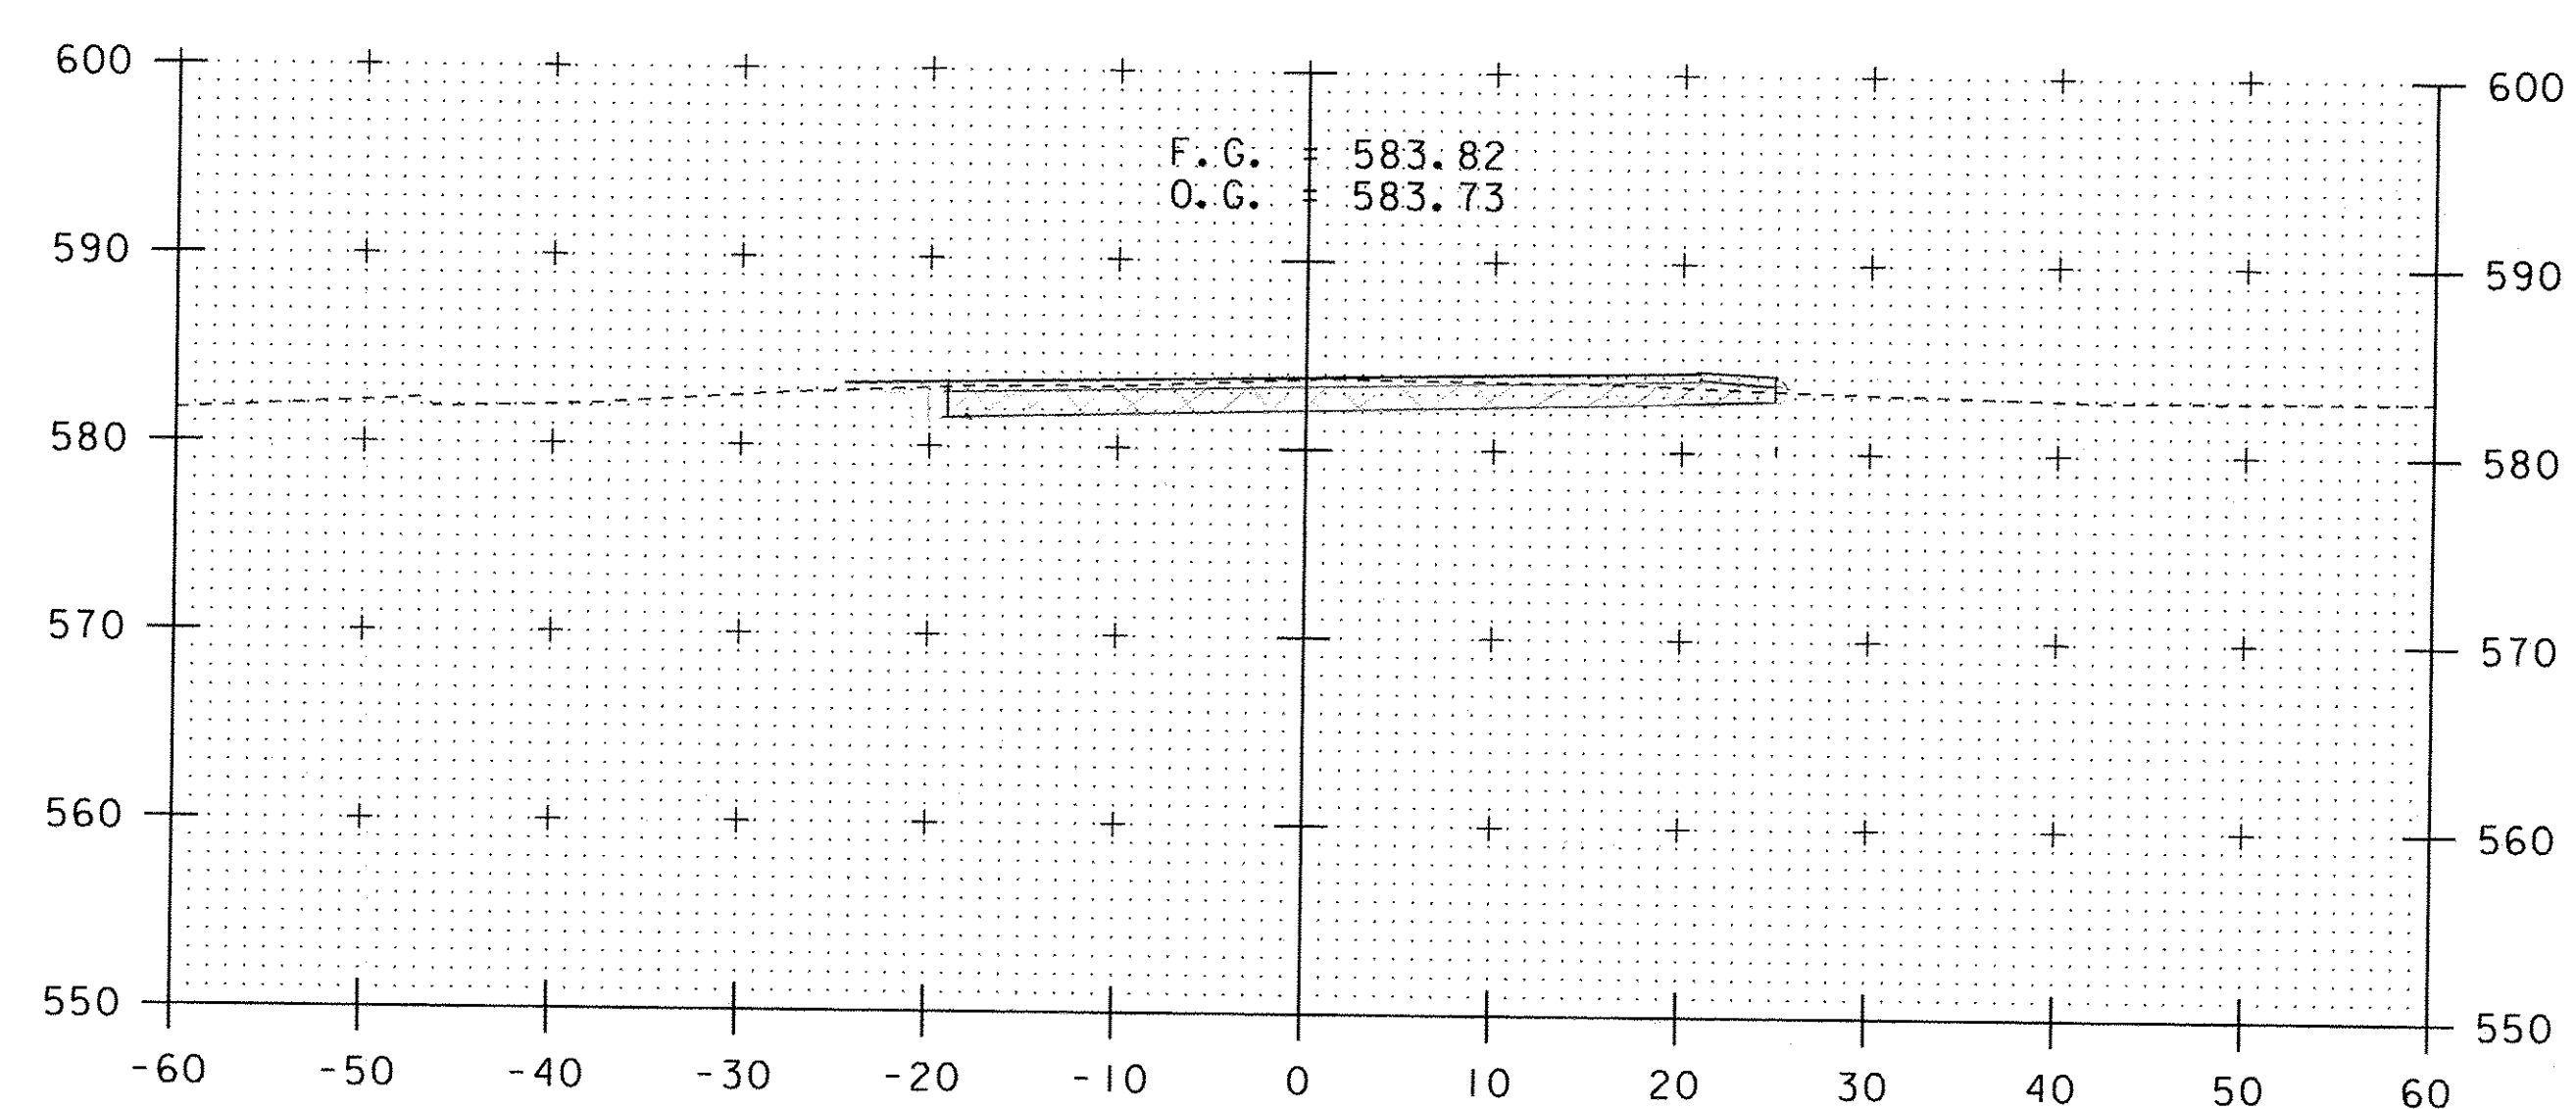

14+75

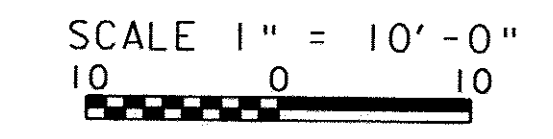

SCALE 1" = 10'-0"

PROJECT NAME: CHESTER	
PROJECT NUMBER: BRF 025-1(37)	
FILE NAME: s95b168xsl.dgn	PLOT DATE: 13-JUN-2011
PROJECT LEADER: C.P.WILLIAMS	DRAWN BY: D.D.BEARD
DESIGNED BY: R.S.YOUNG	CHECKED BY: -----
CONSTRUCTION CROSS SECTIONS	
SHEET 1 OF 1	

STA. 14+25 TO STA. 15+00