




11+75

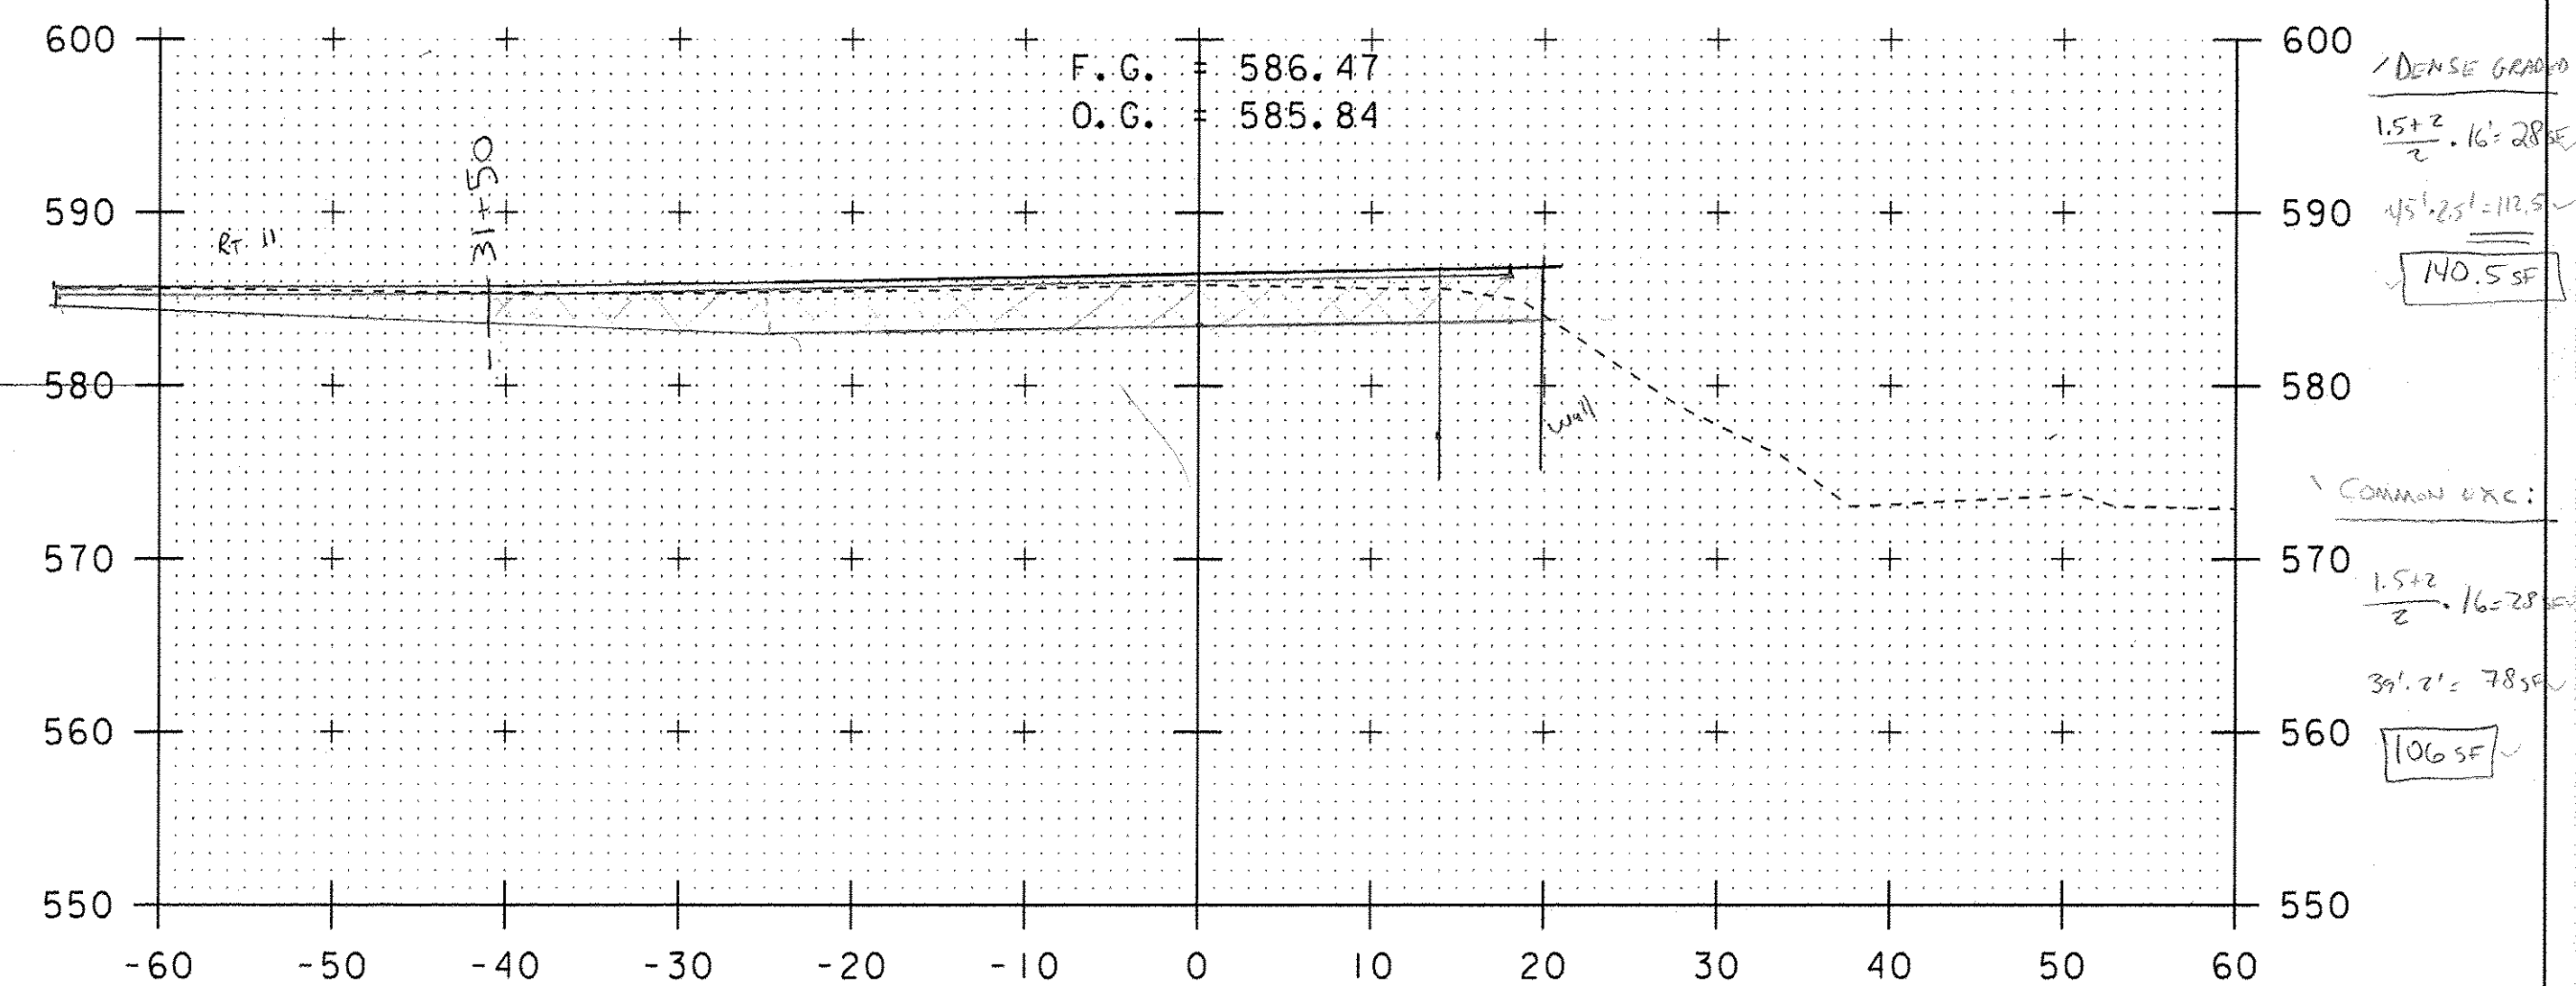


12+25

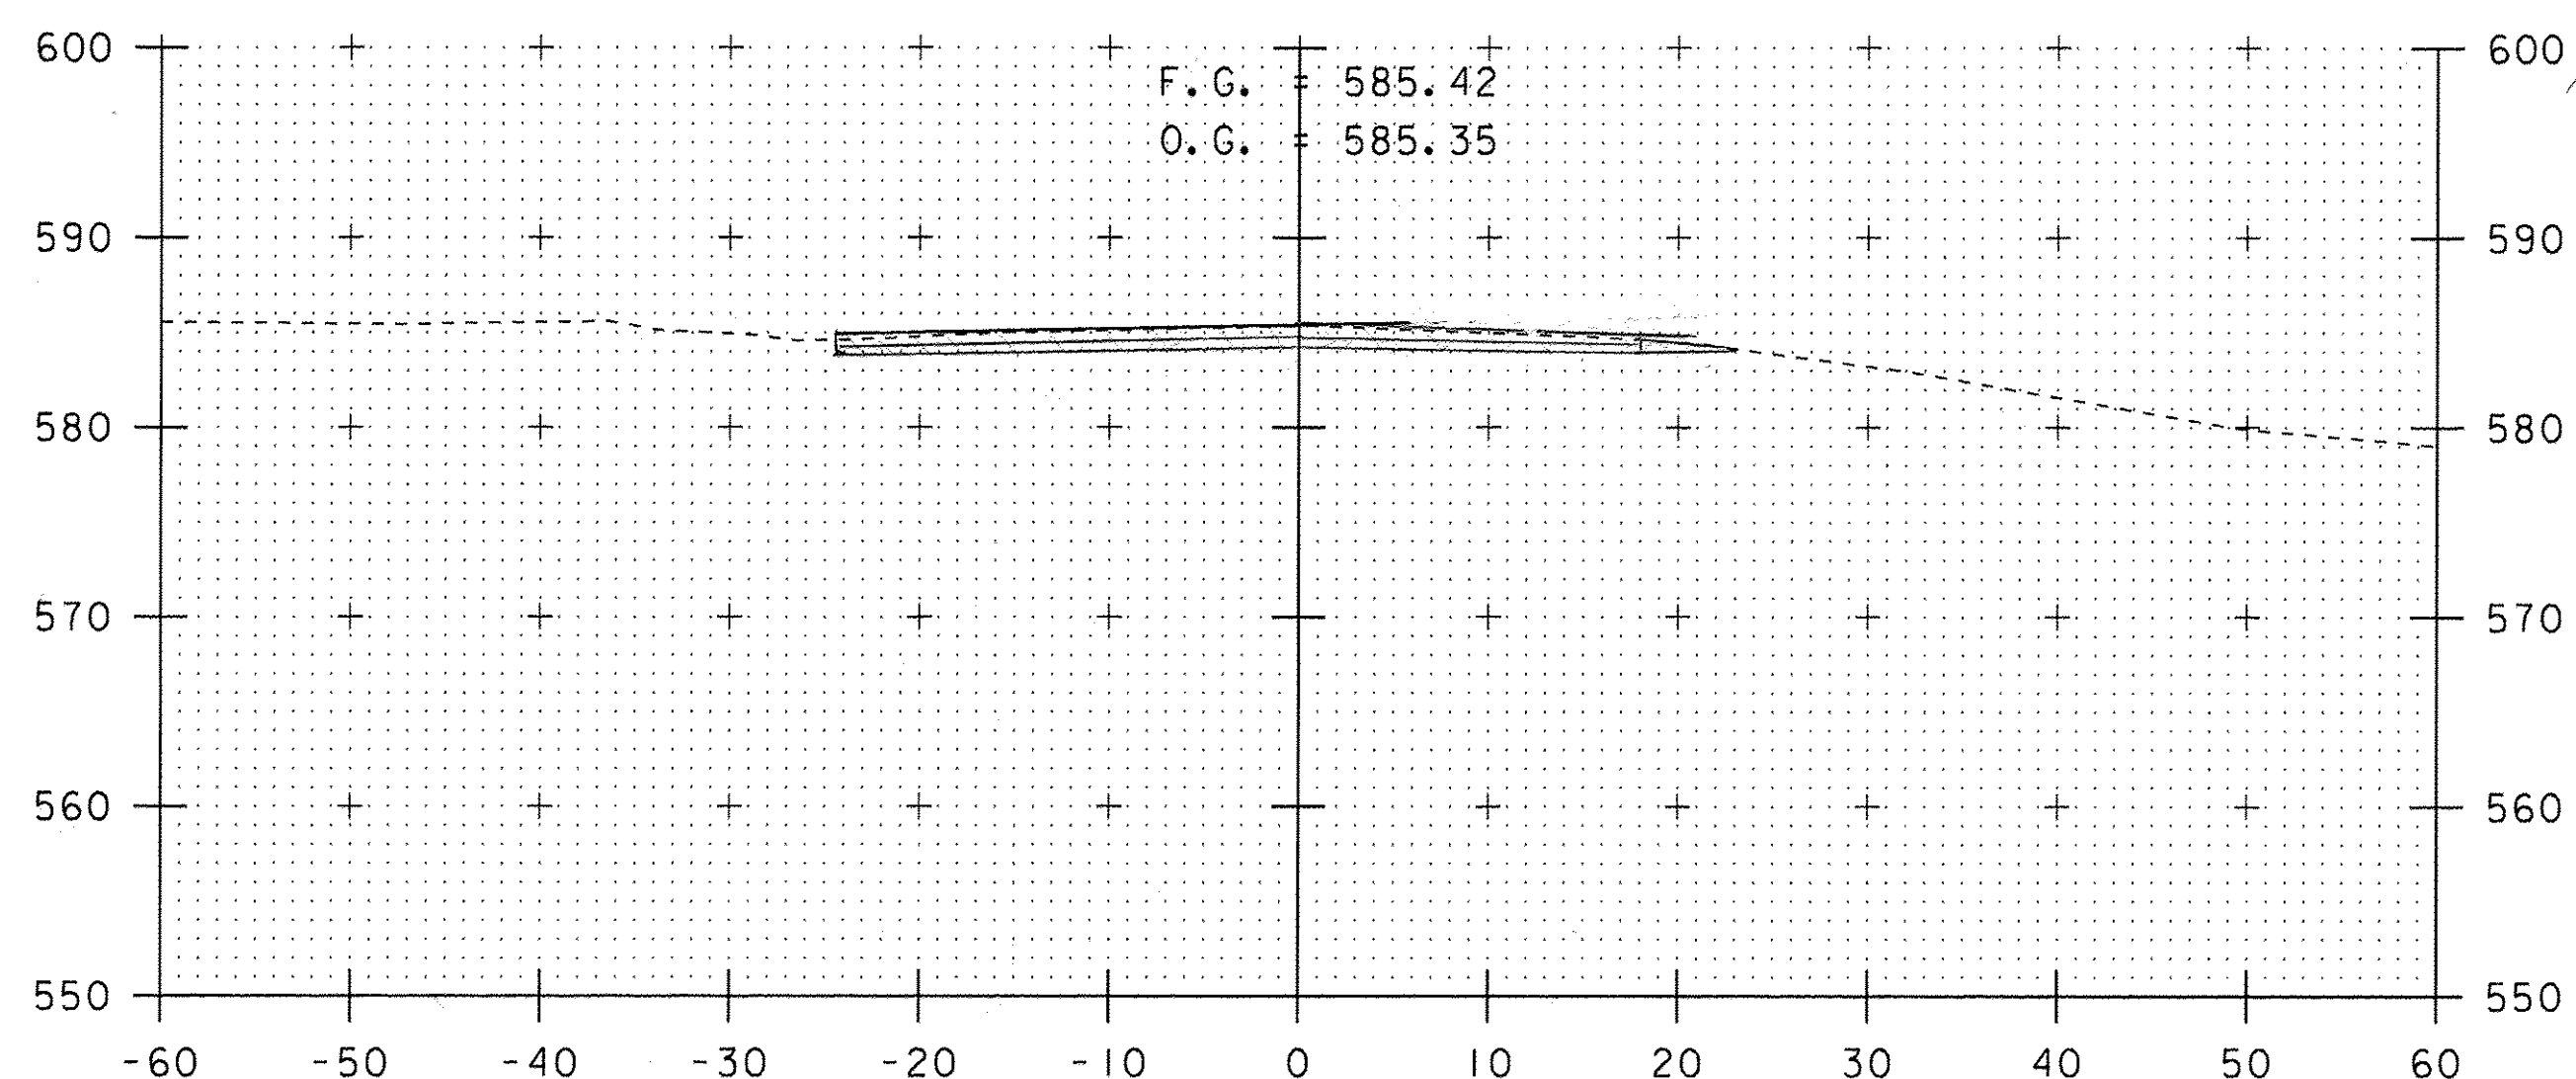

11+50 BEGIN SUBBASE

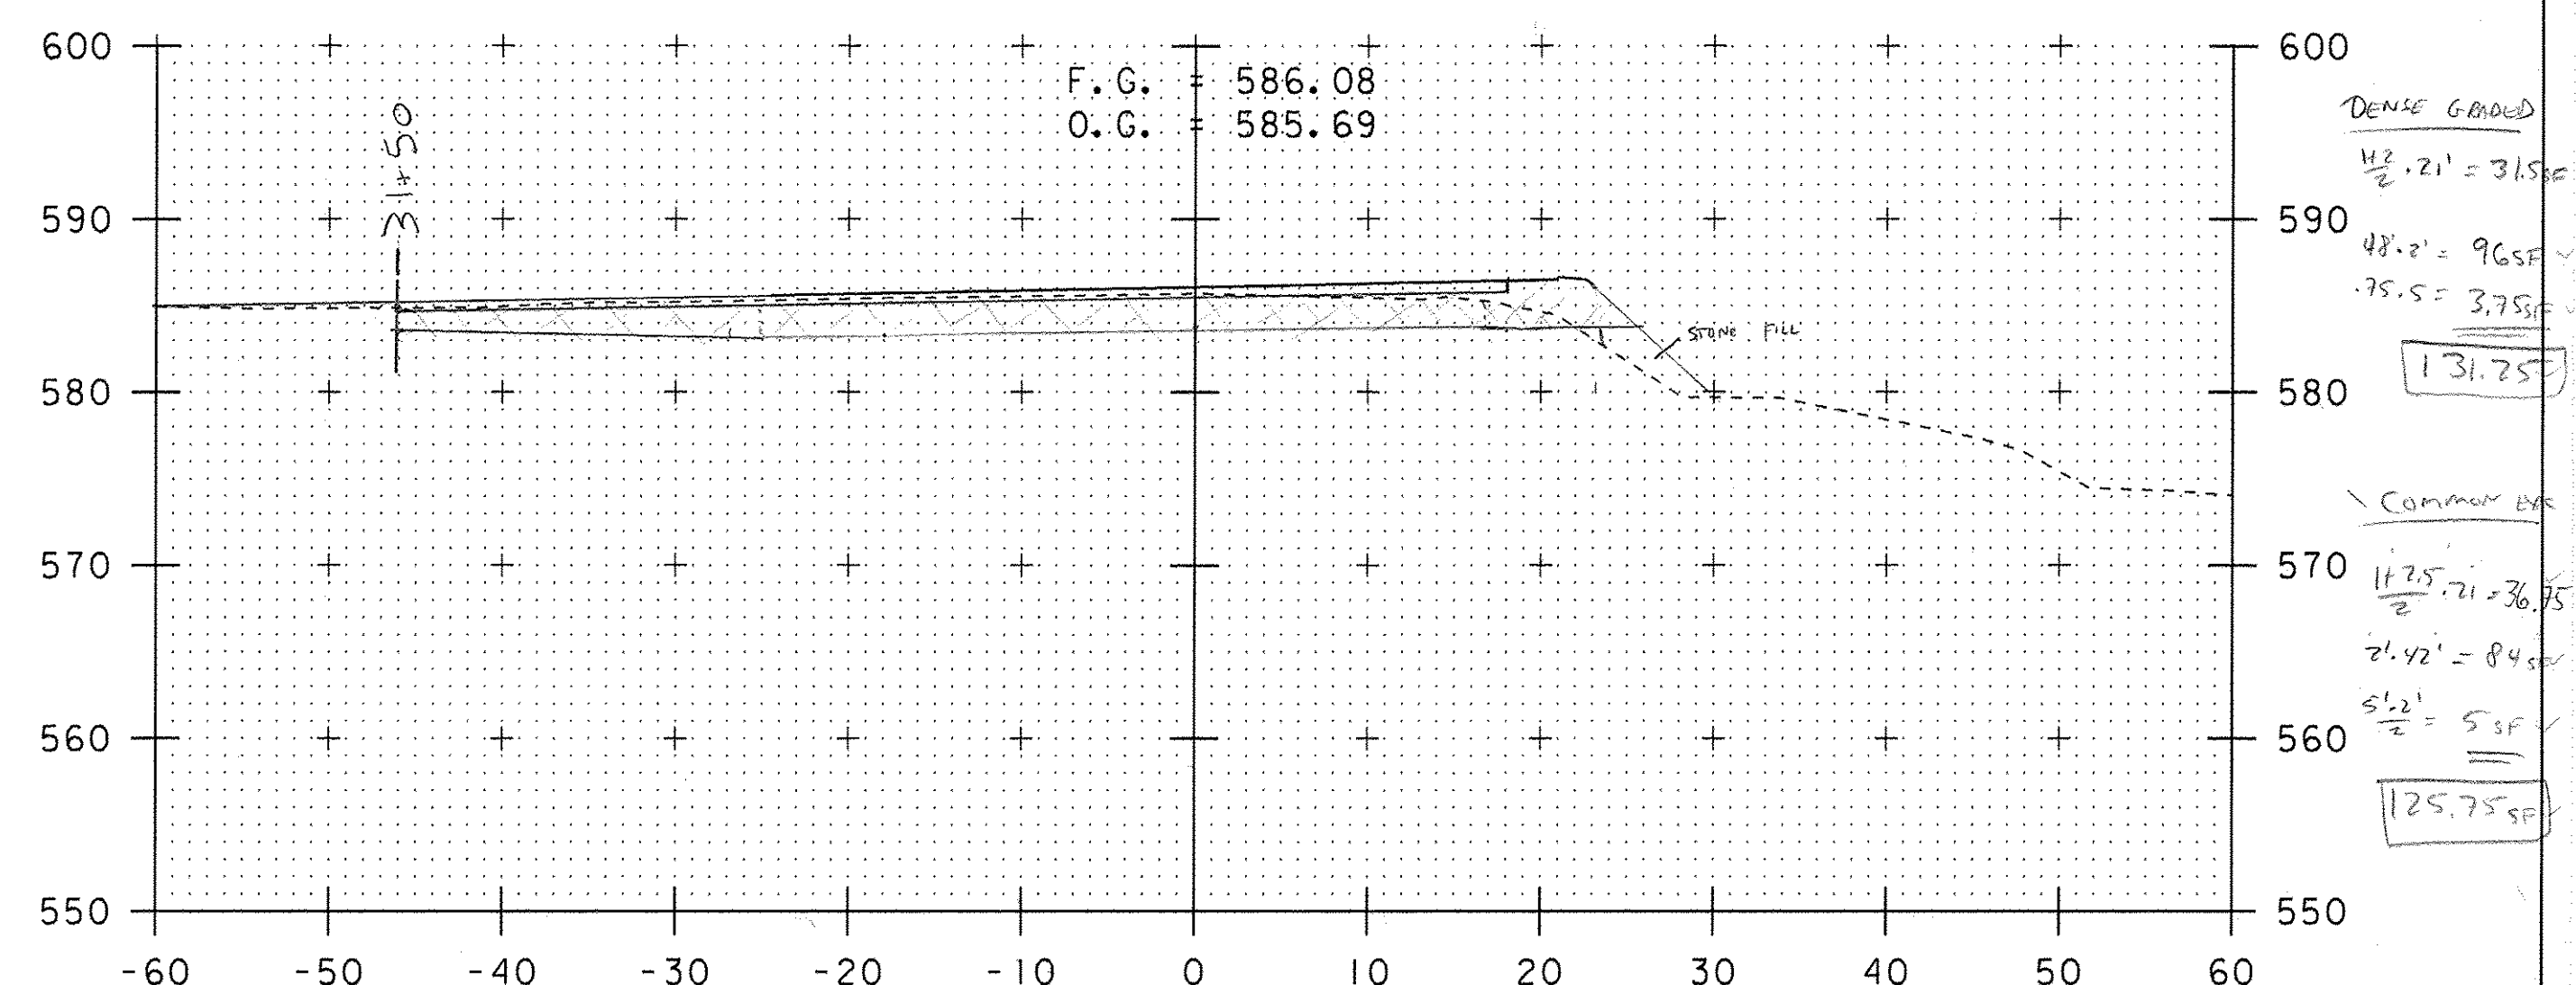

12+00

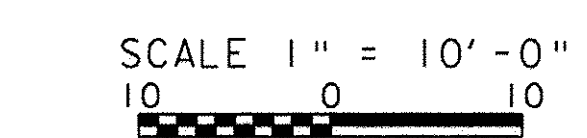

STA. 11+50 TO STA. 12+25

PROJECT NAME: CHESTER	
PROJECT NUMBER: BRF 025-I(37)	
FILE NAME: s95b168xsl.dgn	PLOT DATE: 13-JUN-2011
PROJECT LEADER: C.P.WILLIAMS	DRAWN BY: D.D.BEARD
DESIGNED BY: R.S.YOUNG	CHECKED BY: -----
CONSTRUCTION CROSS SECTIONS	SHEET 1 OF 1