


25+33 START OF AP SLAB


DENSE GRADED  
 BACK: 38' x 2.5' = 95'  
 4' x 3' = 12'  
 3' x 3.5' = 10.5'  
 2' x 1.5' = 3'  
 FRONT: 38' x 1.5' = 60.4'  
 4' x 3' = 12'  
 3' x 3.5' = 10.5'  
 2' x 1.5' = 3'  
 COMMON EXC:  
 45' x 3' = 135'

Planimetered by R.R.W.

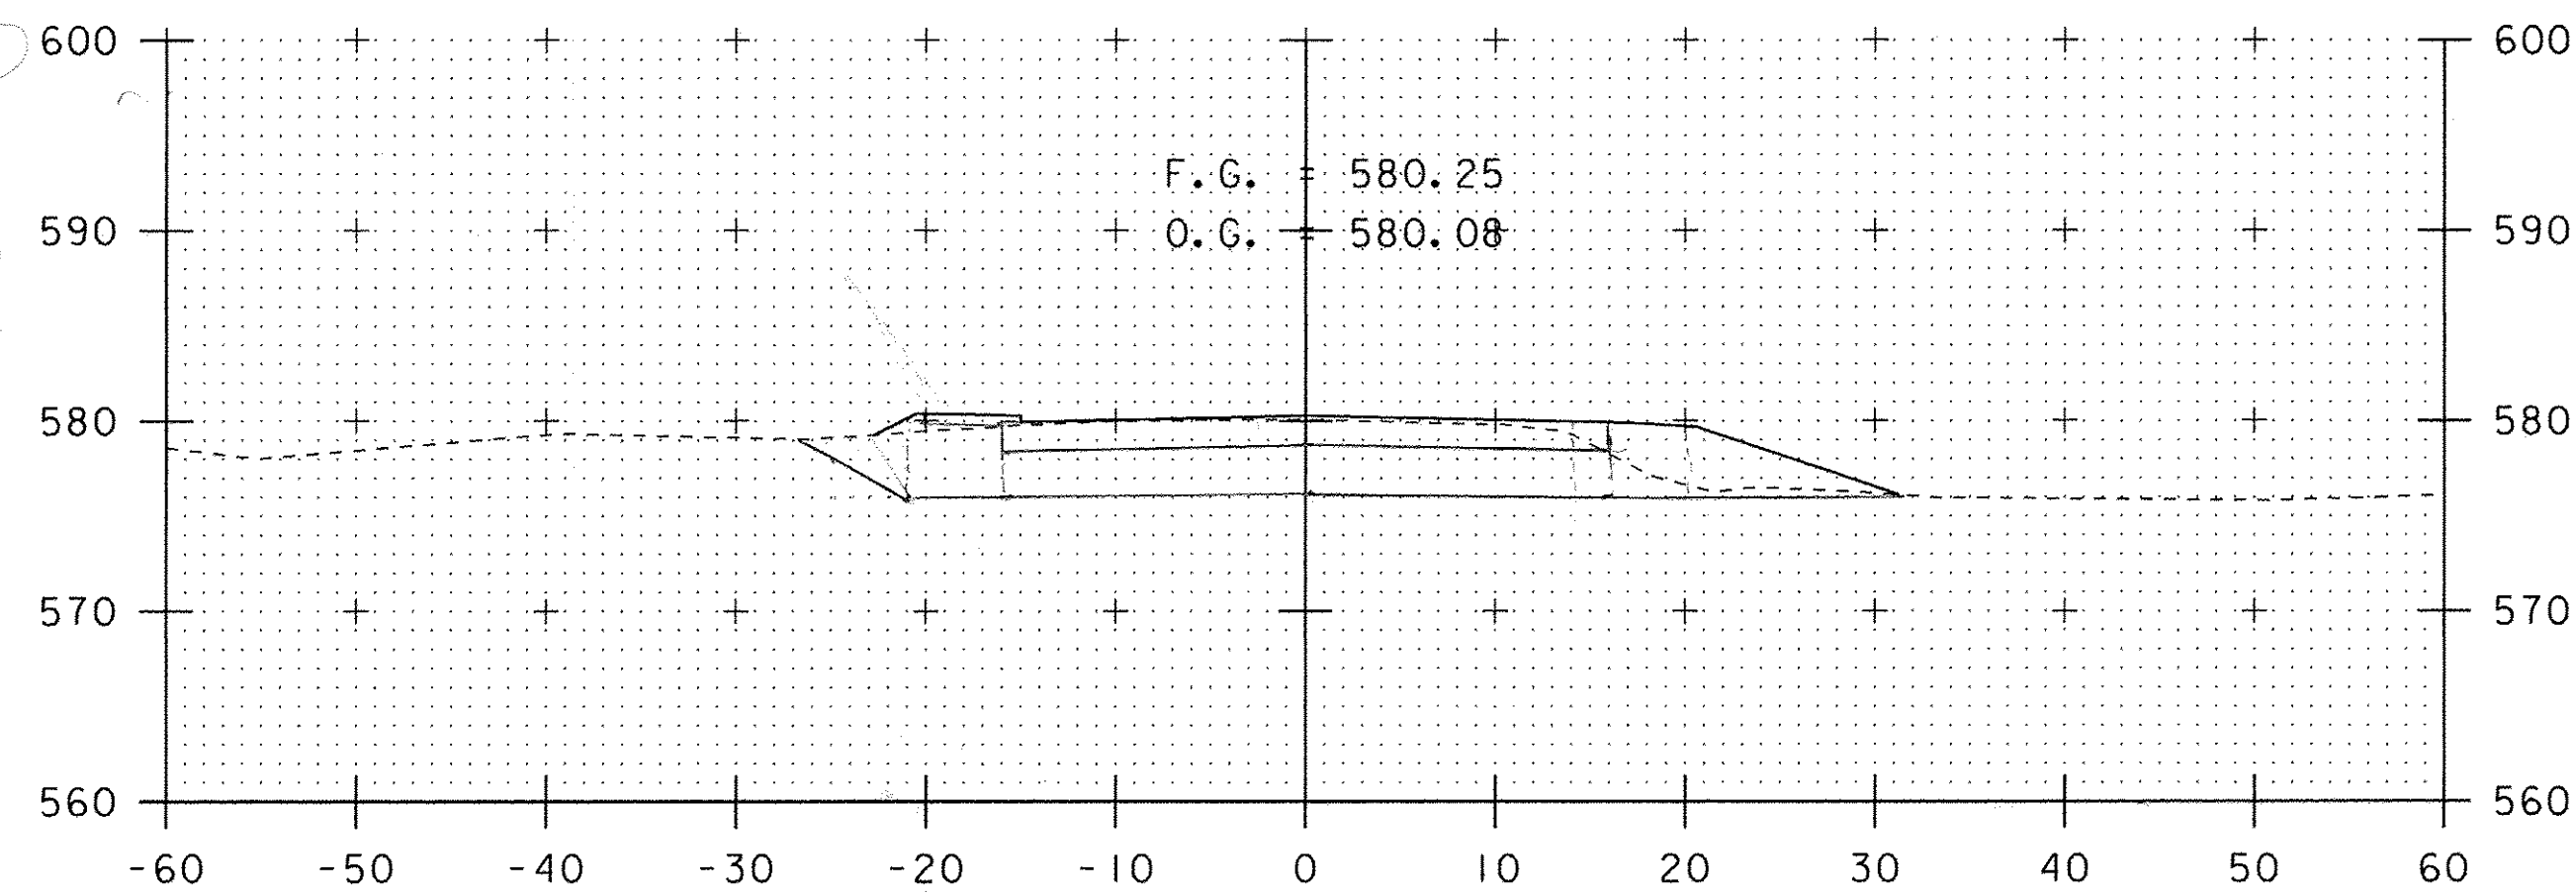


26+15

DENSE GRADED (ends @ 15')  
 2.5' x 32' = 80 ✓  
 5' x 4' = 20 ✓  
 3.5' x 1/2' = 10.5 ✓  
 4' x 4' = 16 ✓  
 4' x 10 1/2' = 20 ✓  
 COMMON EXC (starts @ 15')  
 35' x 4' = 140 ✓  
 6' x 3.5' x 1/2' = 10.5 ✓  
 4' x 3.5' = 14 ✓  
 3.5' x 1/2' = 7.5 ✓  
 172 ✓

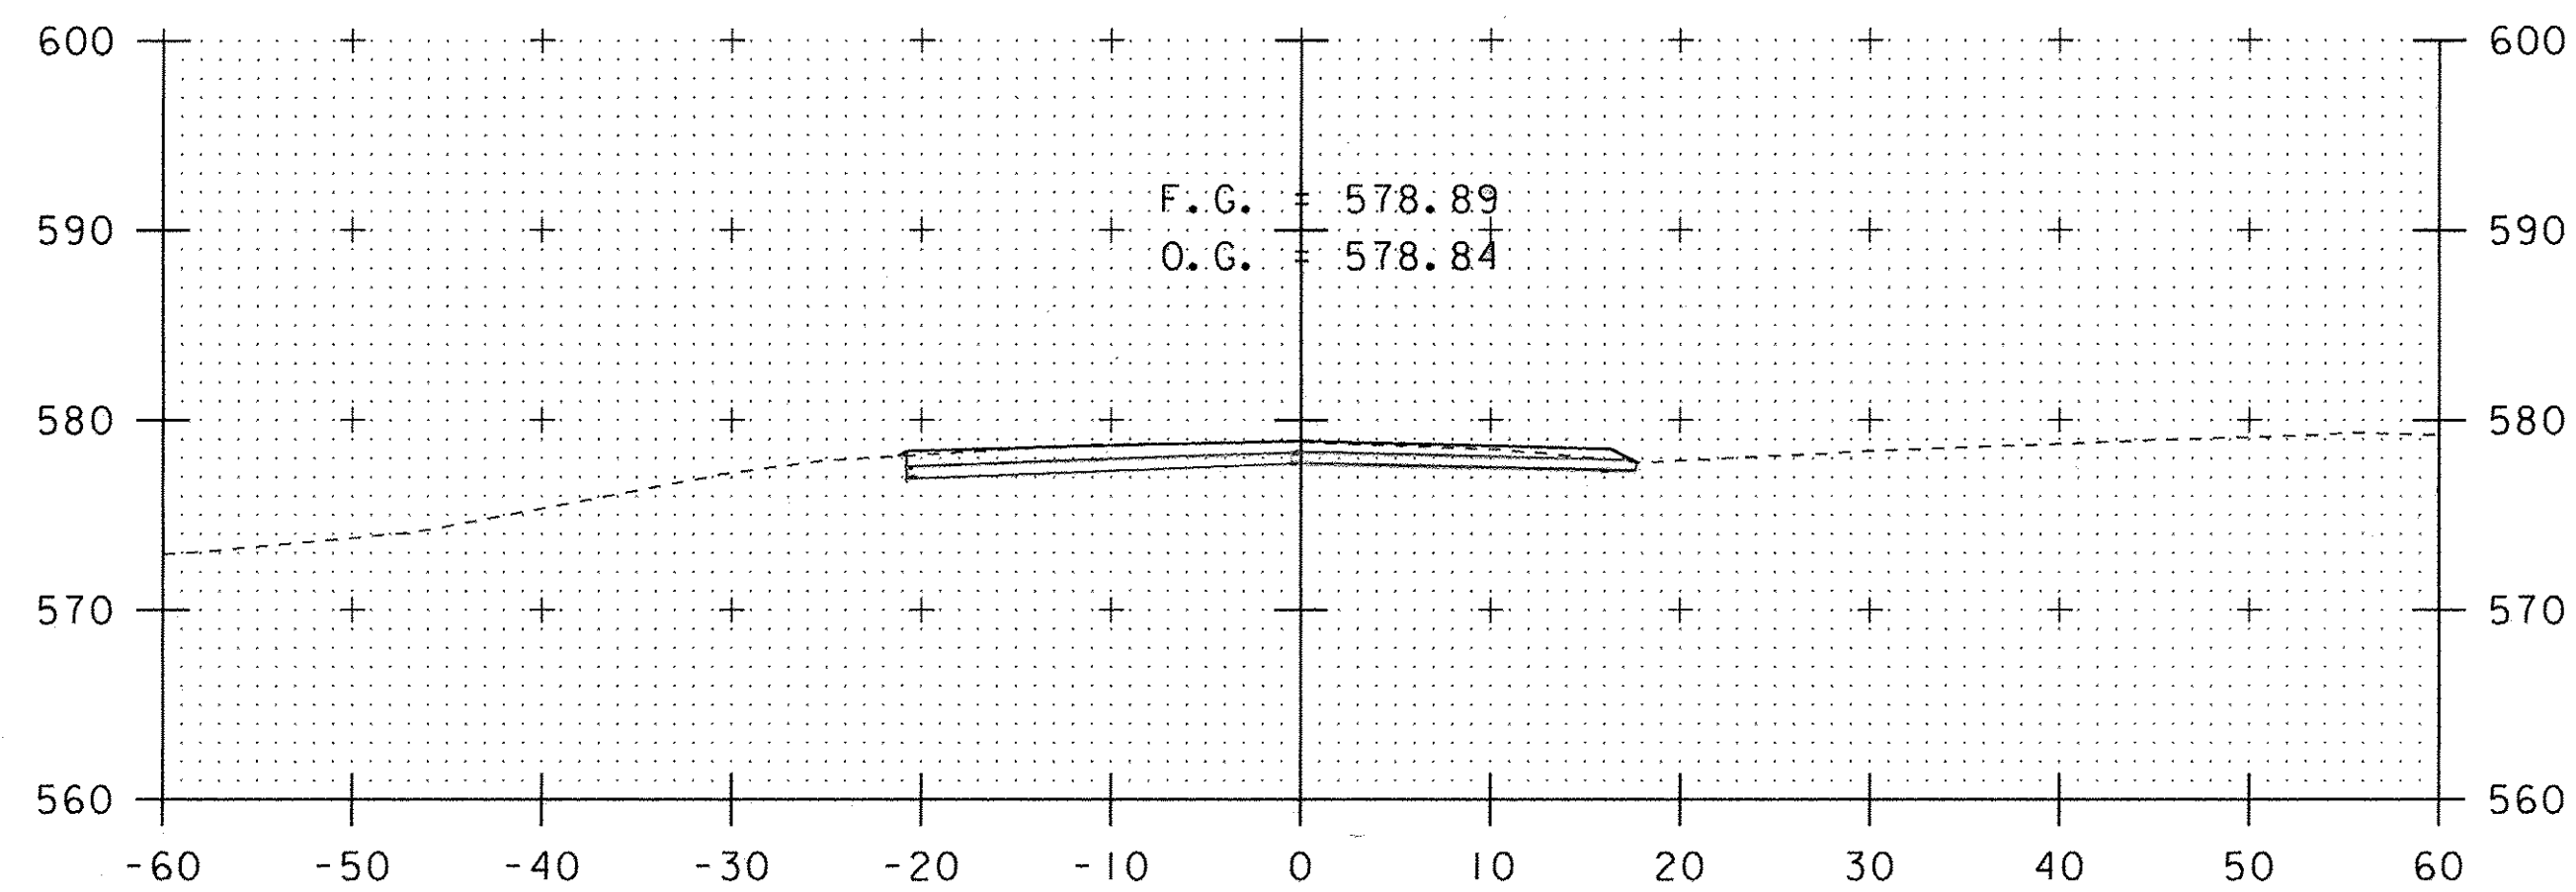

25+00

DENSE GRADED  
 .5' x 38.5' = 19.25 ✓  
 COMMON EXC:  
 1.125 x 21 = 23.6  
 1.115 x 5' x 17.5 = 14.22  
 37.8

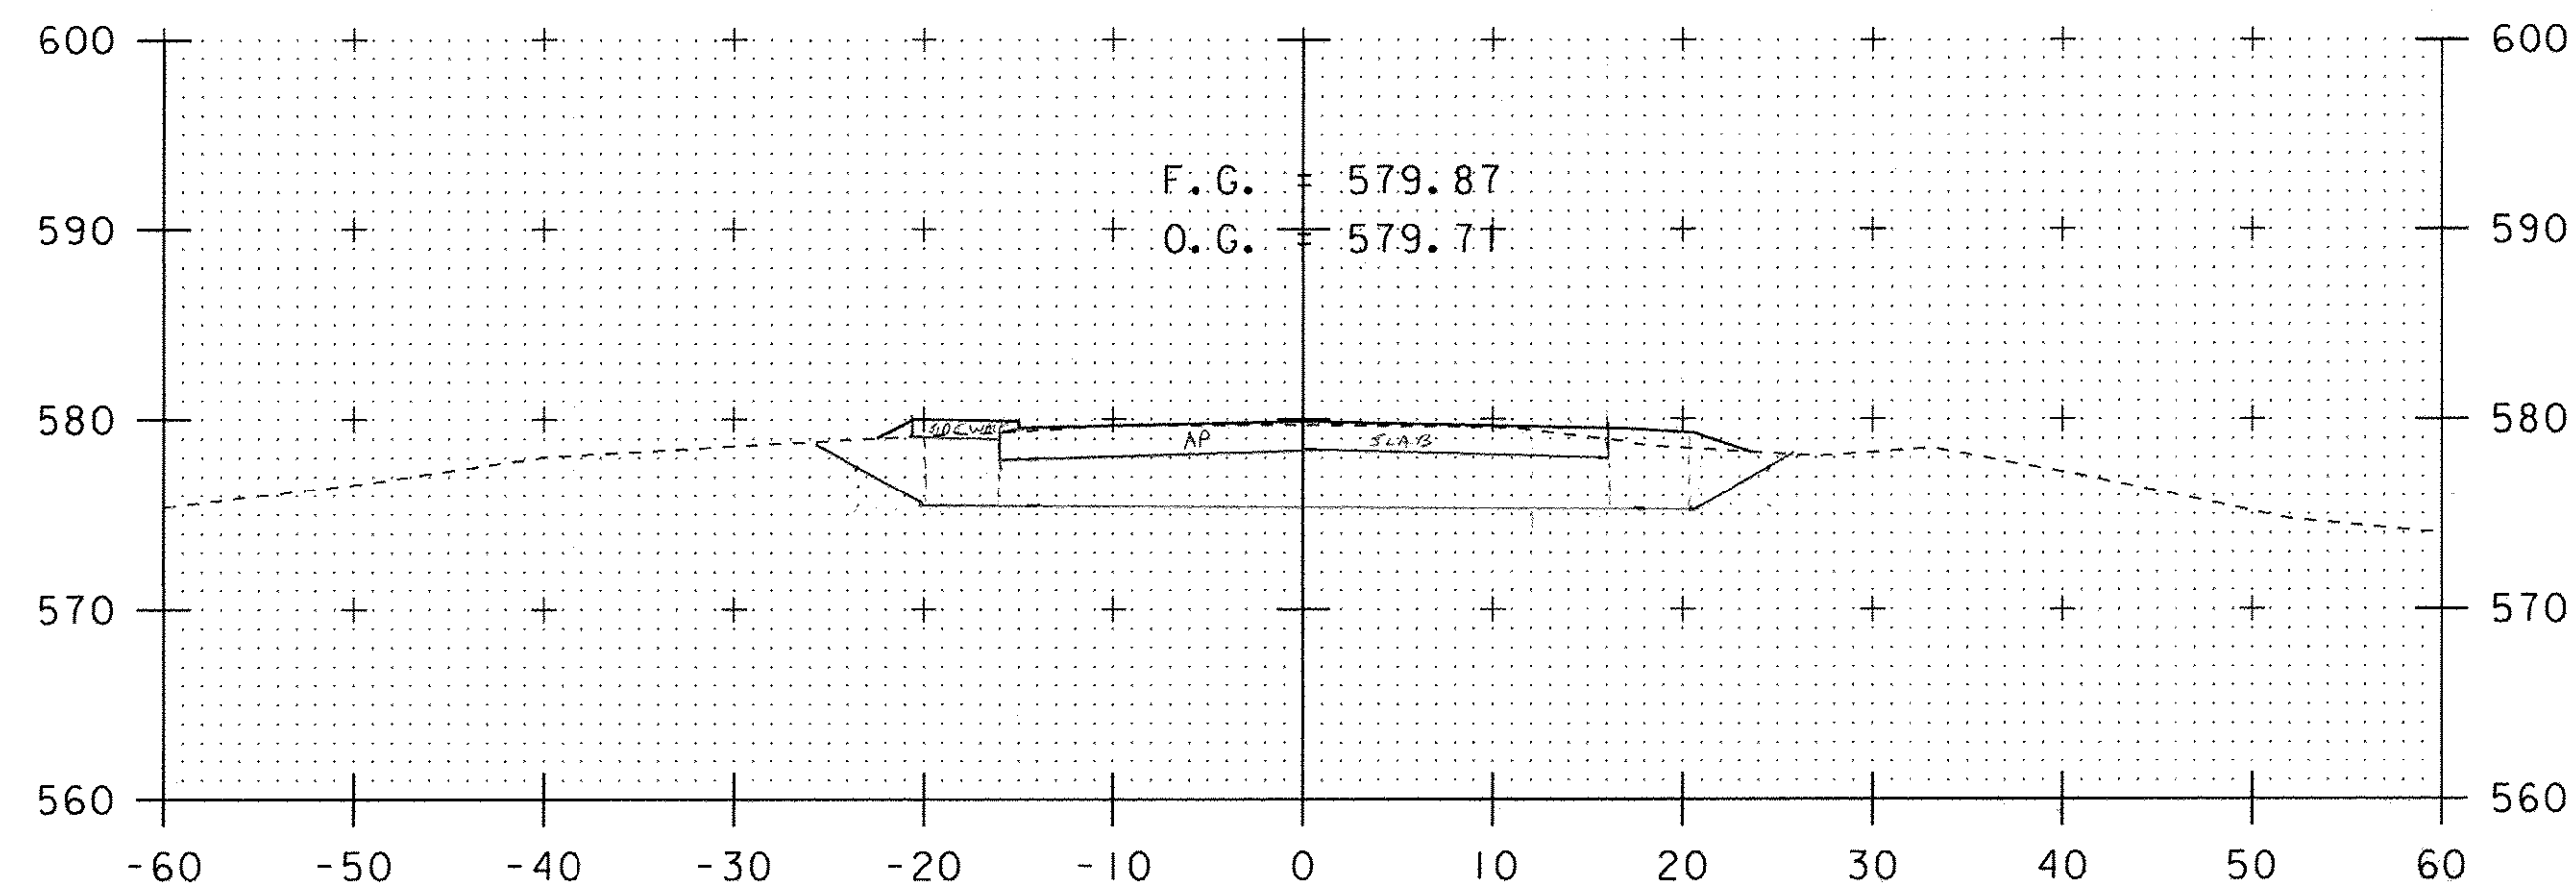

25+50 / 25+52

DENSE GRADED (ends @ 52)  
 32' x 2.5' = 80 ✓  
 4' x 3.5' = 14 ✓  
 4' x 4' = 16 ✓  
 4' x 1/2' = 10 ✓  
 6' x 3' x 1/2' = 9 ✓  
 COMMON EXC (ends @ 52)  
 4' x 32' = 128 ✓  
 6' x 3' x 1/2' = 9 ✓  
 4' x 1/2' x 8 = 28 ✓  
 3.5' x 1/2' = 7.5 ✓  
 172.5 ✓  
 100

PROJECT NAME: CHESTER  
 PROJECT NUMBER: BRF 025-1(28)  
 FILE NAME: s84e061/Str/xsl.dgn  
 PROJECT LEADER: C.P.WILLIAMS  
 DESIGNED BY: R.S.YOUNG  
 CONST BR 8 MAINLINE CROSS SECTIONS I  
 PLOT DATE: 23-JUN-2011  
 DRAWN BY: D.D.BEARD  
 CHECKED BY: R.S.YOUNG  
 SHEET 1 OF 1

