


④ BAW-01 REINF. LAYOUT PLAN
SCALE: 3/8" = 1'-0"

- GENERAL NOTES:**
1. SEE PLAN SHEETS 1, 2, & 3 FOR PLAN AND DETAILS.
 2. ALL ABUTMENT PILE CAPS ARE LABELED AS FOLLOWS: PRODUCT TYPE-IDENTIFICATION NUMBER-SEQUENCE NUMBER.
 3. MARK BAW-01 "NORTH END", FOLLOWED BY THE CORRESPONDING BEAM LABEL.
 4. FABRICATOR IS TO MARK ABUTMENT CAP END WITHIN CLOSE PROXIMITY TO THE NOTED END.
 5. LIGHT SANDBLAST MATCH-CAST END PRIOR TO SHIPMENT TO REMOVE ANY FORM OIL, GREASE, LANTANCE, ETC.
 6. SEE SHEET 1 FOR SLEEVE LOCATIONS. 4" SLEEVES ARE LOCATION CRITICAL.

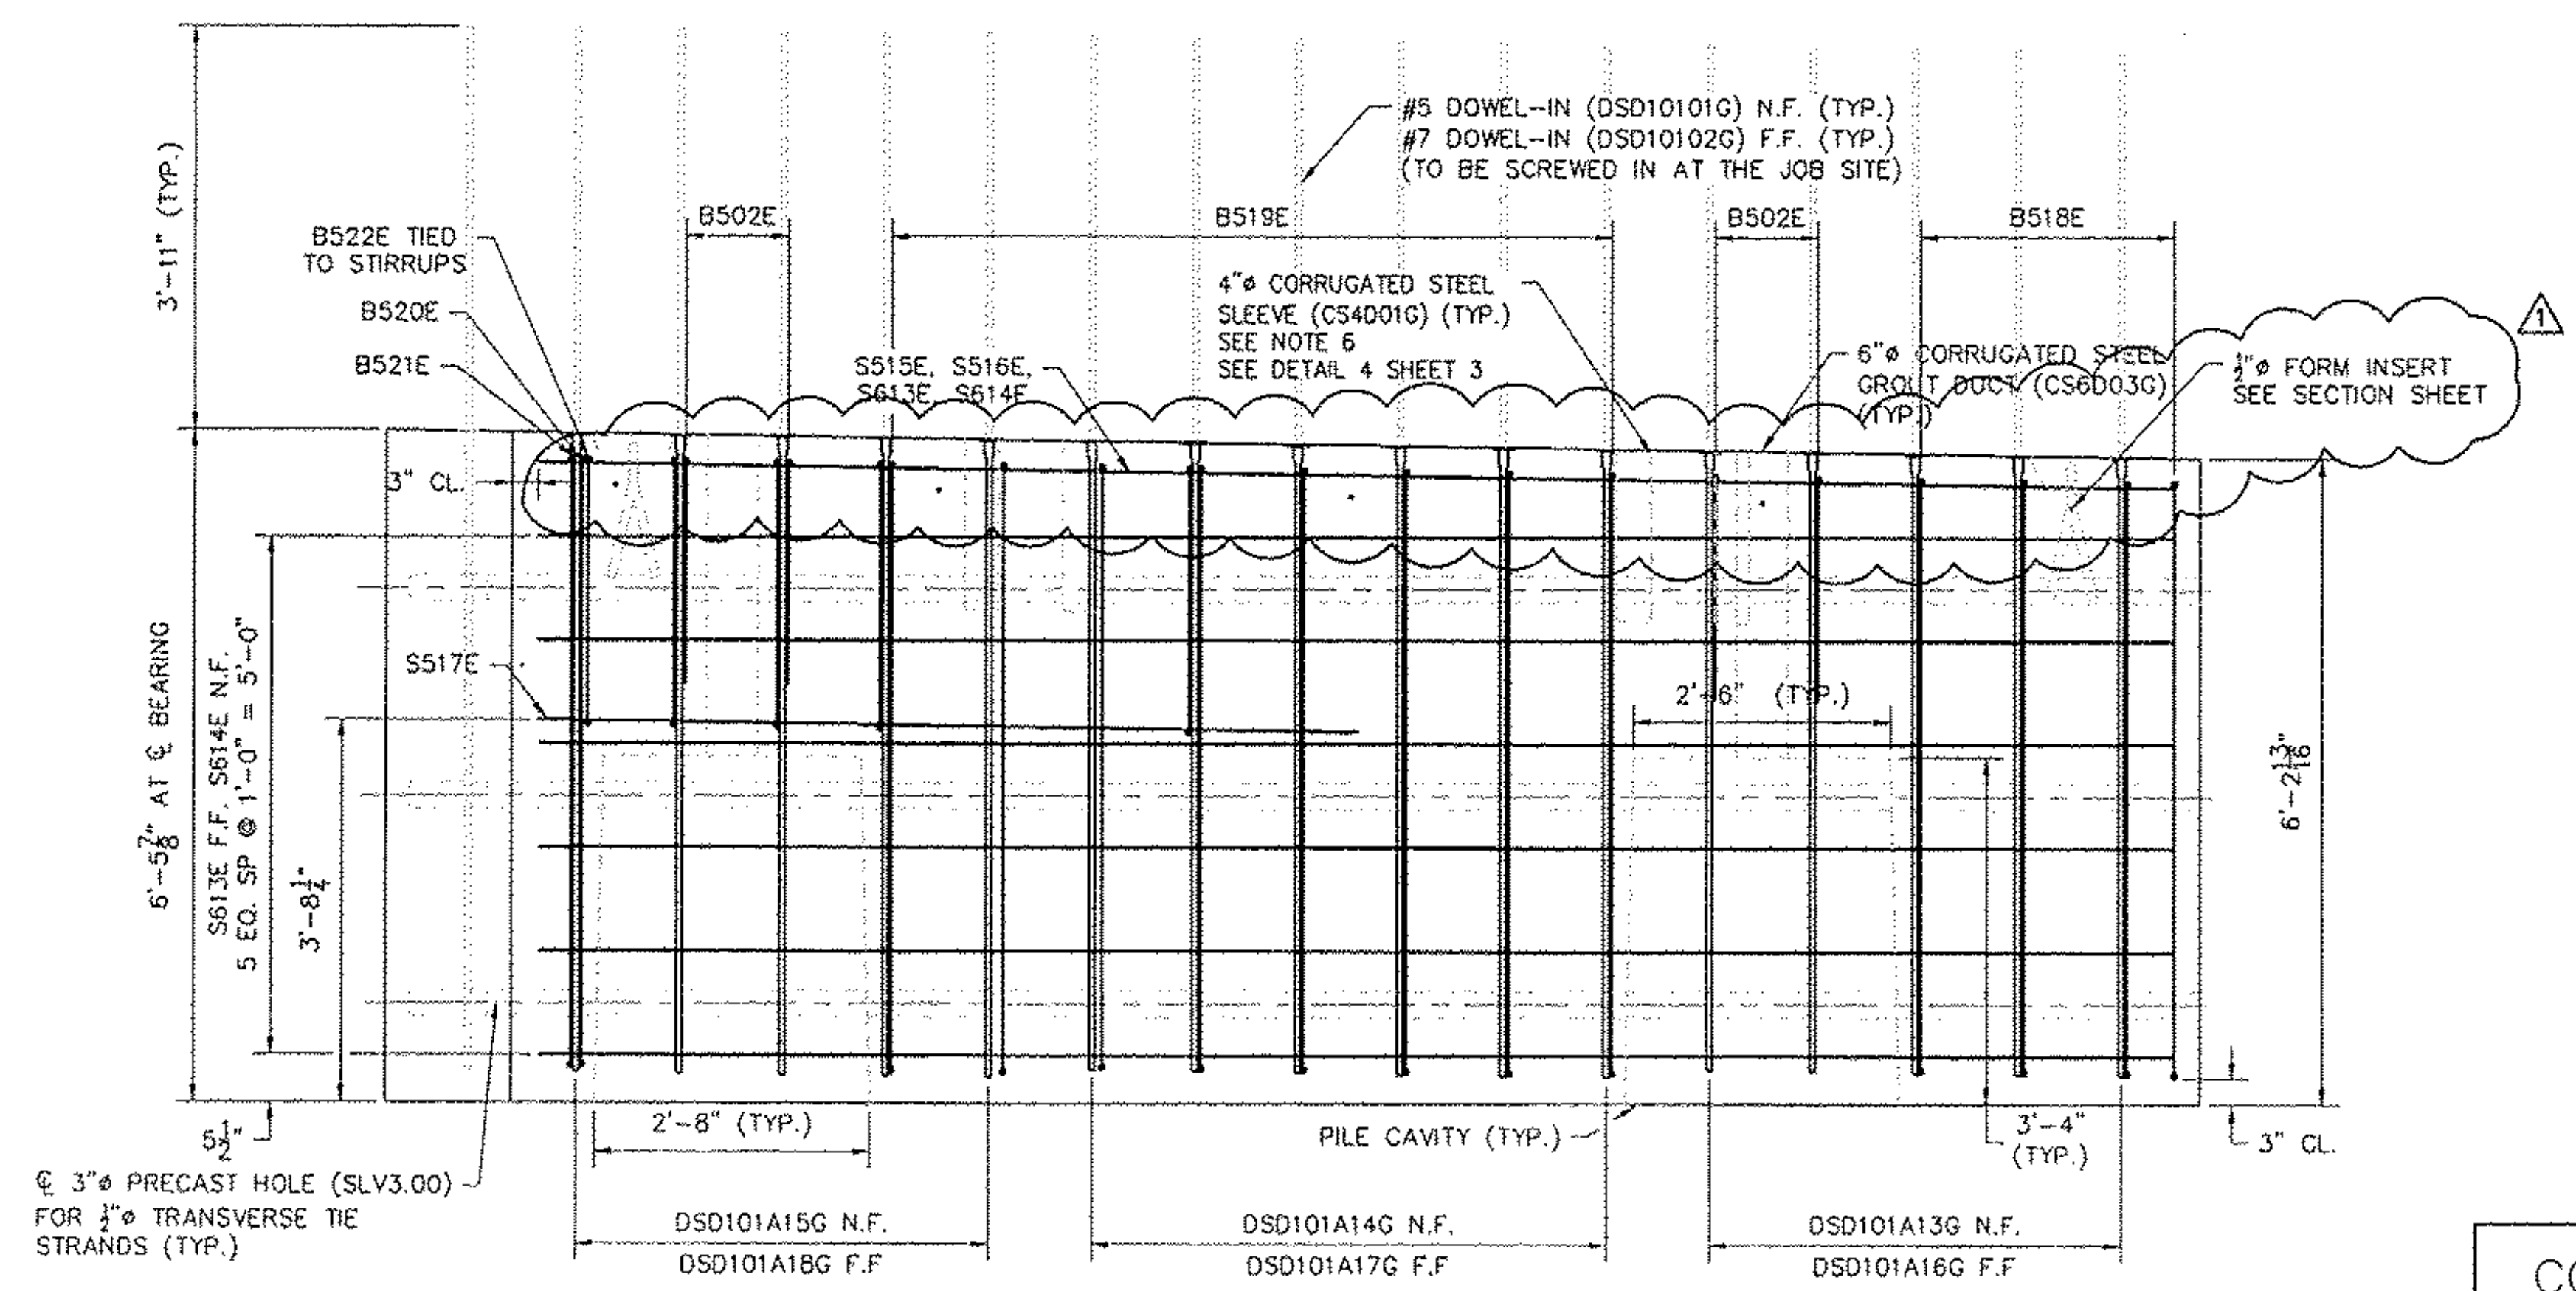

⑤ BAW-01 SECTION D - ELEVATION
SCALE: 3/8" = 1'-0"

RECEIVED
OK'D BY LSS OK'D BY RSY
MAR 11 2011
RESUBMIT _____ APPROVED
BY CPW DATE 3/28/11

REVISION NO.	REVISION DATE
1	MARCH 09, 2011

Hoyle, Tanner & Associates, Inc.
125 College Street, 4th Floor Burlington, VT 05401
Tel (802)860-1331 • Fax (802)860-6490 • www.hoyletanner.com
© Copyright 2011 Hoyle, Tanner & Associates, Inc.

DRAWN BY: APN DATE: FEBRUARY 2011
CHECKED BY: CHS PROJECT NO: 122435.00

PRECAST CONCRETE PRODUCTS
1811 (802) 442-1418 FAX: (802) 442-4719

CHESTER, VT
VT 103
BRIDGE #9
PROJECT NO.: BRF 025-1 (37)
SHEET 4 OF 15

CONSTRUCTION SET
FEBRUARY 18, 2011