




PLAN VIEW - MK# S9-1

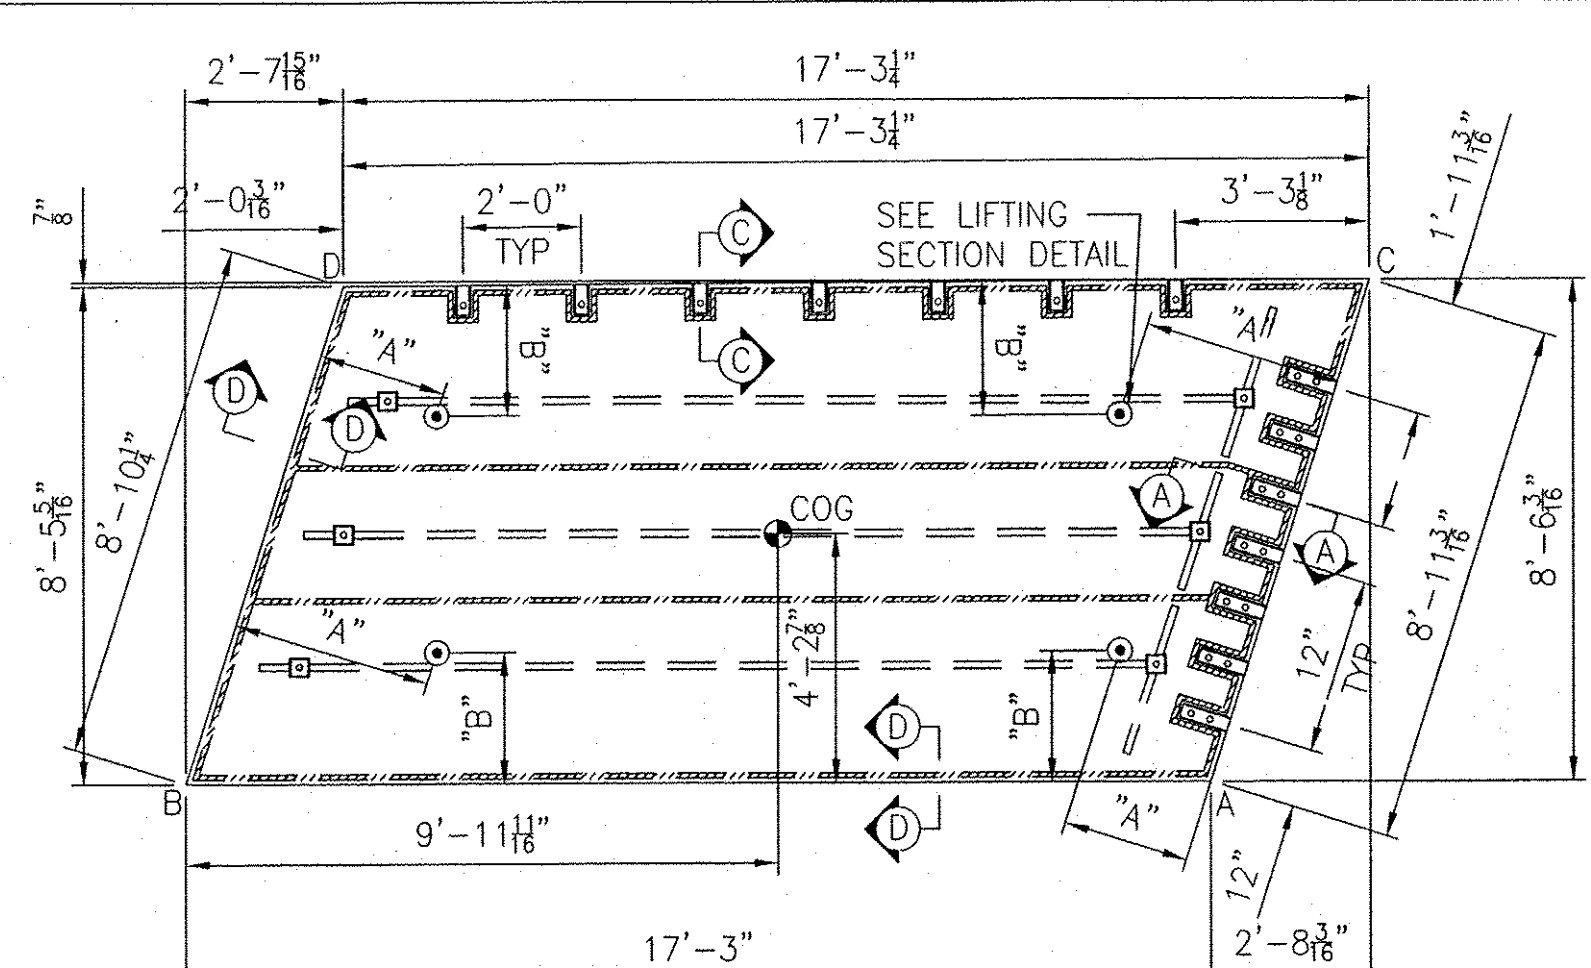


PLAN VIEW - MK# S9-4

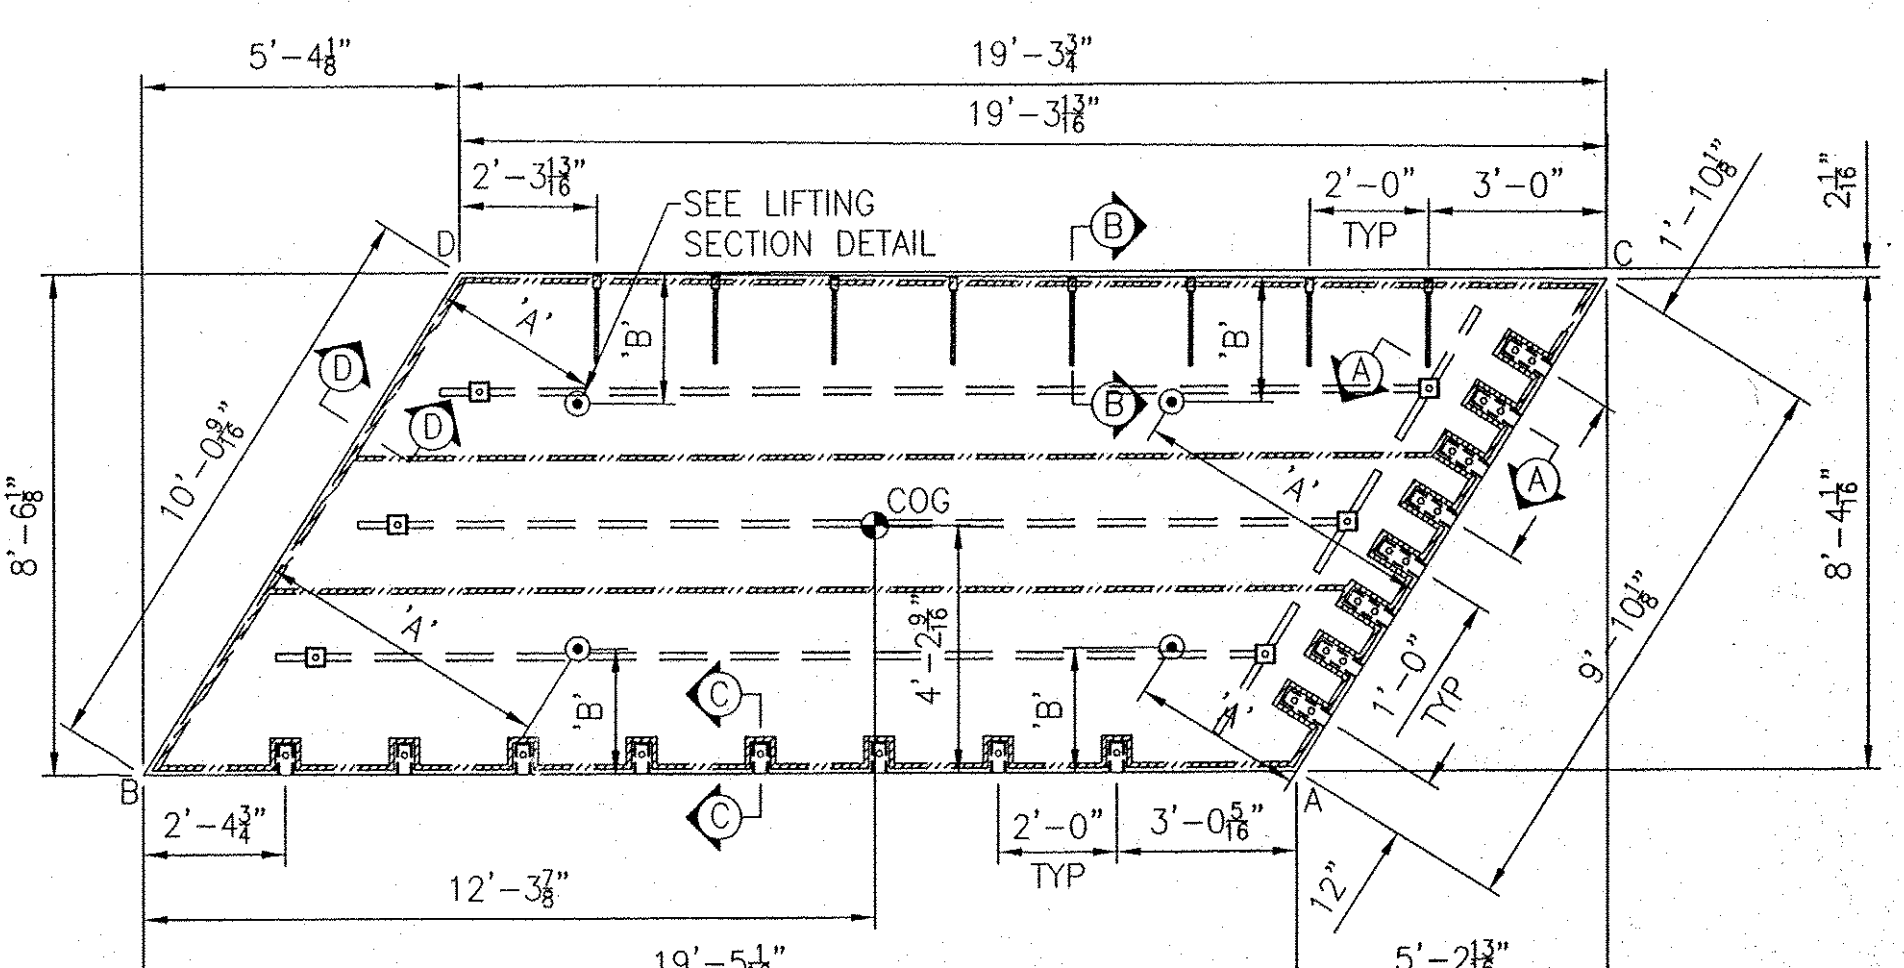


PLAN VIEW - MK# S9-7

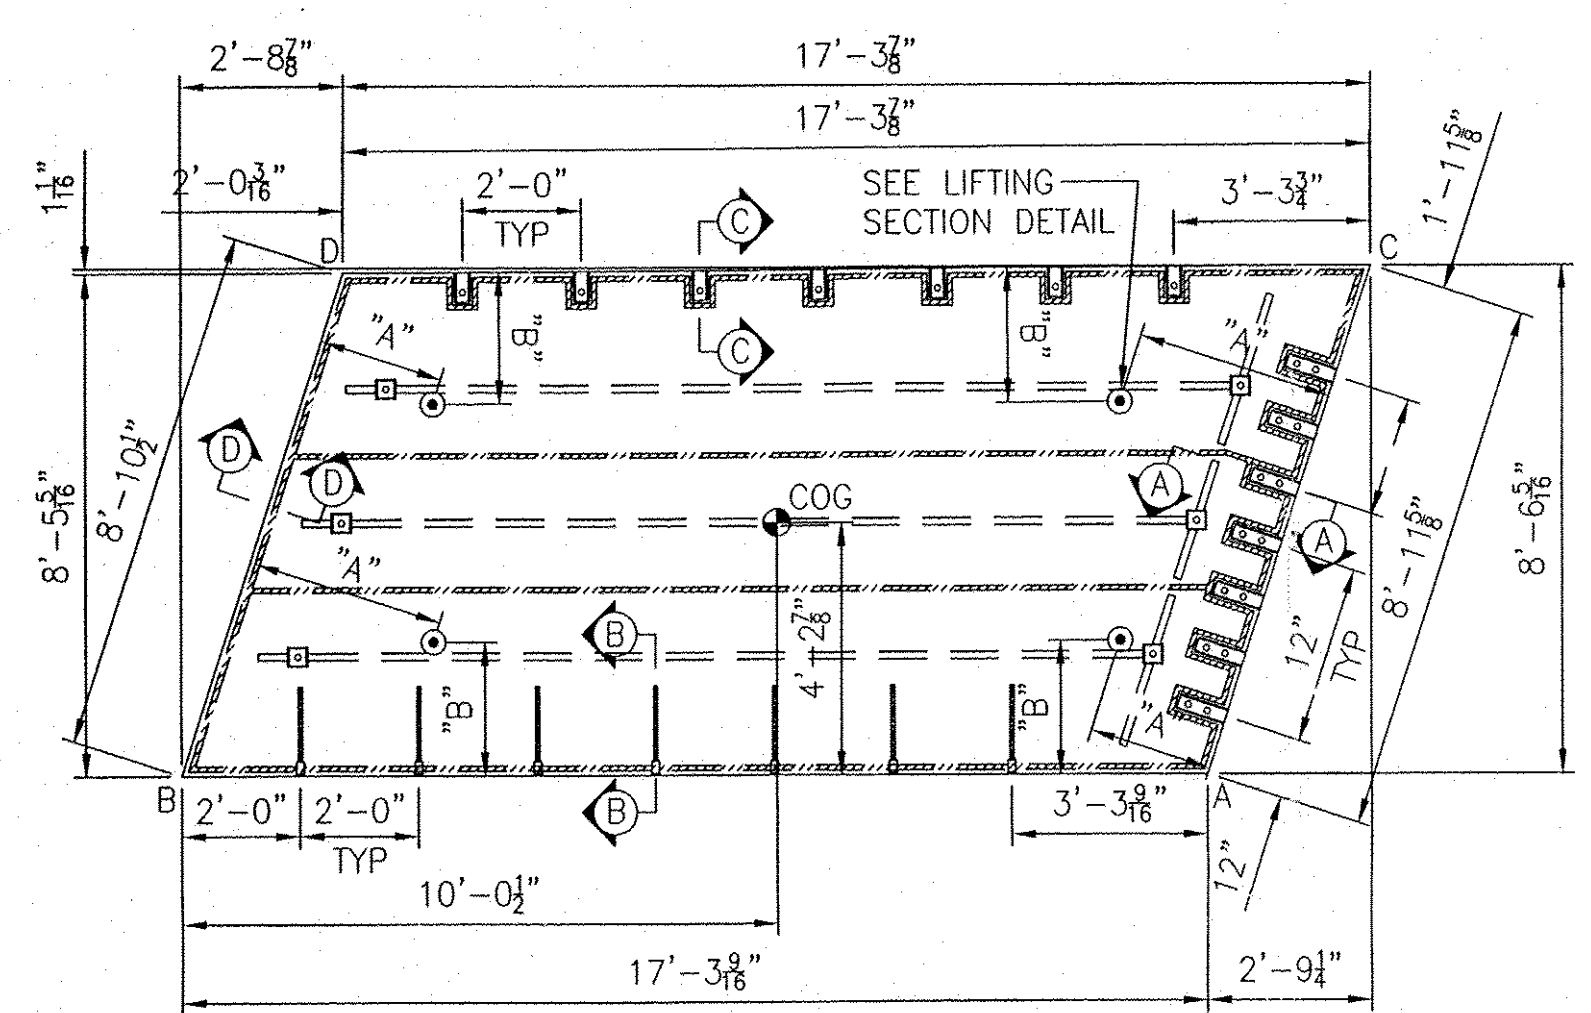


PLAN VIEW - MK# S9-2

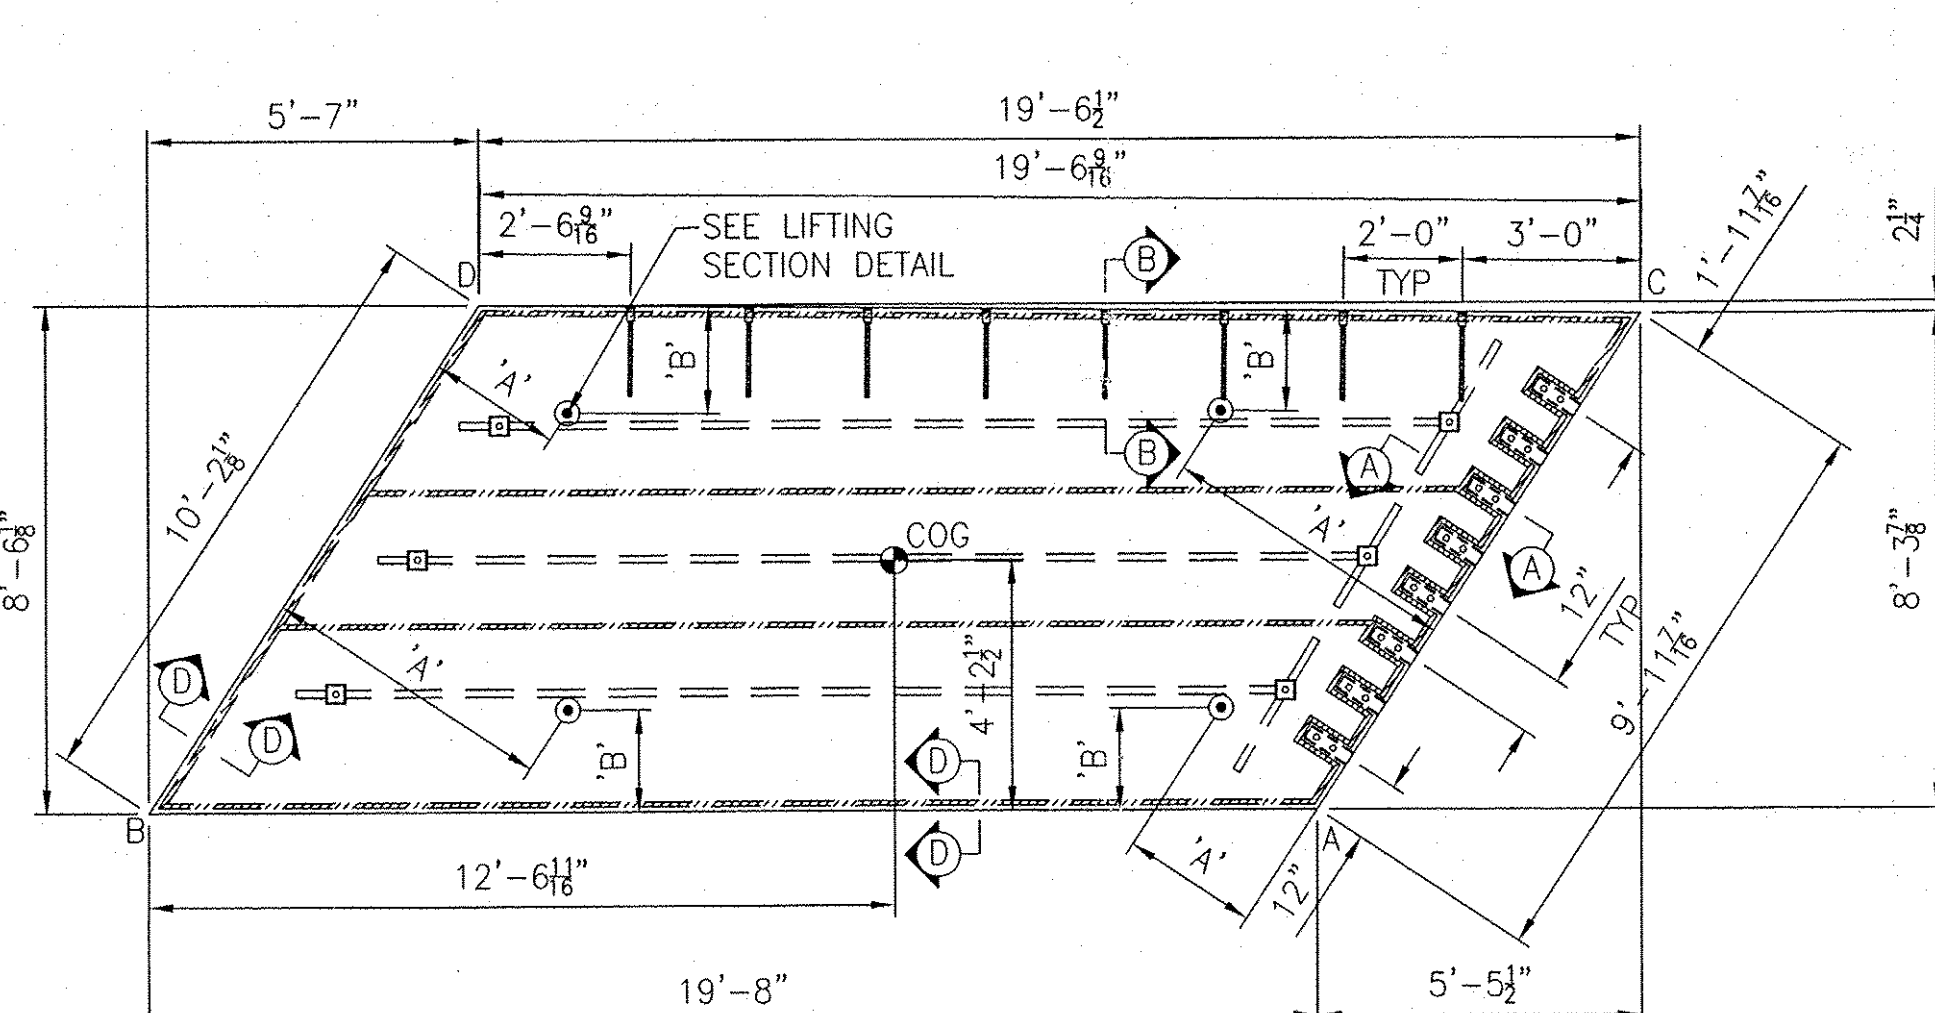


PLAN VIEW - MK# S9-5

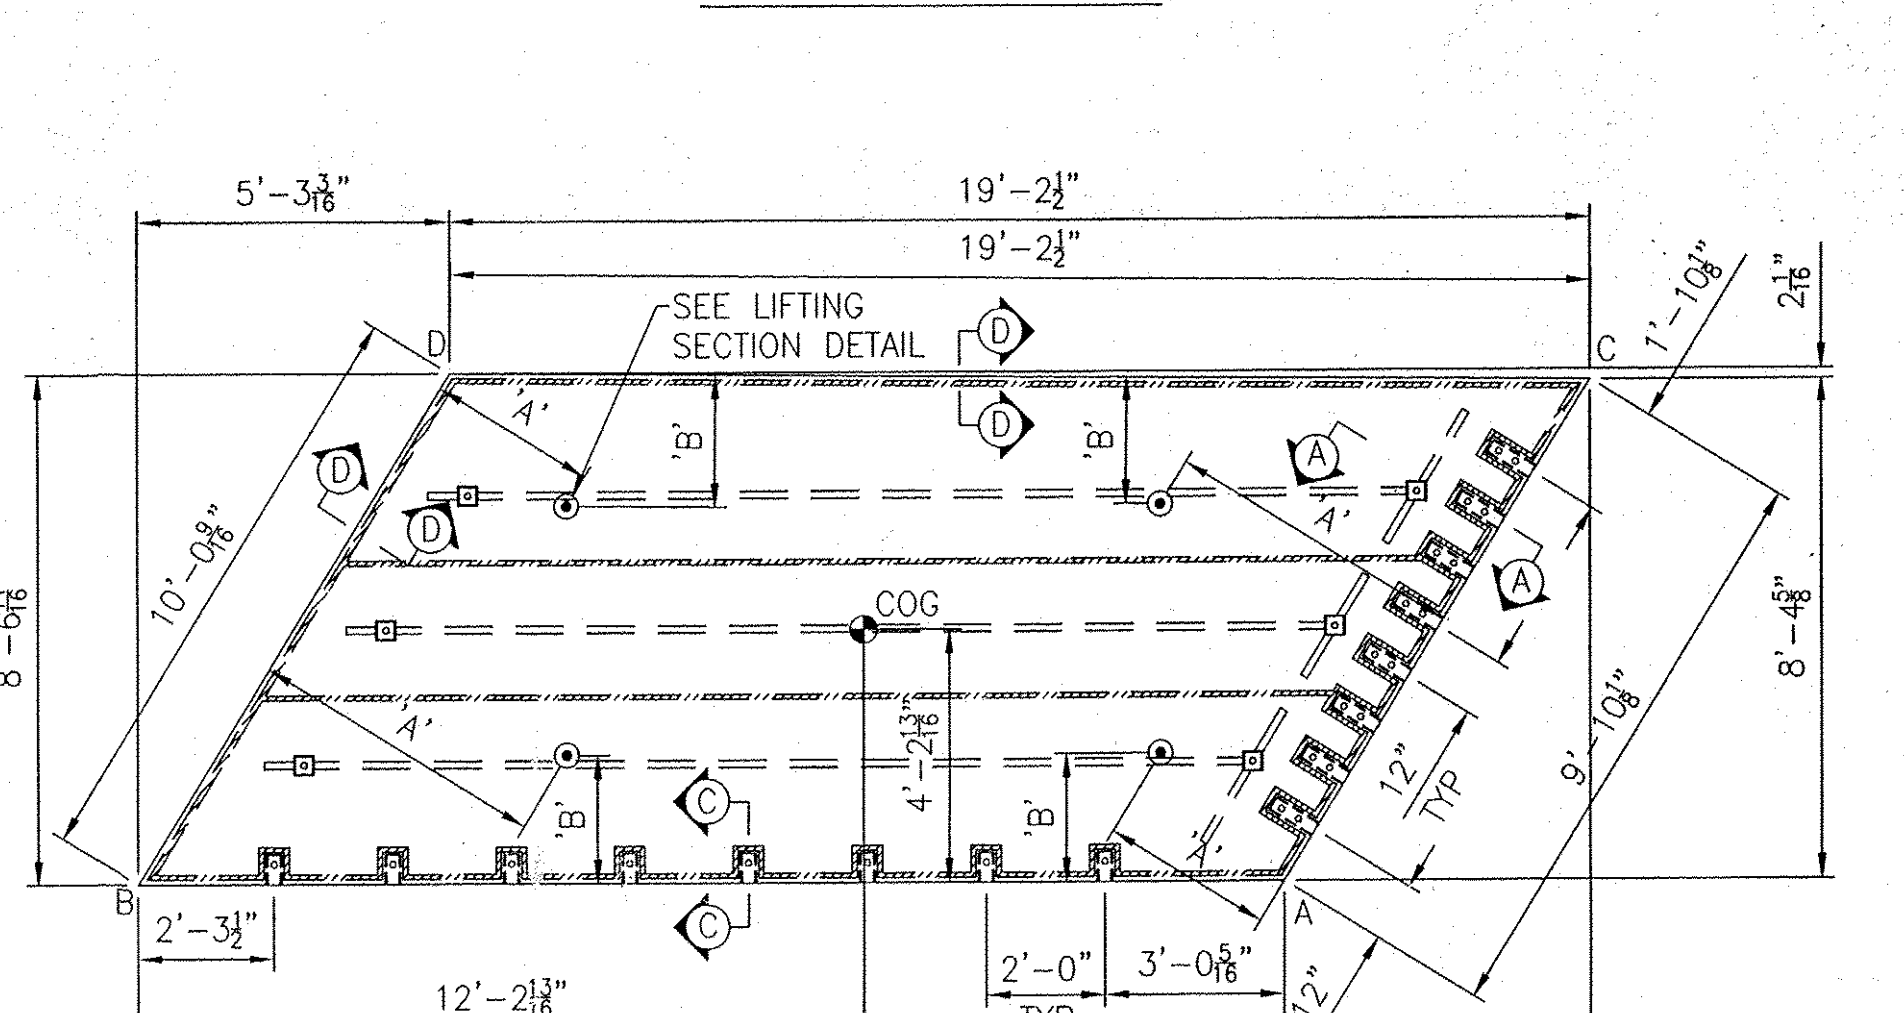

PLAN VIEW - MK# S9-8

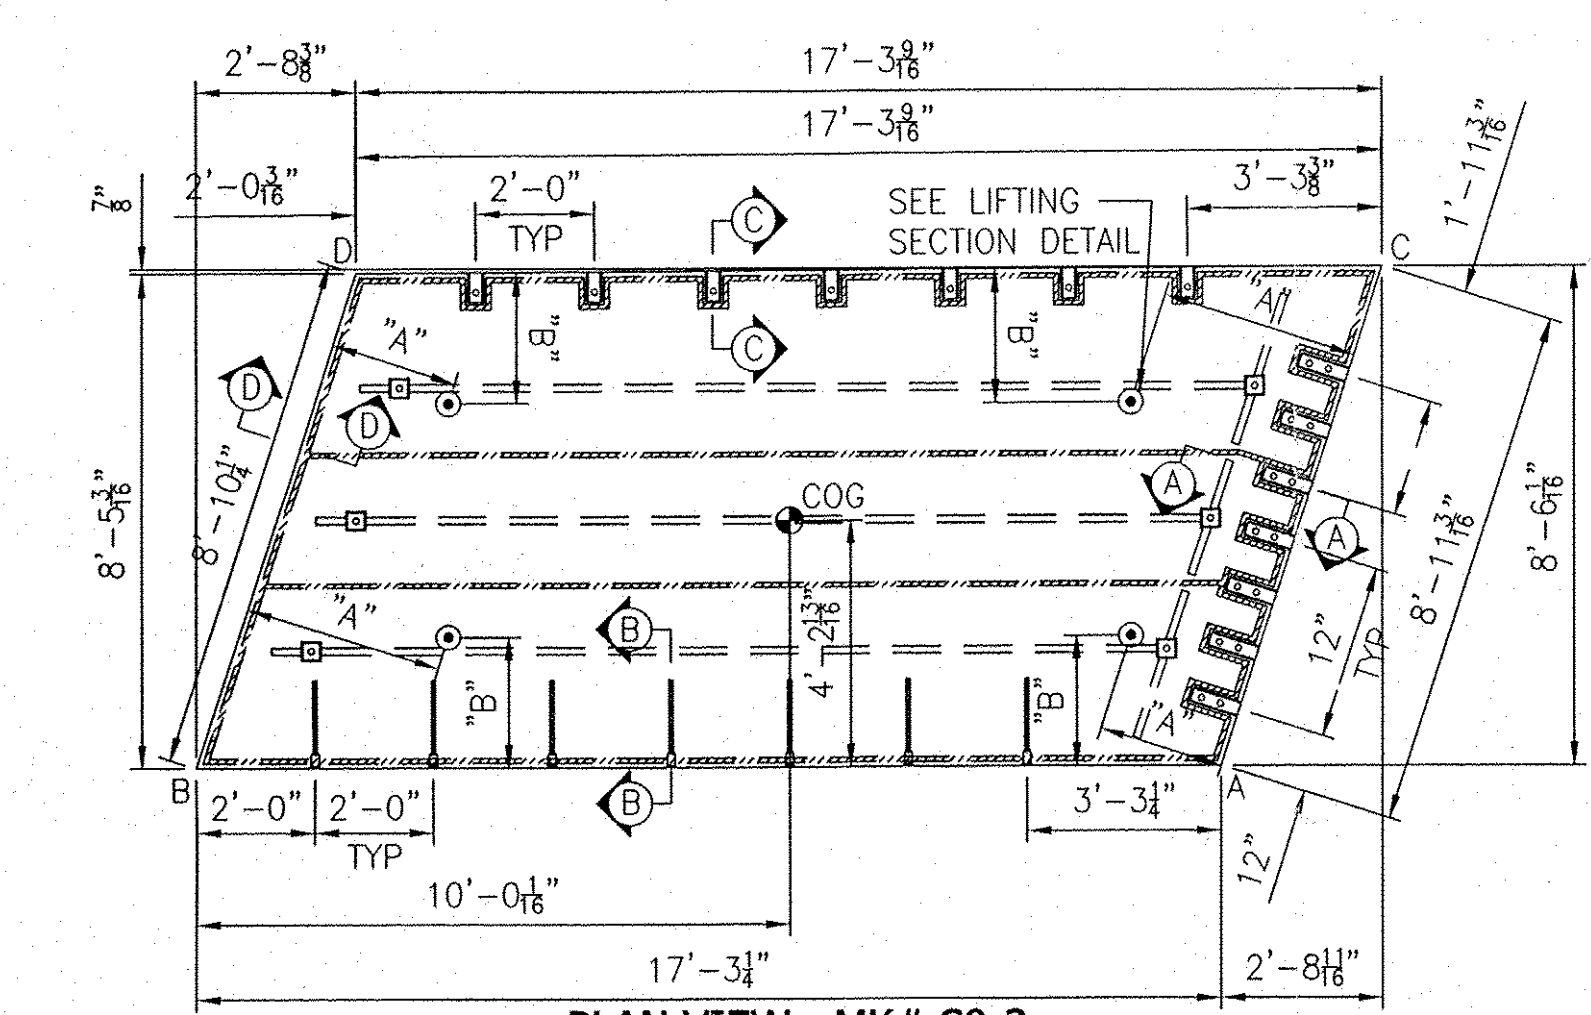

PLAN VIEW - MK# S9-3

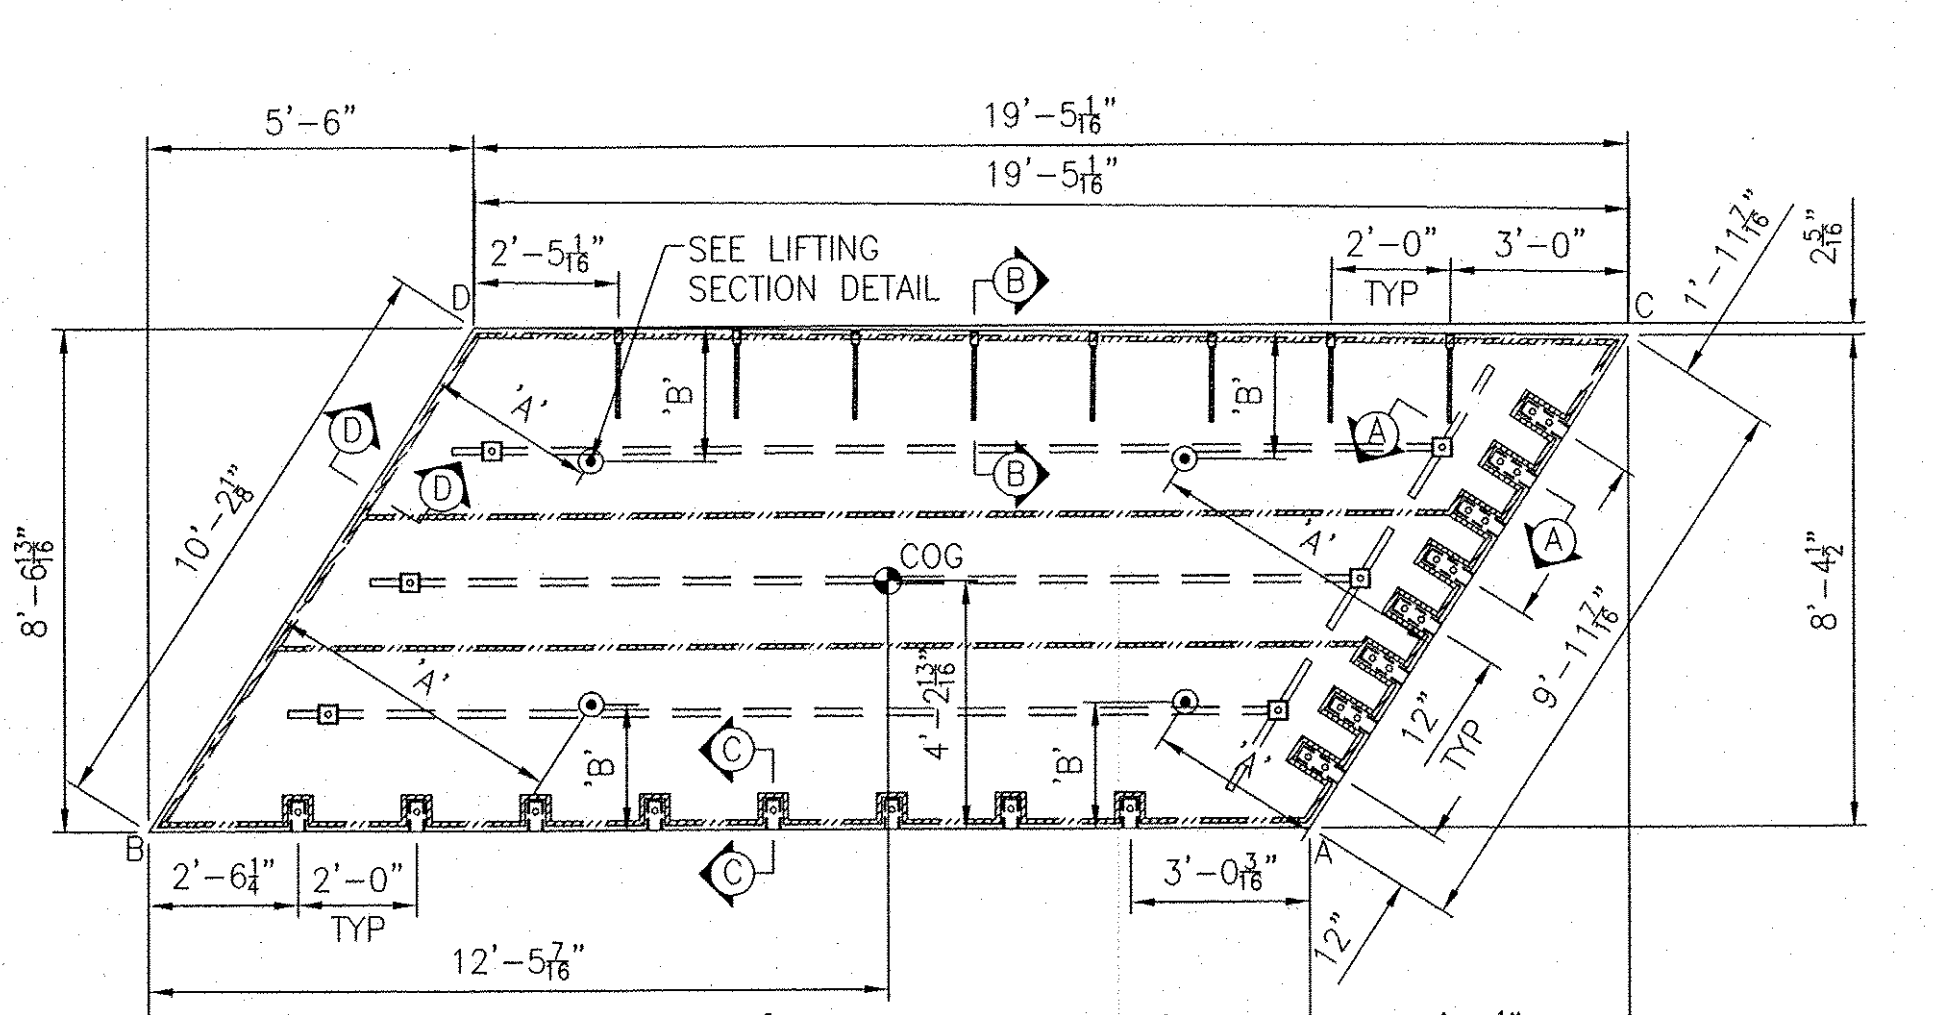

PLAN VIEW - MK# S9-6

S9-1 LIFTING		
CORNER	A	B
A	2'-8 1/4"	1'-8 3/4"
B	4'-1 1/2"	1'-8 3/4"
C	4'-1"	1'-9"
D	2'-6 1/2"	1'-8 1/2"

S9-3 LIFTING		
CORNER	A	B
A	2'-1 1/2"	2'-2 3/4"
B	3'-4 1/2"	2'-2 3/4"
C	3'-4"	2'-3"
D	2'-1 3/4"	2'-2 1/2"

S9-1 DIAGONALS		
	AD	BC
	16'-9 11/16"	21'-10 3/8"

S9-2 DIAGONALS		
	AD	BC
	16'-9 7/8"	21'-9 5/8"

S9-3 DIAGONALS		
	AD	BC
	16'-10 1/16"	21'-8 3/4"

S9-4 DIAGONALS		
	AD	BC
	16'-10 1/4"	21'-8 1/8"

S9-2 LIFTING		
CORNER	A	B
A	2'-1"	2'-3"
B	3'-3 1/4"	2'-3"
C	3'-3 3/4"	2'-3 1/4"
D	2'-1 1/2"	2'-2 1/2"

S9-4 LIFTING		
CORNER	A	B
A	2'-1 1/2"	2'-3"
B	3'-4 1/4"	2'-3"
C	3'-4"	2'-3"
D	2'-1 3/4"	2'-2 1/2"

S9-5 DIAGONALS		
	AD	BC
	16'-5 1/2"	26'-5 5/8"

S9-6 DIAGONALS		
	AD	BC
	16'-5 7/16"	26'-3 1/2"

S9-7 DIAGONALS		
	AD	BC
	16'-5 7/16"	26'-0 3/8"

S9-8 DIAGONALS		
	AD	BC
	16'-5 3/8"	25'-10 7/16"

S9-5 LIFTING		
CORNER	A	B
A	2'-3 1/2"	1'-8 1/2"
B	4'-11 1/2"	1'-8 1/2"
C	5'-0 1/4"	1'-8 1/4"
D	2'-2 3/4"	1'-9 1/2"

S9-7 LIFTING		
CORNER	A	B
A	2'-11"	2'-1 1/2"
B	5'-0 3/4"	2'-1 1/2"
C	5'-1 1/2"	2'-1 1/4"
D	2'-10 1/4"	2'-2 1/4"

S9-6 LIFTING		
CORNER	A	B
A	2'-11"	2'-1 3/4"
B	5'-1 1/4"	2'-1 3/4"
C	5'-2"	2'-1 1/2"
D	2'-10 1/4"	2'-2 3/4"

S9-8 LIFTING		
CORNER	A	B
A	2'-10 3/4"	2'-1 3/4"
B	5'-0 1/2"	2'-1 3/4"
C	5'-1"	2'-1 1/2"
D	2'-10"	2'-2 1/2"

SEE SHEET 4 FOR ALL SECTIONS SHOWN ON THIS SHEET

NO.	DATE	BY	REVISIONS

THE FORT MILLER Co., Inc.  
 P.O. BOX 98  
 SCHULERVILLE, NY 12871  
 (518) 695-5000  
 (518) 695-4970 FAX  
 WWW.FORTMILLER.COM

PROJECT LOCATION: TOWN OF CHESTER - ROUTE 103  
 PROJECT: BRF 025-1(37) - BRIDGE #9  
 SUBJECT: UNIT PLAN VIEWS  
 CONTRACTOR: COLD RIVER BRIDGES, LLC.  
 CONTRACTOR ADDRESS: PO BOX 1076  
 WALPOLE, NH 03608  
 ENGINEER/ARCHITECT: VAOT

F.M. JOB NO. 12511  
 DATE: 2-16-11  
 DRN. BY: TDS  
 CHK. BY: SDH  
 SCALE: NONE  
 SHEET NO. 3 OF 4  
 DWG. NO. P3

RECEIVED  
 G.K.U. BY 255 ORD BY RSY  
 MAR 29 2011  
 RESUBMIT APPROVED  
 BY CPW DATE 3/30/11

NOTES:  
 SEE SHEET 4 FOR ALL SECTIONS SHOWN ON THIS SHEET.  
 SEE SHEET 4 FOR LIFTING SECTION DETAIL.