


ONE - GIRDER - 4G4 (DEV)

SEE DRAWING GNI FOR GENERAL NOTES
 SEE DRAWING F1 FOR FLANGE DIAGRAM
 SEE DRAWING C1 FOR CAMBER DIAGRAM
 SEE DWG XI FOR GIRDER STANDARDS

ABM INFO		SHIP		BILL OF MATERIAL		JOB NO.		DRAWING NO.		REV.
		4G4				476		4		
PAGE	LINE	MARK	QTY	MARK	MATERIAL	LENGTH		REMARKS	WT	PROCUREMENT NOTES
						FT	INCHES			
					GIRDER				28395	
2	L		1	wa	PL 5/8x46	41	7 3/16	M270-SQWT2		
2	A		1	wb	PL 5/8x46	79	4 1/2	M270-SQWT2		
3	E		1	ta	PL 7/8x18	43	5			
2	U		1	tb	PL 7/8x18	77	5 1/4			
1	S		1	ba	PL 1 1/4x18	43	6	M270-SQWT2		
1	Q		1	bb	PL 1 1/4x18	77	4	M270-SQWT2		
4	B		6	x1a	PL 1/2x7 1/2	3	10	M270-SQWT2		
4	B		4	x1b	PL 1/2x7 1/2	3	10	M270-SQWT2		
4	B		1	x1c	PL 1/2x7 1/2	3	10	M270-SQWT2		
4	B		1	x1d	PL 1/2x7 1/2	3	10	M270-SQWT2		
4	C		4	x1f	PL 2x7 1/2	3	10	M270-SQWT2		
4	B		1	x1n	PL 1/2x7 1/2	3	10	M270-SQWT2		

RECEIVED
 ELC
 DEC 14 2010
 APPROVED: AS/MS/CS
 BY: CPW DATE: 12/30/10

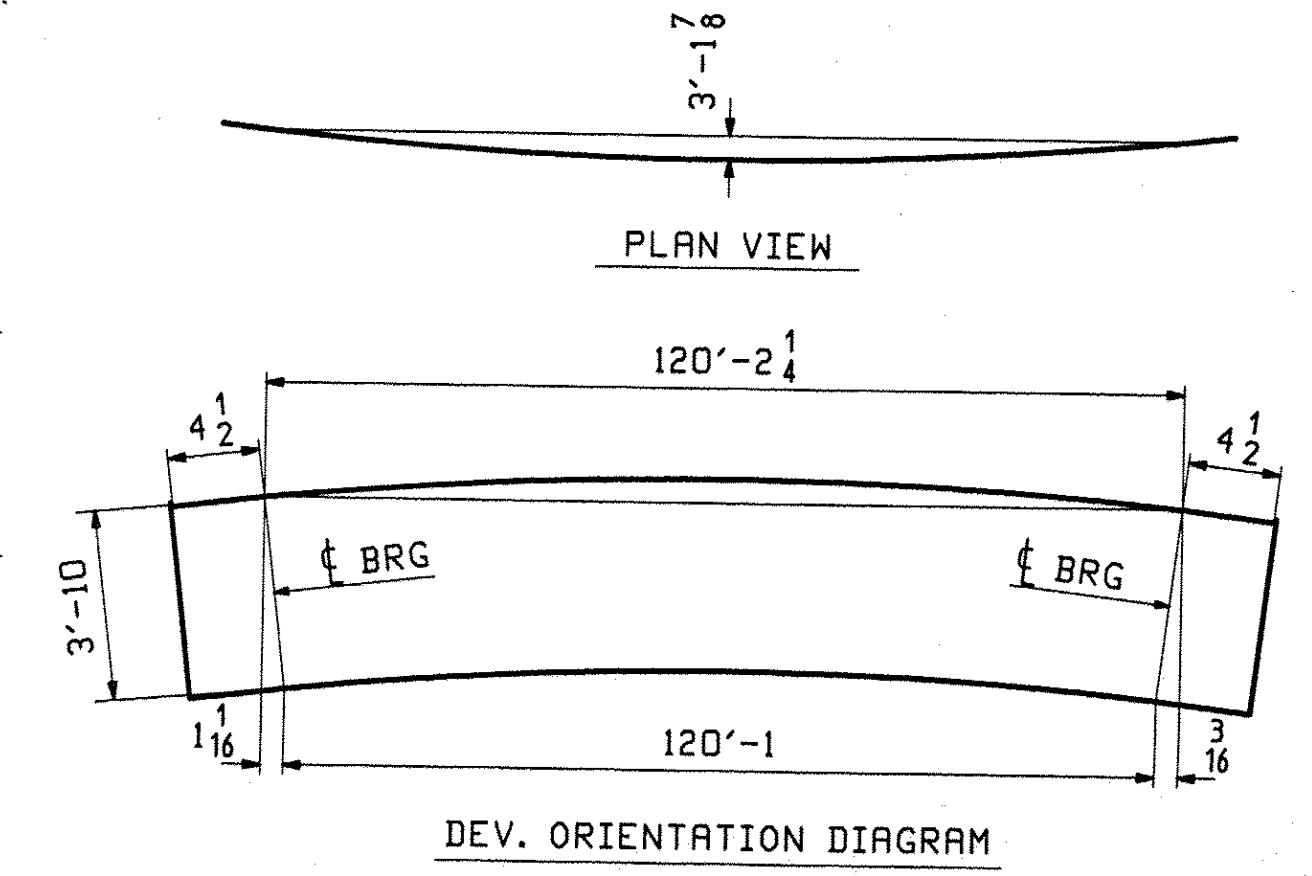

REV.	DATE	REMARKS	DWN	CHK	APVL	SHOP
0						
MATERIAL:		SURFACE PREP. & PAINT:		HOLES:		SHOP BOLTS:
M270-GR50W (U.N.)		SSPC-SP8 10		15/16" Ø (U.N.)		N/A
DESCRIPTION: GIRDER 4G4						
CASCO BAY STEEL STRUCTURES, INC. 75 SPRING HILL ROAD SACO, MAINE 04072 PHONE (207) 282-7360 FAX. (207) 282-1179						
STRUCTURE: VT 103 over Middle Branch Williams Rv. Bridge 9 CHESTER County of Windsor				DRAWN: TG DATE: 11/19		CHKD: DO DATE: 12/01
LOCATION: Town of Chester				JOB NO. 476		DWG NO. 4
PROJ. NO. BRF D25-1(37)				CUSTOMER: Cold River Bridges		REV. 1

P12, Rev. 2, 2010 04:25:35 PM - 1/27/11 10:30:54 AM