


ABM INFO		SHIP		BILL OF MATERIAL				JOB NO.		DRAWING NO.		REV.
		7G7						476		7		
PAGE	LINE	MARK	QTY	MARK	MATERIAL	LENGTH		REMARKS	WT	PROCUREMENT NOTES		
						FT	INCHES					
					GIRDER					35276		
2	J		1	wa	PL 5/8 x 46	51	3 1/16	M270-50MT2				
2	C		1	wb	PL 5/8 x 46	69	0 7/8	M270-50MT2				
3	C		1	ta	PL 7/8 x 18	53	0					
3	A		1	tb	PL 7/8 x 18	67	1 1/8					
1	G		1	ba	PL 2 1/4 x 18	53	0	M270-50MT2				
1	E		1	bb	PL 2 1/4 x 18	67	0	M270-50MT2				
4	B		7	x1a	PL 1/2 x 7 1/2	3	10	M270-50MT2				
4	C		4	x1f	PL 1/2 x 7 1/2	3	10	M270-50MT2				
4	D		1	x1g	PL 1/4 x 4 1/4	1	0 8					
4	D		1	x1m	PL 1/4 x 4 1/4	1	0 8					

REVISIONS
 DEC 14 2010
 APPROVED: [Signature]
 BY CPW DATE 12/30/10

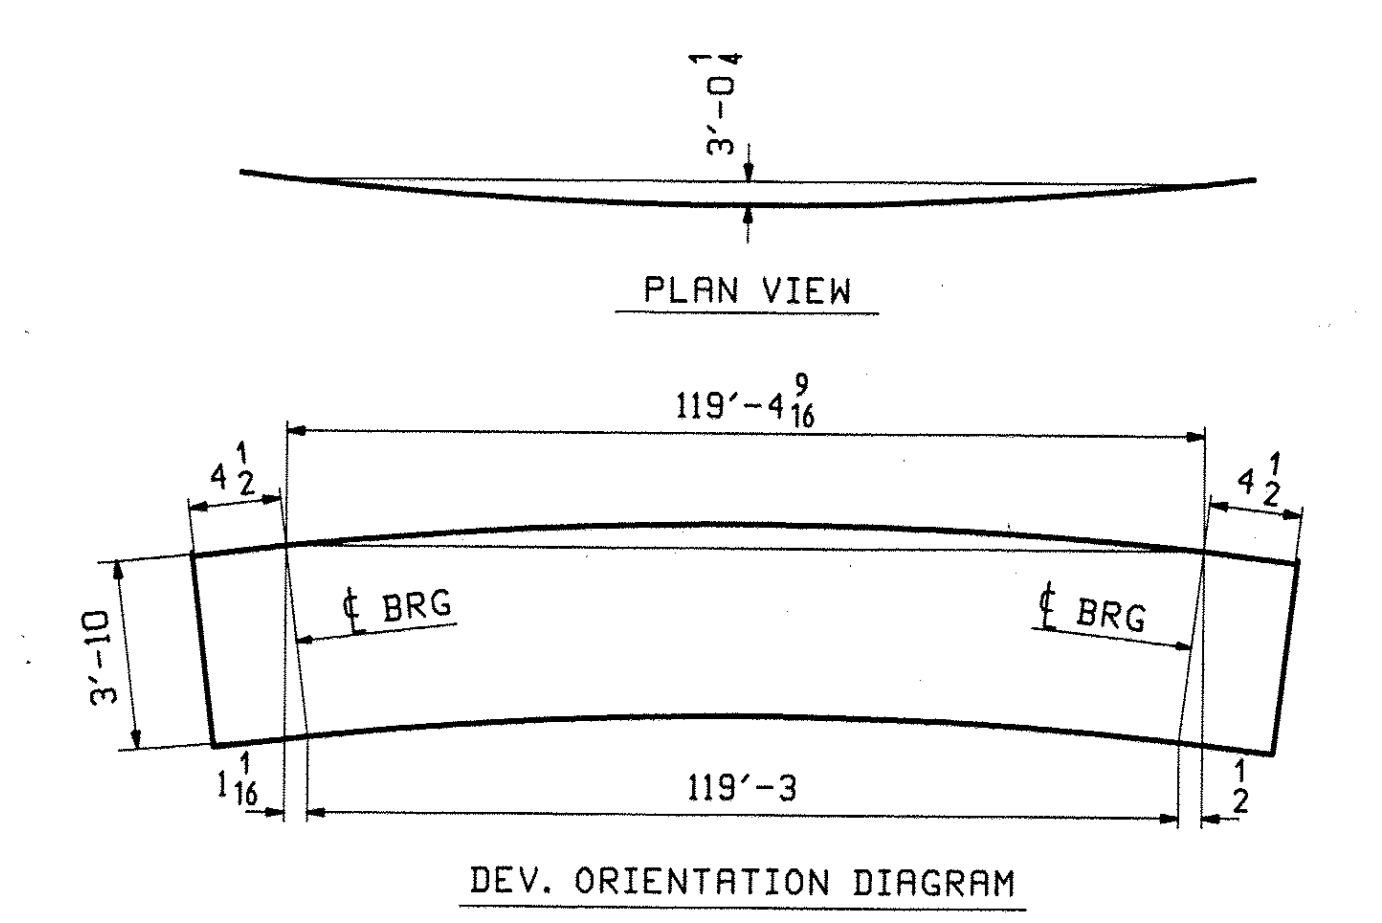

REV.	DATE	REMARKS	DWN	CHK	APVL	SHOP
0						
MATERIAL:		SURFACE PREP. & PAINT:		HOLES:		SHOP BOLTS:
M270-GR50W (U.N.)		SSPC-SP10		1 1/2" Ø (U.N.)		N/A
DESCRIPTION: GIRDER 7G7						
CASCO BAY STEEL STRUCTURES, INC. 75 SPRING HILL ROAD SACO, MAINE 04072 PHONE (207) 282-7360 FAX. (207) 282-1179						
STRUCTURE: VT 103 over Middle Branch Williams Rv. Bridge 9 CHESTER County of Windsor				DRAWN:	DATE:	
				TG	11/19	
				CHKD:	DATE:	
				DO	12/01	
LOCATION: Town of Chester			JOB NO.		DWG NO.	
PROJ NO. BRF 025-1(37)			476		7	
CUSTOMER: Cold River Bridges					REV. [Signature]	