



PIER PLAN
SCALE 1:50

NOTE
SEE SHEET 101 FOR SECTION A-A.

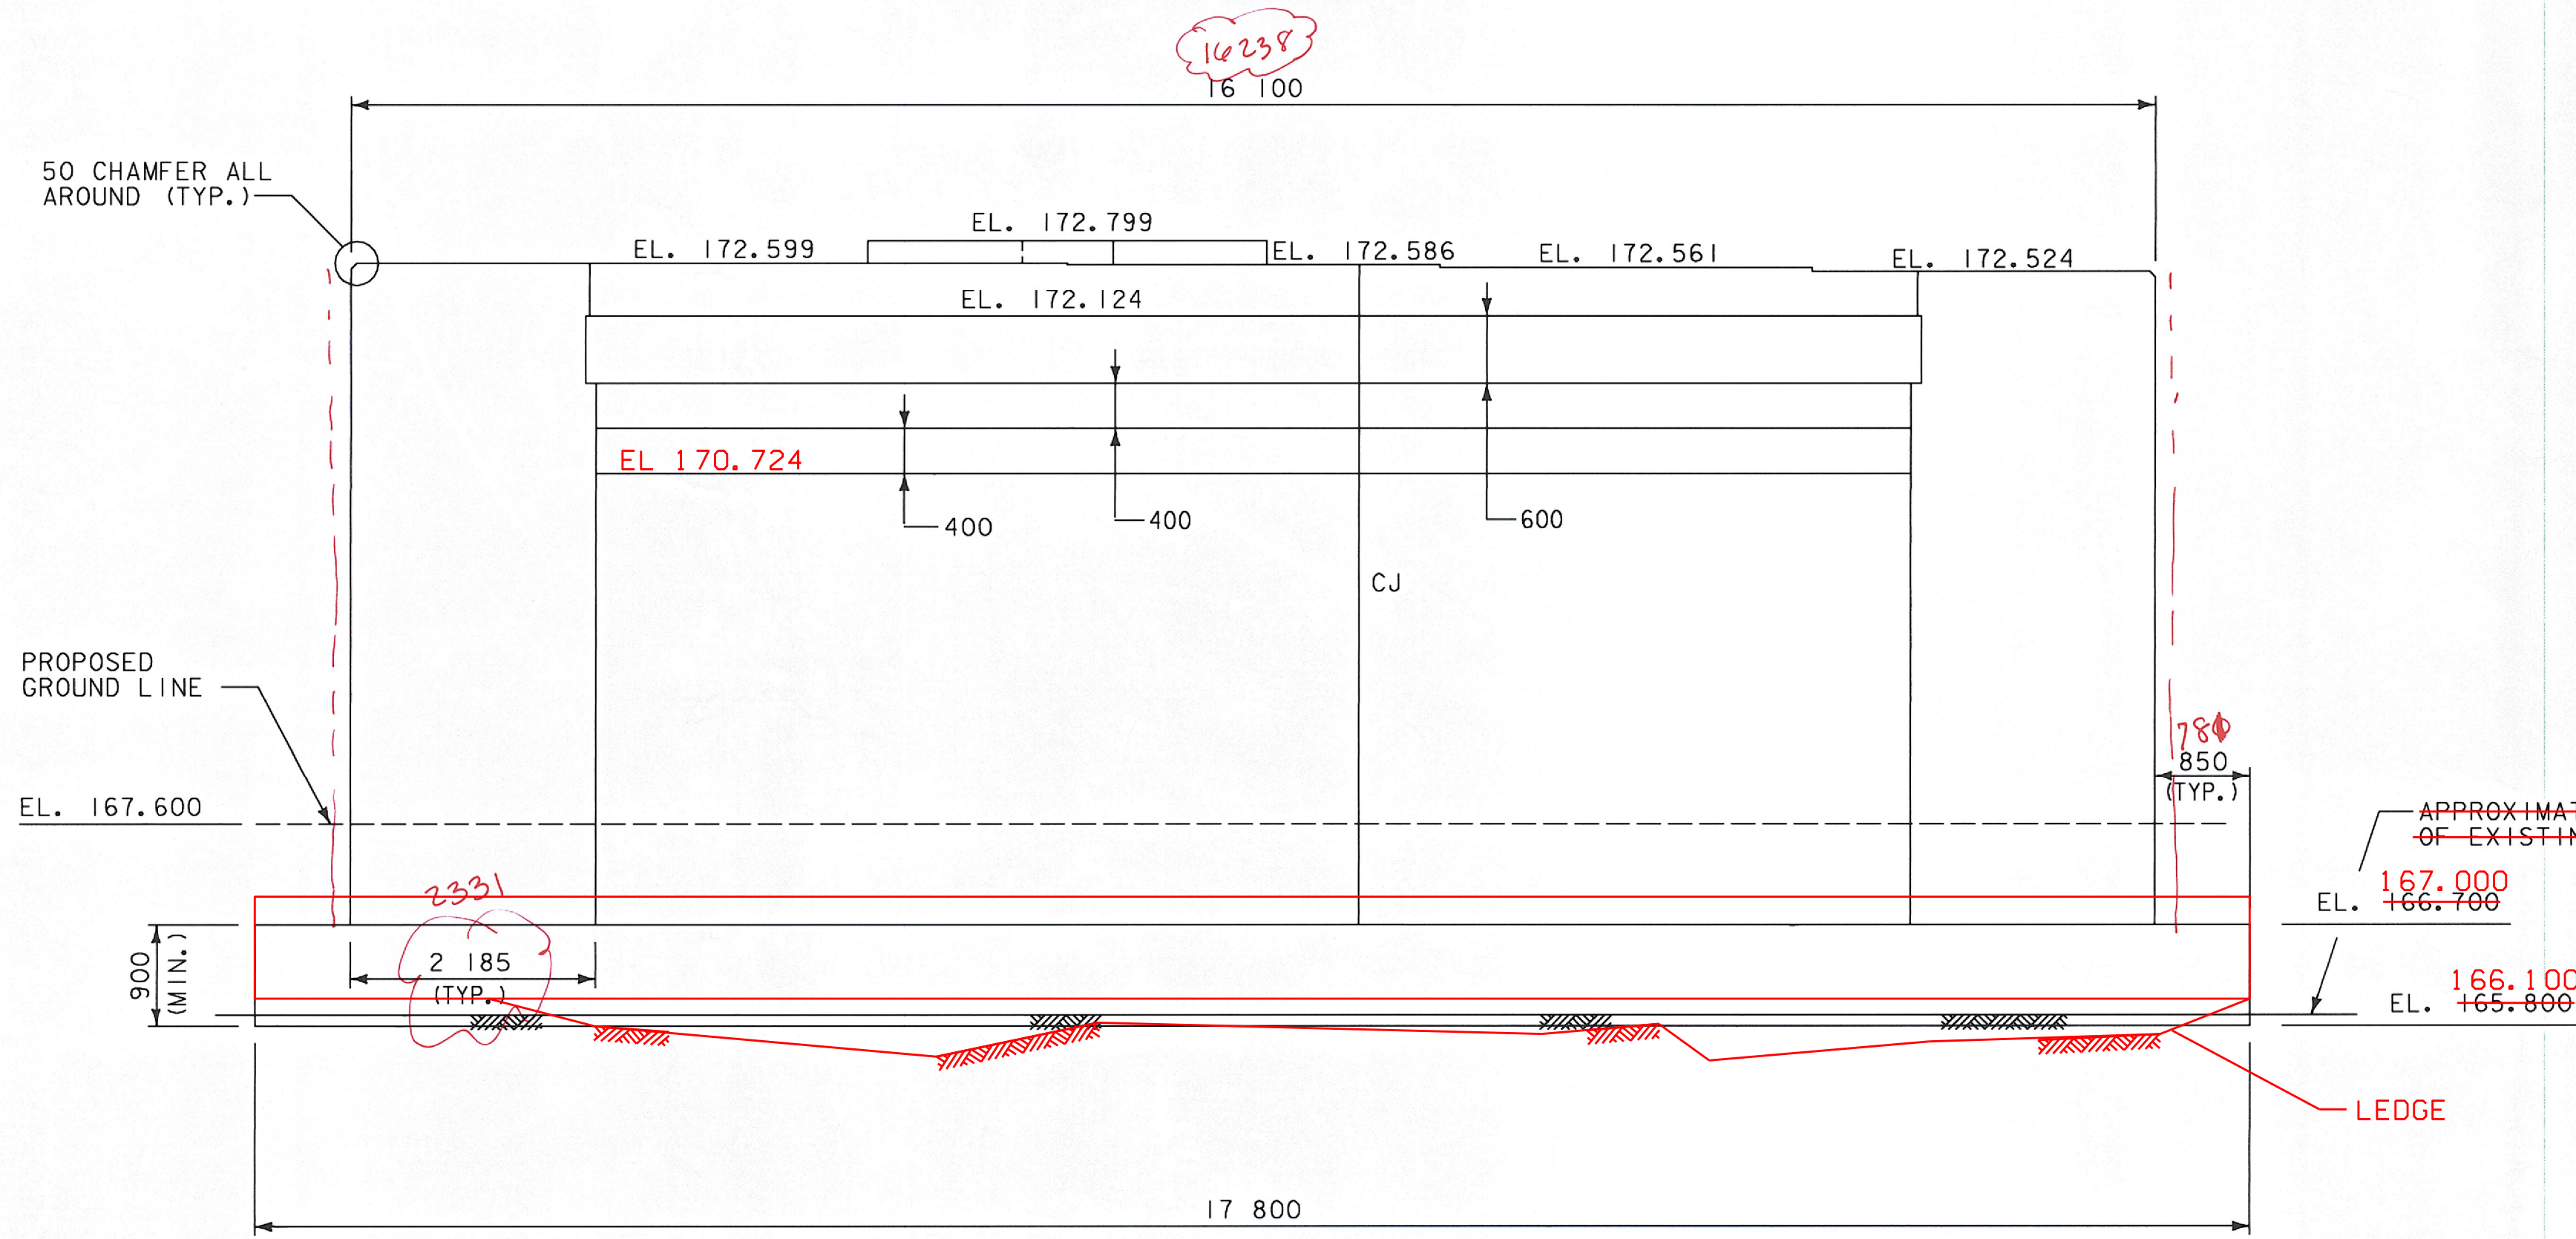

PIER ELEVATION
SCALE 1:50

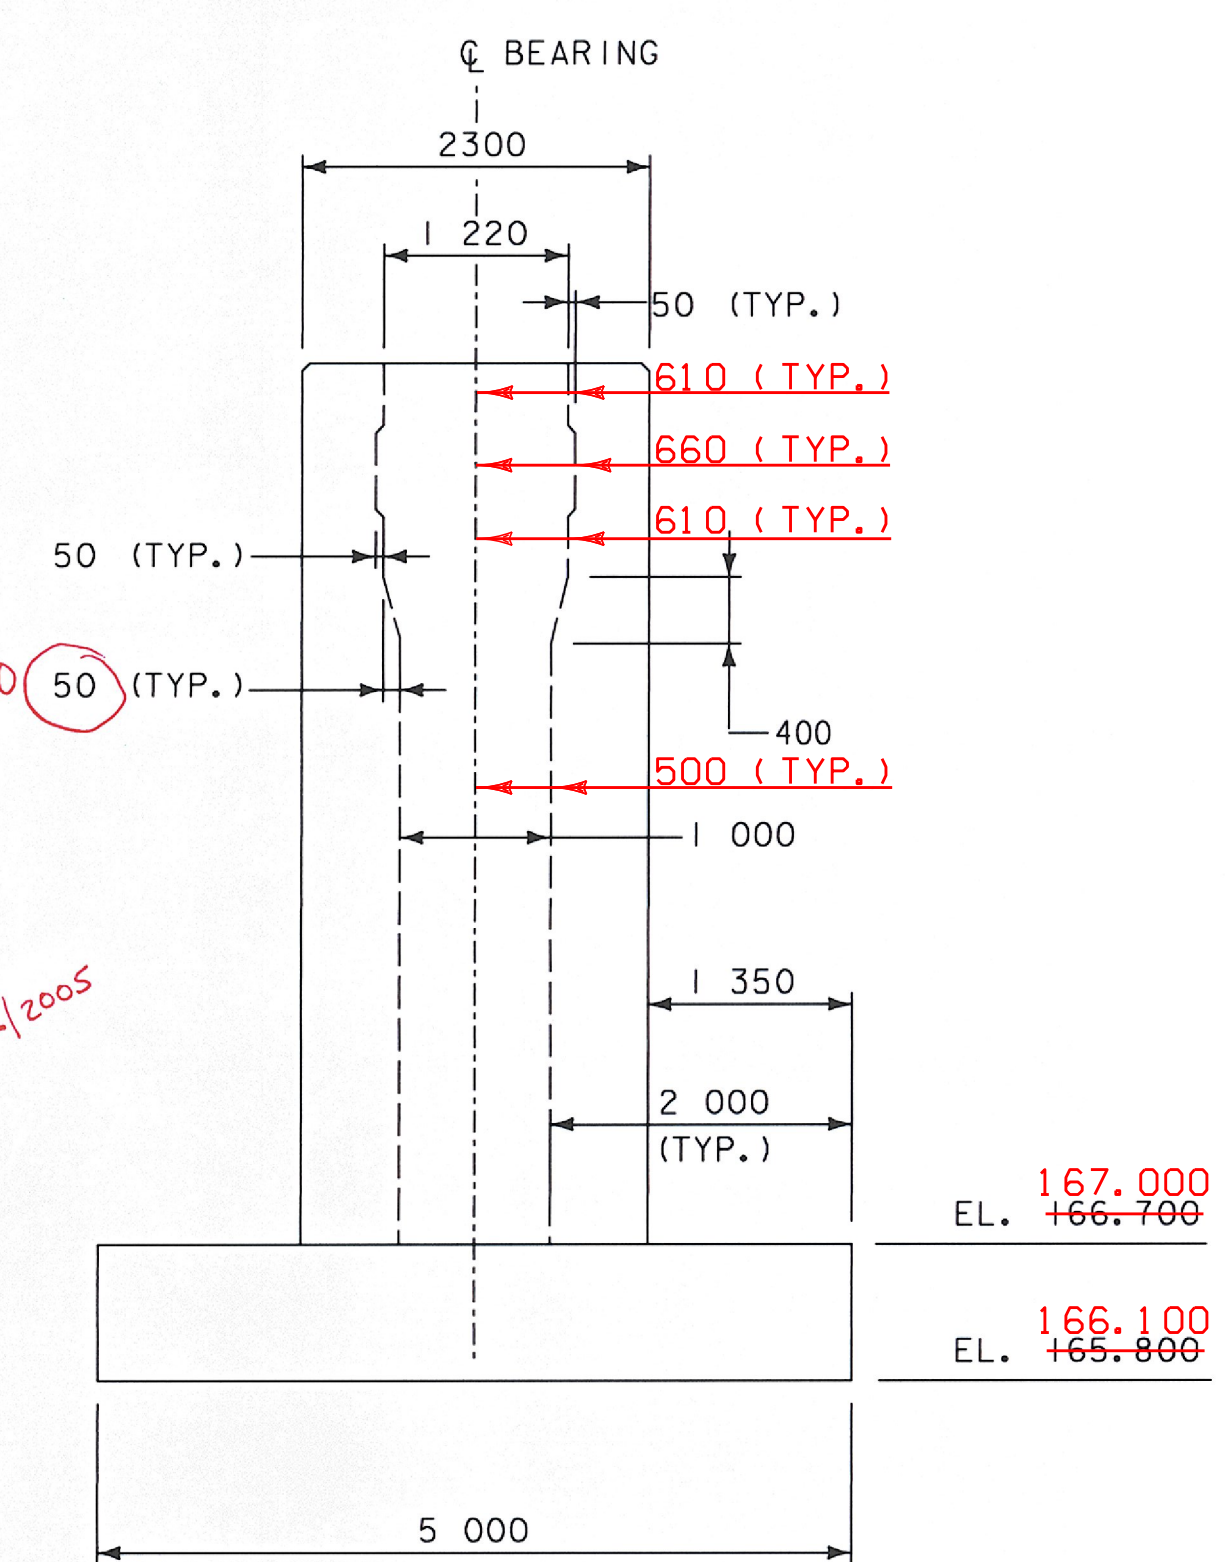

PIER SIDE VIEW
SCALE 1:50

Copies sent to
Danny Borer
on 10/28/05

**STATE OF VERMONT
AGENCY OF TRANSPORTATION**

Town Of	TUNBRIDGE	Bridge No.	4
Highway No.	VT.110	Log Sta.	
		Surv. Sta.	
VT.110 OVER THE FIRST BRANCH OF WHITE RIVER			
PIER PLAN AND ELEVATION			
Designed By	JH	Drawn By	MWS
Checked By	BTW	Bridge Design Supervisor	LMM
Date	3/03	Date	3/03
PROJECT	TUNBRIDGE	PROJECT NO.	BRS 0169(6)
I.G.C. Info.			
Bridge Sheet No.		Sheet	100 of 128

