


REINFORCING LAYOUT ABUTMENT NO. 1

SCALE 1:50

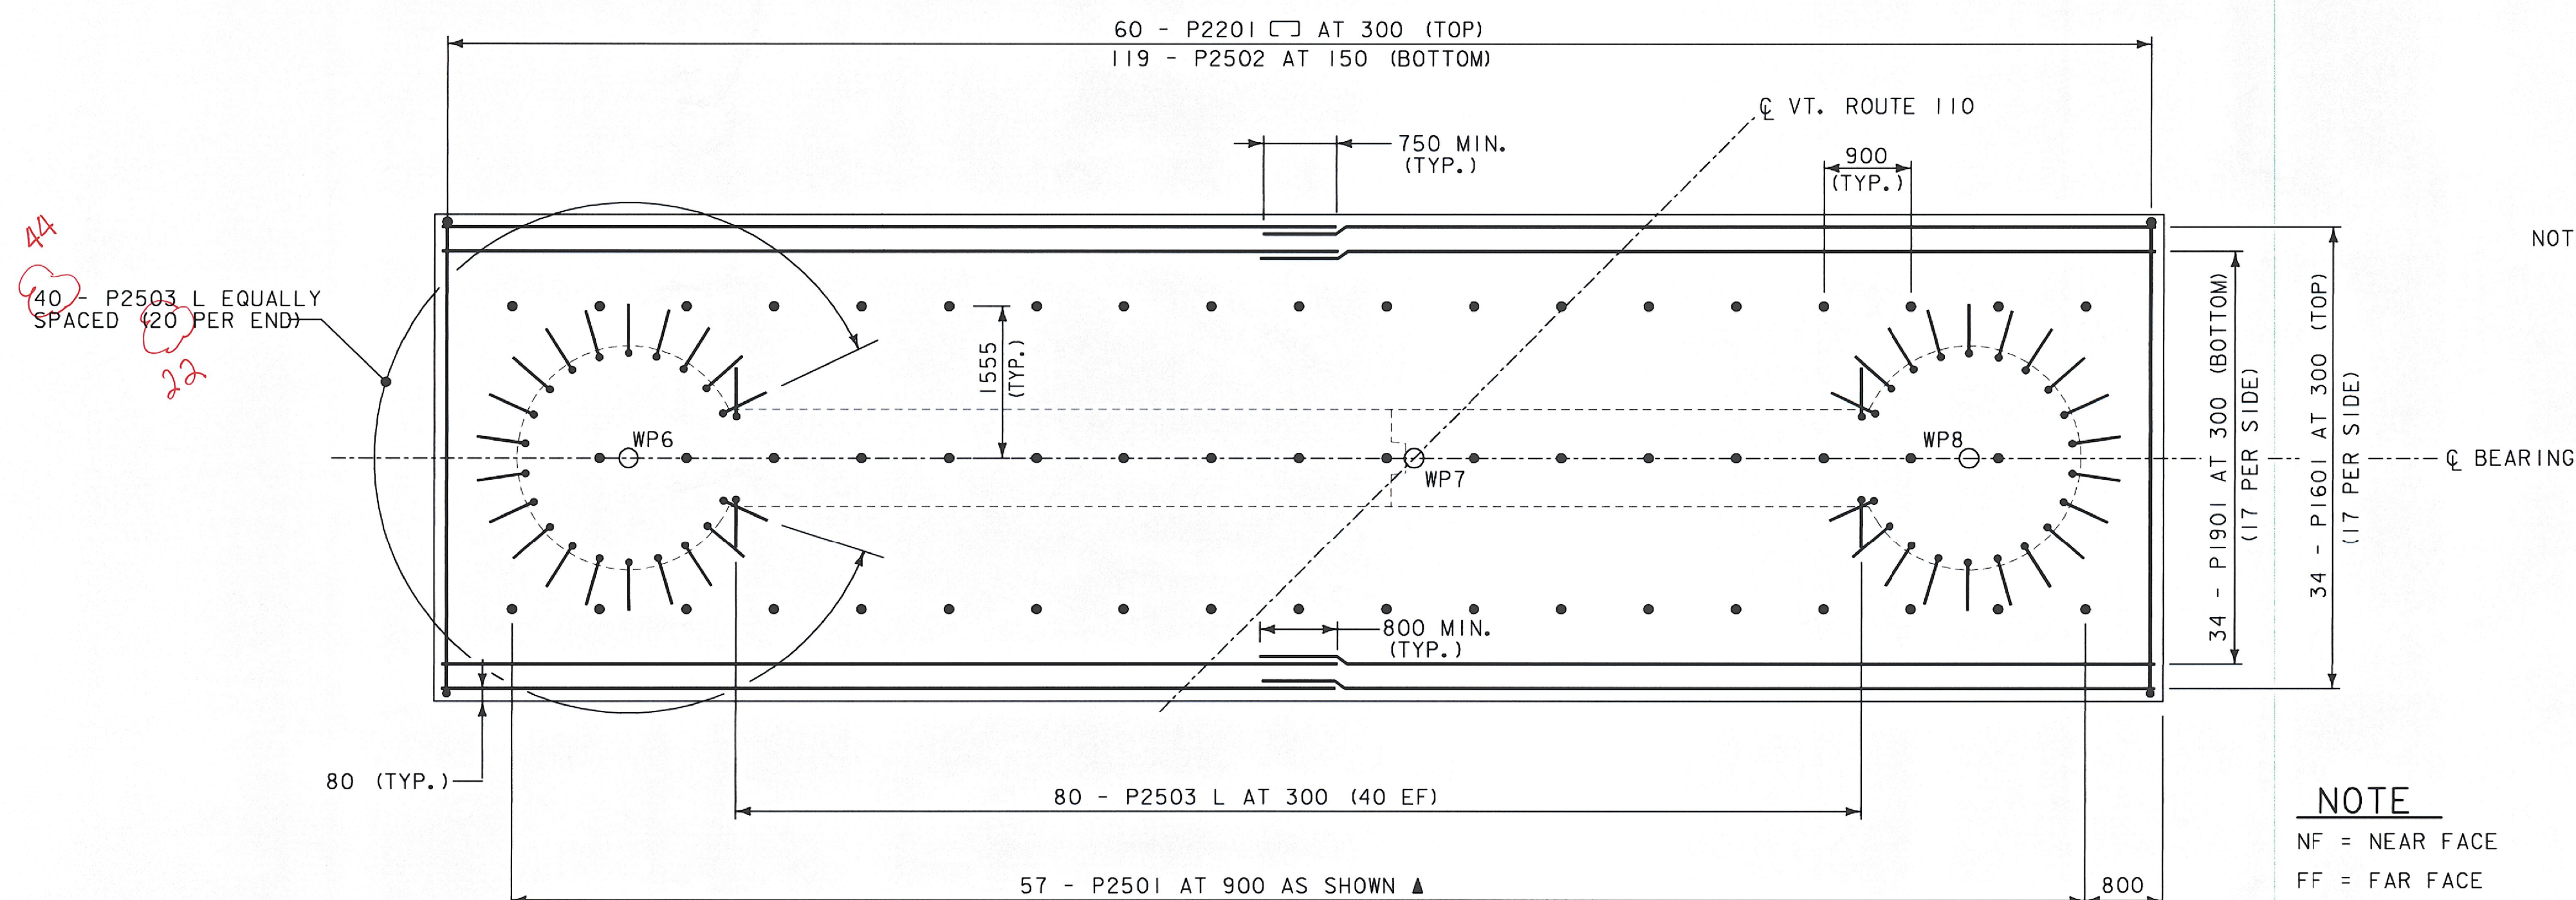

REINFORCING LAYOUT PIER

SCALE 1:50

NOTE: SEE SHEET 103 FOR DOWEL DETAIL

NOTE

- NF = NEAR FACE
- FF = FAR FACE
- EF = EACH FACE
- ▲ = FIELD CUT
- CJ = CONSTRUCTION JOINT

STATE OF VERMONT  
AGENCY OF TRANSPORTATION

Town Of	TUNBRIDGE	Bridge No.	4
Highway No.	VT.110	Log Sta.	
		Surv. Sta.	
VT.110 OVER THE FIRST BRANCH OF WHITE RIVER			
FOOTING REINFORCING PLAN (1 OF 2)			
Designed By	JH	Drawn By	MWS
Checked By	RMR	Date	3/03
		Bridge Design Supervisor	LMM
		Date	3/03
PROJECT	TUNBRIDGE	PROJECT NO.	BRS 0169(6)
I.G.C. Info.			
Bridge Sheet No.	Sheet 102 of 128		

