

INDEX OF SHEETS

SHEET No

1	TITLE
2	QUANTITIES
3	PLAN & PROFILE
4	GRAVITY WALL DETAIL
5-9	CHANNEL SECTIONS

List of Standards

E3	12-13-78 R
SCB-01-75	9-14-81 R

GENERAL NOTES

- GRAVITY WALL TO BE DOWELLED TO SOLID LEDGE, APPROXIMATE ELEVATION 470.0±.
- QUANTITIES ARE ESTIMATED FOR LEDGE ELEVATION OF 470. LEDGE PROFILE ALONG GRAVITY WALL WILL BE TAKEN BY THE ENGINEER, AND QUANTITIES ADJUSTED ACCORDINGLY.
- CONTRACTOR'S ATTENTION IS CALLED TO STANDARD SHEET SCB-01-75. NOTES OF PARTICULAR CONCERN ARE # 4, # 6, # 7, # 8, & # 16.

STATE OF VERMONT AGENCY OF TRANSPORTATION




PROPOSED IMPROVEMENT BRIDGE PROJECT

TOWN OF FAIRFIELD
COUNTY OF FRANKLIN

ROUTE NO: VT. RTE 36 BRIDGE NO: 6
PROJECT LOCATION: PROJECT IS LOCATED 125 MI EAST
OF FAIRFIELD VILLAGE ON VT. RTE 36

PROJECT DESCRIPTION: PROJECT CONSISTS OF THE CONSTRUCTION OF A
CONCRETE GRAVITY WALL, TO BE DOWELLED TO
LEDGE, ALONG WITH CHANNEL EXCAVATION NECESSARY
FOR PLACEMENT OF STONE FILL.

LENGTH OF STRUCTURE: 82.00 FEET
LENGTH OF PARTICIPATION ROADWAY: 1.00 FEET
LENGTH OF NON-PARTICIPATION ROADWAY: 0.00 FEET
LENGTH OF PROJECT: 83.00 FEET

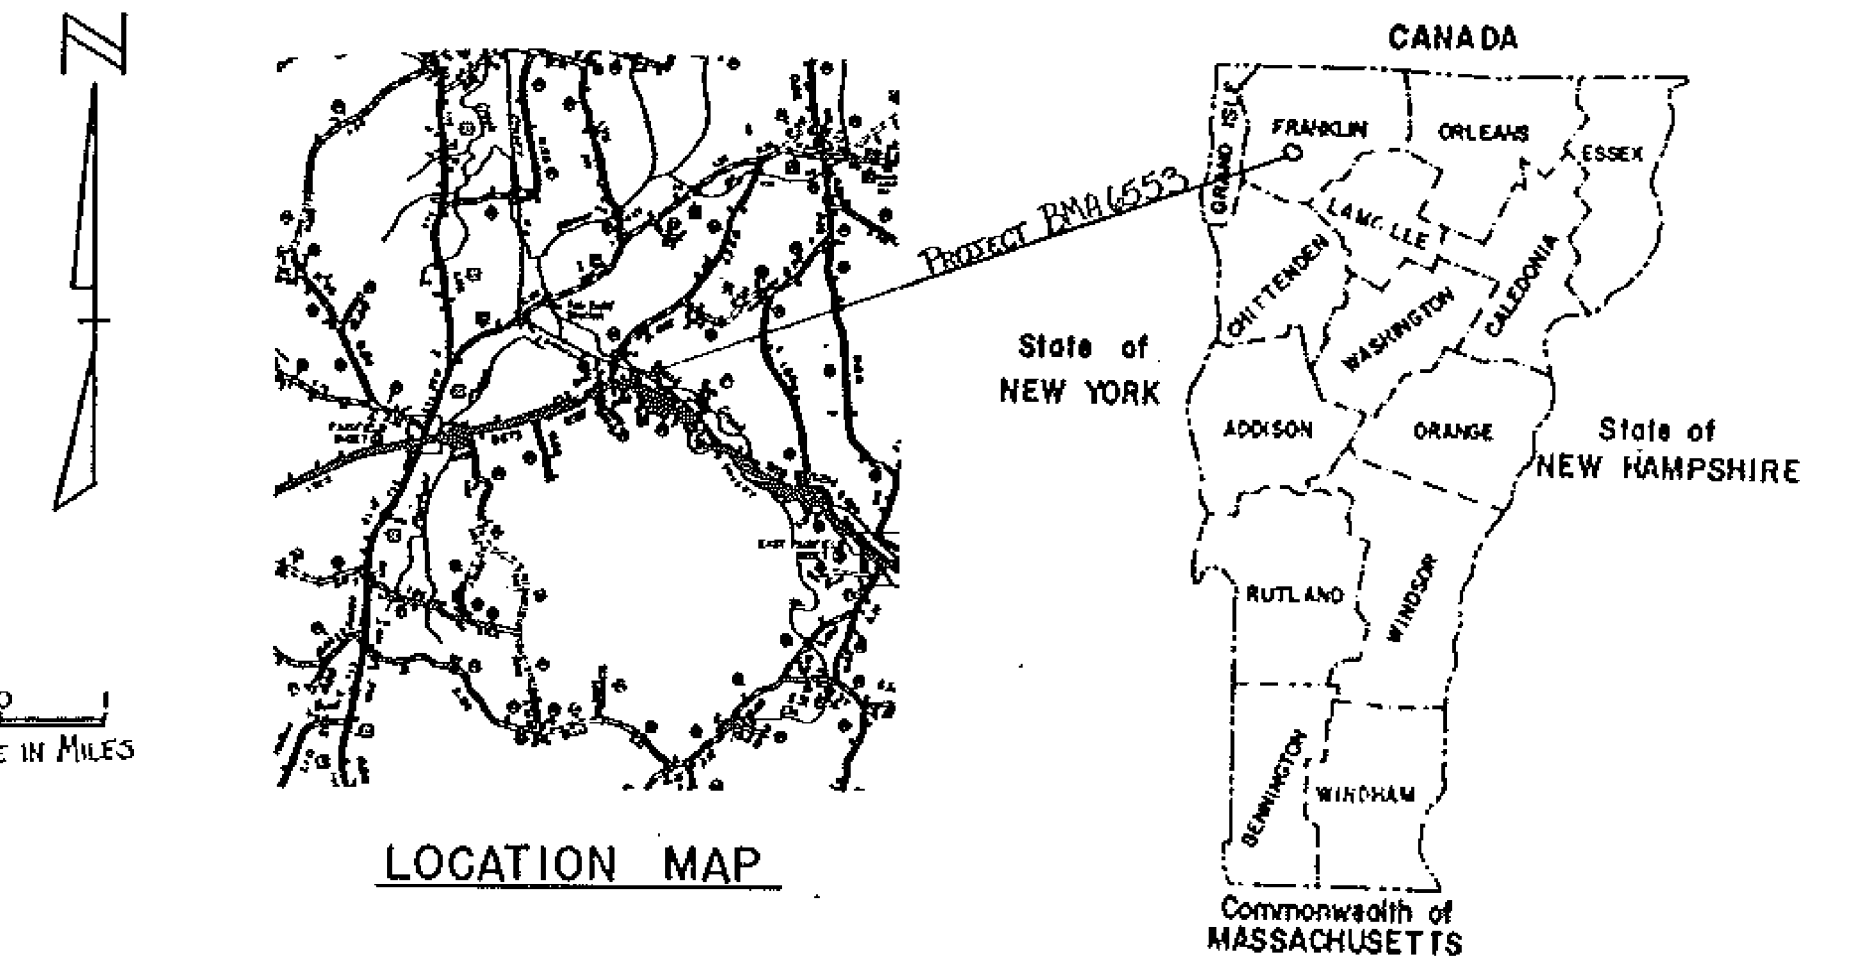

Date AUG 30 1985

Winterser Inc
Contractor

Shard Bailey
Signature


President
Frank E. Aldrich
Transportation Secretary's Signature

CONTRACT PLANS

THESE PLANS DO NOT REFLECT
CHANGES MADE ON THE PROJECT.

CONVENTIONAL SIGNS	
COUNTY LINE	---
TOWN LINE	---
LIMITS OF ACCESS	---X---
POINT OF ACCESS	X
FENCE LINE	---X---
STONE WALL	---X---
TRAVELED WAY	---
GUARD RAIL	---
RAILROAD	---
SURVEY LINE	---
CULVERT	---
POWER POLE	---
TELEPHONE POLE	---
TREES	---
CONTROL OF ACCESS	---
PROPERTY LINE	---
ROW TAKING LINE	---
SLOPE RIGHTS	---
TOP OF CUT	---
TOE OF SLOPE	---

DATUM	
VERTICAL	---
HORIZONTAL	---

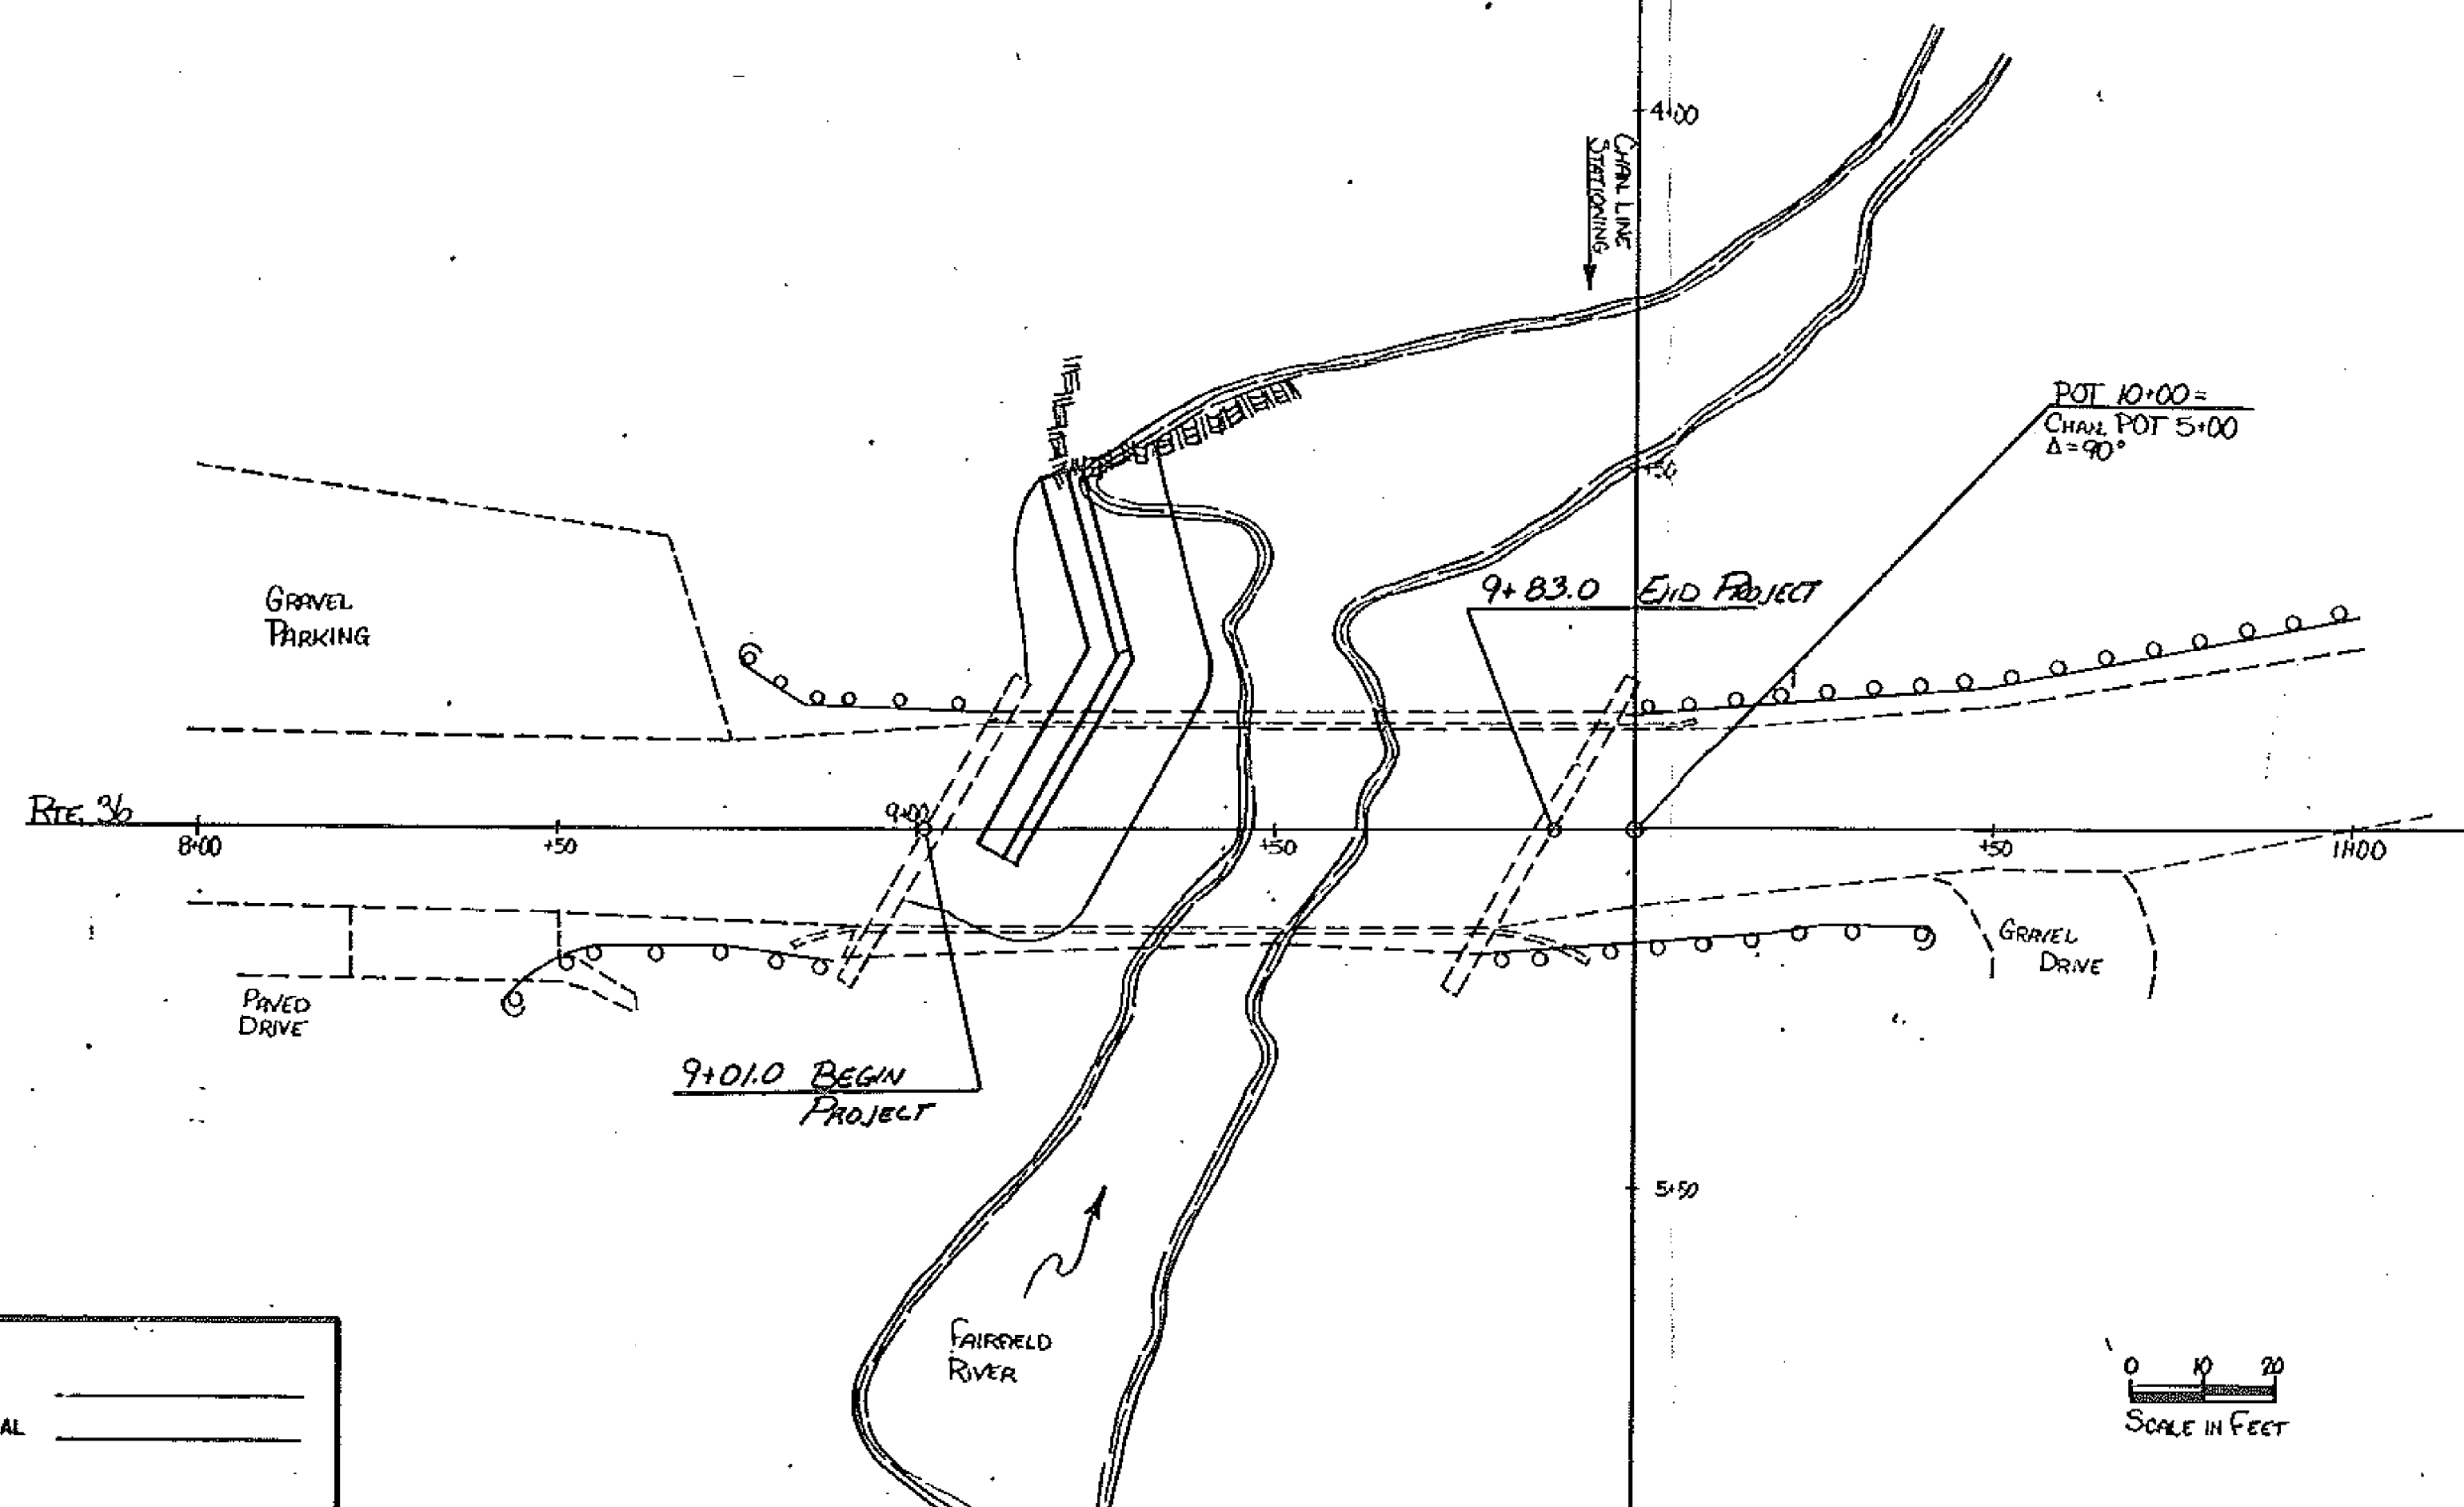

0 10 20
SCALE IN FEET

These plans are subject to such engineering changes as may be required by the Federal Highway Administration or the Director of Engineering and Construction.
Construction is to be carried on in accordance with these plans and the Standard Specifications for Highway and Bridge Construction dated March, 1976, as approved by the Federal Highway Administration on October 27, 1978 for use on this project, including all subsequent revisions and such revised specifications and special provisions as are incorporated in these plans.

SUBMITTED BY ORDER OF THE STATE TRANSPORTATION BOARD	
APPROVED	DATE 6-14-85
DIRECTOR OF ENGINEERING AND CONSTRUCTION	
PROJECT FAIRFIELD	PROJECT NO. ER0298(4)S
SHEET 1 OF 9	SHEETS
SJB 7/21/81	

[illegible]



BRIDGE QUANTITY SHEET

[illegible]



TYPICAL BAR BENDS

REV. NO.	MADE BY	DATE	DESCRIPTION

STATE OF VERMONT AGENCY OF TRANSPORTATION			
TOWN OF <i>FAIRFIELD</i>		BRIDGE NO. <i>6</i>	
HIGHWAY NO. <i>VT 36</i>		LOG STA.	
		SURV. STA.	
BRIDGE QUANTITY SHEET & REINFORCING STEEL SCHEDULE			
DESIGNED BY <i>A. Elwood</i>		DRAWN BY <i>M. P. Blodgett</i>	
CHECKED BY <i>A. W. Elwood</i>		BRIDGE DESIGN SUPERVISOR	
DATE <i>9/84</i>		DATE <i>9/8</i>	
PROJECT <i>FAIRFIELD</i>		PROJECT NO. <i>FR0298(4)S</i>	
BRIDGE SHEET NO.		SHEET <i>2</i> OF <i>9</i>	

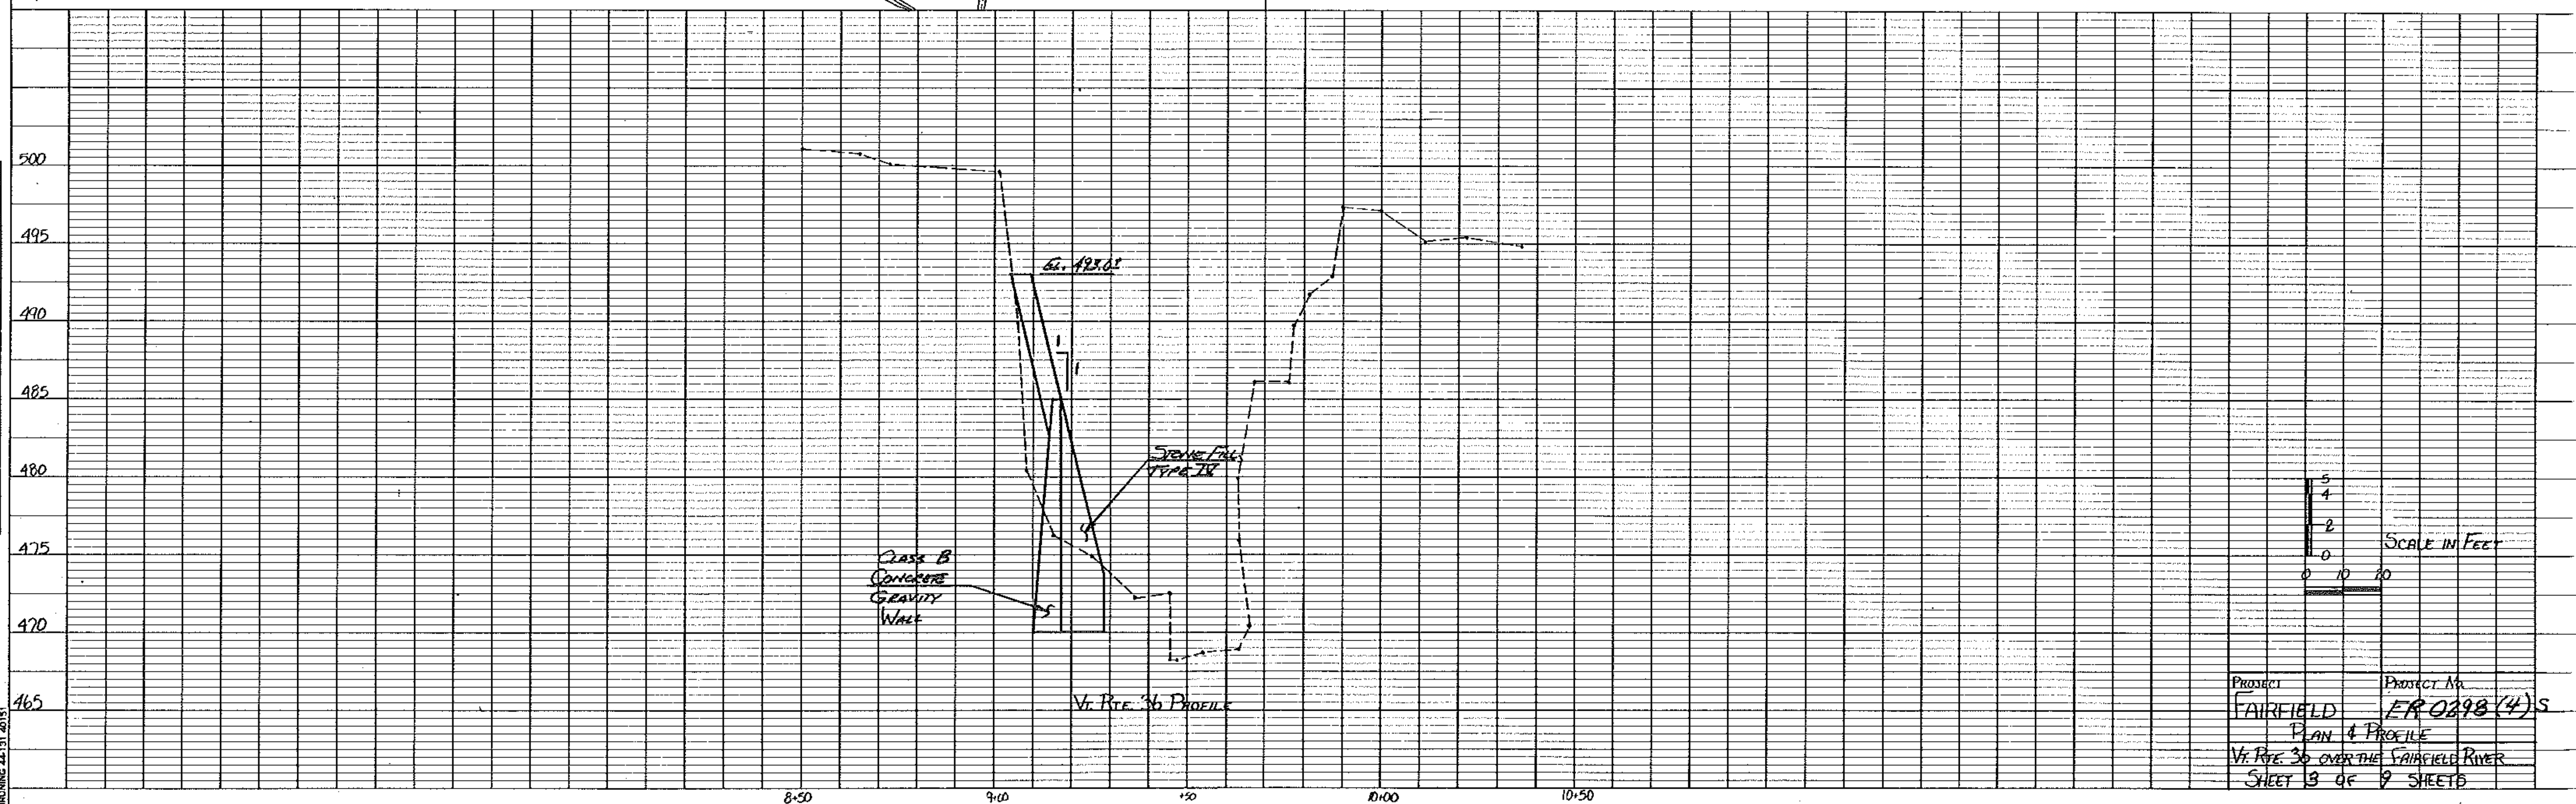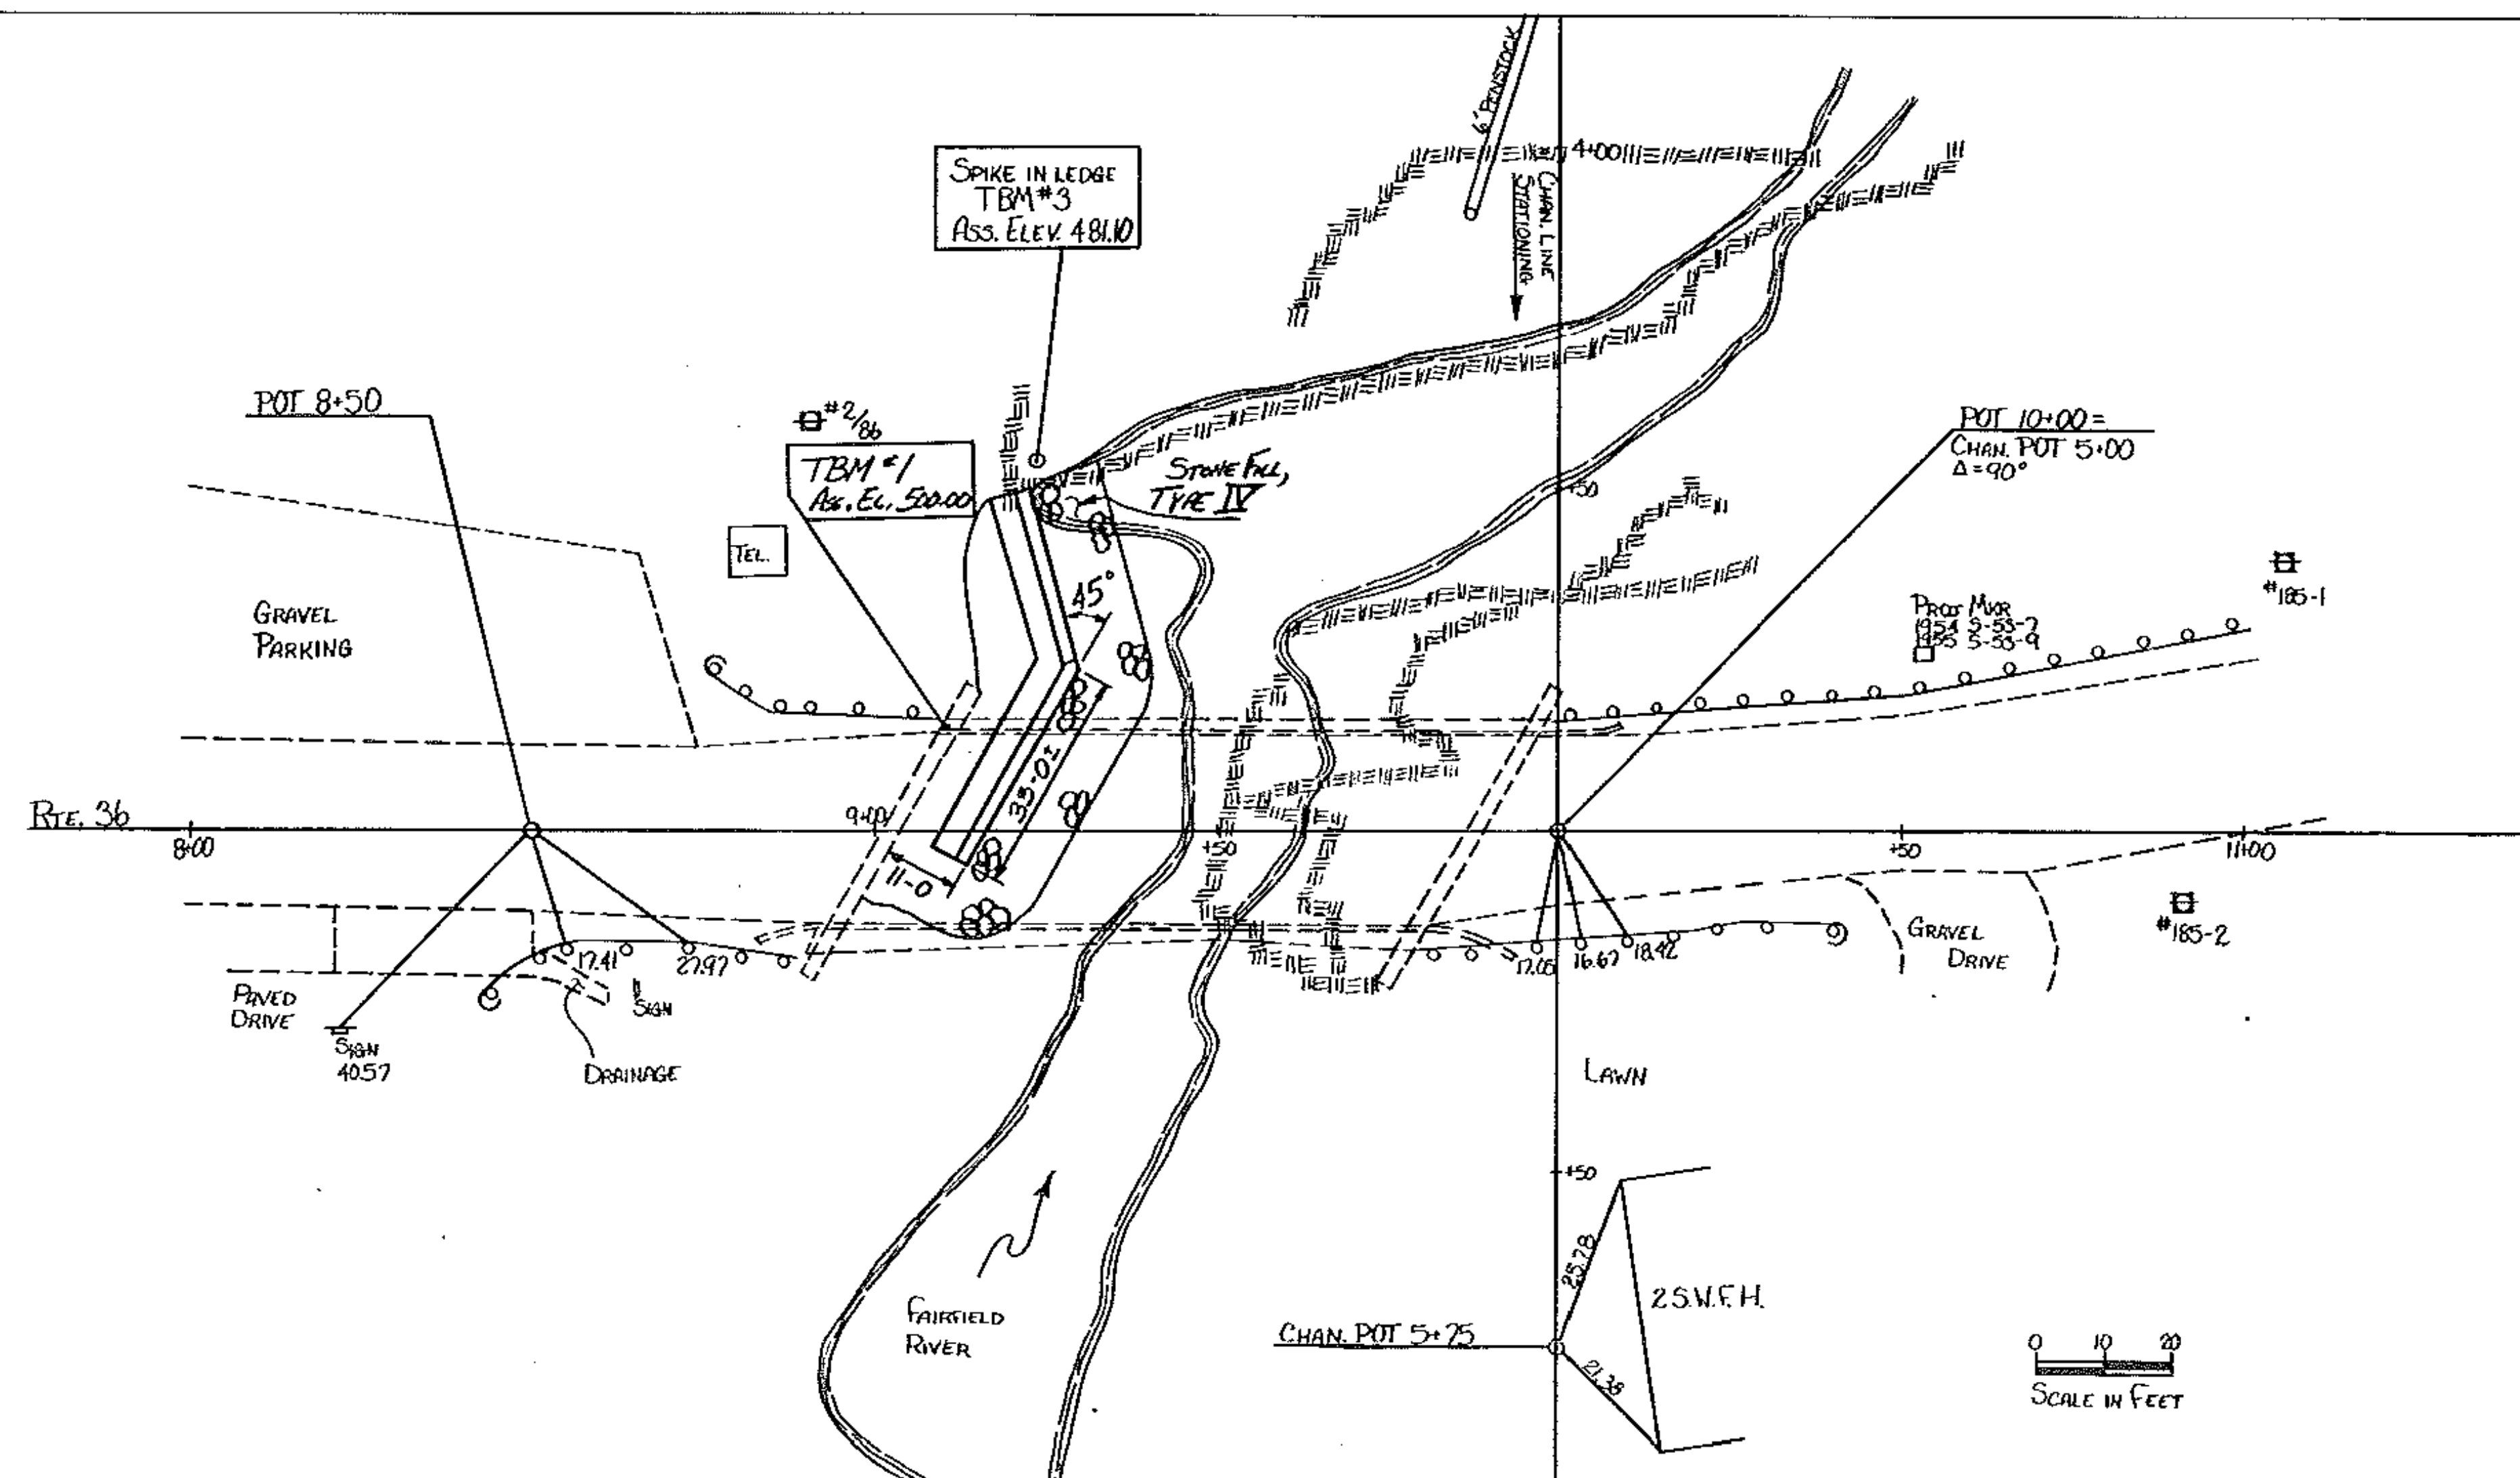


PROJECT	PROJECT No.
FAIRFIELD	ER 0298 (4) S
PLAN & PROFILE	
V/L R/F 30 OVER THE FAIRFIELD RIVER	
SHEET 3 OF	9 SHEETS

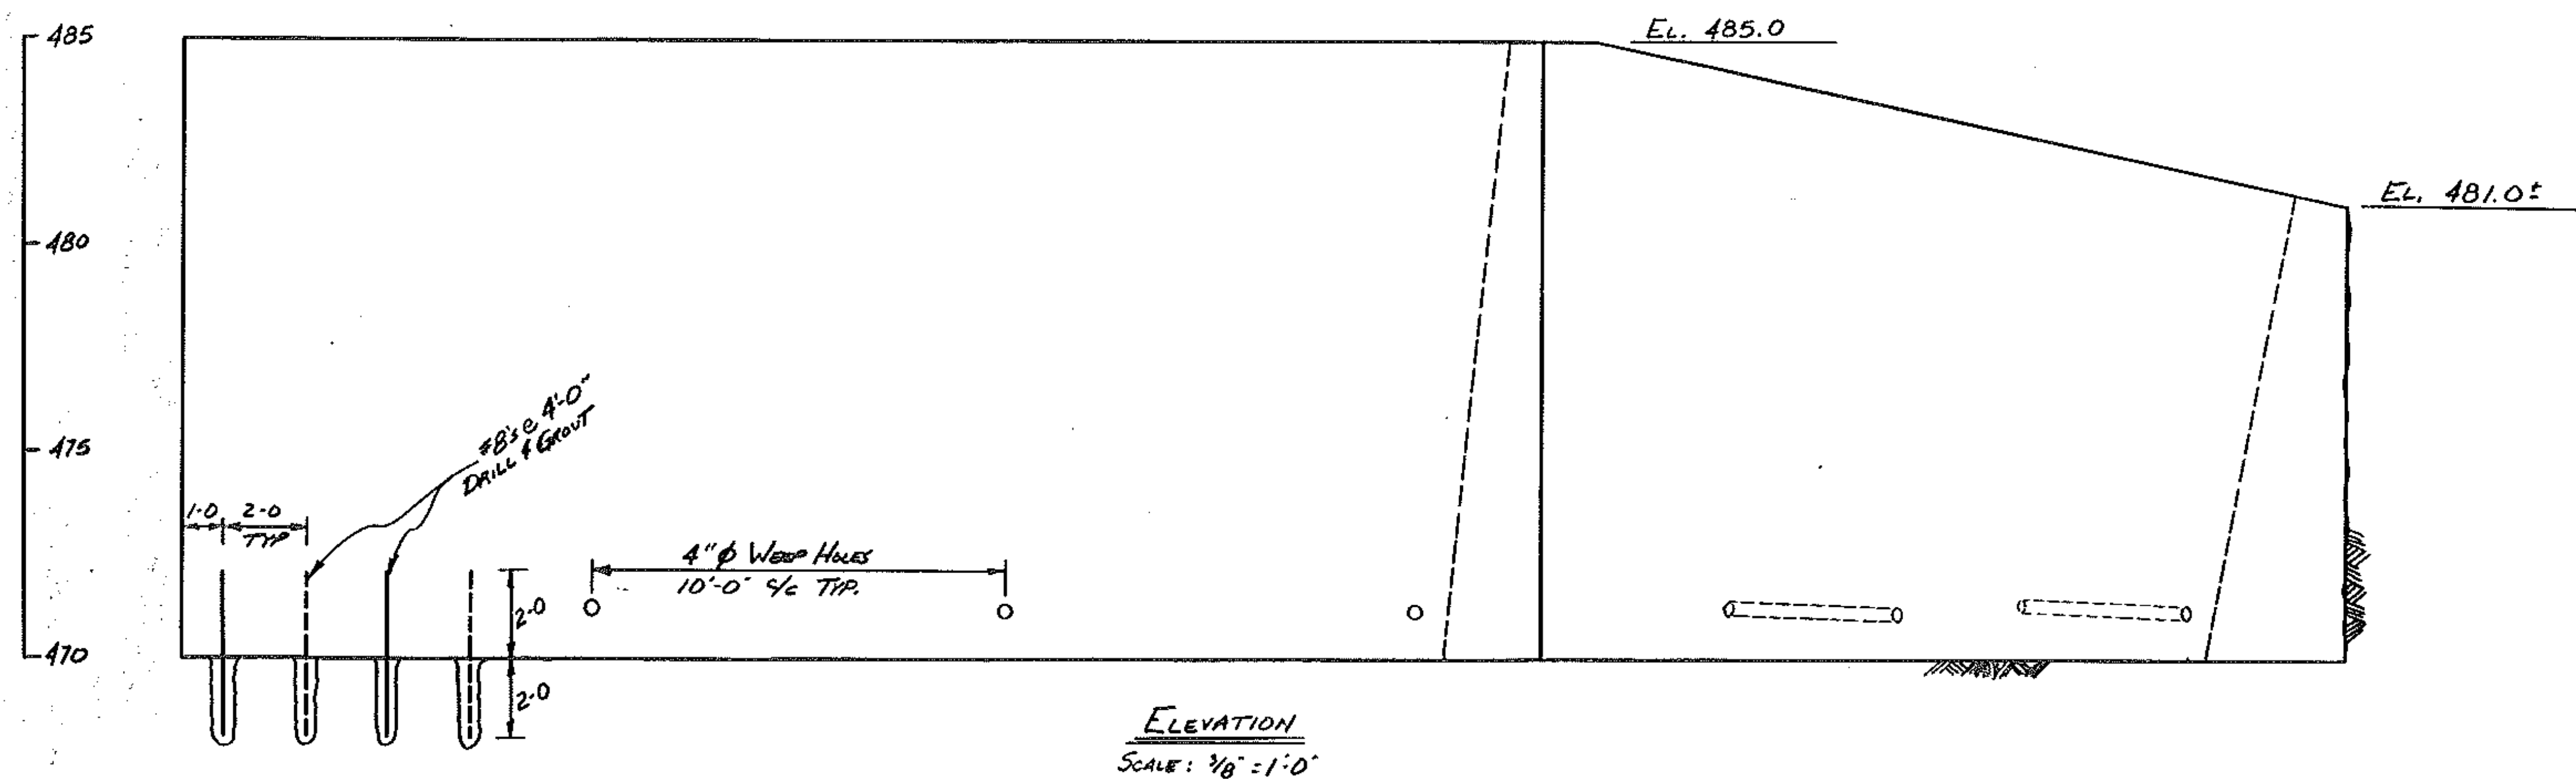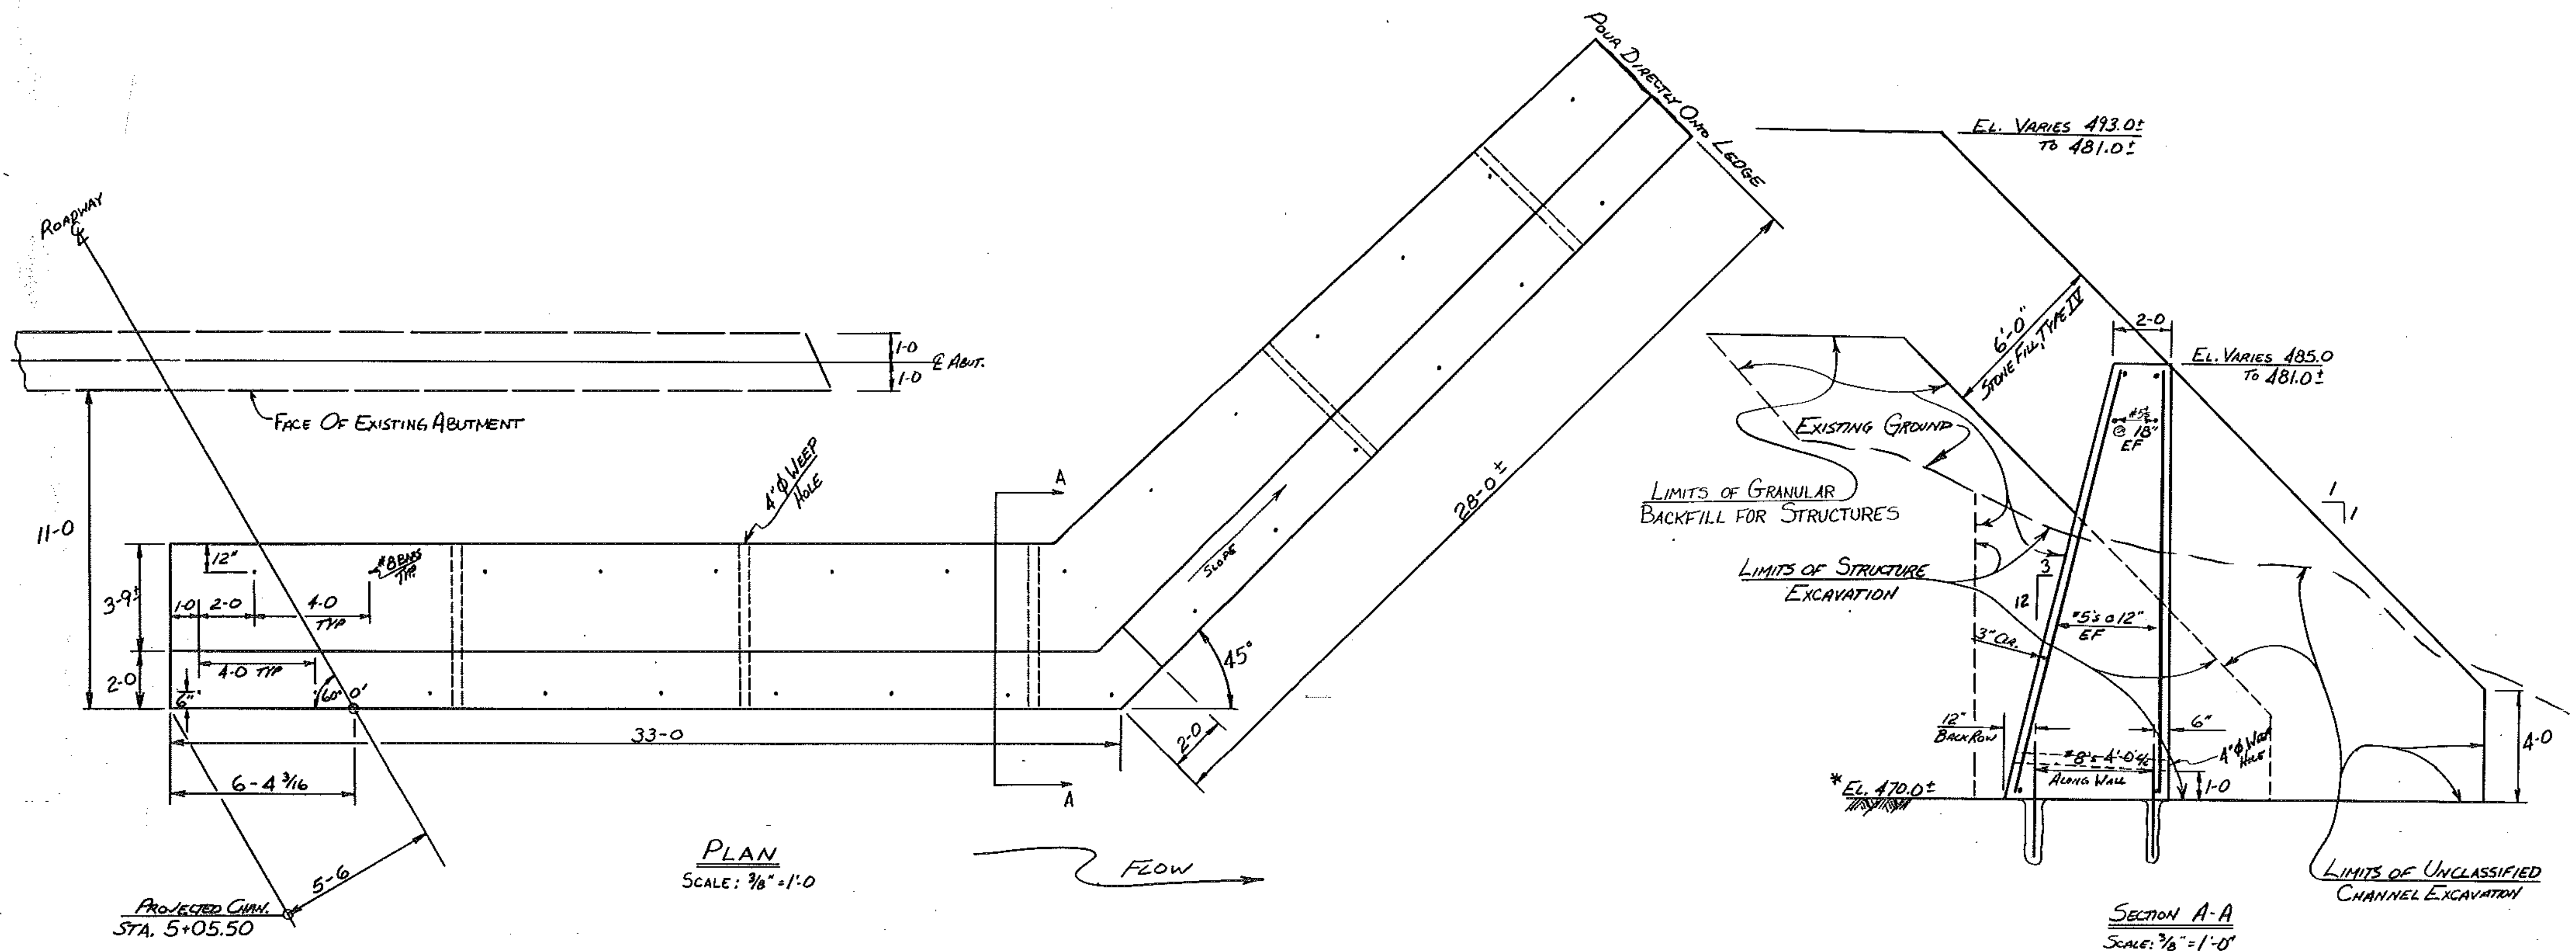


* GRAVITY WALL SECTION SHALL BE EXTENDED TO THE ACTUAL LEDGE ELEVATION. CONTACT THE STRUCTURES DIVISION IN THE EVENT THE ACTUAL LEDGE ELEVATION IS LESS THAN 465.0. TOE OF THE STONE FILL SHOULD ALSO EXTEND TO THE ACTUAL LEDGE ELEVATION.


STATE OF VERMONT AGENCY OF TRANSPORTATION			
Town of	FAIRFIELD	Bridge No.	6
Highway No.	VT. 36	Log Sta.	
		Surv. Sta.	
CONCRETE REMAINING WALL			
PLAN, ELEVATION & SECTION			
Designed By	A. ELWOOD	Drawn By	M. POLSANO
Checked By	A. ELWOOD	Bridge Design Supervisor	R.S. HAUT
	9/84	Date	9/84
PROJECT	FAIRFIELD	PROJECT NO.	ER 0298 (4)S
LOC. Info.			
Bridge Sheet No.		Sheet	4 of 9

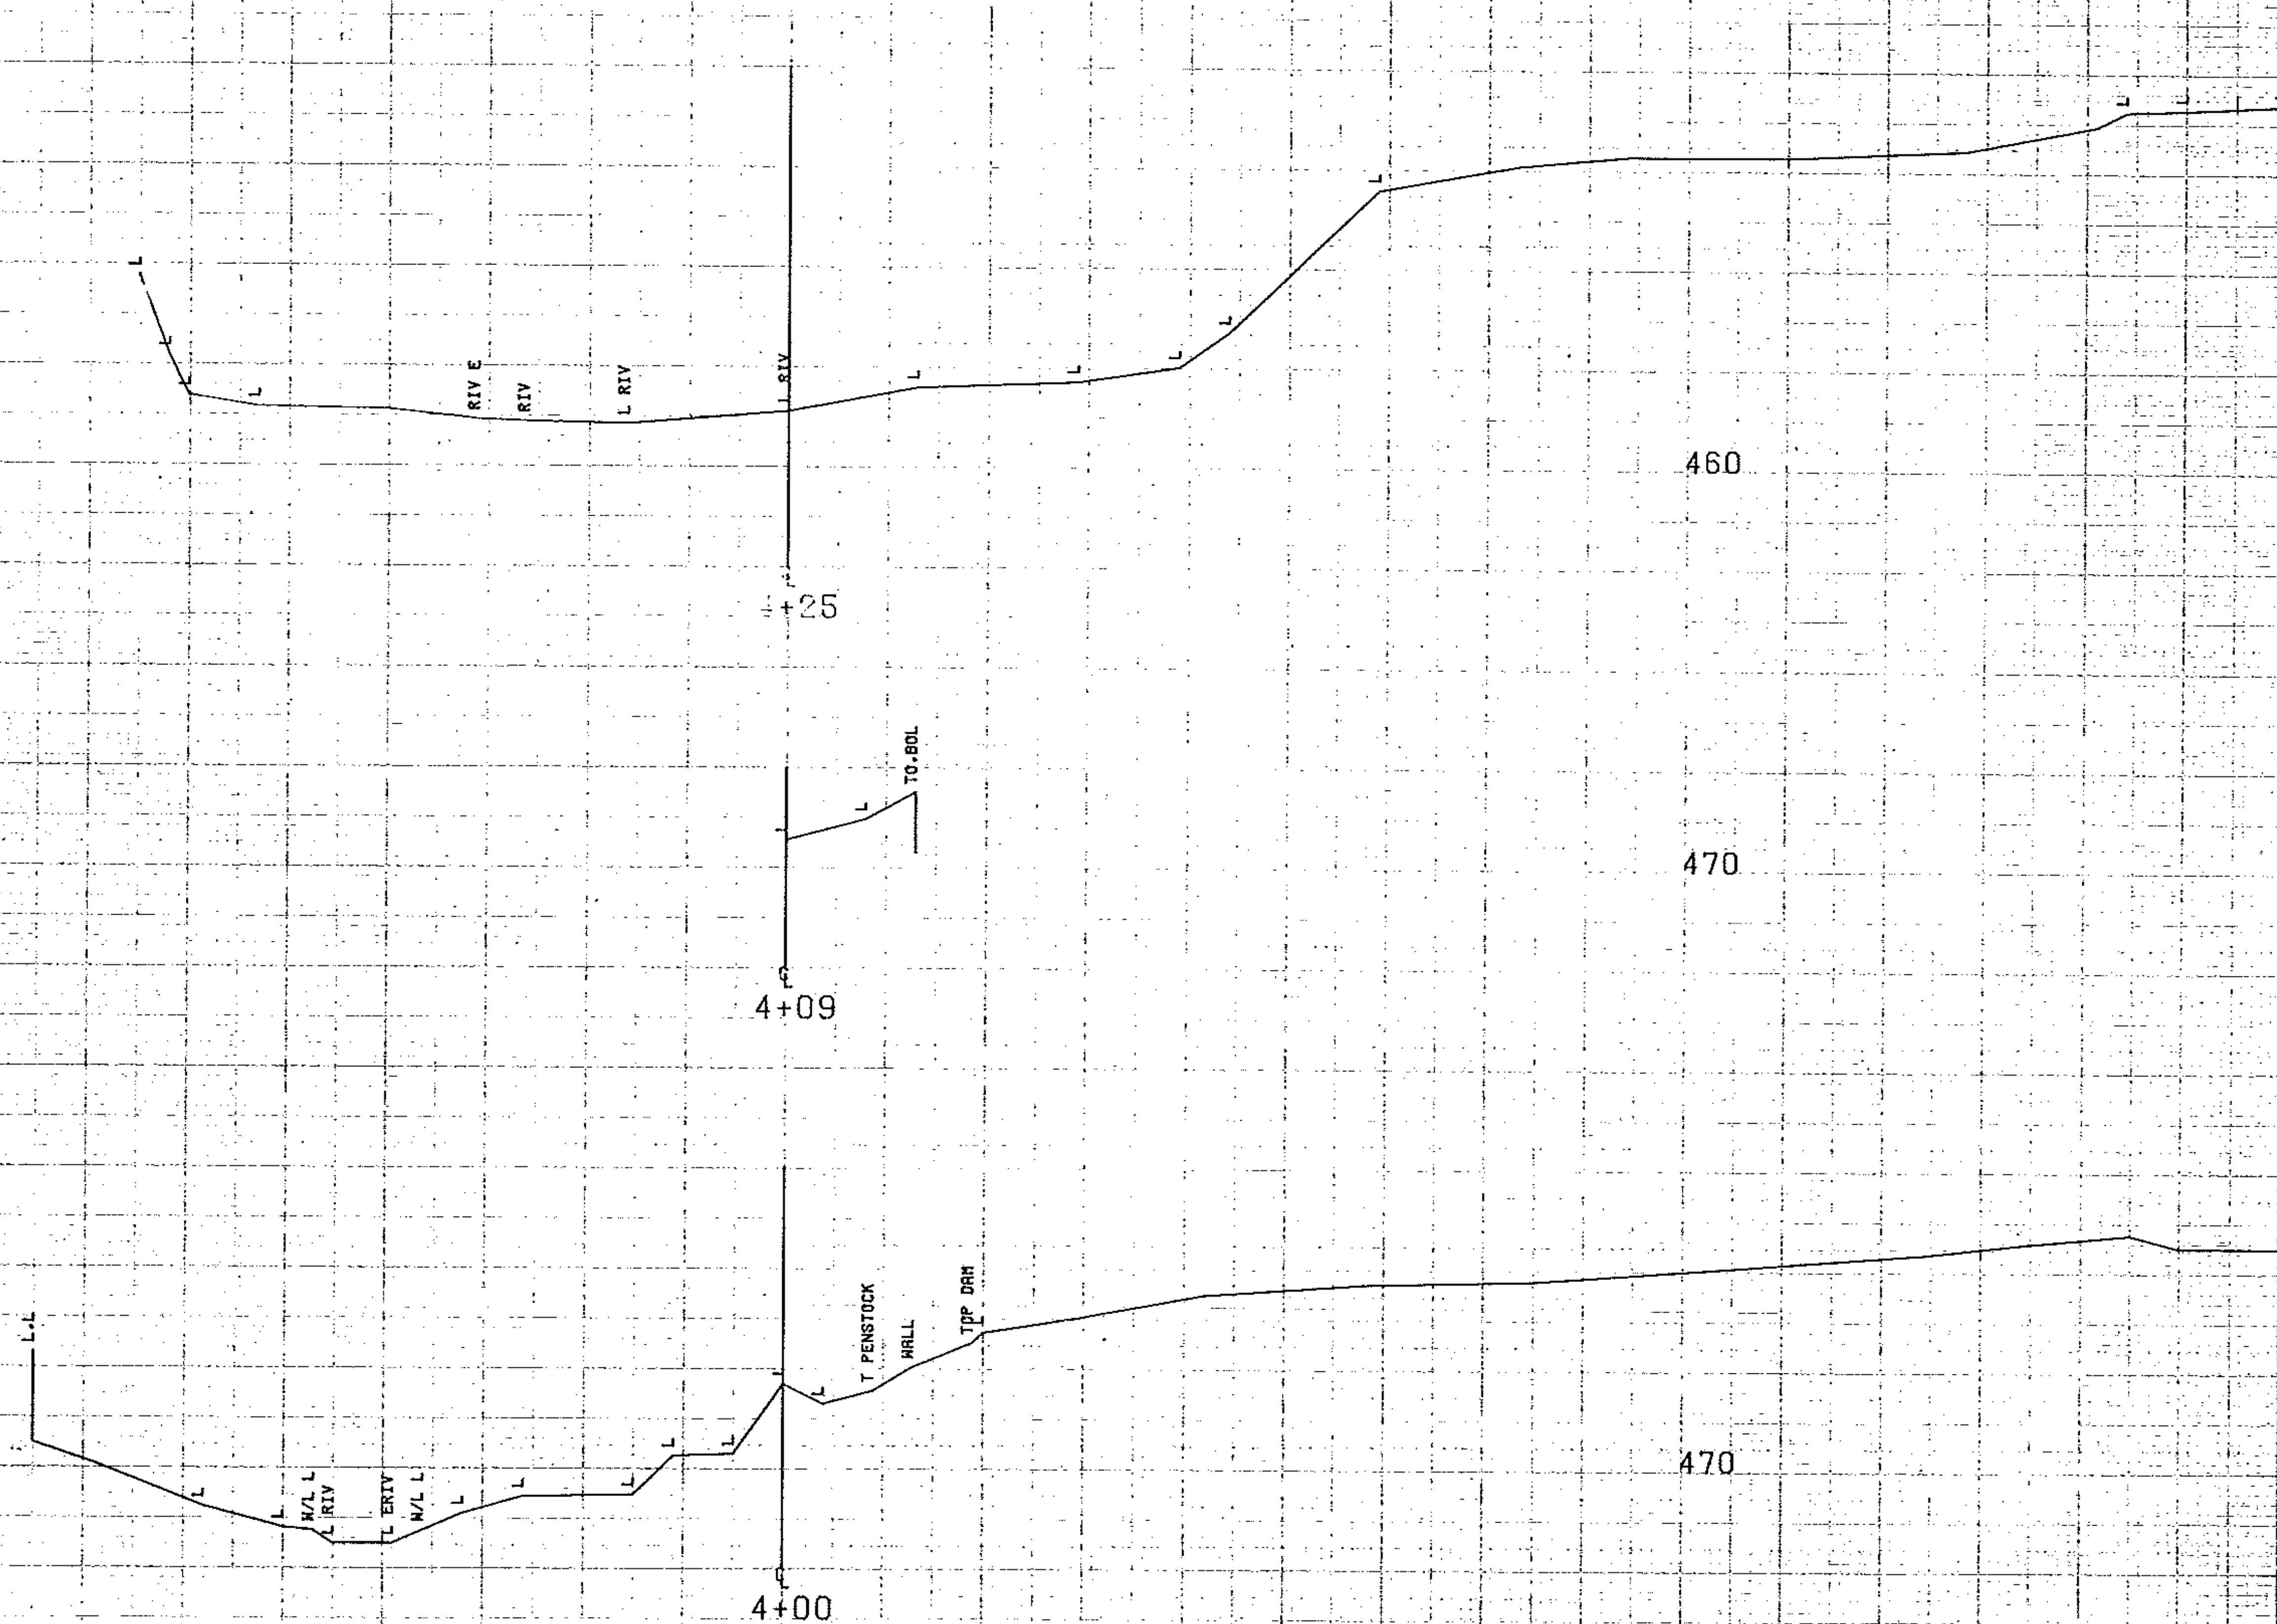


FROM STA.	4+00	TO STA.	4+25
PROJECT NAME	FAIRFIELD	CHAN	
NO.	20212/4	SPLOTTED	08/15/84
SURVEYED BY	FANTONI	AUGUST	1984
SHEET	3 OF 7	SHEETS	

SCALE 1" = 10 FEET

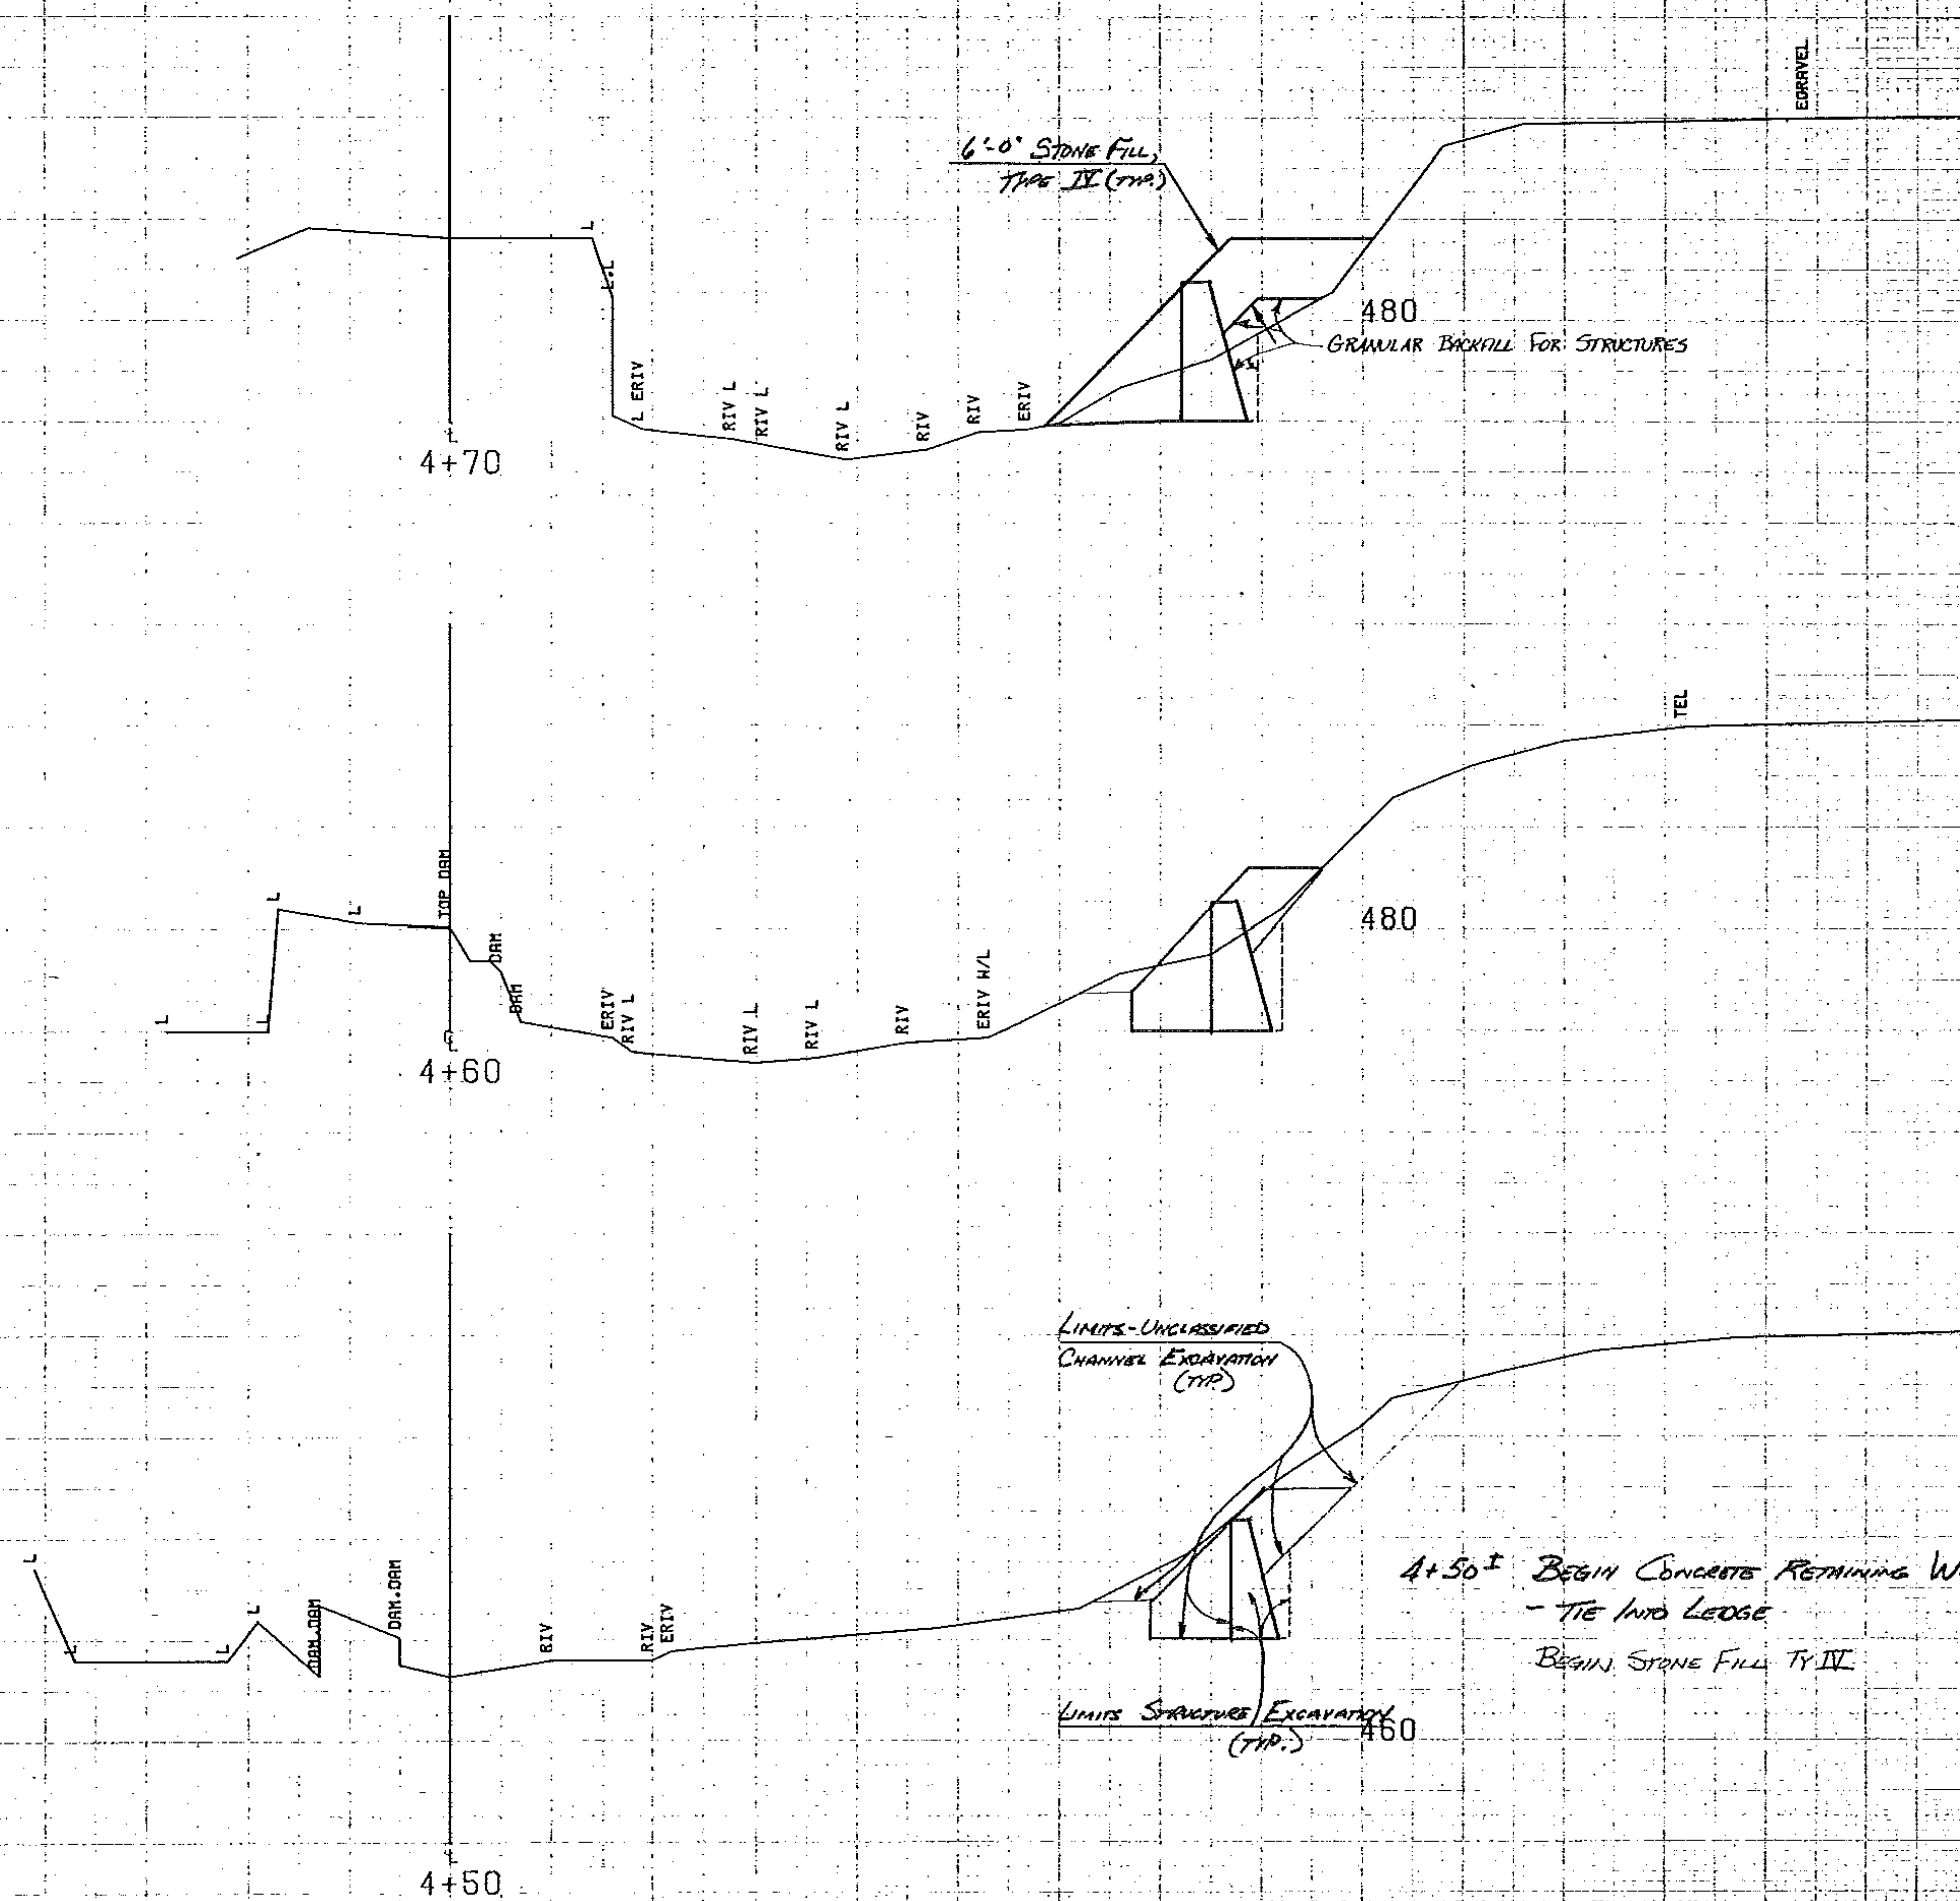

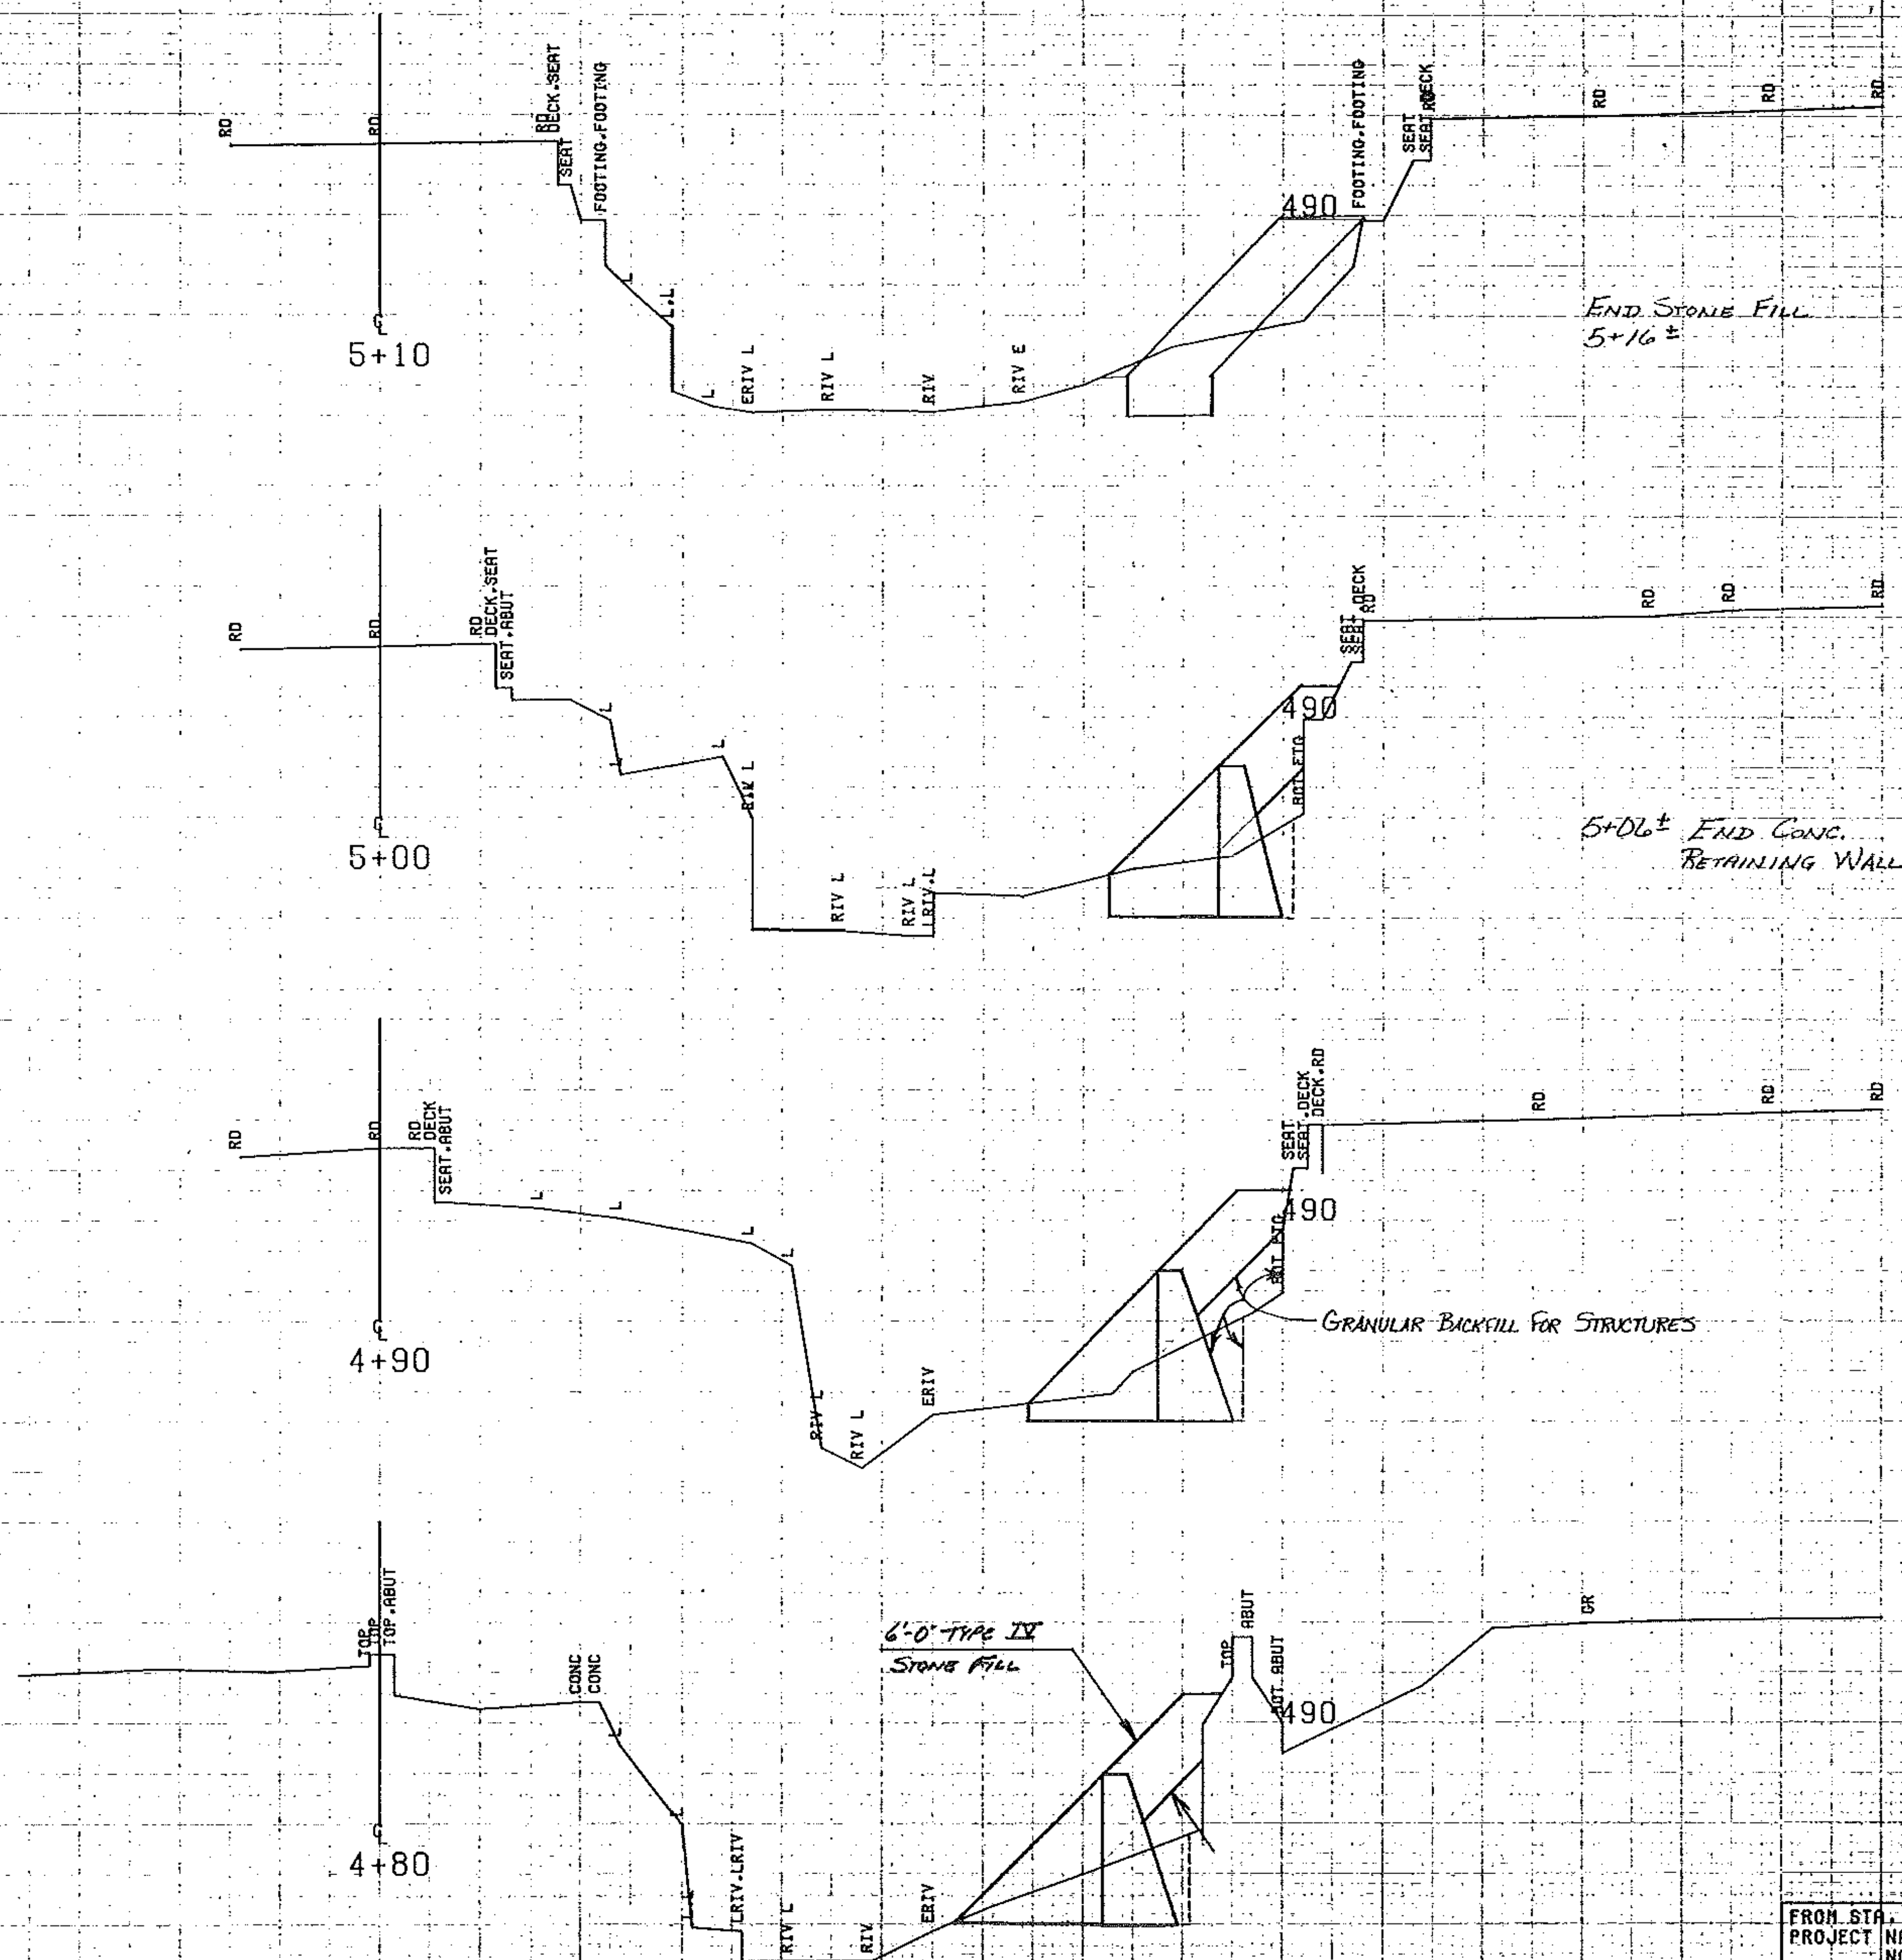

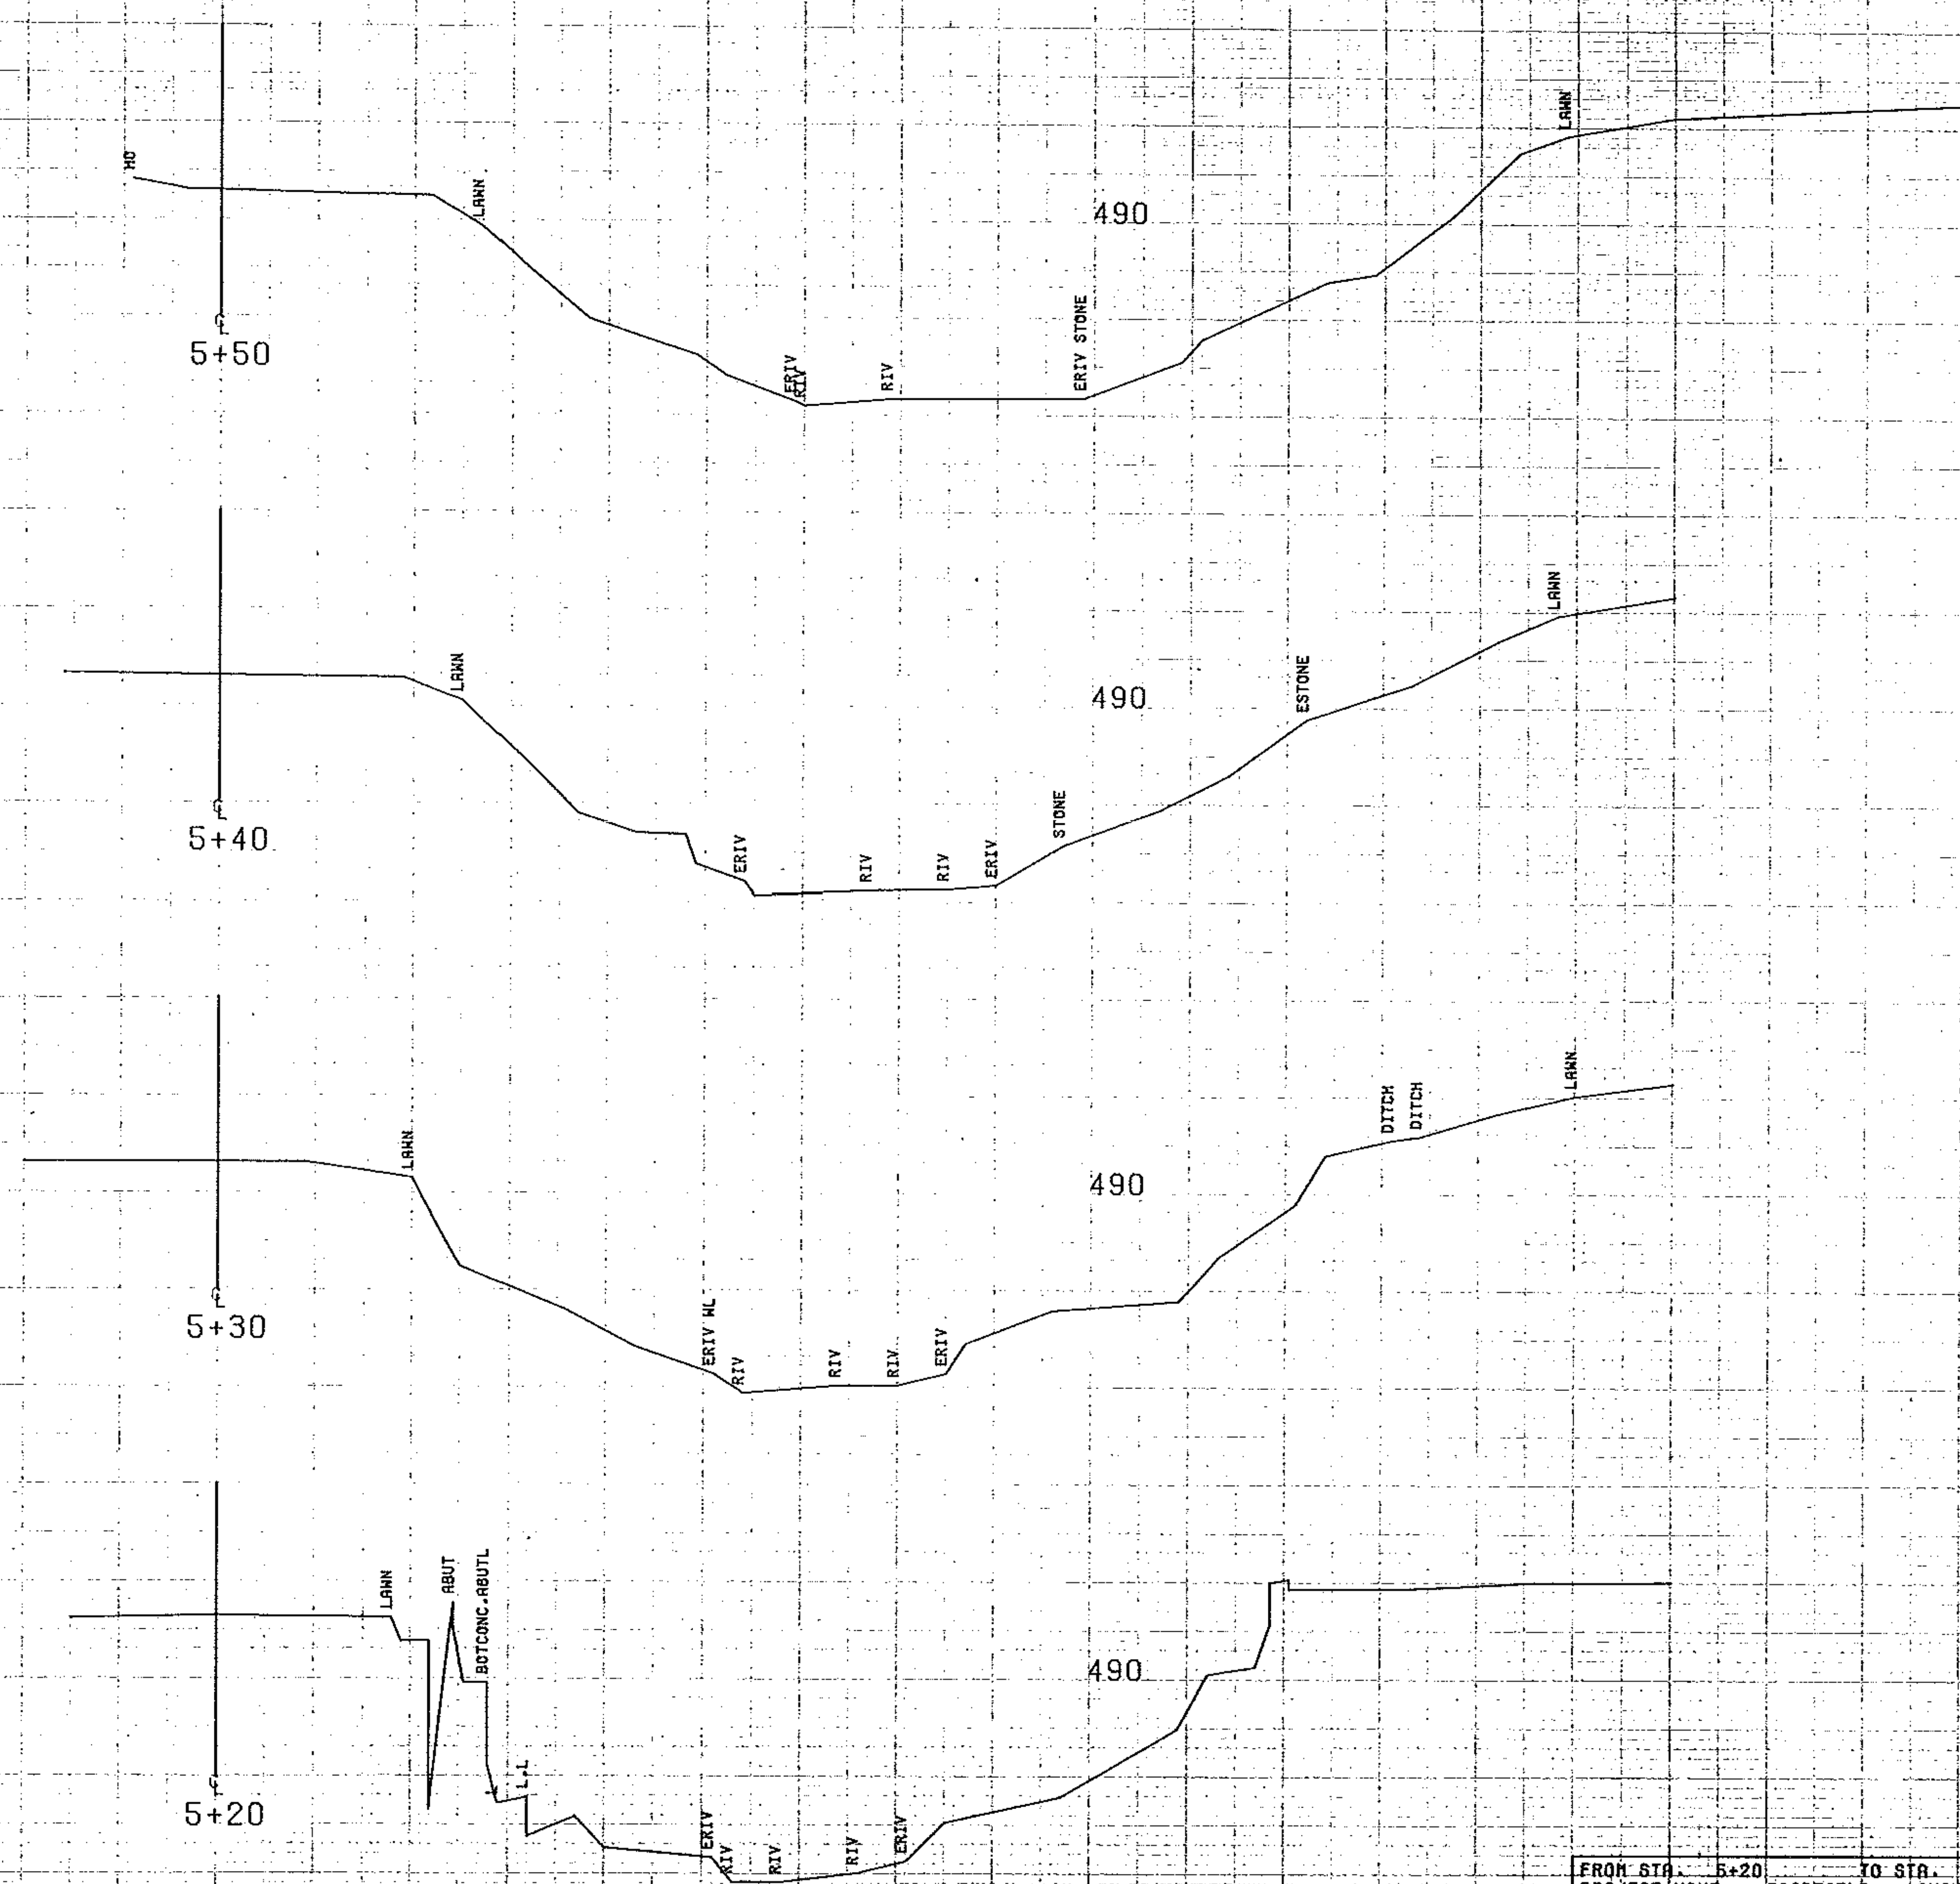

FROM STA.	5+20	TO STA.	5+50
PROJECT NAME	FAIRFIELD CHAN		
NO.	000003 (Kozak)		
SURVEYED BY	FANTONI		
SHEET	24	OF	25 SHEETS
AUGUST 1984		PLOTTED 08/15/84	

SCALE 10 FEET

