


# TYPICAL SECTIONS & DESIGN DATA

ITEM 406.25 BITUMINOUS CONCRETE PAVEMENT  
 LEVELING COURSE, TYPE III OR IV (250 TONS/MILE)  
 AS DIRECTED BY THE ENGINEER  
 1" WEARING COURSE (+ $\frac{1}{2}$ " ) TYPE III 22' WIDE

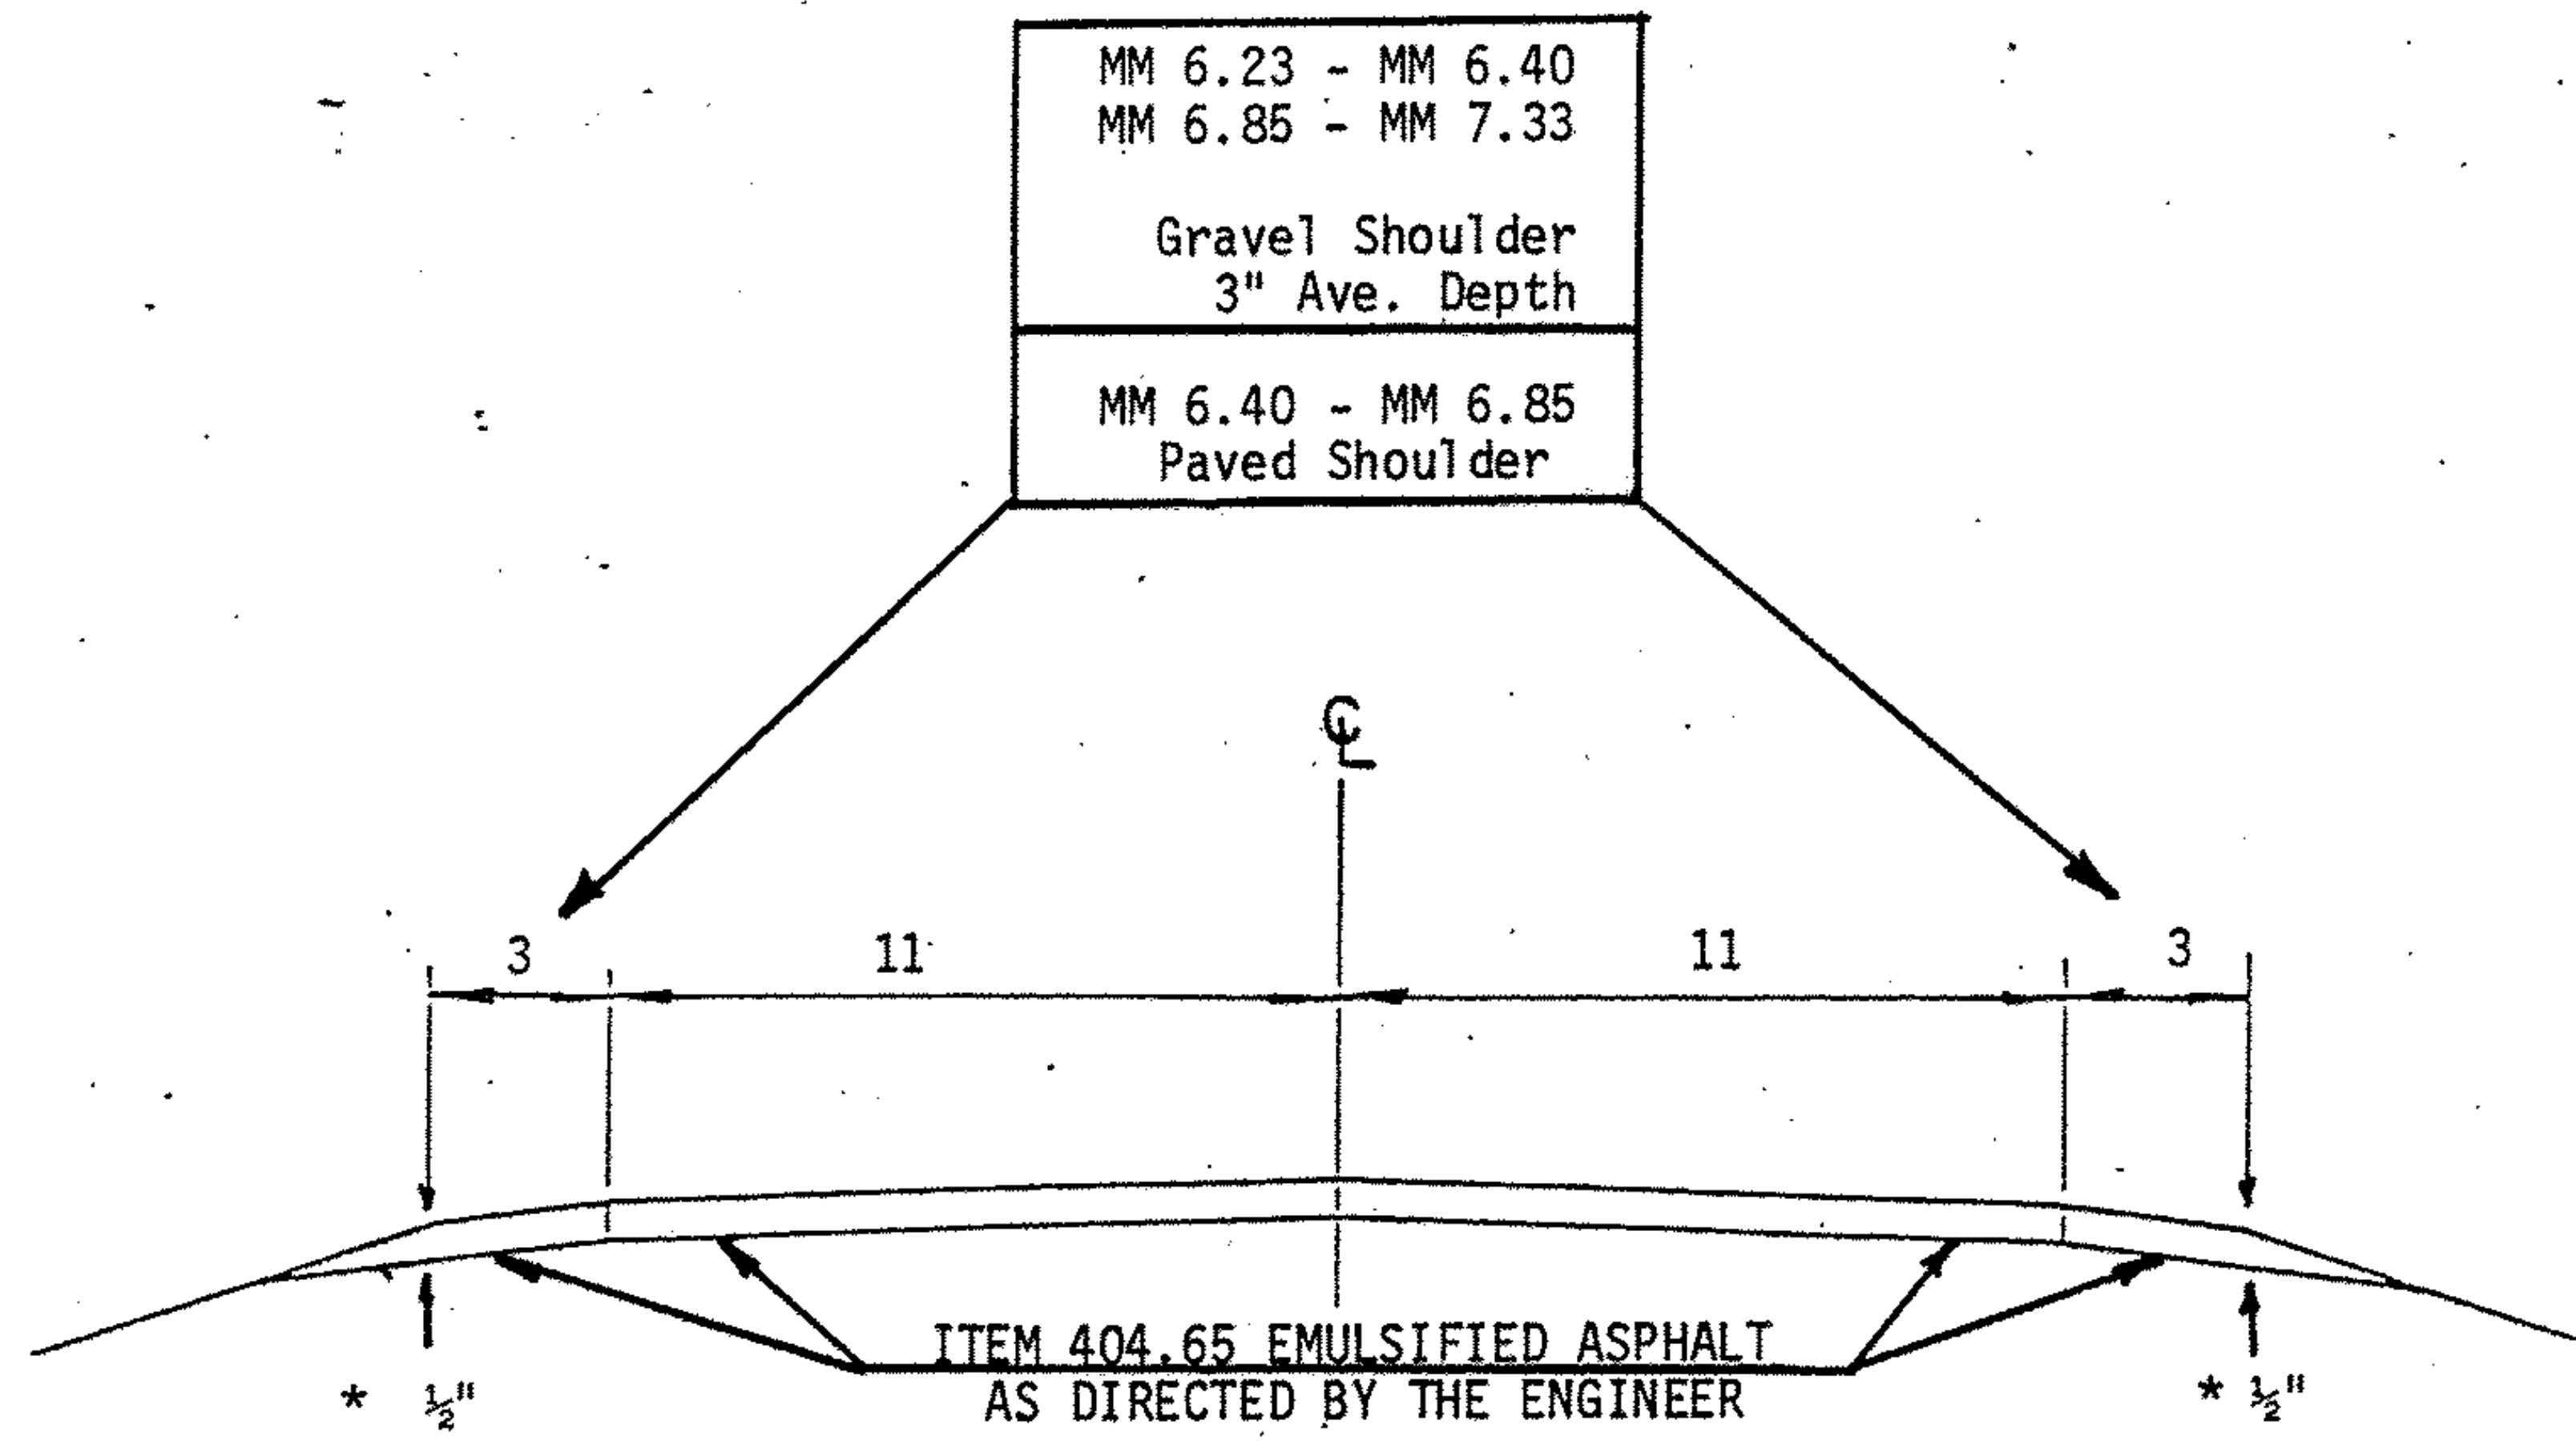

ITEM 404.65 EMULSIFIED ASPHALT  
 AS DIRECTED BY THE ENGINEER

MARSHFIELD

MM 6.232 - MM 7.333

### TRAFFIC DATA

1982 ADT. = 2790  
 V = 35 MPH

\*Shoulder to be tapered from full depth to  $\frac{1}{2}$ ".

PROJECT MARSHFIELD

NO. HMA 2520

SHEET 3 OF 10 SHEETS