


DETAILS

- ITEM 646.63 DURABLE CROSSWALK MARKING w/ DIAGONAL LINES
- ITEM 675.20 TRAFFIC SIGNS, TYPE A
- ITEM 675.35 TRAFFIC SIGN POSTS, TYPE A

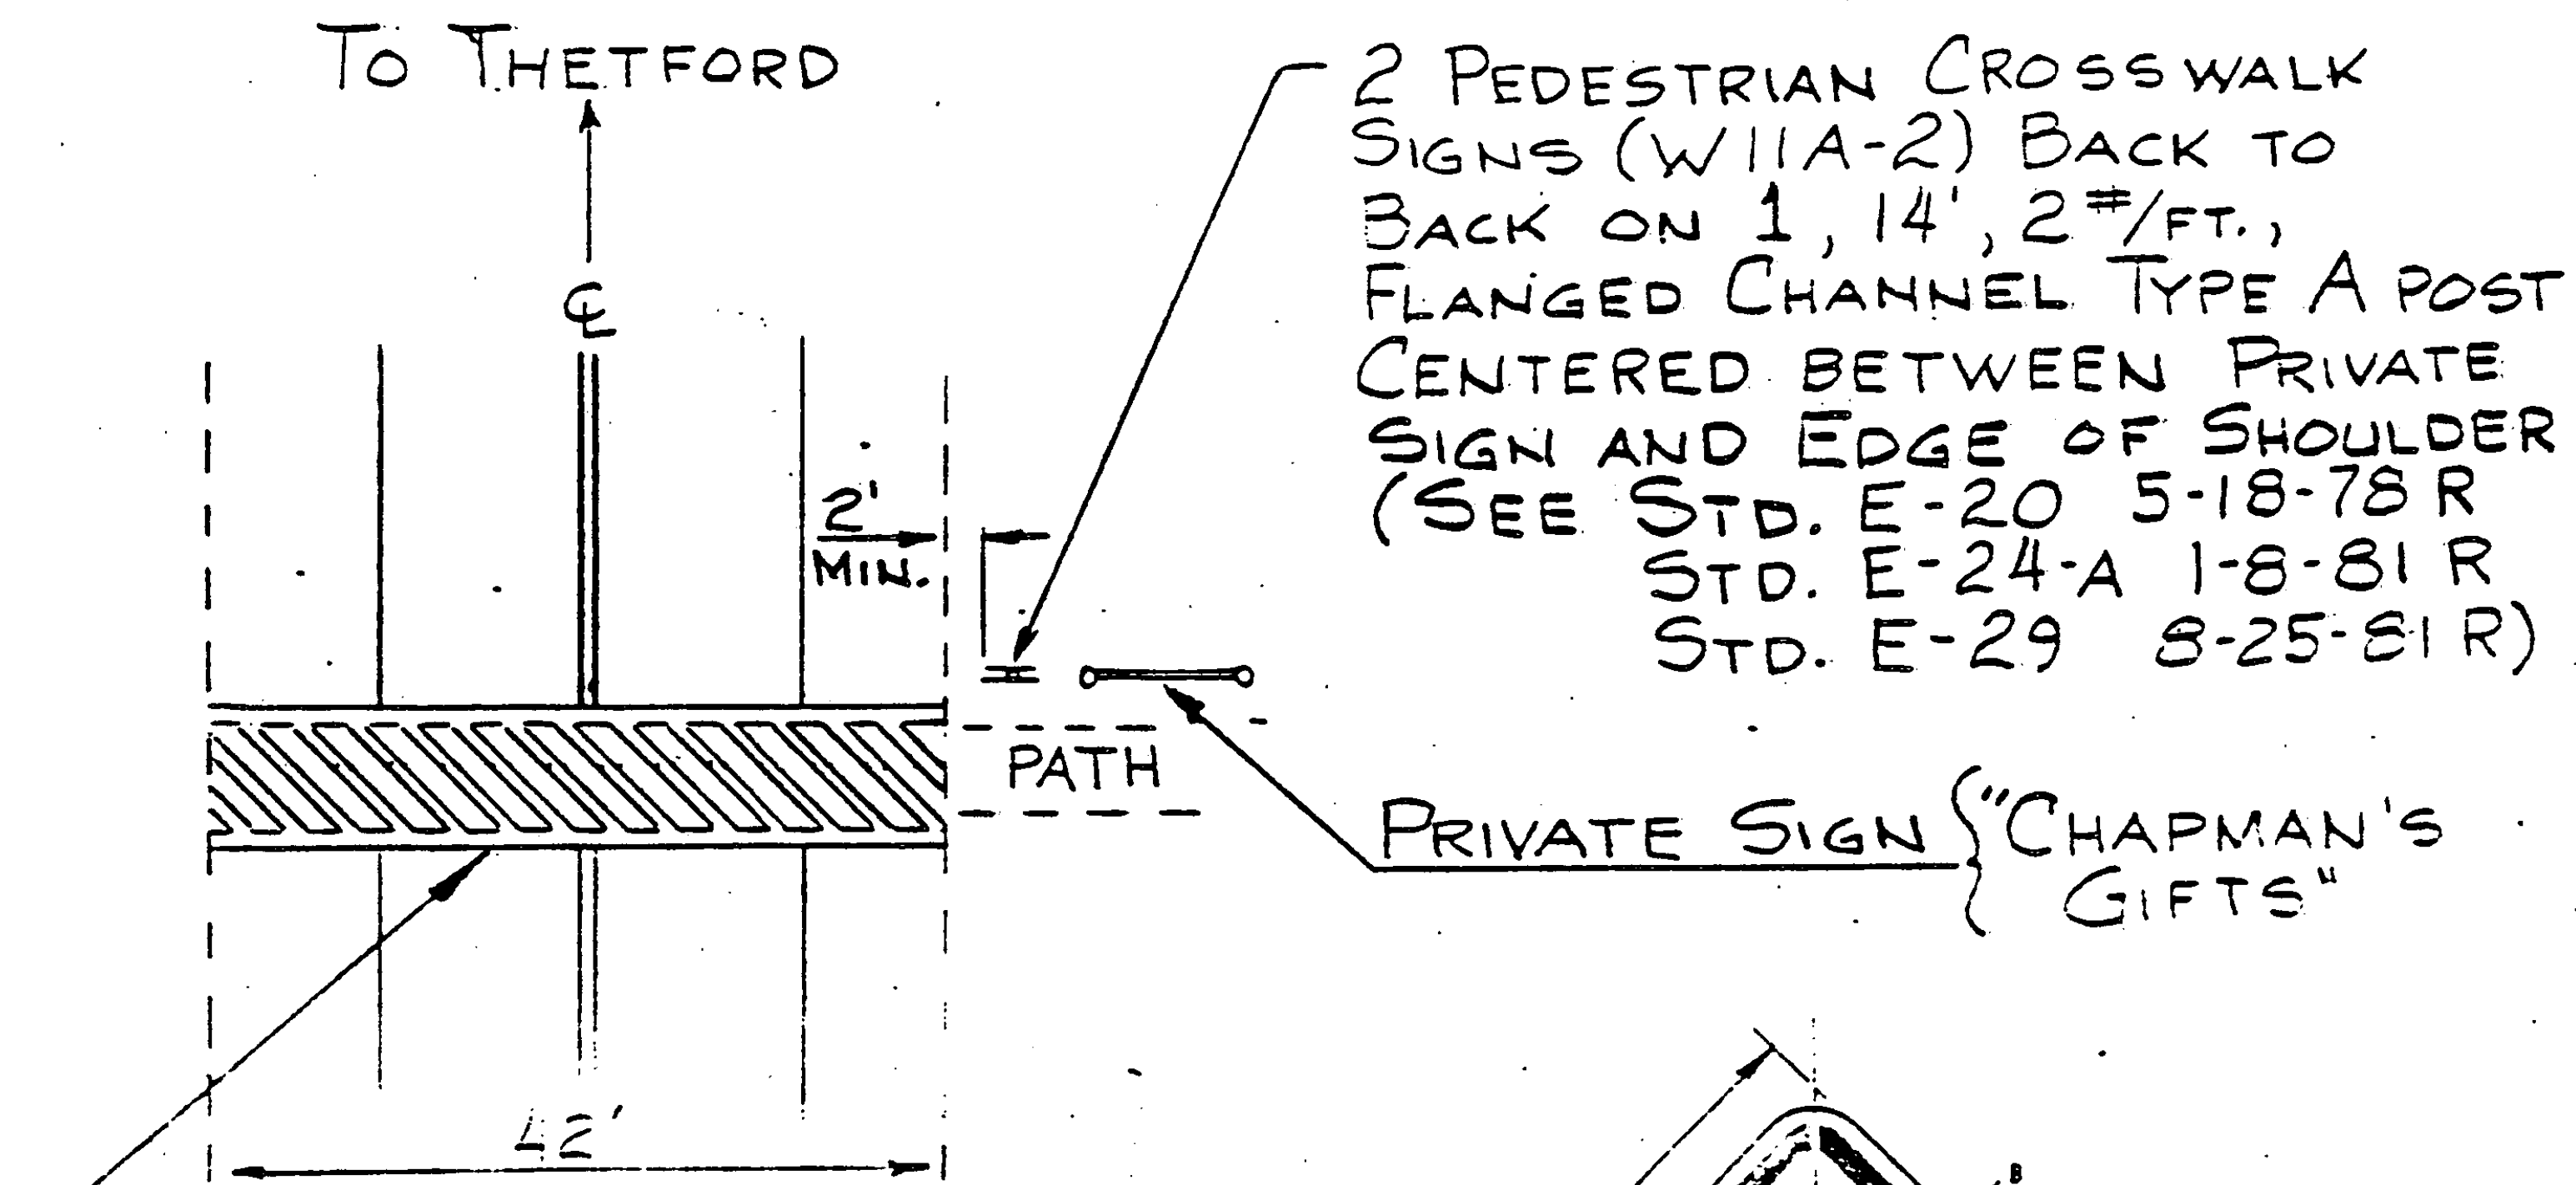

CROSSWALK AT INV. 3.25
(SEE STD. E-50 3-16-82 R)

SIGN	DIMENSIONS (INCHES)									
	A	B	C	D	E	F	G	H	J	
STD.	30	1/2	3/4	14	8	1-1/2	4	6	1-7/8	

COLORS
LEGEND - BLACK (NON-REFL)
BACKGROUND - YELLOW (REFL)

DIMENSIONS AND DETAIL FOR W11A-2 SIGN

