


PROJECT DESCRIPTION AND LOCATION

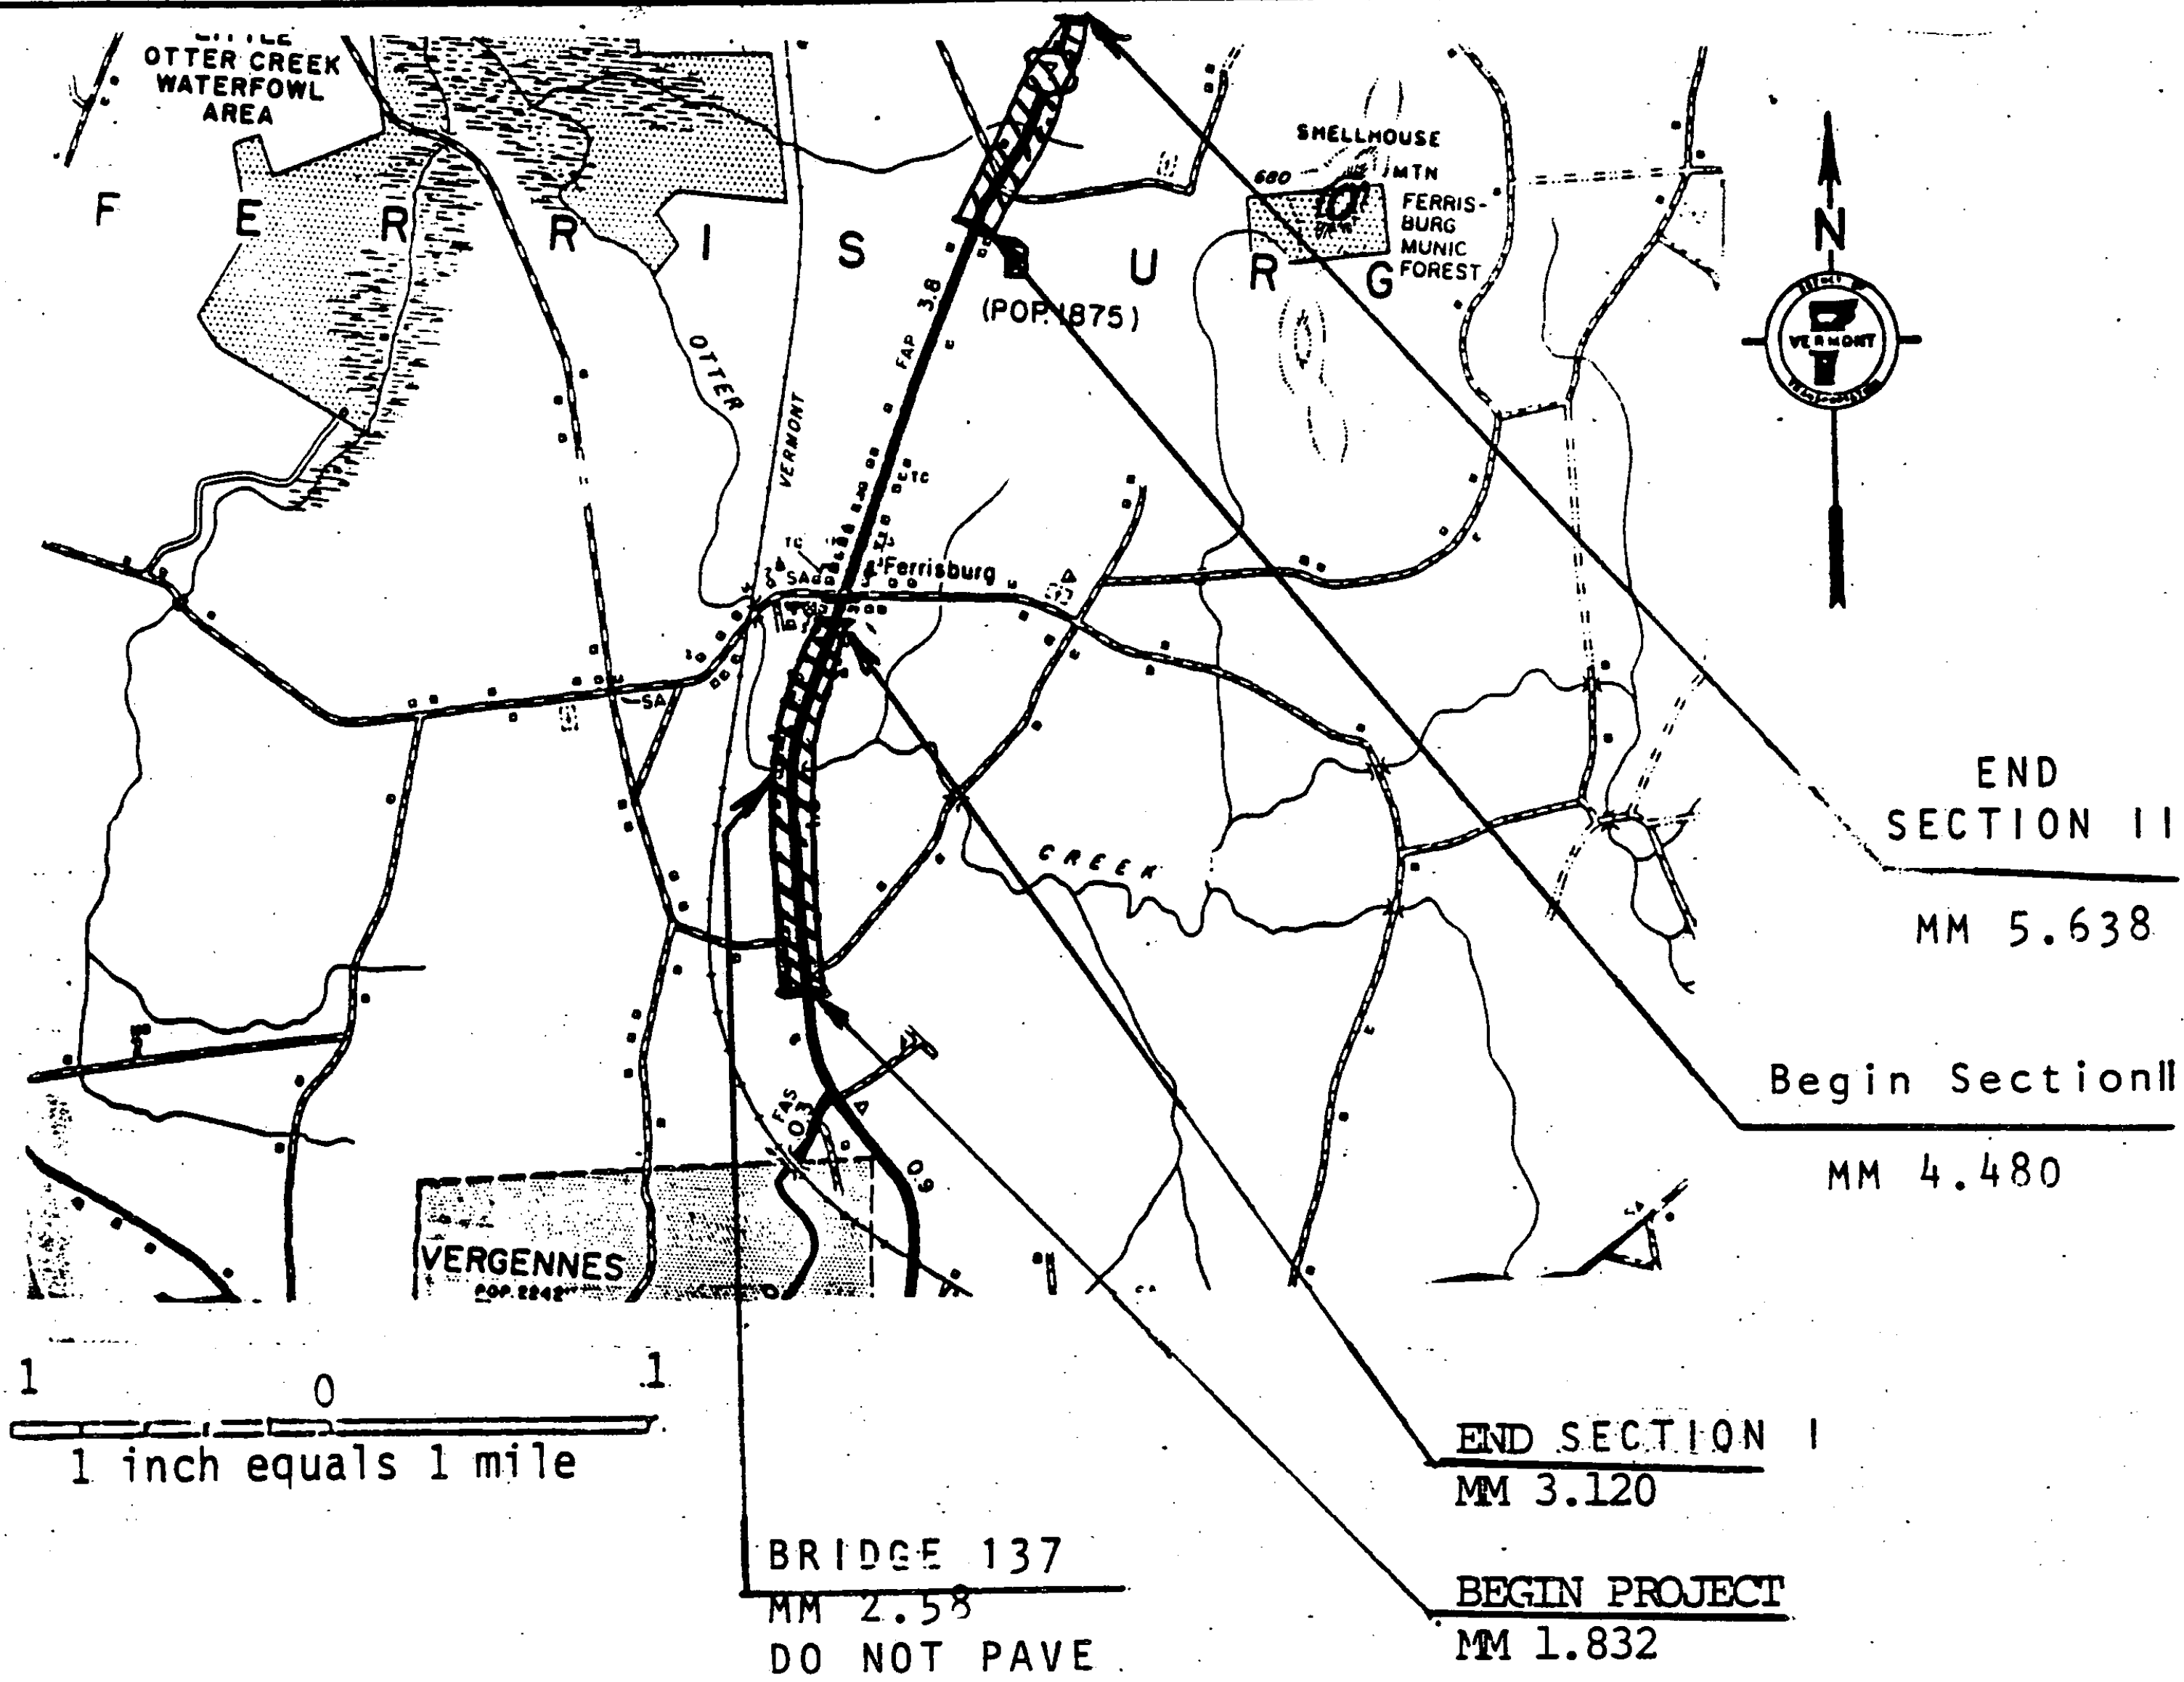

On US 7, Beginning 1.832 miles northerly of the Waltham-Ferrisburg Town Line at MM 1.832 and extending 1.288 miles northerly to MM 3.120. Beginning, again, at MM 4.480 and extending northerly 1.158 miles to MM 5.638

LENGTH OF PROJECT:	
Section I	1.288 Miles 6800 Feet
Section II	1.158 Miles 6144 Feet
TOTAL	2.446 Miles 12,944 Feet