



TYPICAL SECTIONS & DESIGN DATA

ITEM 406.25 BITUMINOUS CONCRETE PAVEMENT
 Leveling course, Type III or IV (.164 tons/mile)
 AS DIRECTED BY THE ENGINEER
 1½" Wearing course (+½") Type III

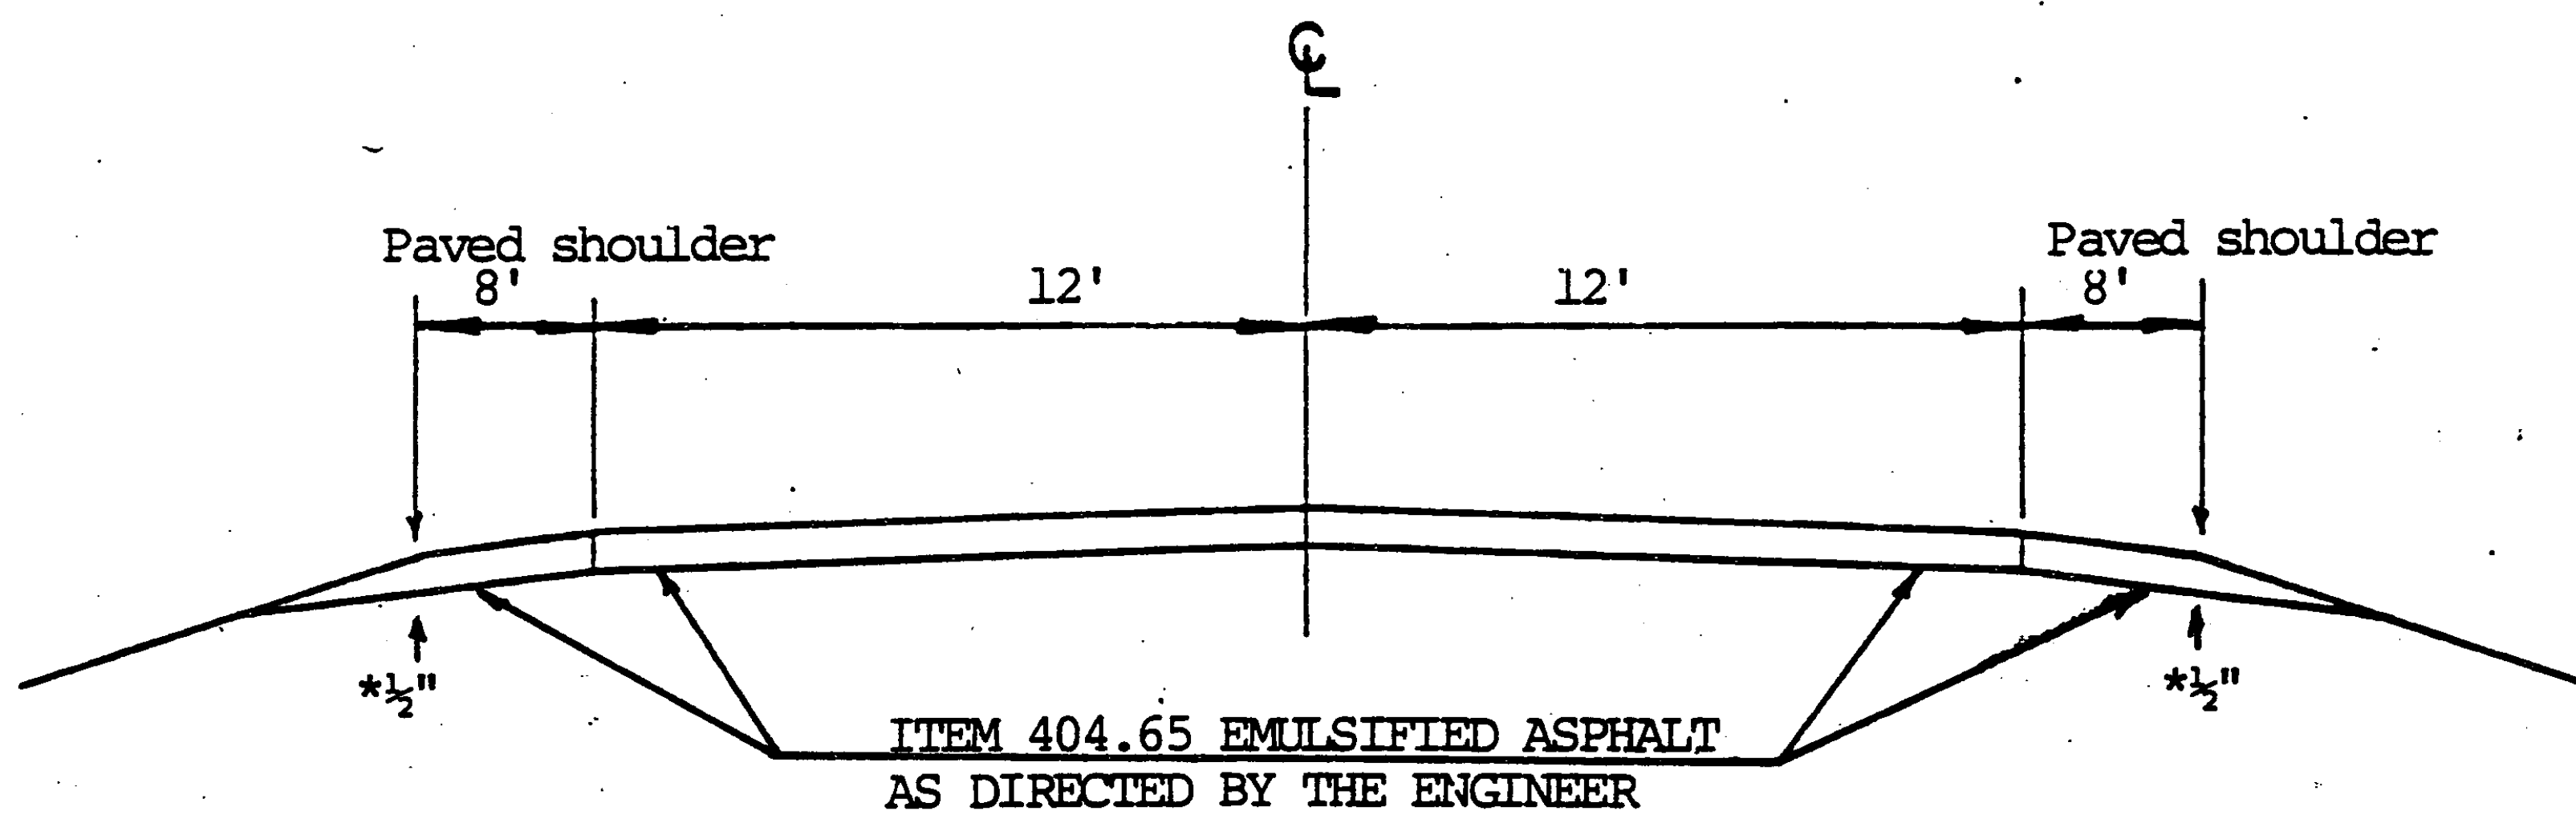

MM 1.832 - MM 3.020
 MM 4.480 - MM 5.638

ITEM 406.25 BITUMINOUS CONCRETE PAVEMENT
 Leveling course, Type III or IV (.164 tons/mile)
 AS DIRECTED BY THE ENGINEER
 1½" Wearing course (+½") Type III

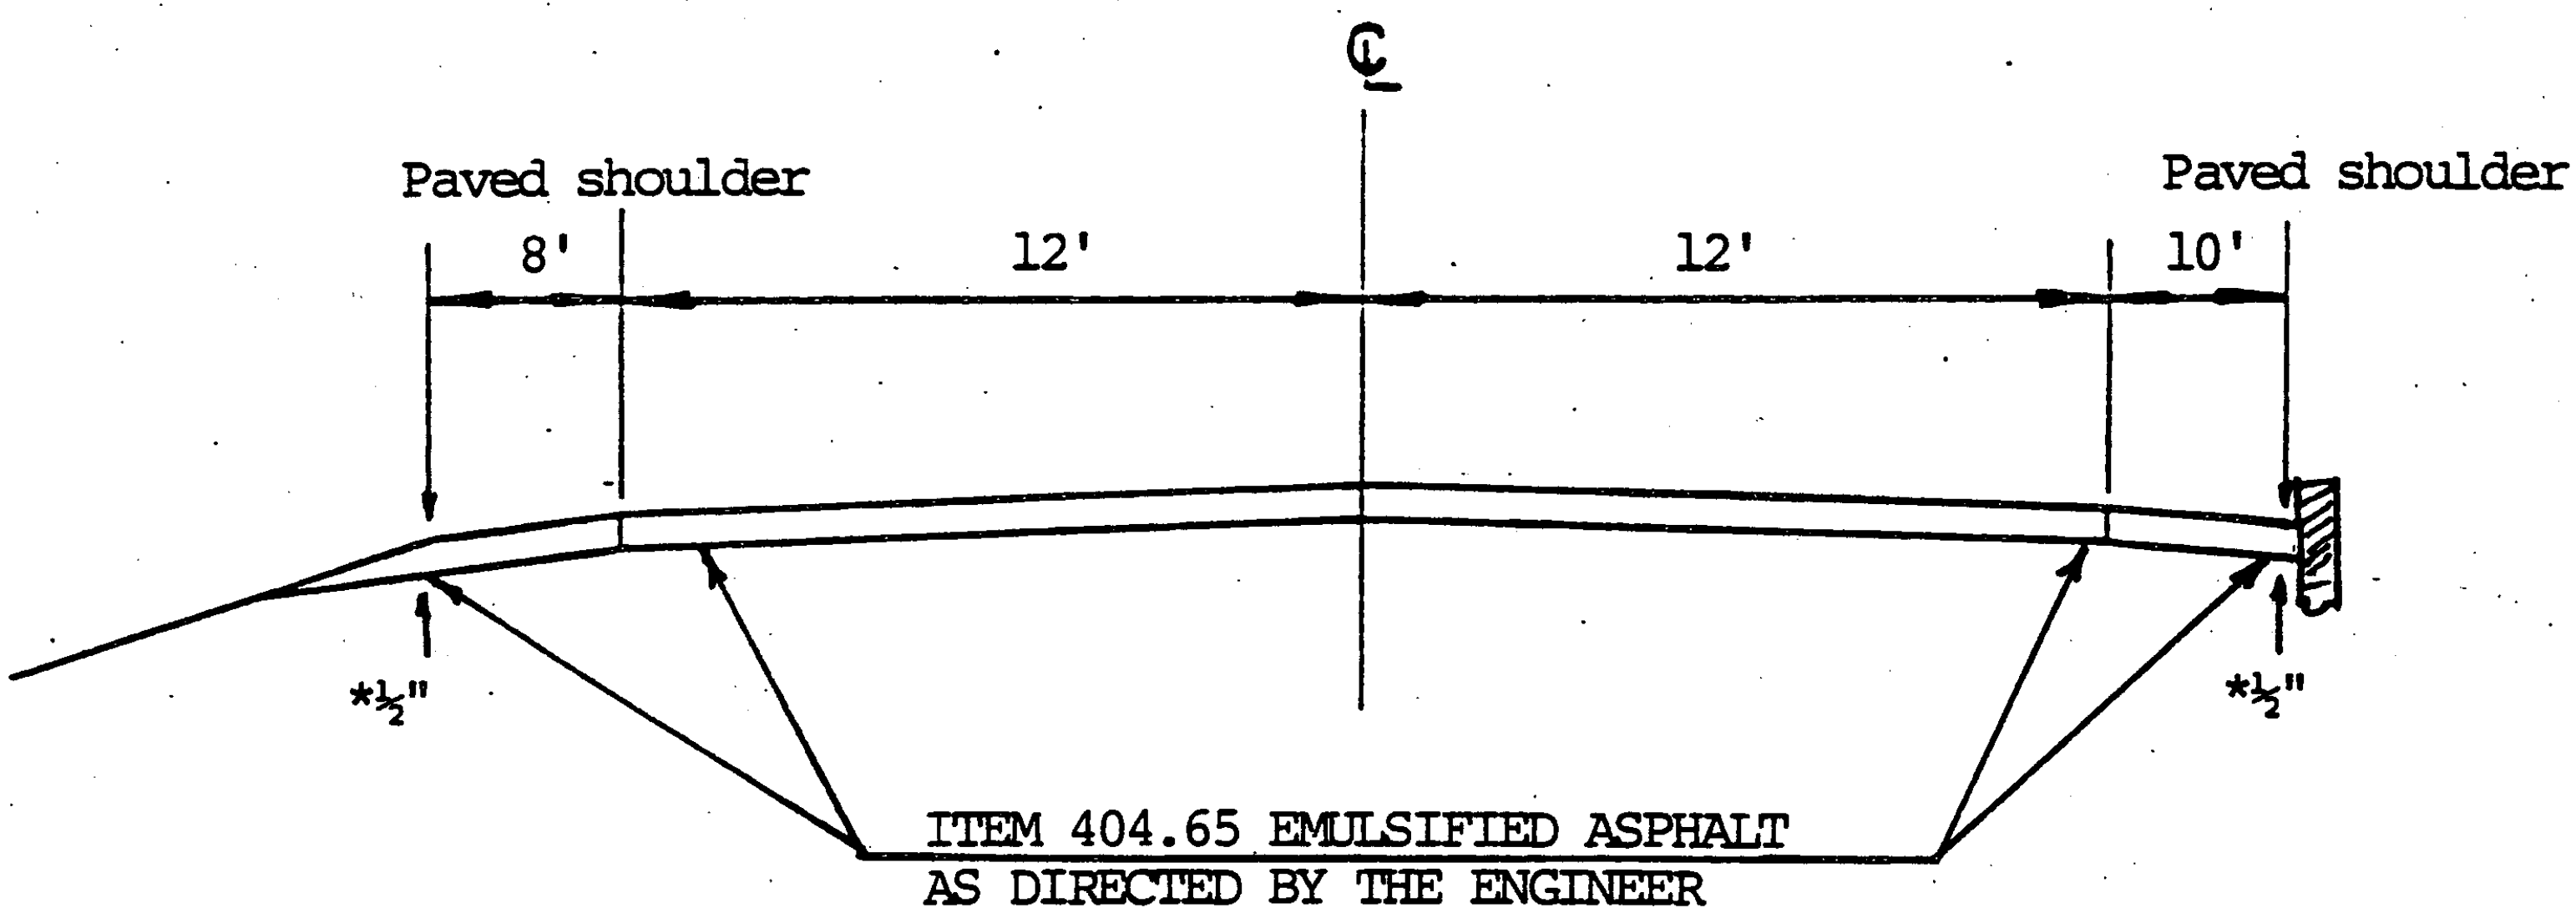

MM 3.020 - MM 3.120

TRAFFIC DATA
 1982 ADT-7890
 V=50 MPH

* Shoulder to be tapered from full depth to ½"

PROJECT FERRISBURG

NO. HMA 2517
 SHEET 3 OF 11