


PROJECT DESCRIPTION AND LOCATION

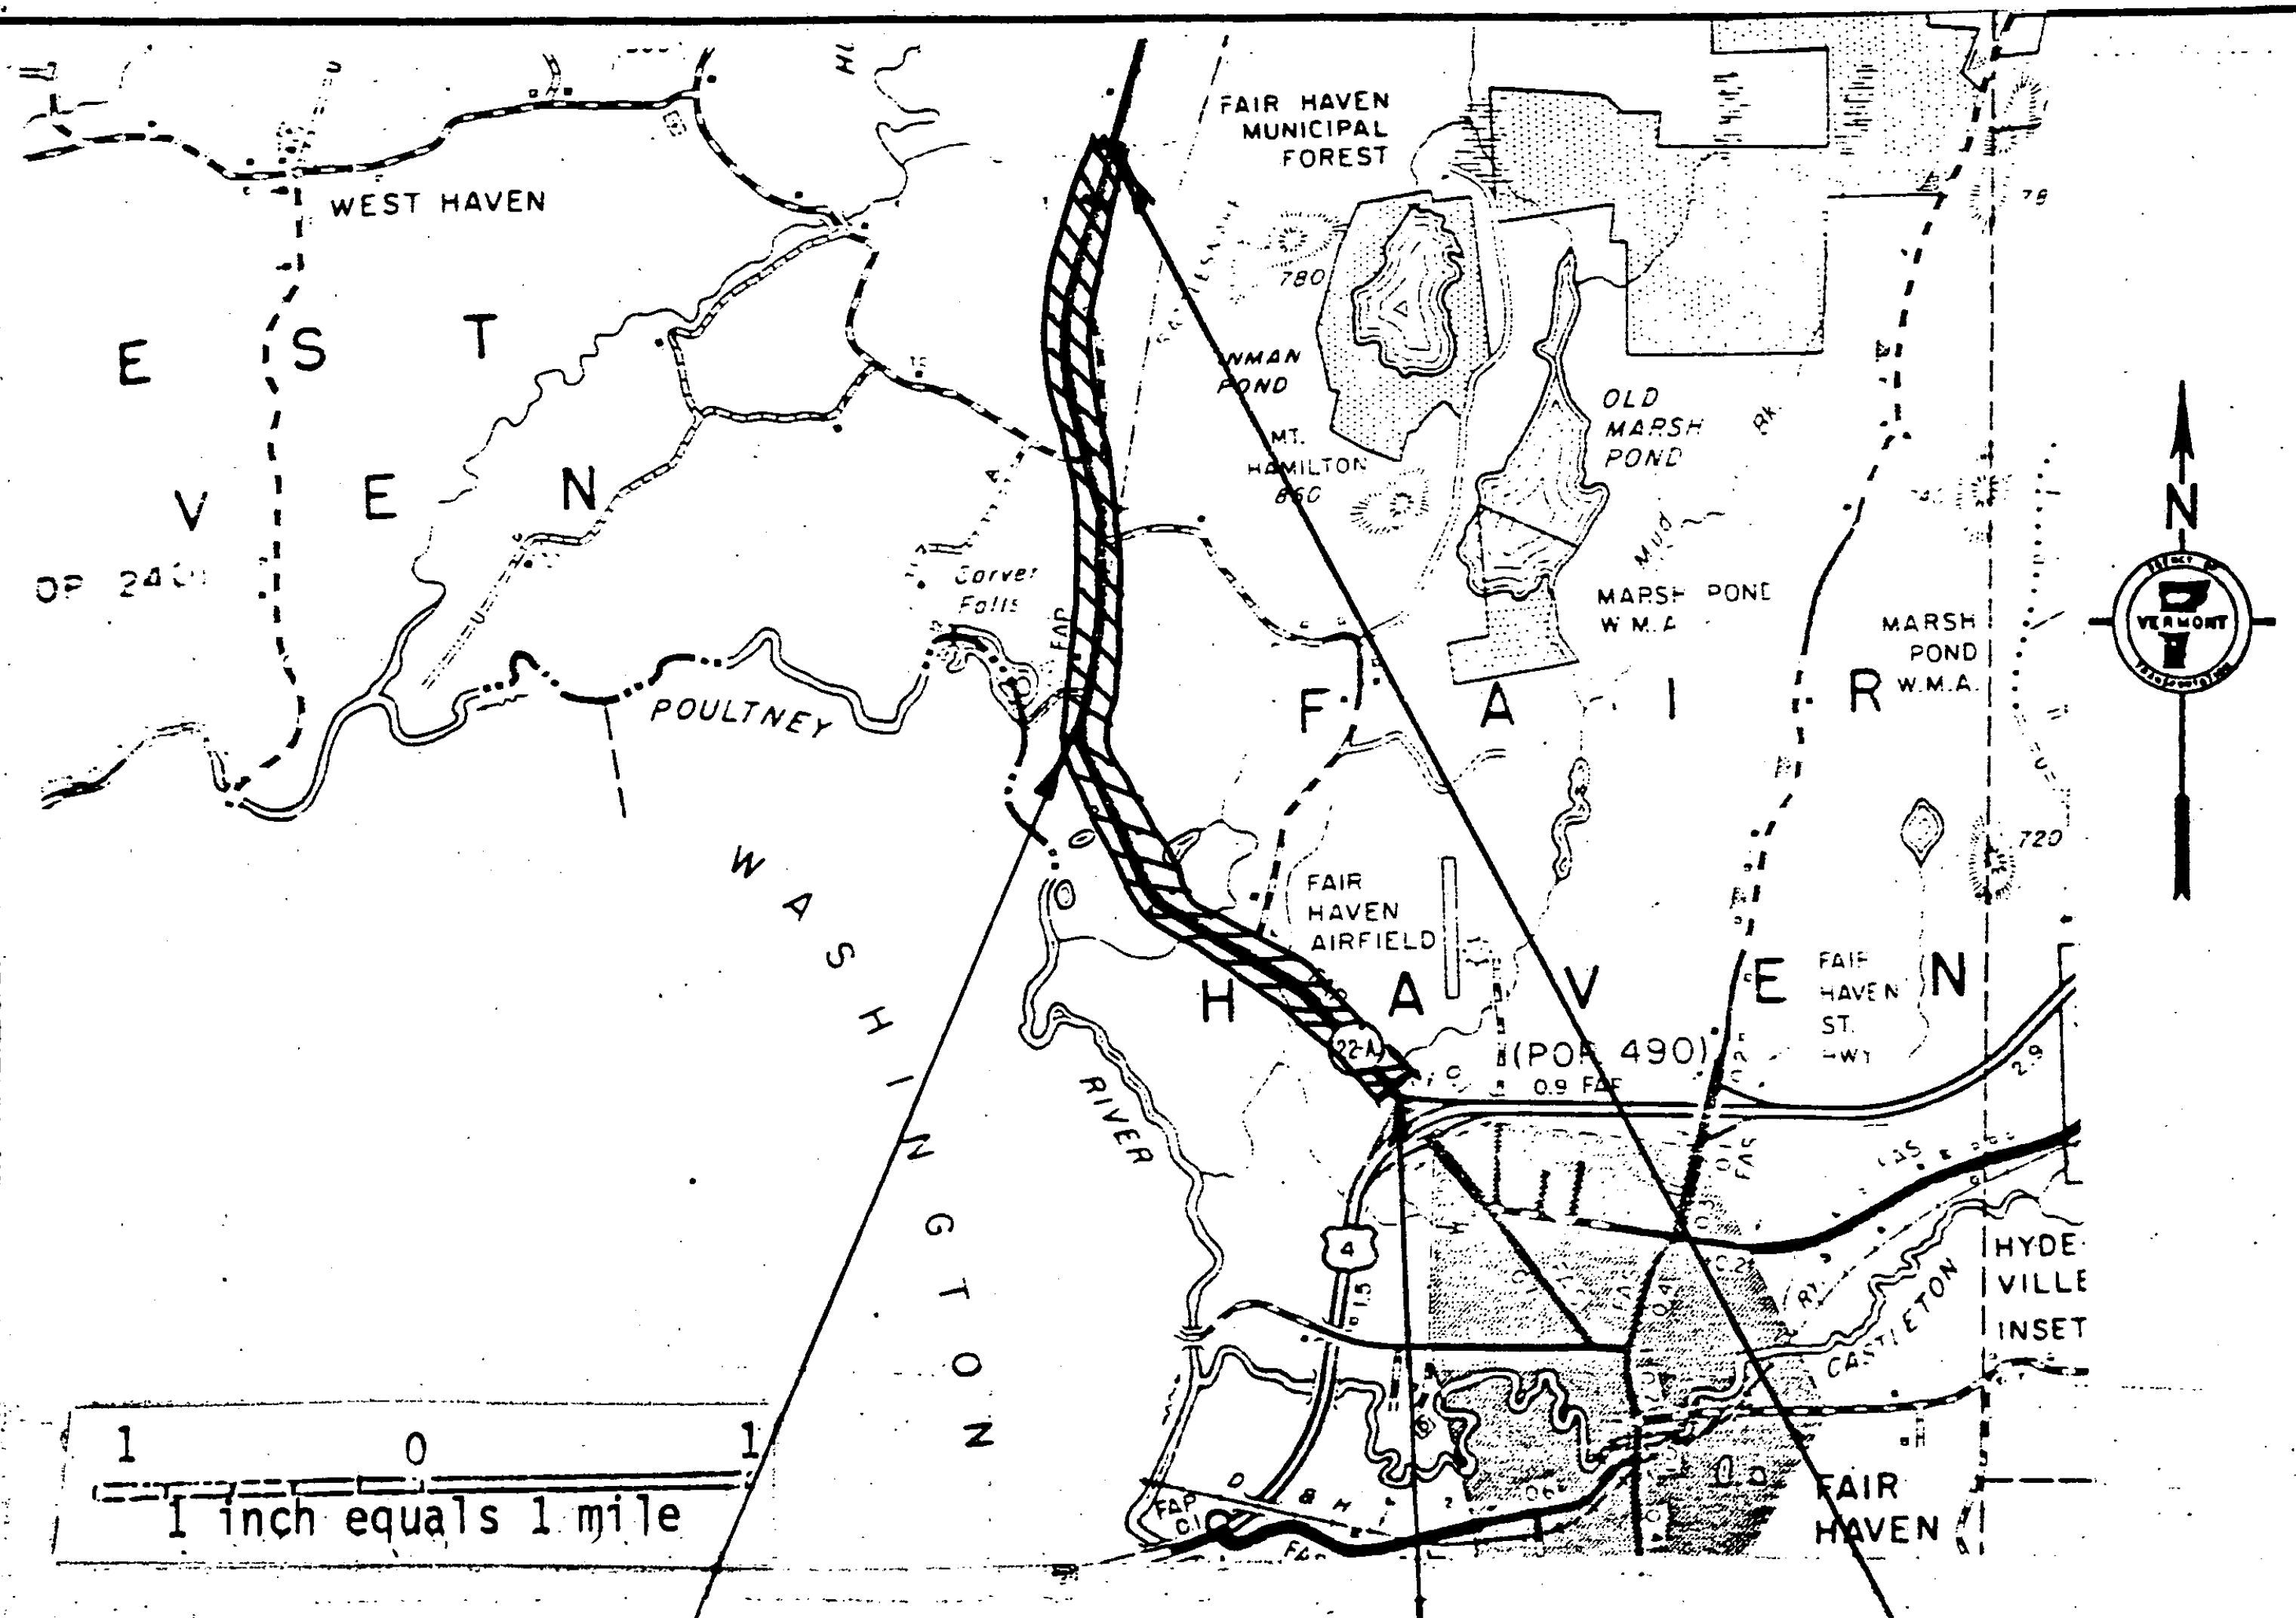

WEST HAVEN MM0.00
 FAIRHAVEN MM4.43

BEGIN PROJECT
 MM. 2.809

END PROJECT
 MM 1.730.

ON VT-22A: BEGINNING 0.27 MILES NORTHERLY OF THE JUNCTION OF
 US4 IN FAIRHAVEN AT MM 2.809 AND EXTENDING NORTHERLY
 3.350 MILES TO WEST HAVEN MM 1.730.

LENGTH OF PROJECT
3.350 MILES
 17,689 FEET

PROJECT <u>FAIRHAVEN-WEST HAVEN</u>	NO. <u>HMA 2510</u> SHEET <u>2</u> OF <u>14</u> SHEETS
-------------------------------------	---