


PROJECT DESCRIPTION AND LOCATION

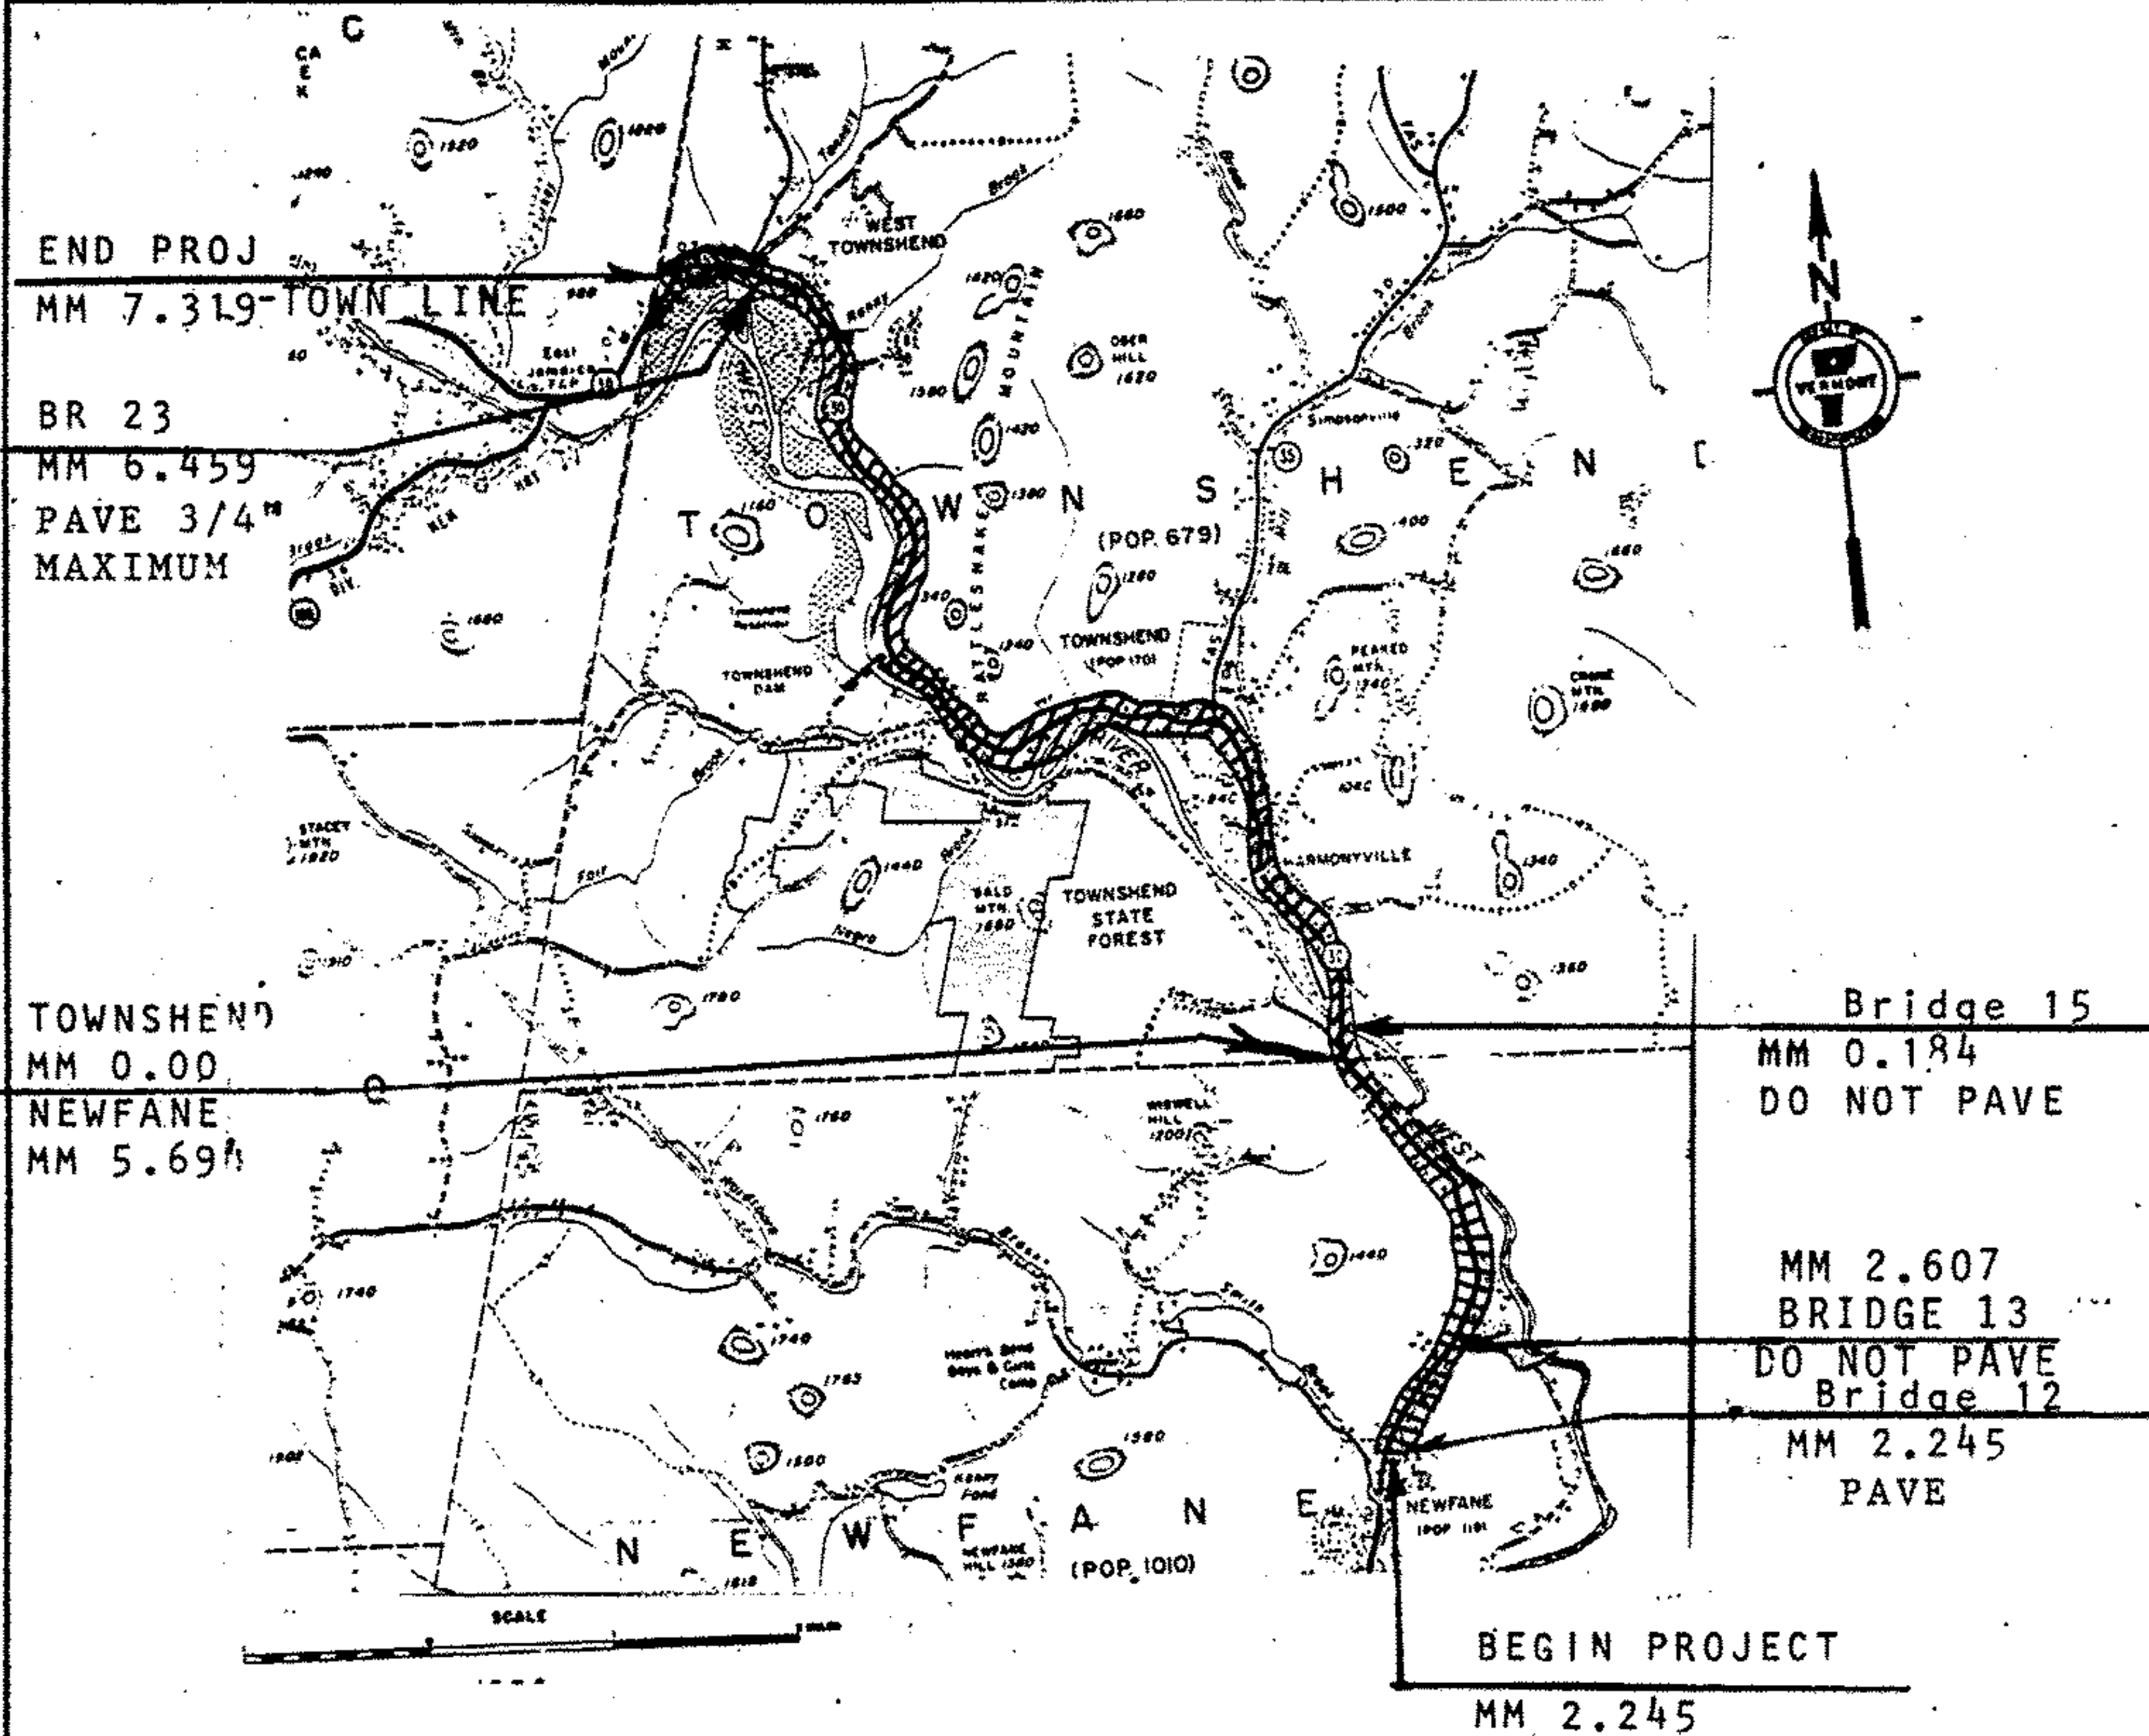

ON VT 30: BEGINNING 2.24 MILES NORTHERLY OF THE DUMMERSTON-NEWFANE TOWN LINE AT MM 2.245 AND EXTENDING 10.769 MILES NORTHERLY TO MM 7.319 IN TOWNSHEND, THE TOWNSHEND-JAMAICA TOWN LINE

LENGTH OF PROJECT
10.769 MILES
56,860 FEET

PROJECT NEWFANE- TOWNSHEND

NO. HMA 2505

SHEET 2 OF 11 SHEETS