


TYPICAL SECTIONS & DESIGN DATA


ITEM 404.65 BITUMINOUS CONCRETE PAVEMENT
 LEVELING COURSE, TYPE III OR IV (177 TONS/MILE)
 AS DIRECTED BY THE ENGINEER
 3/4" WEARING COURSE (+1/4") Type IV

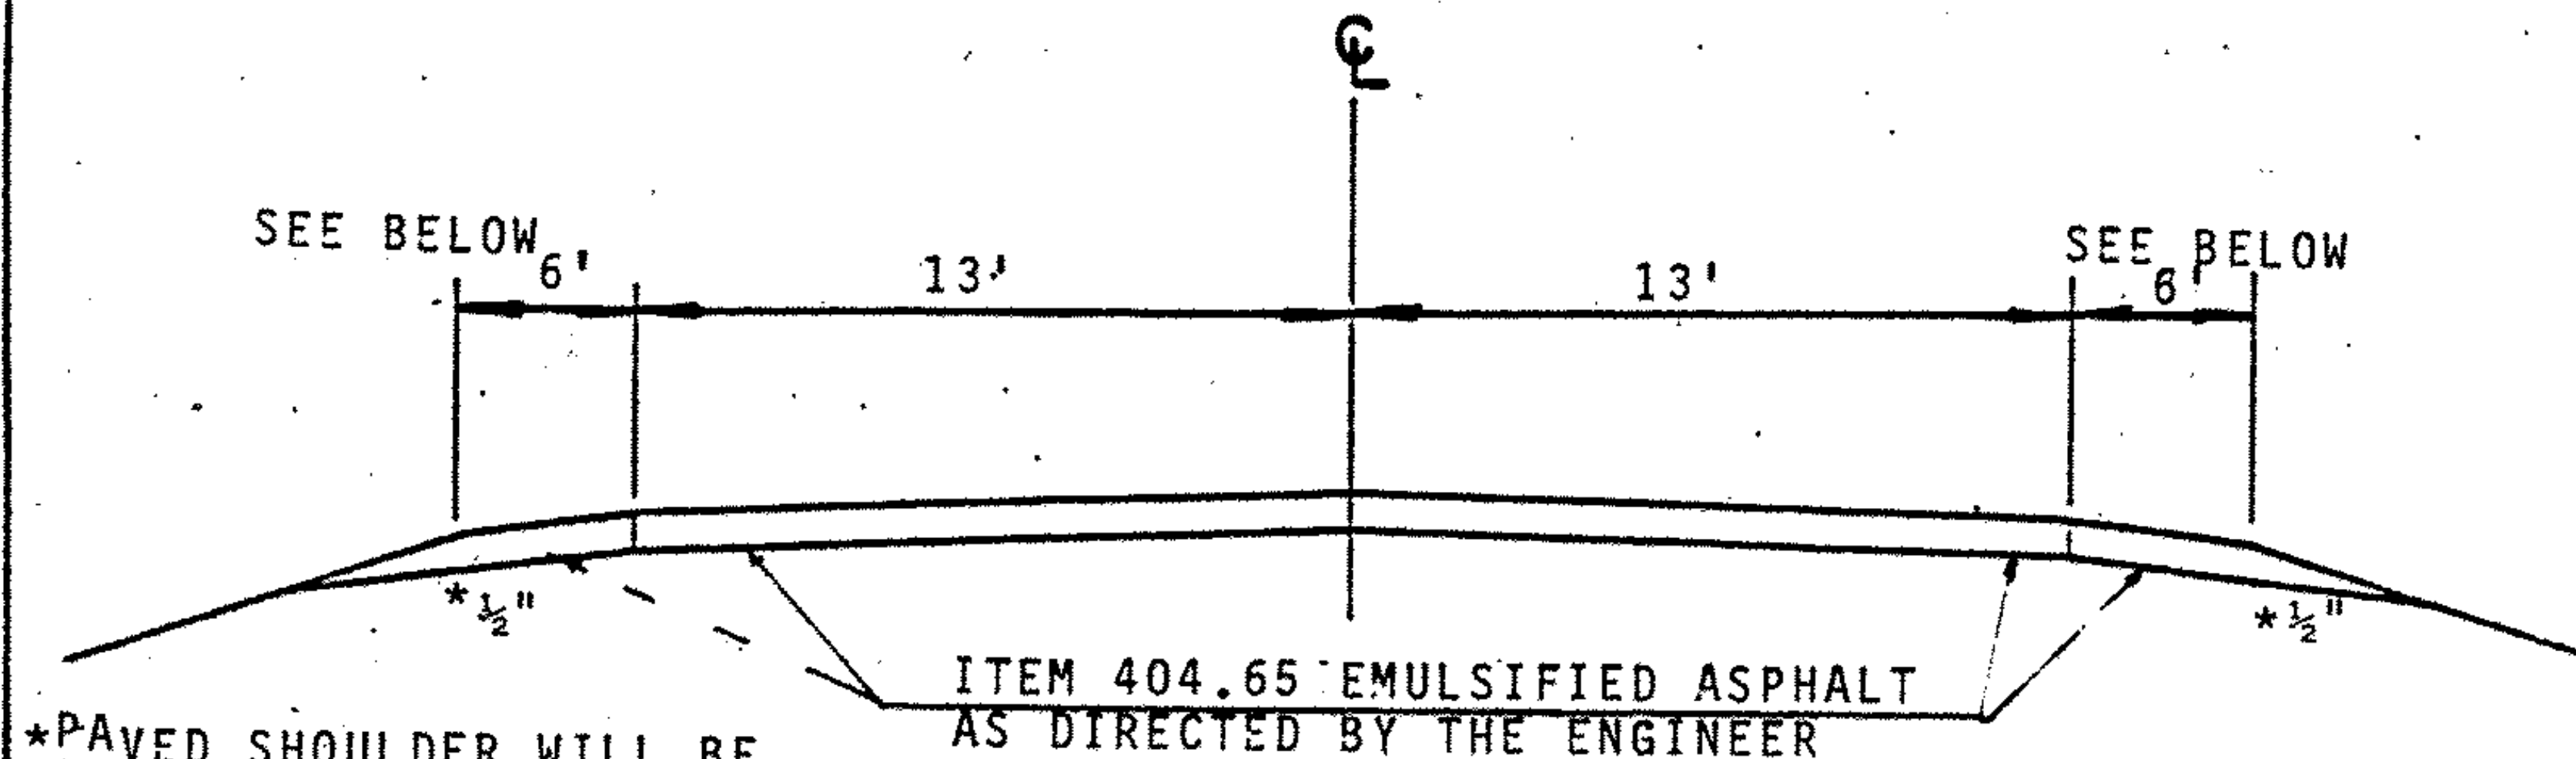

*PAVED SHOULDER WILL BE
 TAPERED FROM FULL DEPTH
 TO 1/2".

NEWFANE MM 2.24 - MM 2.60 (GRAVEL SHOULDERS)
 MM 3.20 - MM 3.50 " "
 MM 3.70 - MM 4.00 " "
 MM 2.60 - MM 3.00 (PAVED SHOULDER)

ITEM 406.25 BITUMINOUS CONCRETE PAVEMENT
 LEVELING COURSE, TYPE III OR IV (177 TONS/MILE)
 AS DIRECTED BY THE ENGINEER
 3/4" WEARING COURSE (+1/4") TYPE IV

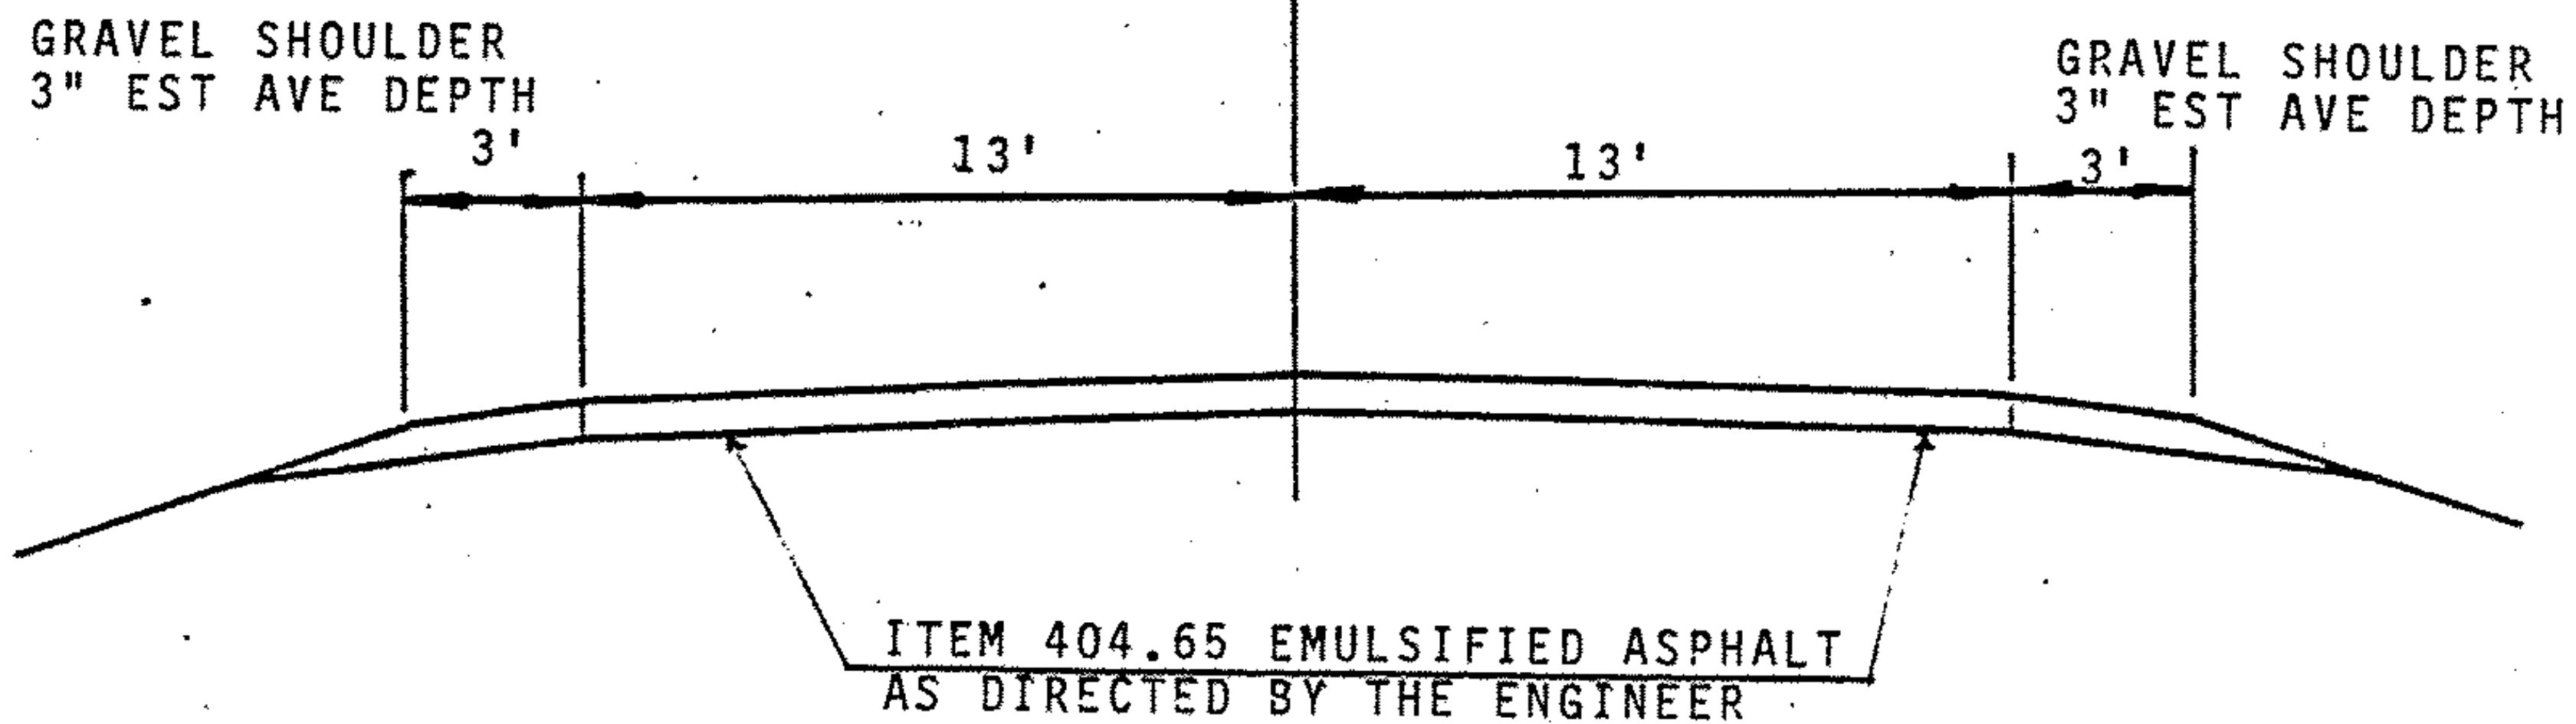

NEWFANE MM 3.00 - MM 3.20
 MM 3.50 - MM 3.70
 MM 4.00 - MM 5.69
 TOWNSHEND MM 0.00 - MM 3.50
 MM 4.20 - MM 6.65

NO. HMA 2505

PROJECT NEWFANE-TOWNSHEND

SHEET 3 OF 11 SHEETS